

**STATE OF SOUTH DAKOTA
DEPARTMENT OF TRANSPORTATION**


**PLANS FOR PROPOSED
PROJECT 000I-271
INTERSTATES 29, 90 & 229
LINCOLN & MINNEHAHA COUNTIES**

PIPE & DROP INLET CLEANOUT
PCN I5FN

000I-271 (INTERSTATE 29)
MRM 72.81 to MRM 84.55

STORM WATER PERMIT
(None required)

| DESIGN DESIGNATION | | | |
|---------------------------|--------|--------|--------|
| ROUTE | I29 | I90 | I229 |
| ADT(2018) | 44,446 | 18,302 | 36,150 |
| ADT(2038) | 75,312 | 28,100 | 60,018 |
| DHV | 8,350 | 3,484 | 6,602 |
| D | 100% | 100% | 100% |
| T DHV | 6.8% | 7.0% | 4.6% |
| T ADT | 14.9% | 15.4% | 10.2% |
| V | 65 MPH | 65 MPH | 65 MPH |

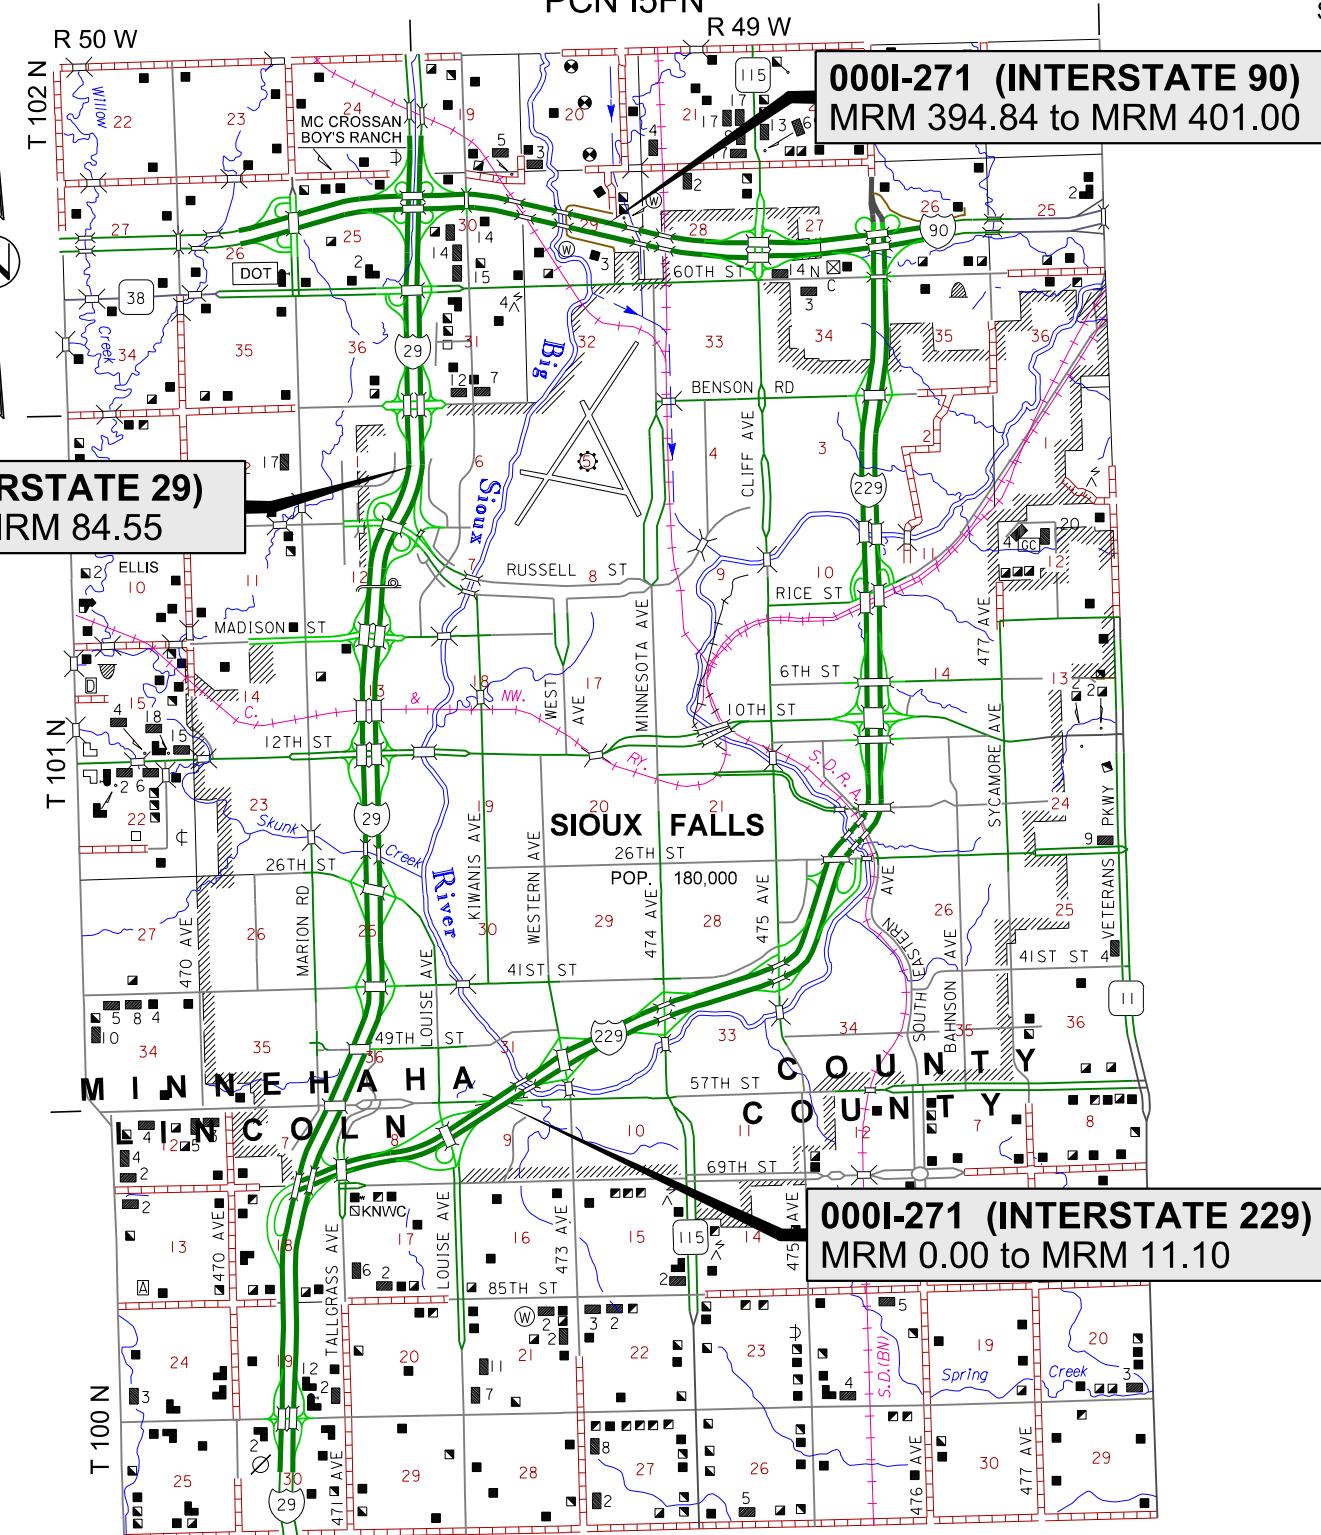

| STATE OF SOUTH DAKOTA | PROJECT | SHEET | TOTAL SHEETS |
|-----------------------|----------|-------|--------------|
| | 000I-271 | 1 | 43 |

Plotting Date: 07/18/2019

INDEX OF SHEETS

| | |
|----------------|----------------------------------------------------|
| Sheet 1 | Layout Map & Index of Sheets |
| Sheet 2 | Estimate of Quantities & Environmental Commitments |
| Sheets 3 & 4 | Plan Notes |
| Sheets 5 - 7 | Tables for Drop Inlet Work |
| Sheets 8 - 25 | I29 Work Locations |
| Sheets 26 - 31 | I229 Work Locations |
| Sheets 32 - 41 | I90 Work Locations |
| Sheets 42 & 43 | Standard Plates for Traffic Control |

ESTIMATE OF QUANTITIES & ENVIRONMENTAL COMMITMENTS

| STATE OF SOUTH DAKOTA | PROJECT | SHEET | TOTAL SHEETS |
|-----------------------------|----------|-------|-----------------|
| | 0001-271 | 2 | 43 |

ESTIMATE OF QUANTITIES

| BID ITEM NUMBER | ITEM | QUANTITY | UNIT |
|-----------------|----------------------------------------|----------|------|
| 009E0010 | Mobilization | Lump Sum | LS |
| 120E0600 | Contractor Furnished Borrow Excavation | 30 | CuYd |
| 250E0020 | Incidental Work, Grading | Lump Sum | LS |
| 450E8900 | Cleanout Pipe Culvert | 23 | Each |
| 634E0110 | Traffic Control Signs | 115.5 | SqFt |
| 634E0120 | Traffic Control, Miscellaneous | Lump Sum | LS |
| 634E0275 | Type 3 Barricade | 1 | Each |
| 734E0103 | Type 3 Erosion Control Blanket | 278 | SqYd |

SPECIFICATIONS

Standard Specifications for Roads and Bridges, 2015 Edition and Required Provisions, Supplemental Specifications and Special Provisions as included in the Proposal.

ENVIRONMENTAL COMMITMENTS

The SDDOT is committed to protecting the environment and uses Section A Environmental Commitments as a communication tool for the Engineer and Contractor to ensure that attention is given to avoid, minimize, and/or mitigate an environmental impact. Environmental commitments to various agencies and the public have been made to secure approval of this project. An agency with permitting authority can delay a project if identified environmental impacts have not been adequately addressed. Unless otherwise designated, the Contractor's primary contact regarding matters associated with these commitments will be the Project Engineer. These environmental commitments are not subject to change without prior written approval from the SDDOT Environmental Office.

Additional guidance on SDDOT's Environmental Commitments can be accessed through the Environmental Procedures Manual found at: <http://www.sddot.com/resources/Manuals/EnvironProcManual.pdf>

For questions regarding change orders in the field that may have an effect on an Environmental Commitment, the Project Engineer will contact the Environmental Office at 605-773-3098 or 605-773-4336 to determine whether an environmental analysis and/or resource agency coordination is necessary.

COMMITMENT C: WATER SOURCE

The Contractor will not withdraw water with equipment previously used outside the State of South Dakota or previously used in aquatic invasive species waters within South Dakota without prior approval from the SDDOT Environmental Office. Thoroughly wash all construction equipment to prevent and control the introduction and spread of invasive species into the project vicinity.

The Contractor will not withdraw water directly from streams of the James, Big Sioux, and Vermillion watersheds without prior approval from the SDDOT Environmental Office.

Action Taken/Required:

The Contractor will obtain the necessary permits from the regulatory agencies such as the South Dakota Department of Environment and Natural Resources (DENR) and the United States Army Corps of Engineers (USACE) prior to water extraction activities.

Additional information and mapping of Aquatic Invasive Species in South Dakota can be accessed at: <http://sdleastwanted.com/maps/default.aspx>.

COMMITMENT E: STORM WATER

Construction activities constitute less than 1 acre of disturbance.

Action Taken/Required:

At a minimum and regardless of project size, appropriate erosion and sediment control measures must be installed to control the discharge of pollutants from the construction site.

COMMITMENT H: WASTE DISPOSAL SITE

The Contractor will furnish a site(s) for the disposal of construction and/or demolition debris generated by this project.

Action Taken/Required:

Construction and/or demolition debris may not be disposed of within the Public ROW.

The waste disposal site(s) will be managed and reclaimed in accordance with the following from the General Permit for Construction/Demolition Debris Disposal Under the South Dakota Waste Management Program issued by the Department of Environment and Natural Resources.

The waste disposal site(s) will not be located in a wetland, within 200 feet of surface water, or in an area that adversely affects wildlife, recreation, aesthetic value of an area, or any threatened or endangered species, as approved by the Environmental Office and the Project Engineer.

If the waste disposal site(s) is located such that it is within view of any ROW, the following additional requirements will apply:

1. Construction and/or demolition debris consisting of concrete, asphalt concrete, or other similar materials will be buried in a trench completely separate from wood debris. The final cover over the construction and/or demolition debris will consist of a minimum of 1 foot of soil capable of supporting vegetation. Waste disposal sites provided outside of the Public ROW will be seeded in accordance with Natural Resources Conservation Service recommendations. The seeding recommendations may be obtained through the appropriate County NRCS Office. The Contractor will control the access to waste disposal sites not within the Public ROW with fences, gates, and placement of a sign or signs at the entrance to the site stating No Dumping Allowed.
2. Concrete and asphalt concrete debris may be stockpiled within view of the ROW for a period of time not to exceed the duration of the project. Prior to project completion, the waste will be removed from view of the ROW or buried, and the waste disposal site reclaimed as noted above.

The above requirements will not apply to waste disposal sites that are covered by an individual solid waste permit as specified in SDCL 34A-6-58, SDCL 34A-6-1.13, and ARSD 74:27:10:06.

Failure to comply with the requirements stated above may result in civil penalties in accordance with South Dakota Solid Waste Law, SDCL 34A-6-1.31.

Cost associated with furnishing waste disposal site(s), disposing of waste, maintaining control of access (fence, gates and signs), and reclamation of the waste disposal site(s) will be incidental to the various contract items.

COMMITMENT I: HISTORICAL PRESERVATION OFFICE CLEARANCES

State Historical Preservation Office (SHPO or THPO) concurrence has not been obtained for this project.

Action Taken/Required:

All earth disturbing activities require a cultural resource review prior to scheduling the pre-construction meeting. This work includes but is not limited to: Contractor furnished material sources, material processing sites, stockpile sites, storage areas, plant sites, and waste areas.

The Contractor will arrange and pay for a record search and when necessary, a cultural resource survey. The Contractor has the option to contact the state Archaeological Research Center (ARC) at 605-394-1936 or another qualified archaeologist, to obtain either a records search or a cultural resources survey. A record search might be sufficient for review if the site was previously surveyed; however, a cultural resources survey may need to be conducted by a qualified archaeologist.

The Contractor will provide ARC with the following: a topographical map or aerial view of which the site is clearly outlined, site dimensions, project number, and PCN. If applicable, provide evidence that the site has been previously disturbed by farming, mining, or construction activities with a landowner statement that artifacts have not been found on the site.

The Contractor will submit the cultural resources survey report to SDDOT Environmental Office, 700 East Broadway Avenue, Pierre, SD 57501-2586. SDDOT will submit the information to the appropriate SHPO/THPO. Allow **30 Days** from the date this information is submitted to the Environmental Engineer for SHPO/THPO review.

In the event of an inadvertent discovery of human remains, funerary objects, or if evidence of cultural resources is identified during project construction activities, then such activities will immediately cease, and the Project Engineer will be immediately notified. The Project Engineer will contact the SDDOT Environmental Office to determine an appropriate course of action.

The Contractor is responsible for obtaining any additional permits and clearances for Contractor furnished material sources, material processing sites, stockpile sites, storage areas, plant sites, and waste areas that affect wetlands, threatened and endangered species, or waterways. The Contractor will not utilize a site known or suspected of having contaminated soil or water. The Contractor will provide the required permits and clearances to the Project Engineer at the preconstruction meeting.

| STATE OF SOUTH DAKOTA | PROJECT | SHEET | TOTAL SHEETS |
|-----------------------------|----------|-------|-----------------|
| | 000I-271 | 3 | 43 |

SCOPE OF WORK

The project consists of drop inlet cleanout. Locating and cleaning buried and/or silted in culvert outlets.

Work activities will not be allowed during the morning peak from 6:30 AM to 9:00 AM and the afternoon peak from 3:30 PM to 6:00 PM Monday through Friday.

DETAILS OF EXISTING DROP INLETS

All details of the existing drop inlets are based on visual inspections and are provided as information only. It is the Contractor's responsibility to inspect and verify the actual field conditions affecting the satisfactory completion of the work required for this project.

SEQUENCE OF OPERATIONS

The Contractor will submit a sequence of operations for approval two weeks prior to the preconstruction meeting.

Approval of an alternate sequence of operations will only be allowed when the proposed changes meet with the Department's intent for traffic control and sequencing of the work. An alternate sequence will be submitted for review a minimum of one week prior to potential implementation.

CLEANOUT PIPE CULVERTS AND DROP INLETS

Cleanout of pipe culverts and drop inlets will be cleaned out by water flushing or other approved methods. Material removed from the pipe culverts will become the property of the Contractor for disposal.

The Contractor will implement appropriate temporary sediment control measures prior to water flushing to prevent discharges from the project boundaries.

The pipe culvert and drop inlets will be cleaned to the satisfaction of the Engineer.

Cost to remove and reset inlet grates, dewater, clean pipes, and dispose of removed material will be incidental to the contract unit price per each for Cleanout Pipe Culvert.

UTILITIES

The Contractor will contact the involved utility companies through South Dakota One Call (1-800-781-7474) prior to starting work. It will be the responsibility of the Contractor to coordinate work with the utility owners to avoid damage to existing facilities.

Utilities are not planned to be affected on this project. If utilities are identified near the improvement area, the Contractor will contact the Project Engineer to determine modifications that will be necessary to avoid utility impacts.

WATER FOR COMPACTION

Cost for water for compaction of the Contractor Furnished Borrow Excavation will be incidental to the contract unit prices for the various items. The moisture required at the time of compaction will be as directed by the Engineer.

CONTRACTOR FURNISHED BORROW EXCAVATION

The Contractor will provide a suitable site for Contractor furnished borrow excavation material. The Contractor is responsible for obtaining all required permits and clearances for the borrow site. The borrow material will be approved by the Engineer. The plans quantity for Contractor Furnished Borrow Excavation as shown in the Estimate of Quantities will be the basis of payment for this item.

Restoration of the Contractor furnished borrow excavation site will be the responsibility of the Contractor.

Interstate 90 Eastbound MRM 397.460 Railroad Bridge Outside Shoulder place 30 cubic yards of Contractor Furnished Borrow.

INCIDENTAL WORK, GRADING

Route: Interstate 90 Eastbound

MRM 397.460 – Railroad Bridge
Clean culvert outlet and place approximate 30 CuYds of fill and 278 SqYd of Type 3 Erosion Control Blanket at washout.

MRM 399.460 – Cliff Ave. Bridge
Clean culvert outlet

MRM 400.550 – Interstate 229
Clean culvert outlet

Route: Interstate 90 Westbound

MRM 397.450 – Railroad Bridge
Clean Culvert outlet

MRM 398.440 – Big Sioux River inside shoulder
Remove plastic covering drop inlet lid

MRM 398.440 – Big Sioux River outside shoulder
Remove plastic covering drop inlet lid

MRM 399.460 – Cliff Ave. Bridge inside shoulder
Clean culvert outlet

MRM 399.460 – Cliff Ave. Bridge outside shoulder
Clean culvert outlet

MRM 400.550 – Interstate 229 Bridge inside shoulder
Clean culvert outlet

MRM 400.550 – Interstate 229 Bridge outside shoulder
Clean culvert outlet

Route: Interstate 229 Northbound

MRM 5.460 – Big Sioux River Bridge
Clean culvert outlet

MRM 5.550 – Railroad Bridge
Clean culvert outlet

Route: Interstate 229 Southbound

MRM 7.850 – Rice Street Bridge
Clean culvert outlet

MRM 6.823 – Between 6th and 10th Streets
Clean culvert outlet

PERMANENT SEEDING

Interstate 90 Eastbound - MRM 397.460 – Railroad Bridge
Clean culvert outlet and place approximate 30 CuYds of fill at washout.

Washout area to be seeded by the Contractor.

Cost for permanent seeding will be incidental to the contract unit prices for the various contract items. Permanent seed mixture will be approved by the Engineer without any further testing.

| | | | |
|-----------------------------|----------|-------|-----------------|
| STATE OF SOUTH DAKOTA | PROJECT | SHEET | TOTAL SHEETS |
| | 0001-271 | 4 | 43 |

GENERAL TRAFFIC CONTROL

Existing guide, route, informational logo, regulatory, and warning signs will be temporarily reset and maintained during construction. Removing, relocating, covering, salvaging, and resetting of existing traffic control devices, including delineation, will be the responsibility of the Contractor. Cost for this work will be incidental to the contract unit prices for the various items unless otherwise specified in the plans. Any delineators and signs damaged or lost will be replaced by the Contractor at no cost to the State.

Temporary traffic control sign locations will be set in the field by the Contractor and verified by the Engineer prior to installation.

Temporary speed limit signs will have a minimum mounting height of 5 feet in rural locations, even when mounted on portable supports. Portable sign supports will not be located on sidewalks, bicycle facilities, or other areas designated for pedestrian or bicycle traffic.

Construction operations will be conducted in the general direction of traffic movement.

If there is a discrepancy between the traffic control plans, standard plates, and the MUTCD, whichever is more stringent will be used, as determined by the Engineer.

Unless otherwise stated in these plans, work will not be allowed during hours of darkness. Overnight lane closures will not be allowed.

Traffic Control Signs, as shown in the Estimate of Quantities, are estimates. Contractor's operation may require adjustments in quantities, either more or less. Payment will be for those signs actually ordered by the Engineer and used.

Fixed location signing placed more than 4 calendar days prior to the start of construction will be covered or laid down until the time of construction. The covers must be approved by the Engineer prior to installation. Cost for material, labor and equipment necessary to complete this work will be incidental to other contract items. No separate payment will be made.

Fixed location signs, sign posts, and breakaway bases will be removed within 7 calendar days following pavement marking.

Haul trucks will be equipped with an additional flashing amber light that is visible from the backside of the haul truck. Cost for flashing amber lights will be incidental to the contract unit prices for the various items.

Traffic will be maintained on the driving lanes. Use of the shoulder as a driving lane will not be permitted. Any damage to the shoulder due to rerouted traffic or Contractor's equipment will be repaired at no expense to the Department.

Construction vehicles will exit or enter the construction work zone at locations identified by the Engineer. At no time will construction vehicles utilize the maintenance crossovers or the Interstate median to exit or enter Interstate traffic.

SHEETING FOR TRAFFIC CONTROL SIGNS

All fluorescent orange background material on traffic control signs, all temporary delineators, and all temporary STOP (R1-1), YIELD (R1-2), DO NOT ENTER (R5-1), and WRONG WAY (R5-1a) signs will conform to the requirements of ASTM D4956 Type IX or XI. All other traffic control signs and background colors will conform to the requirements of ASTM D4956 Type IV.

TRAFFIC CONTROL SIGNS

Sufficient traffic control devices have been included in these plans to sign one workspace on each route. If the Contractor elects to work on additional locations simultaneously, the cost for additional traffic control devices will be incidental to the contract unit price per square foot for Traffic Control Signs.

ITEMIZED LIST FOR TRAFFIC CONTROL SIGNS

| CONVENTIONAL ROAD | | | | | |
|----------------------------------------------|-------------------------------------|--------|-----------|---------------|-------|
| SIGN CODE | SIGN DESCRIPTION | NUMBER | SIGN SIZE | SQFT PER SIGN | SQFT |
| W7-3aP | NEXT __ MILES (plaque) | 2 | 36" x 30" | 7.5 | 15.0 |
| W20-1 | ROAD WORK AHEAD | 2 | 48" x 48" | 16.0 | 32.0 |
| W21-5a | LEFT or RIGHT SHOULDER CLOSED | 2 | 48" x 48" | 16.0 | 32.0 |
| W21-5b | LEFT or RIGHT SHOULDER CLOSED AHEAD | 2 | 48" x 48" | 16.0 | 32.0 |
| G20-2 | END ROAD WORK | 1 | 36" x 18" | 4.5 | 4.5 |
| CONVENTIONAL ROAD TRAFFIC CONTROL SIGNS SQFT | | | | | 115.5 |

| | | | |
|-----------------------------|----------|-------|-----------------|
| STATE OF SOUTH DAKOTA | PROJECT | SHEET | TOTAL SHEETS |
| | 000I-271 | 5 | 43 |

TABLES FOR DROP INLET WORK

| Station | Route: Interstate 29 Southbound lanes | | | | | Station | Route: Interstate 29 Northbound lanes | | | | |
|---------|---------------------------------------|--------------------|----------|------------|--------------------------------|----------------------------------------------------------------------------------------------------------------------------------------------------------------------------------------------------------------------------------------------------------------------------------------------------------------------------------|---------------------------------------|--------------------|----------|------------|--------------------------------|
| | MRM | Interchange/Bridge | Shoulder | Drop Inlet | For Information Only (Each) | | MRM | Interchange/Bridge | Shoulder | Drop Inlet | For Information Only (Each) |
| 156+42 | 82.508 | Benson Road | Outside | 1 | Drop Inlet 50% full | 84+17 | 79.230 | 12th Street | Outside | 1 | Drop Inlet 80% full |
| 142+82 | 82.305 | Benson Road | Outside | 1 | Drop Inlet 90% full | 88+21 | 79.300 | 12th Street | Outside | 1 | Drop Inlet 90% full |
| 142+82 | 80.406 | Madison | Outside | 1 | Drop Inlet 70% full | 100+58 | 79.530 | Railroad | Outside | 1 | Drop Inlet 60% full |
| 138+78 | 80.325 | Madison | Outside | 1 | Drop Inlet 70% full | 138+78 | 80.250 | Madison Street | Outside | 1 | Drop Inlet 50% full |
| 88+39 | 79.300 | 12th Street | Inside | 1 | Drop Inlet 100% full | 142+82 | 80.330 | Madison Street | Outside | 1 | Drop Inlet 60% full |
| 88+39 | 79.300 | 12th Street | Outside | 1 | Drop Inlet 100% full | DROP INLET CLEANOUT | | TOTALS | 5 | | |
| 84+35 | 79.263 | 12th Street | Outside | 1 | Drop Inlet 100% full | Outside Shoulder refers to the wide shoulder adjacent to the driving lane. Inside Shoulder reffers to the narrow shoulder adjacent to the passing lane. Percentage of drop inlet full is for information only and not for bidding purposes The percentage of debris in the drop inlet will not be adjusted for payment. | | | | | |
| 191+49 | 78.383 | Skunk Creek | Outside | 1 | Drop Inlet 50% full | | | | | | |
| 188+08 | 78.324 | Skunk Creek | Outside | 1 | Drop Inlet 50% full | | | | | | |
| | | | | | | DROP INLET CLEANOUT | TOTALS | 12 | | | |

Outside Shoulder refers to the wide shoulder adjacent to the driving lane.

Inside Shoulder reffers to the narrow shoulder adjacent to the passing lane.

Percentage of drop inlet full is for information only and not for bidding purposes.

The percentage of debris in the drop inlet will not be adjusted for payment.

| STATE OF SOUTH DAKOTA | PROJECT | SHEET | TOTAL SHEETS |
|-----------------------------|----------|-------|-----------------|
| | 000I-271 | 6 | 43 |

TABLES FOR DROP INLET WORK (CONTINUED)

| Station | Route: Interstate 229 Southbound lanes | | | | |
|---------|----------------------------------------|---------------------------------------------------------------------|----------|---------------|--------------------------------|
| | MRM | Interchange/Bridge | Shoulder | Drop Inlet | For Information Only (Each) |
| 156+89 | 7.850 | Rice Street | Outside | | |
| | | *Incidental Work Grading - Clean culvert out | | 0 | |
| 343+80 | 6.823 | Between 6th & 10th Streets | | | |
| | | *Incidental Work Grading - Clean culvert out | | 0 | |
| 42+16 | 5.460 | Big Sioux River Bridge N of 26th | Outside | 1 | Drop Inlet 60% full |
| | | *Incidental Work Grading - Remove 3 trees and clean culvert outlet. | | | |
| 152+45 | 3.010 | Minnesota Ave. | Outside | 1 | Drop Inlet 80% full |
| | | | | | |
| | | DROP INLET CLEANOUT | | TOTALS | 0 |
| | | | | | |

Outside Shoulder refers to the wide shoulder adjacent to the driving lane.

Inside Shoulder reffers to the narrow shoulder adjacent to the passing lane.

Percentage of drop inlet full is for information only and not for bidding purposes.

The percentage of debris in the drop inlet will not be adjusted for payment.

| Station | Route: Interstate 229 Northbound lanes | | | | |
|---------|----------------------------------------|--------------------------------------------------|----------|---------------|--------------------------------|
| | MRM | Interchange/Bridge | Shoulder | Drop Inlet | For Information Only (Each) |
| 42+16 | 5.460 | Big Sioux River Bridge N of 26 | Outside | 0 | |
| | | *Incidental Work Grading - Clean culvert outlet. | | | |
| 51+57 | 5.550 | Railroad | | 0 | |
| | | *Incidental Work Grading - Clean culvert outlet. | | | |
| | | DROP INLET CLEANOUT | | TOTALS | 0 |
| | | | | | |

Outside Shoulder refers to the wide shoulder adjacent to the driving lane.

Inside Shoulder reffers to the narrow shoulder adjacent to the passing lane.

Percentage of drop inlet full is for information only and not for bidding purposes.

The percentage of debris in the drop inlet will not be adjusted for payment.

TABLES FOR DROP INLET WORK (CONTINUED)

Route: Interstate 90 Eastbound lanes

| STATION | MRM | Interchange/Bridge | Shoulder | Drop Inlet | For Information Only (Each) |
|----------------------------|---------|--------------------|----------|------------|-----------------------------------------------------------------------------------------------------------------------------------------------|
| 125+54 | 397.460 | Railroad | Outside | 1 | Drop Inlet 80% full |
| | | | | | *Incidental Work Grading - Clean plugged culvert outlet and place 30 cuyds of fill and 278 SqYd of Type 3 Erosion Control blanket at washout. |
| 146+54 | 397.860 | Big Sioux River | Outside | 1 | Drop Inlet 90% full |
| 146+57 | 397.860 | Big Sioux River | Inside | 1 | Drop Inlet 70% full |
| 177+72 | 398.450 | Big Sioux River | Inside | 1 | Drop Inlet 70% full |
| 56+13 | 399.460 | Cliff Ave. | Inside | 0 | |
| | | | | | *Incidental Work Grading- Clean culvert outlet. |
| 332+08 | 400.550 | Interstate 229 | Inside | 0 | |
| | | | | | *Incidental Work Grading- Clean culvert outlet. |
| DROP INLET CLEANOUT | | TOTALS | 4 | | |

Outside Shoulder refers to the wide shoulder adjacent to the driving lane.

Inside Shoulder refers to the narrow shoulder adjacent to the passing lane.

Percentage of drop inlet full is for information only and not for bidding purposes.

The percentage of debris in the drop inlet will not be adjusted for payment.

Route: Interstate 90 Westbound lanes

| STATION | MRM | Interchange/Bridge | Shoulder | Drop Inlet | For Information Only (Each) |
|---------|---------|--------------------|----------|------------|------------------------------------------------------------------|
| 124+59 | 397.450 | Railroad | Outside | 0 | |
| | | | | | *Incidental Work Grading - Clean culvert outlet. |
| 177+09 | 398.440 | Big Sioux River | Inside | 0 | |
| | | | | | *Incidental Work Grading-Remove plastic covering drop inlet lid. |
| 177+09 | 398.440 | Big Sioux River | Outside | 0 | |
| | | | | | *Incidental Work Grading-Remove plastic covering drop inlet lid. |
| 56+13 | 399.460 | Cliff Ave. | Inside | 0 | |
| | | | | | *Incidental Work Grading- Clean culvert outlet. |
| 56+13 | 399.460 | Cliff Ave. | Outside | 0 | |
| | | | | | *Incidental Work Grading- Clean culvert outlet. |
| 332+14 | 400.550 | Interstate 229 | Inside | 0 | |
| | | | | | *Incidental Work Grading- Clean culvert outlet. |
| 332+19 | 400.550 | Interstate 229 | Outside | 0 | |
| | | | | | *Incidental Work Grading- Clean culvert outlet. |

DROP INLET CLEANOUT TOTALS 0

Outside Shoulder refers to the wide shoulder adjacent to the driving lane.

Inside Shoulder refers to the narrow shoulder adjacent to the passing lane.

Percentage of drop inlet full is for information only and not for bidding purposes.

The percentage of debris in the drop inlet will not be adjusted for payment.

TEA INTERCHANGE
INTERSTATE 29 SOUTHBOUND
Sta. 59+00-66'L
Sta. 4026+39-31-R
4014+30-40'L

4026+39-32.13' R to
4026+39-50' L
Install 18" - 42' R C Pipe
18" R C Pipe to C M Pipe Transition
(Std. Plate 450.50)
Install 18" - 35' C M Pipe Downspout
(25' & 10' Str Pipe)
and 2 - 37.5° Elbows
& 1 Slope End

4026+39-31.93' R
Install Type M Median Drain
Grate El. = 1515.66

4014+30-31' L
Install Bank and Channel
Protection Gabions
(27.0 CY)

Ramp C

.54 PI 4010+22.82
.76 N 428748.03
.71 E 2906854.12
R Del 1°03'23" L

4027+69-7' L to
4027+69-44' L
Install 24" - 36' C M Pipe
(26' & 10' Str. Pipe)
and 1 - 30° Elbow
& 1 Sloped End

4027+69-7' L
Install Type C Drop Inlet
Grate El. elev. = 1515.44

4025+45-19' L
Install Bank and Channel
Protection Gabions
(4.5 CY)

4028+37-20.37' R to
4028+37-43' L
Install 24" - 24' R C Pipe
24" R C Pipe to C M Pipe Transition
(Std. Plate 450.50)
Install 24" - 37' C M Pipe Downspout
(27' & 10' Str. Pipe)
and 1 - 25° Elbow
and 1 - 27.5° Elbow
& 1 Sloped End


4028+37 20.67' R
Install Type B Drop Inlet/w
6" Concrete Collar
Grate El. = 1514.98

Ramp C


PI 4022+95.14
N 430019.97
E 2906823.12
Del 1°22'15" L
Dc 0°30'00"
T 137.08
L 274.15
R 11459.16

Ramp C


PI 4028+81.11
N 430605.27
E 2906794.84
Del 3°11'00" R
Dc 1°15'00"
T 127.37
L 254.67
R 4583.75

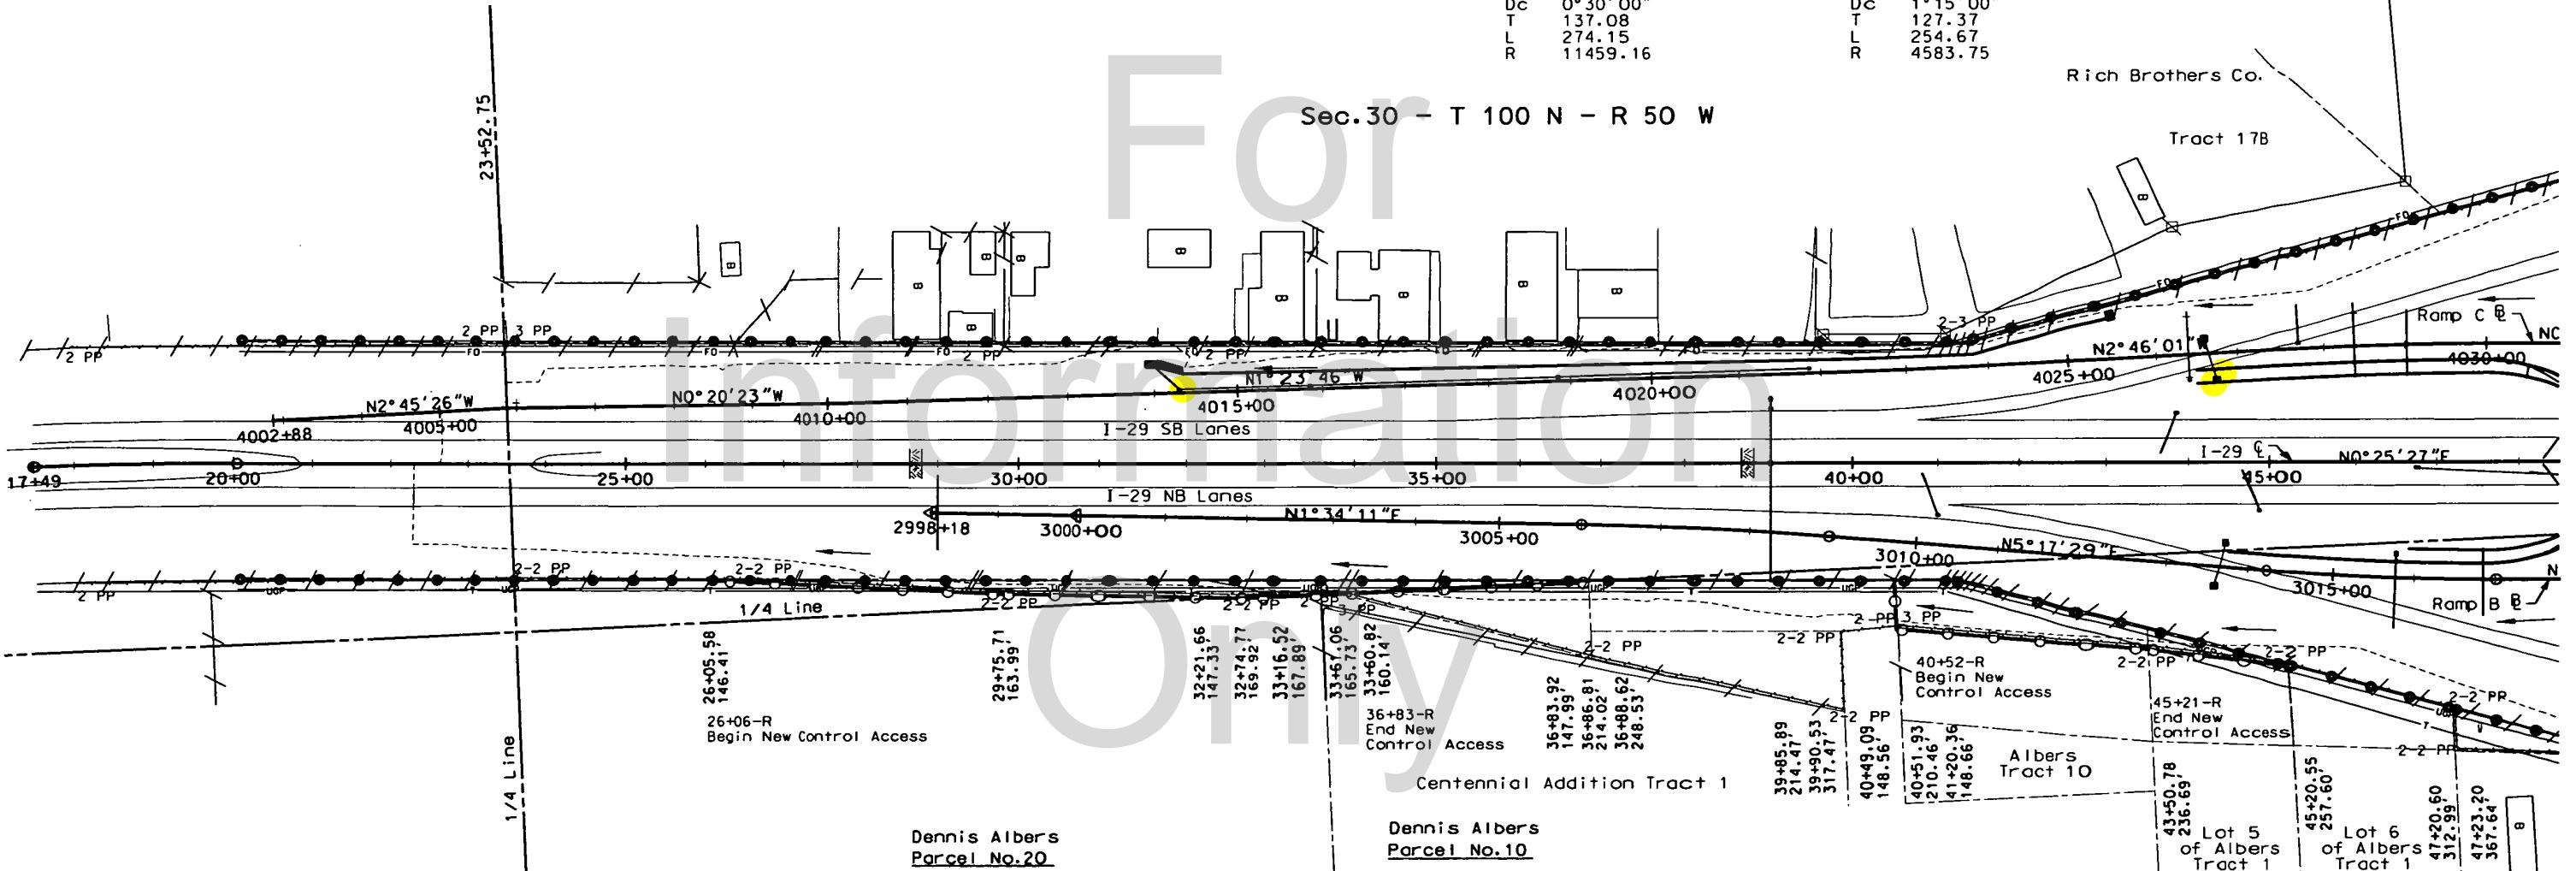

TEA INTERCHANGE
INTERSTATE 29 SOUTHBOUND
Sta. 59+00-66'L
Sta. 4026+39-31-R
4014+30-40'L

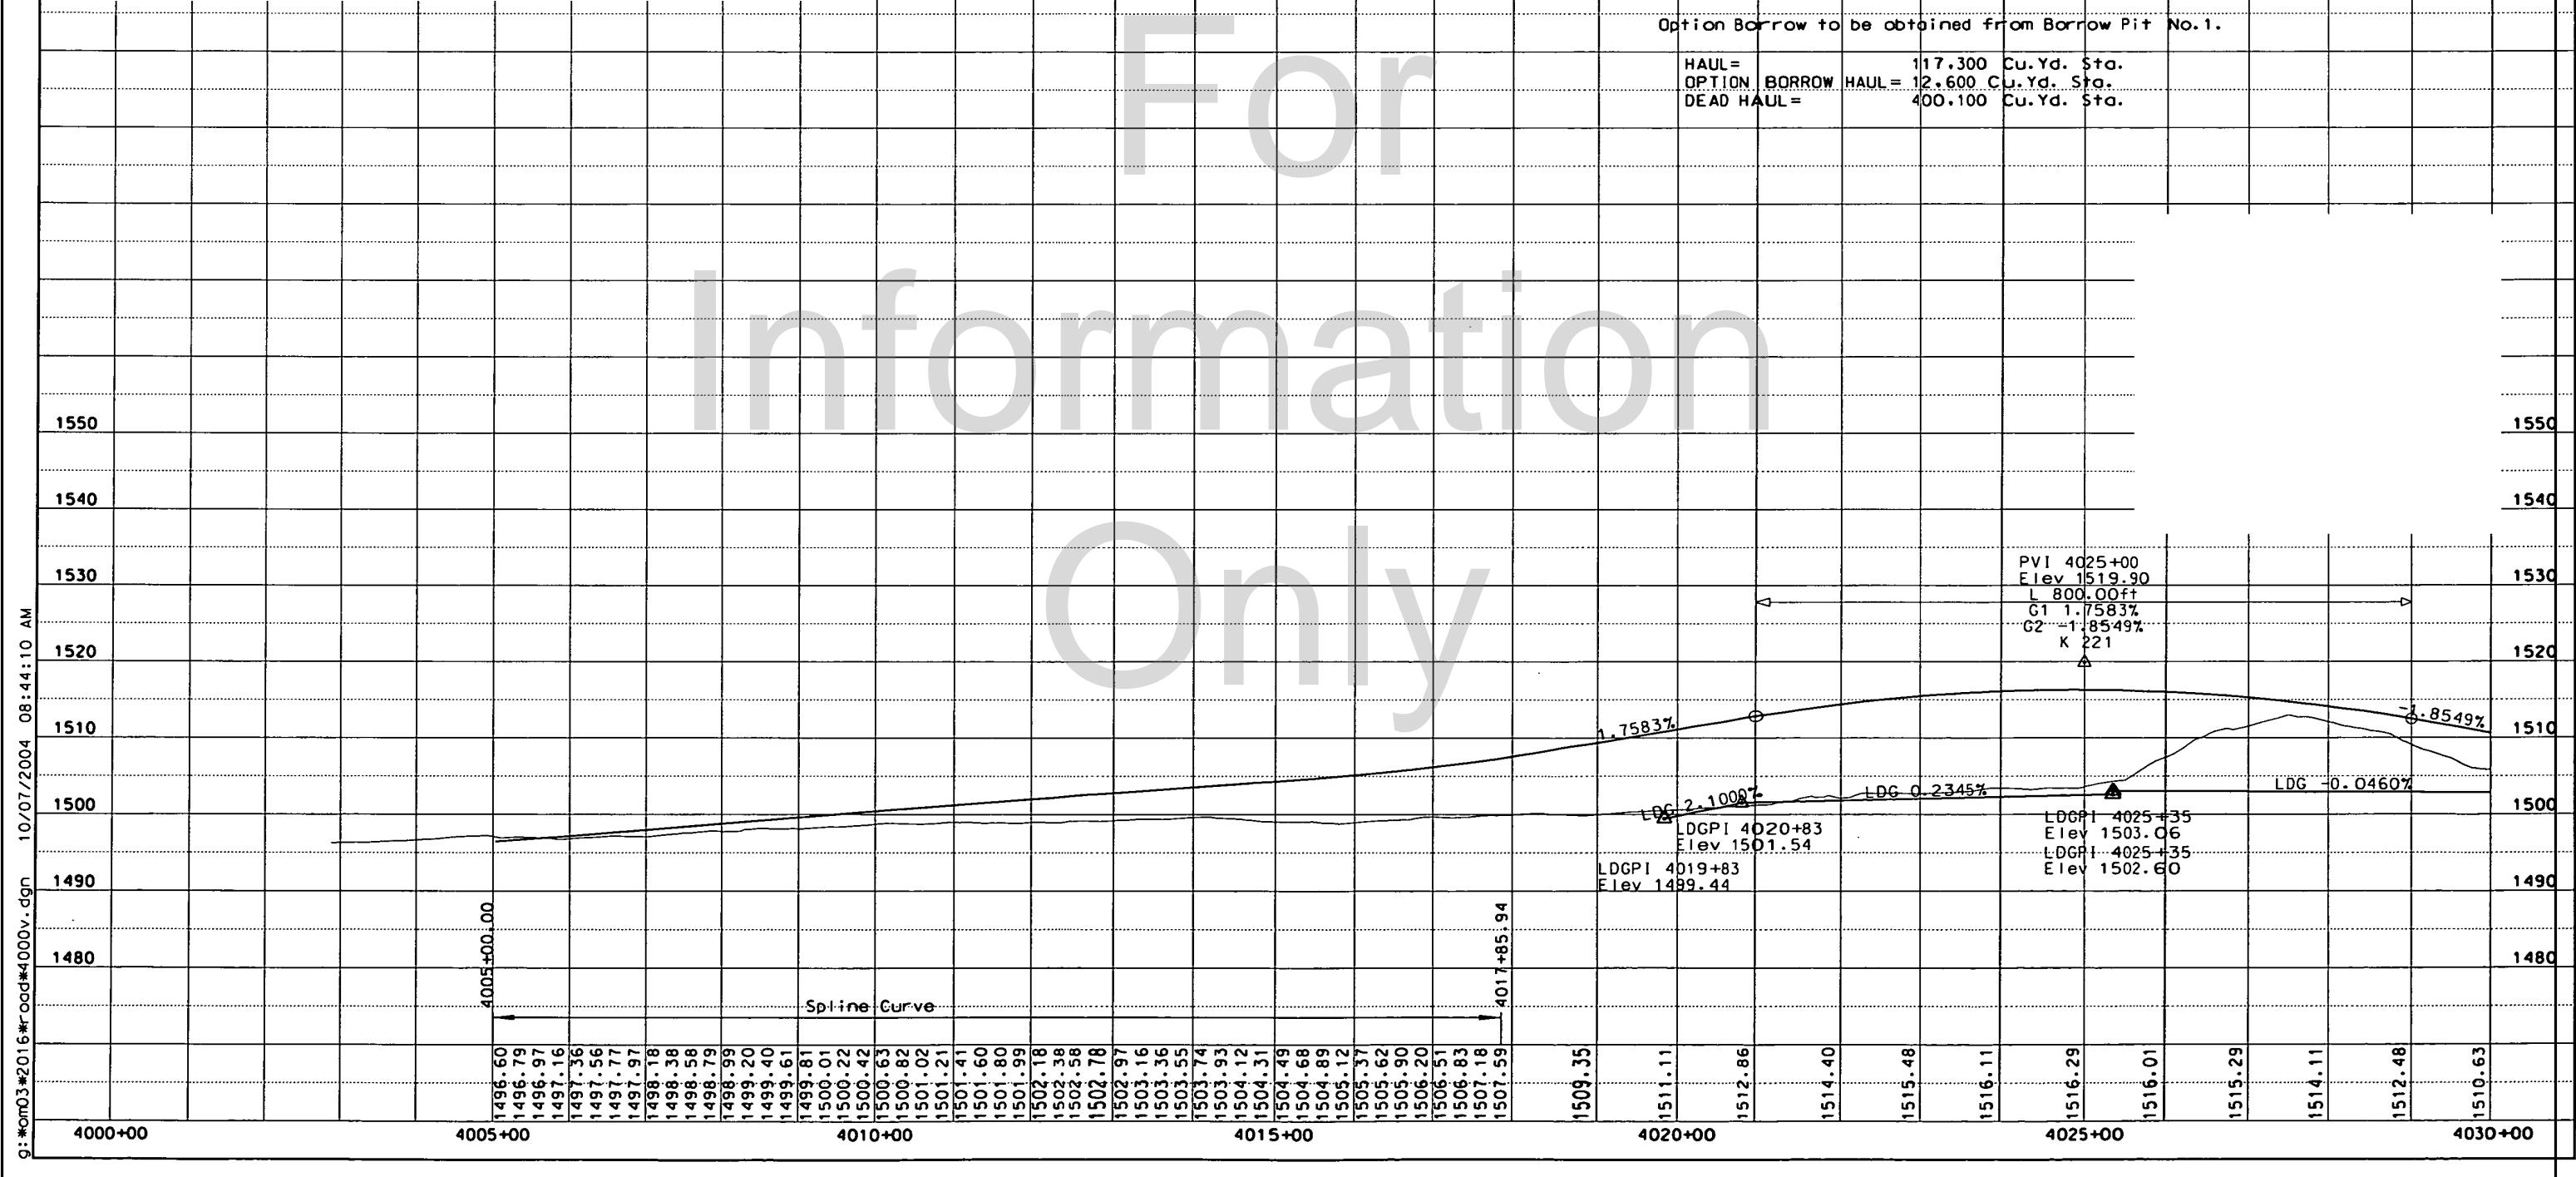

TEA INTERCHANGE
INTERSTATE 29 SOUTHBOUND
Sta. 59+00-66'L
Sta. 4026+39-31-R
4014+30-40'L

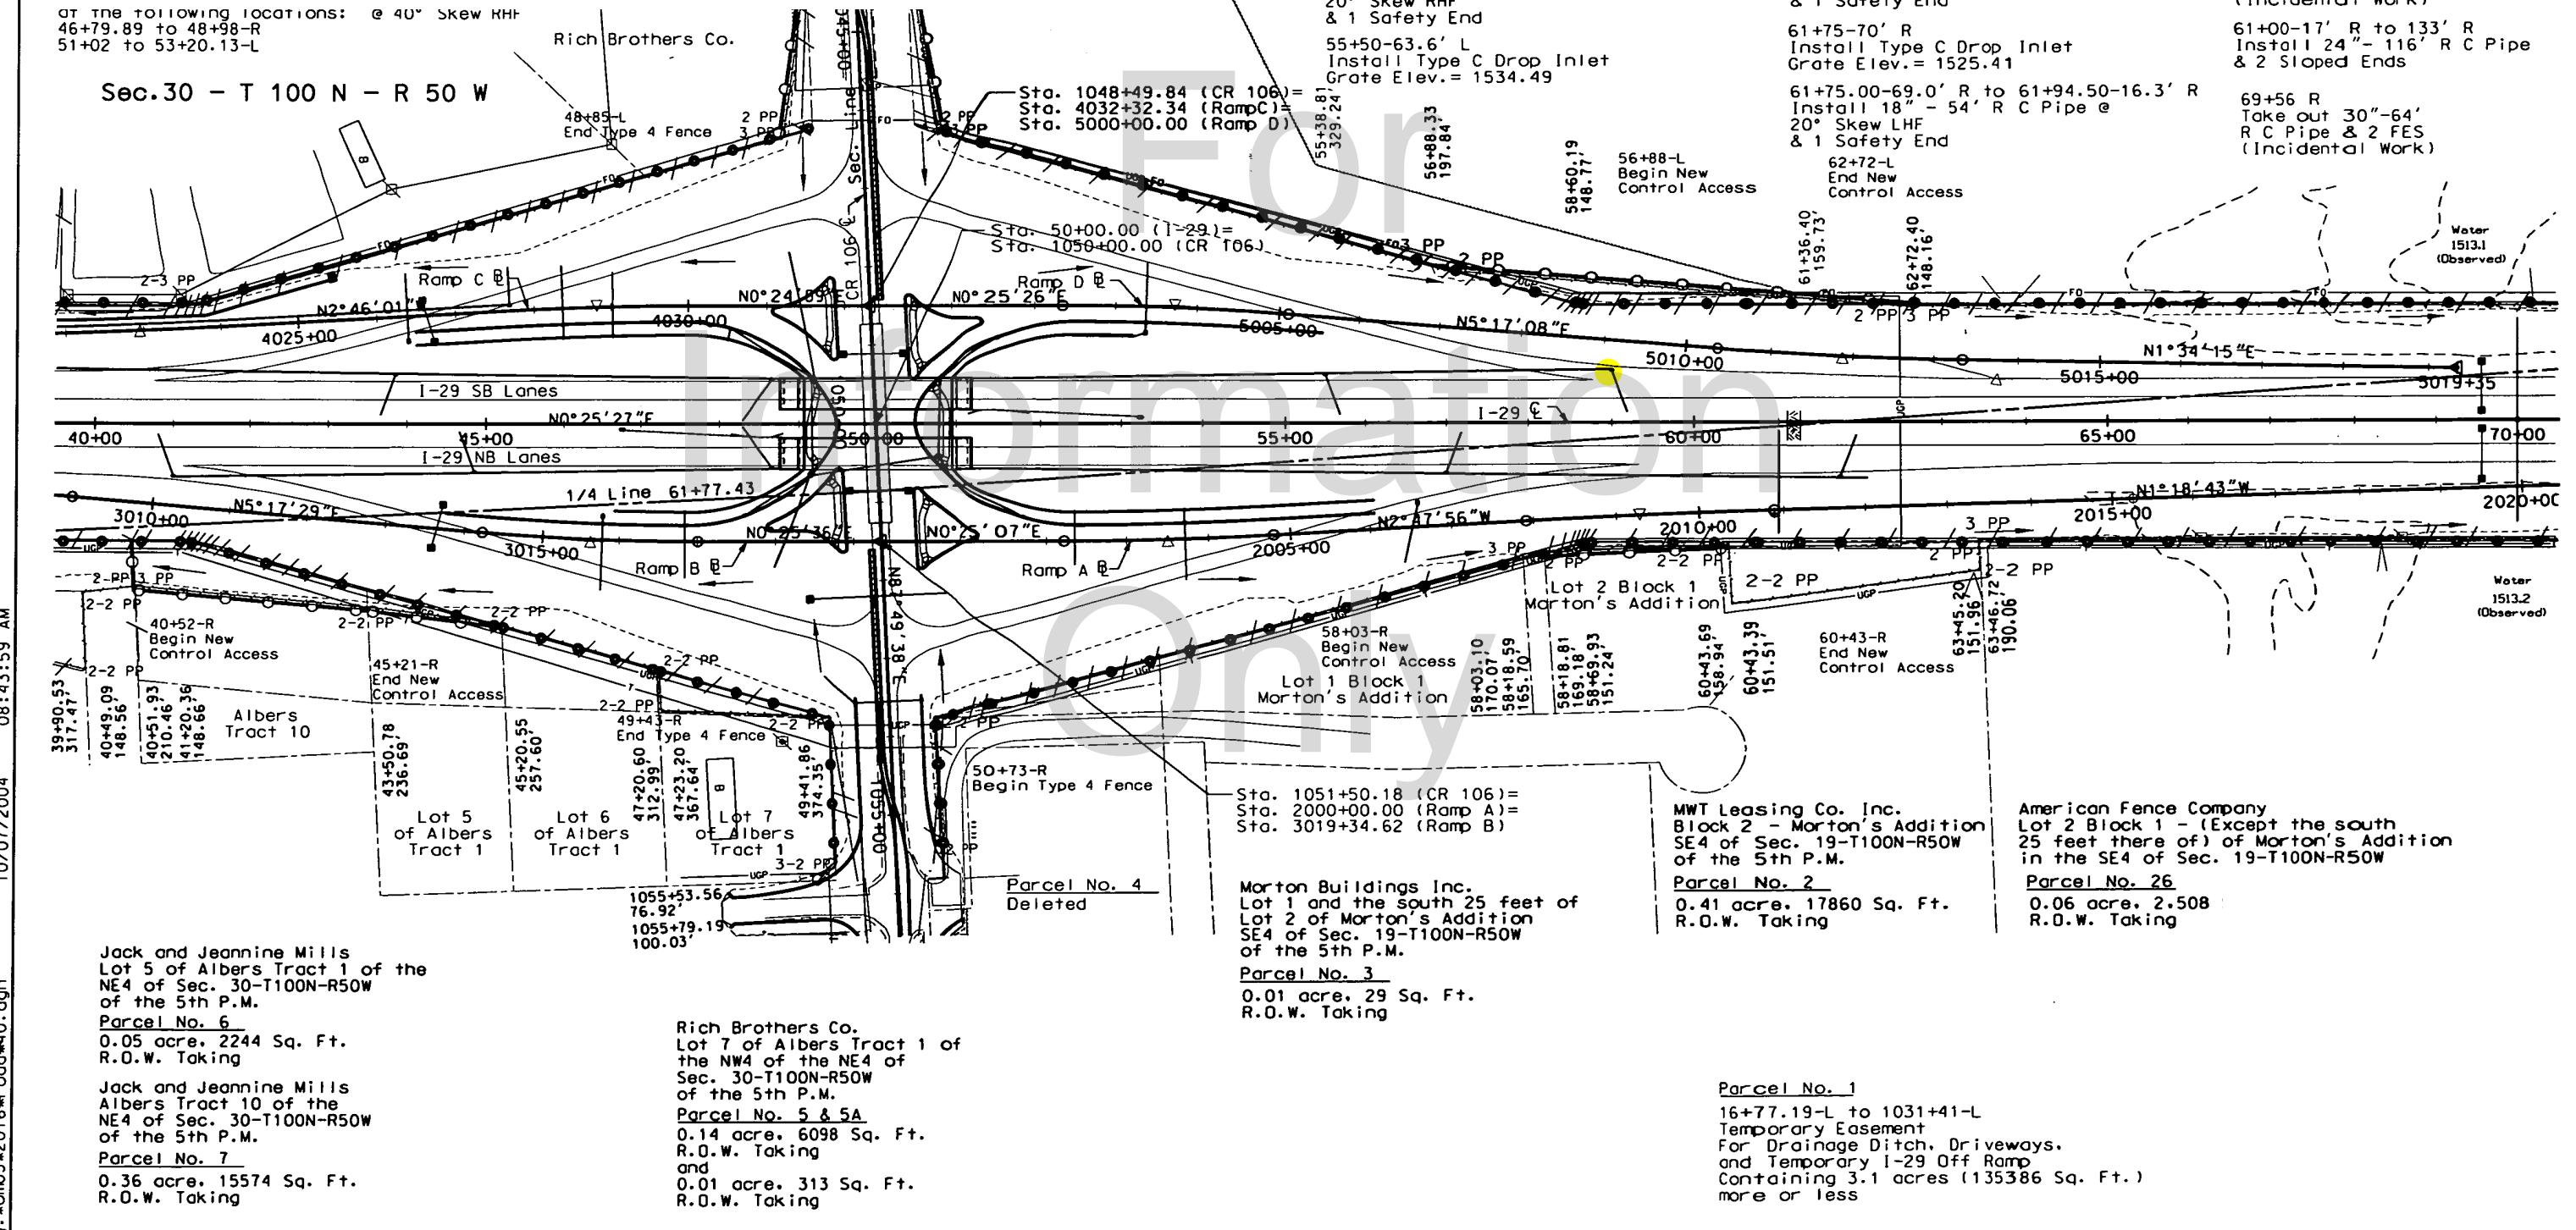

TEA INTERCHANGE
INTERSTATE 29 SOUTHBOUND
Sta. 59+00-66'L
Sta. 4026+39-31-R
4014+30-40'L


I - 29

| | | | |
|---------------------|---------|--------|---------|
| EXC | 13.816 | EBC | 133.391 |
| UNDERCUT | 8.743 | +20% | 26.678 |
| SELECT | 27.532 | 22.943 | 160.069 |
| SUBGRADE | | | |
| TOPPING | | | |
| OUT OF BALANCE EXC. | 45.986 | +20% | 4.589 |
| OPTION BORROW EXC. | 91.524 | 27.532 | 187.601 |
| | 187.601 | | |

Out of balance exc. is to be obtained as follows and will be paid for only once as unclassified excavation:
42.228 CY from CR 106 and 3.758 CY from Ramp A.


Option Borrow Excavation is to be obtained from Borrow Pit No. 1.

HAUL = 2,107.100 Cu.Yd. Sta.
OPTION BORROW HAUL = 640.700 Cu.Yd. Sta.
DEAD HAUL = 28,994.800 Cu.Yd. Sta.

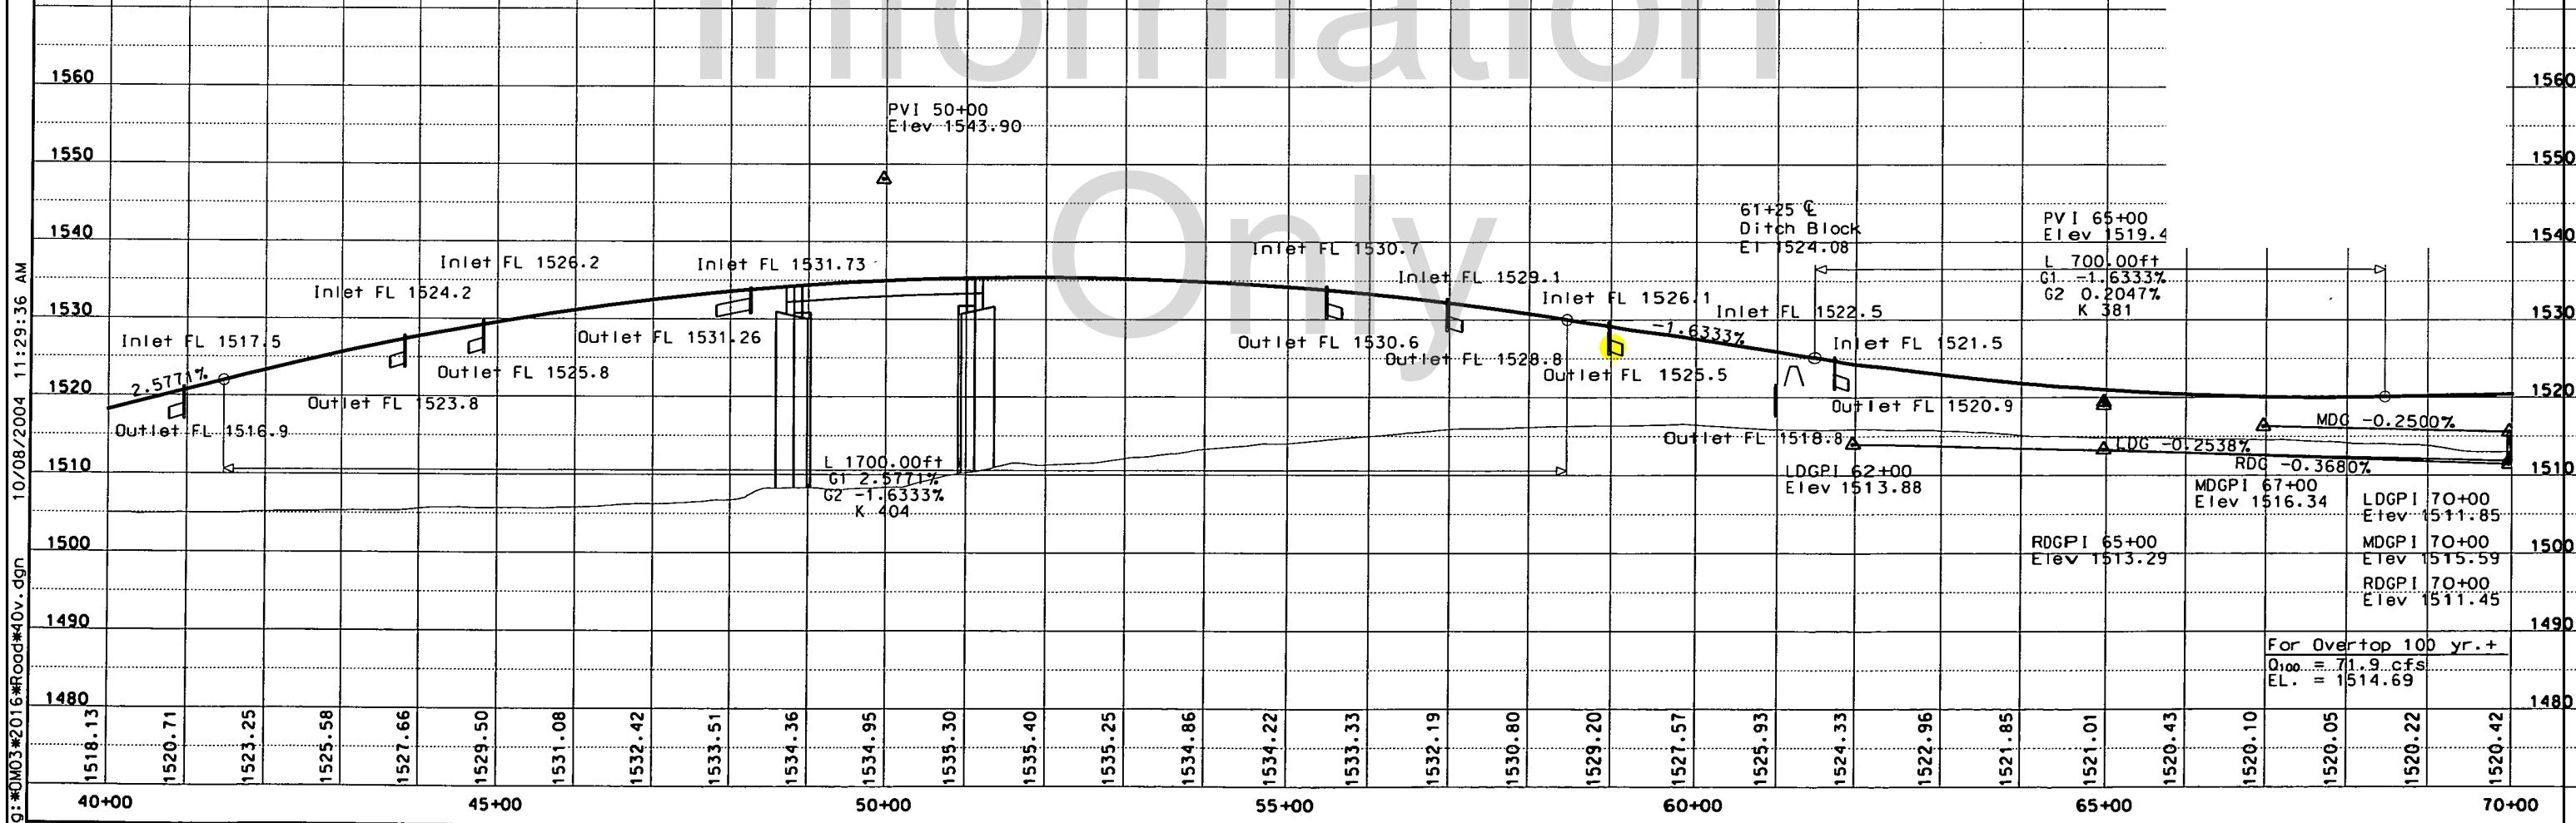


Sec. 24 - T101N R50W

SKUNK CREEK BRIDGE
INTERSTATE 29 SOUTHBOUND
Sta. 188+08-88'R (MRM 78.324)
Sta. 191+49-88'R (MRM78.383)

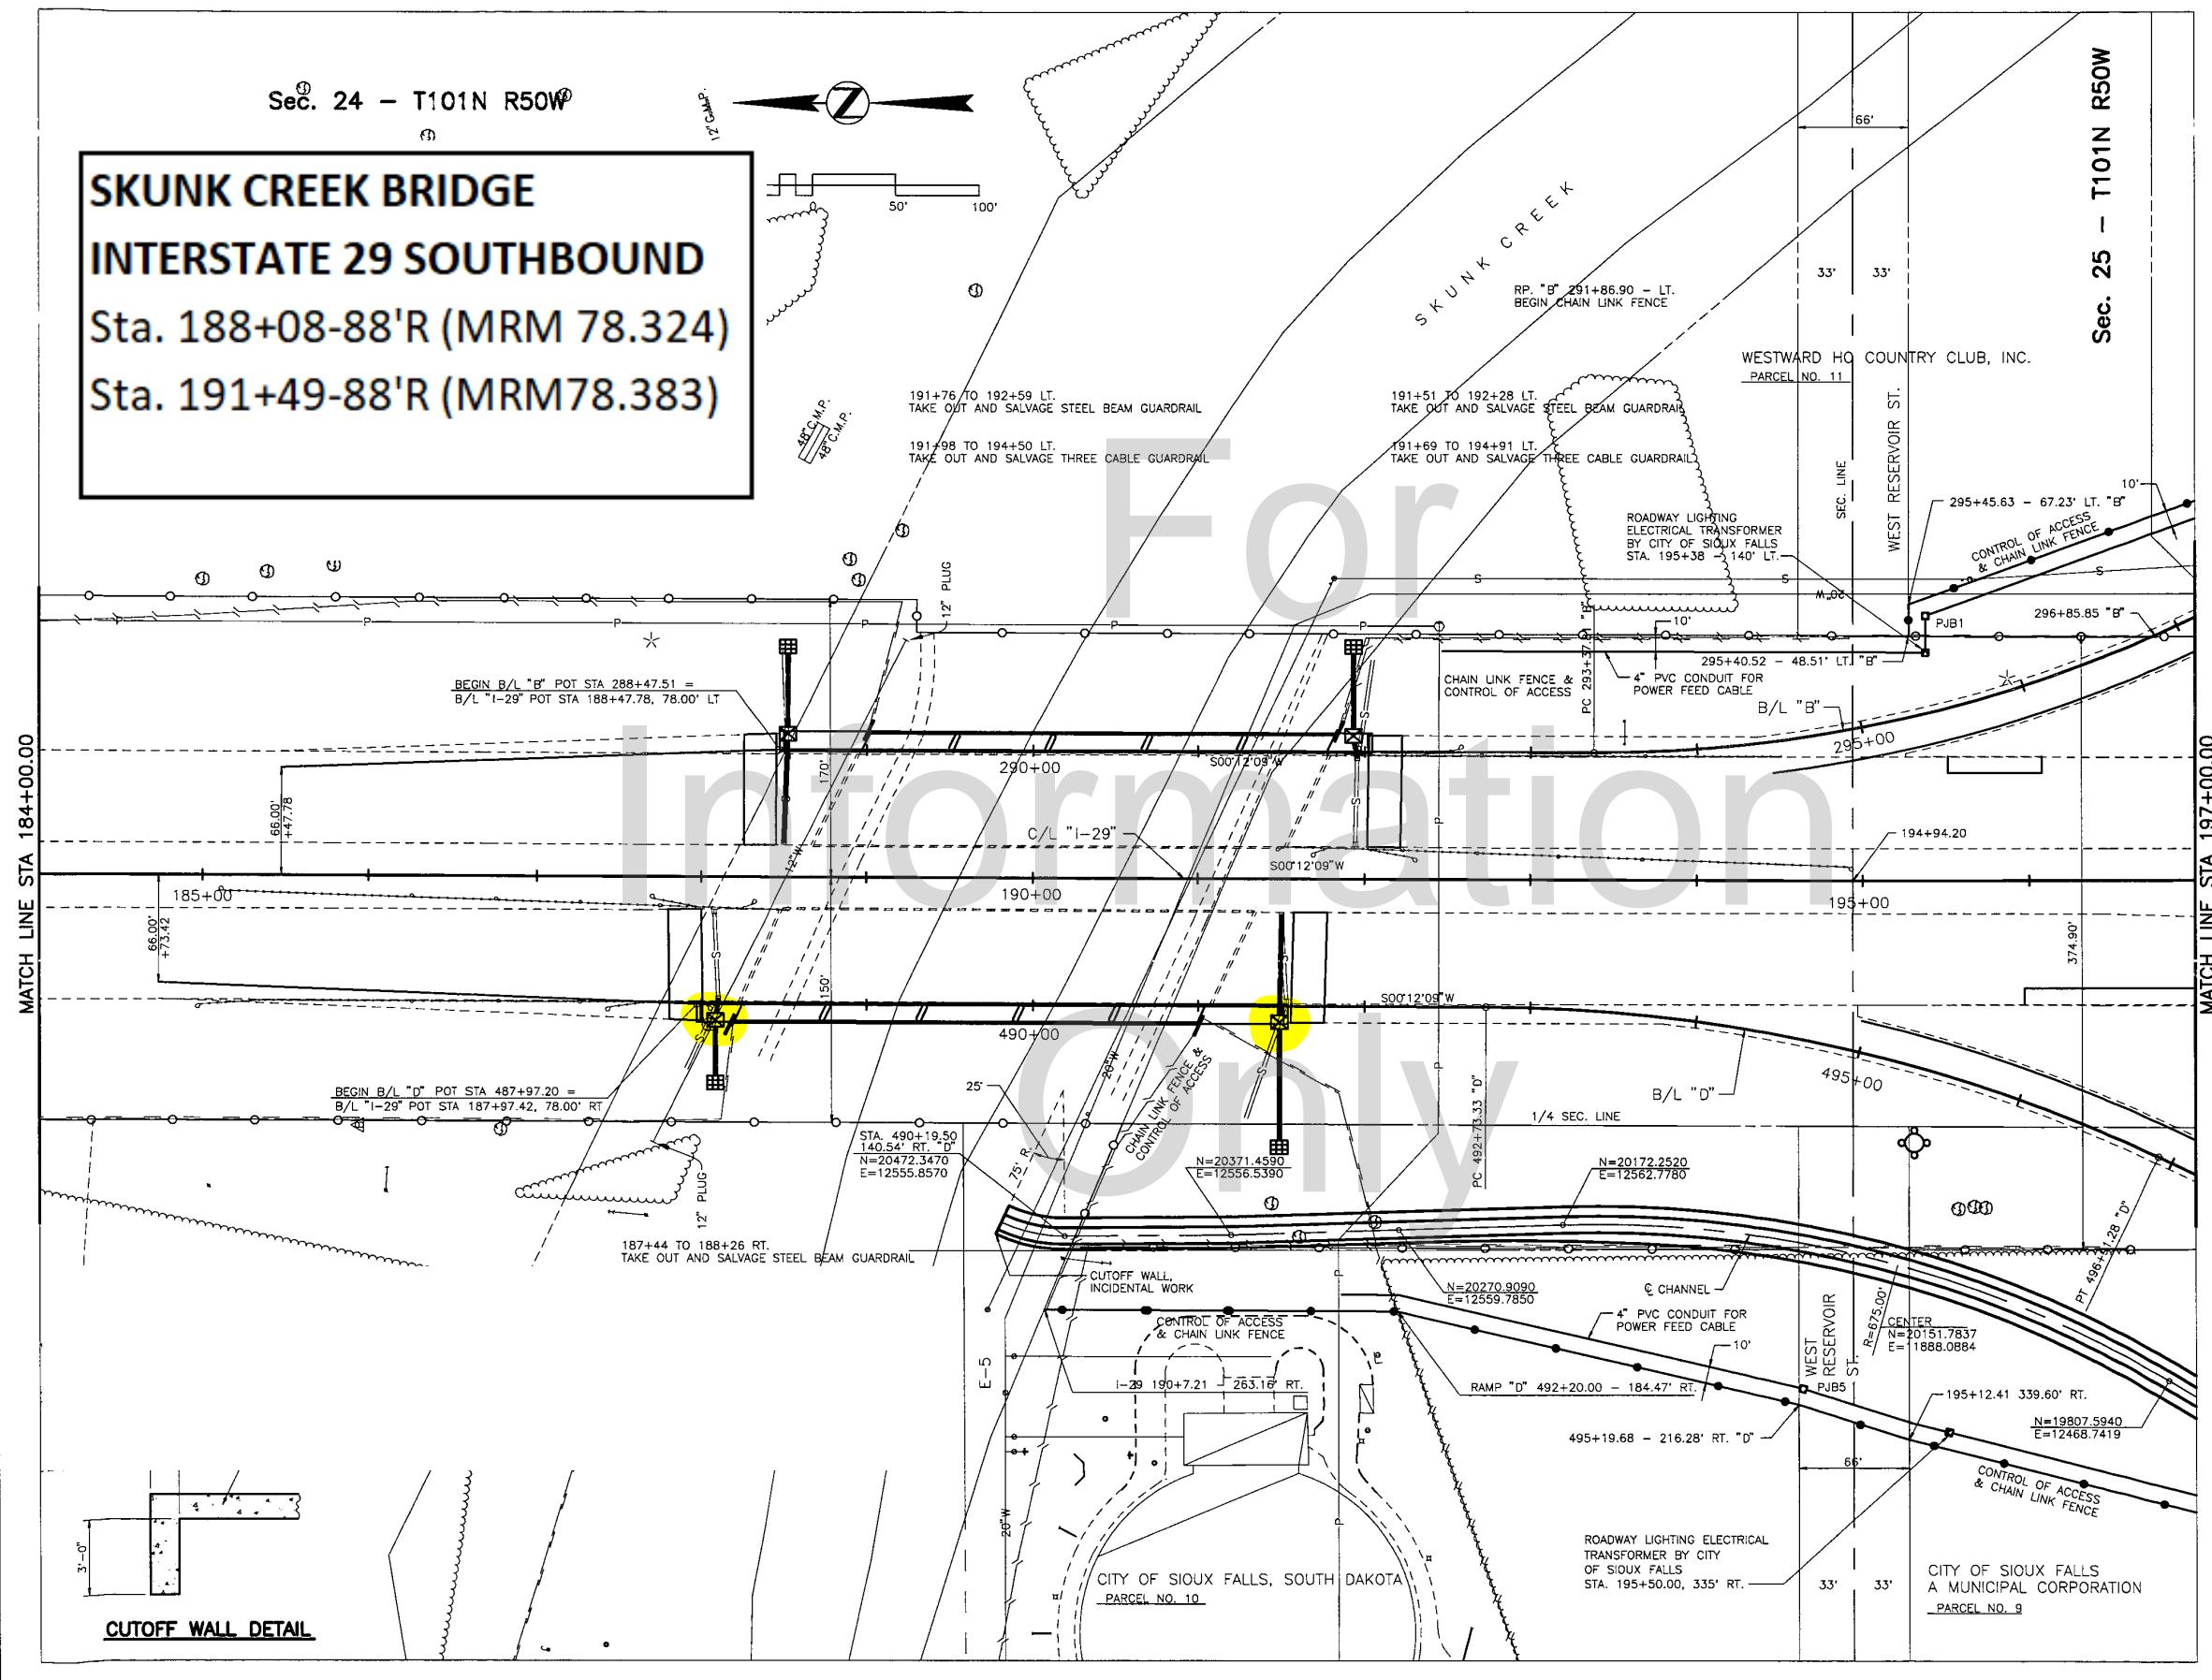

| | | | |
|-----------------------------|----------|-------|-----------------|
| STATE OF SOUTH DAKOTA | PROJECT | SHEET | TOTAL SHEETS |
| | 0001-271 | 13 | 43 |

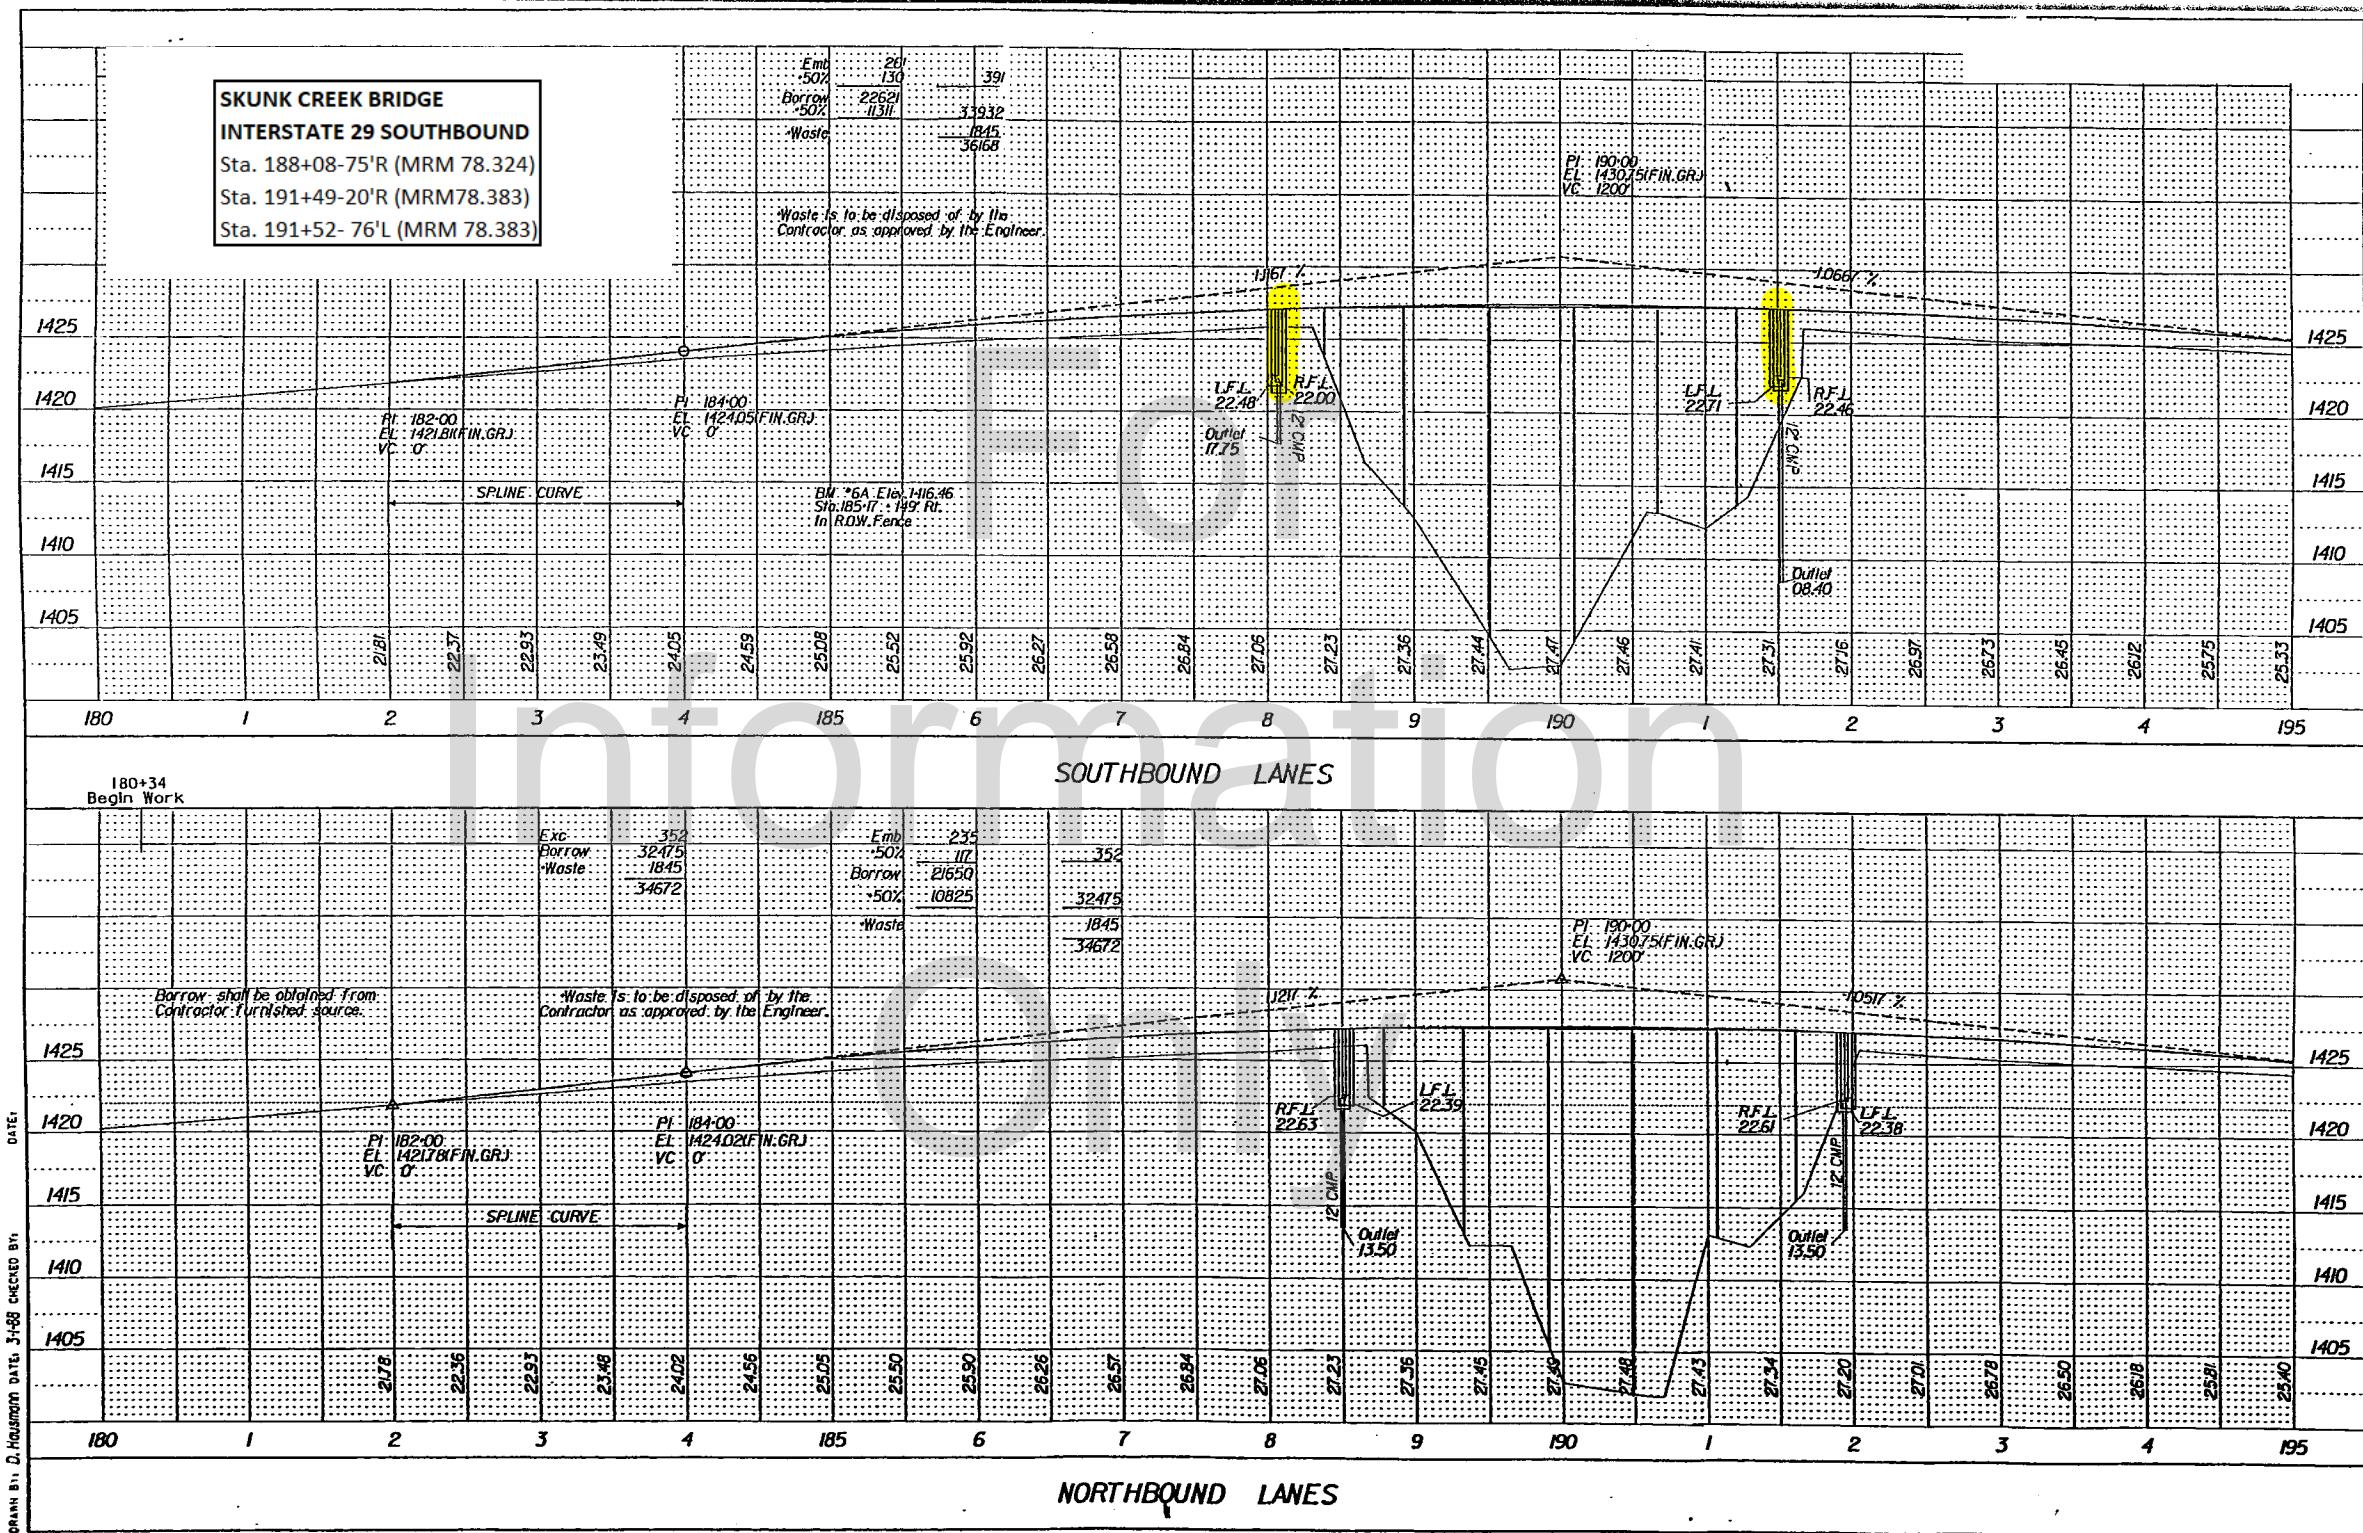

SHEET OF SHEETS

**CONSTRUCTION PLANS
INTERSTATE 29**

INSTALL 3'x4' TYPE C DROP INLETS AND
TYPE C FRAME, GRATE AND COLLAR
AT THE FOLLOWING LOCATIONS:

79+01.9 - 76.5' R
79+01.9 - 76.5' L
84+17.8 - 76.5' R
84+35.7 - 76.5' L
88+21.6 - 76.5' R
88+39.6 - 76.5' L
89+47.7 - 76.5' R
91+28.0 - 76.5' L

STATE OF
SOUTH
DAKOTA

PROJECT
0001-271

SHEET
14
TOTAL
SHEETS
43

**12TH STREET INTERCHANGE
INTERSTATE 29 NORTHBOUND**

Sta. 84+17-76'R (MRM 79.230)

Sta. 88+21-76'R (MRM 79.300)

INTERSTATE 29 SOUTHBOUND

Sta. 88+39-76'L (MRM 79.300)

Sta. 88+39-23'L (MRM 79.300)

Sta. 84+35-76'L (MRM 79.263)

27+60.3 - 23.5' L TO 32.4' R (RAMP B)
INSTALL 18"-54" RC PIPE
INSTALL 18"- (1) SAFETY END
(BETWEEN DROP INLETS)

14+05.2 - 183.2' L TO
17+64.5 - 55.8' L (RAMP D)
INSTALL 27"-452" RC PIPE
INSTALL 18"x27" RC TEE @ STA.
15+04.2 - 95.0' L
INSTALL 27"- (1) FLARED END

15+04.2 - 77.7' L TO
15+10.8 - 95.0' L (RAMP D)
INSTALL 18"-18" RC PIPE
(BETWEEN DROP INLET AND TEE)

16+68.9 - 20.5' L (RAMP A)
16+68.9 - 20.5' L TO
56.5' R (RAMP A)
INSTALL 18"-74" RC PIPE
(70' STR. AND 4' STR.)
INSTALL 18"- (1) 7' RC BEND
INSTALL 18"- (1) RCP SAFETY END

INSTALL 3'x10' TYPE S DROP INLET
AND TYPE S FRAME AND LID AT THE
FOLLOWING LOCATIONS:
27+60.3 - 23.5' L (RAMP B)
26+63.6 - 9.2' L (RAMP C)
15+04.2 - 77.7' L (RAMP D)

ST. INC.
NO. 35
85+60 - 306' L
END CHAIN
LINK FENCE

180 - 185' L
END CHAIN LINK FENCE
MATCH EXISTING

78+50 - 101.65' R TO
84+62.81 - 0' R
INSTALL MSE RETAINING WALL
WALL "B" (SEE SECTION E)

81+00 - 113.91' L TO
84+62.81 - 0' L
INSTALL MSE RETAINING WALL
WALL "C" (SEE SECTION E)

16+68.9 - 20.5' L (RAMP A)
16+68.9 - 20.5' L TO
56.5' R (RAMP A)
INSTALL 18"-74" RC PIPE
(70' STR. AND 4' STR.)
INSTALL 18"- (1) 7' RC BEND
INSTALL 18"- (1) RCP SAFETY END

INSTALL 2'x3' TYPE B DROP INLET AND
TYPE B FRAME, GRATE AND COLLAR AT
THE FOLLOWING LOCATION:

26+63.6 - 20.8' R (RAMP C)

87+10 - 338' L
BEGIN CHAIN
LINK FENCE


87+79 - 325' L
END CHAIN LINK FENCE
MATCH EXISTING

78+50 - 101.65' R TO
84+62.81 - 0' R
INSTALL (2) 374"-0" CONT.
COMP. GIRDER BRIDGES
(SEE SECTION E)

81+00 - 113.91' L TO
84+62.81 - 0' L
INSTALL MSE RETAINING WALL
WALL "A" (SEE SECTION E)

87+94.26 - 0' L TO
88+75 - 148.38' L
INSTALL MSE RETAINING WALL
WALL "D" (SEE SECTION E)


WEEG'S TRAILER PARK, INC.
PARCEL NO. 23

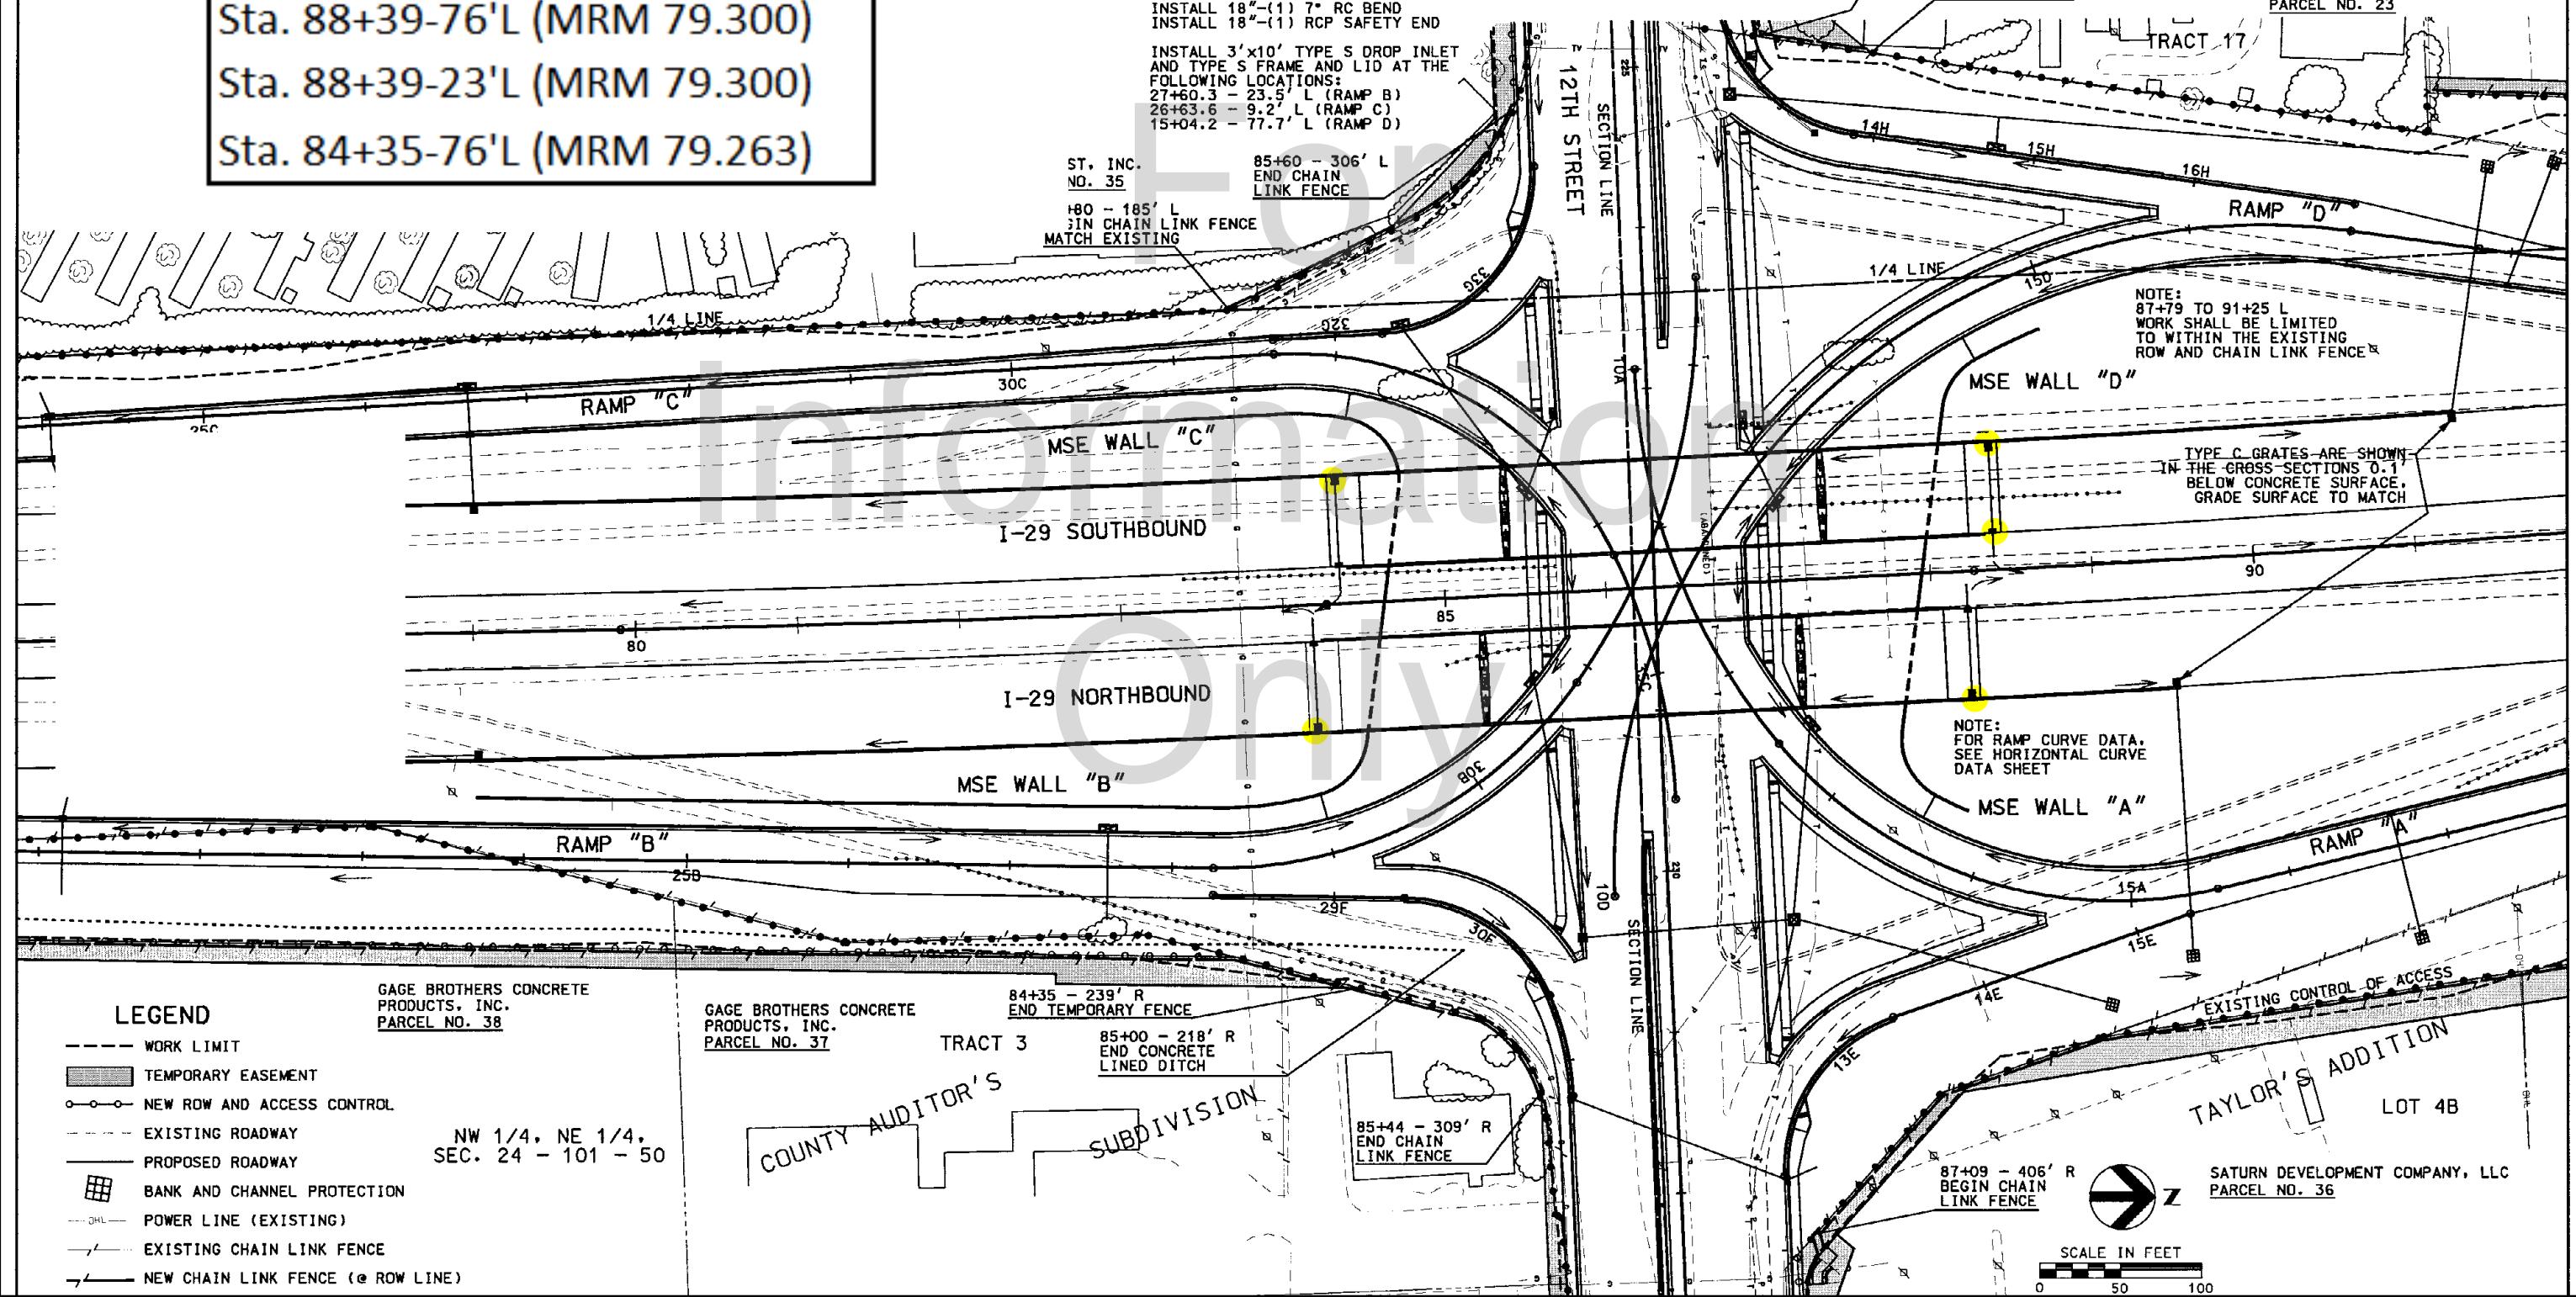

INTERSTATE 29

STATE OF
SOUTH
DAKOTAPROJECT
0001-271SHEET
15
TOTAL
SHEETS
43

FOR I-29 SOUTHBOUND EARTHWORK BALANCE EQUATION. SEE PREVIOUS SHEET FROM STA. 34+00 TO 49+00 AND EARTHWORK BALANCE SUMMARY SHEET ON SHEET X4

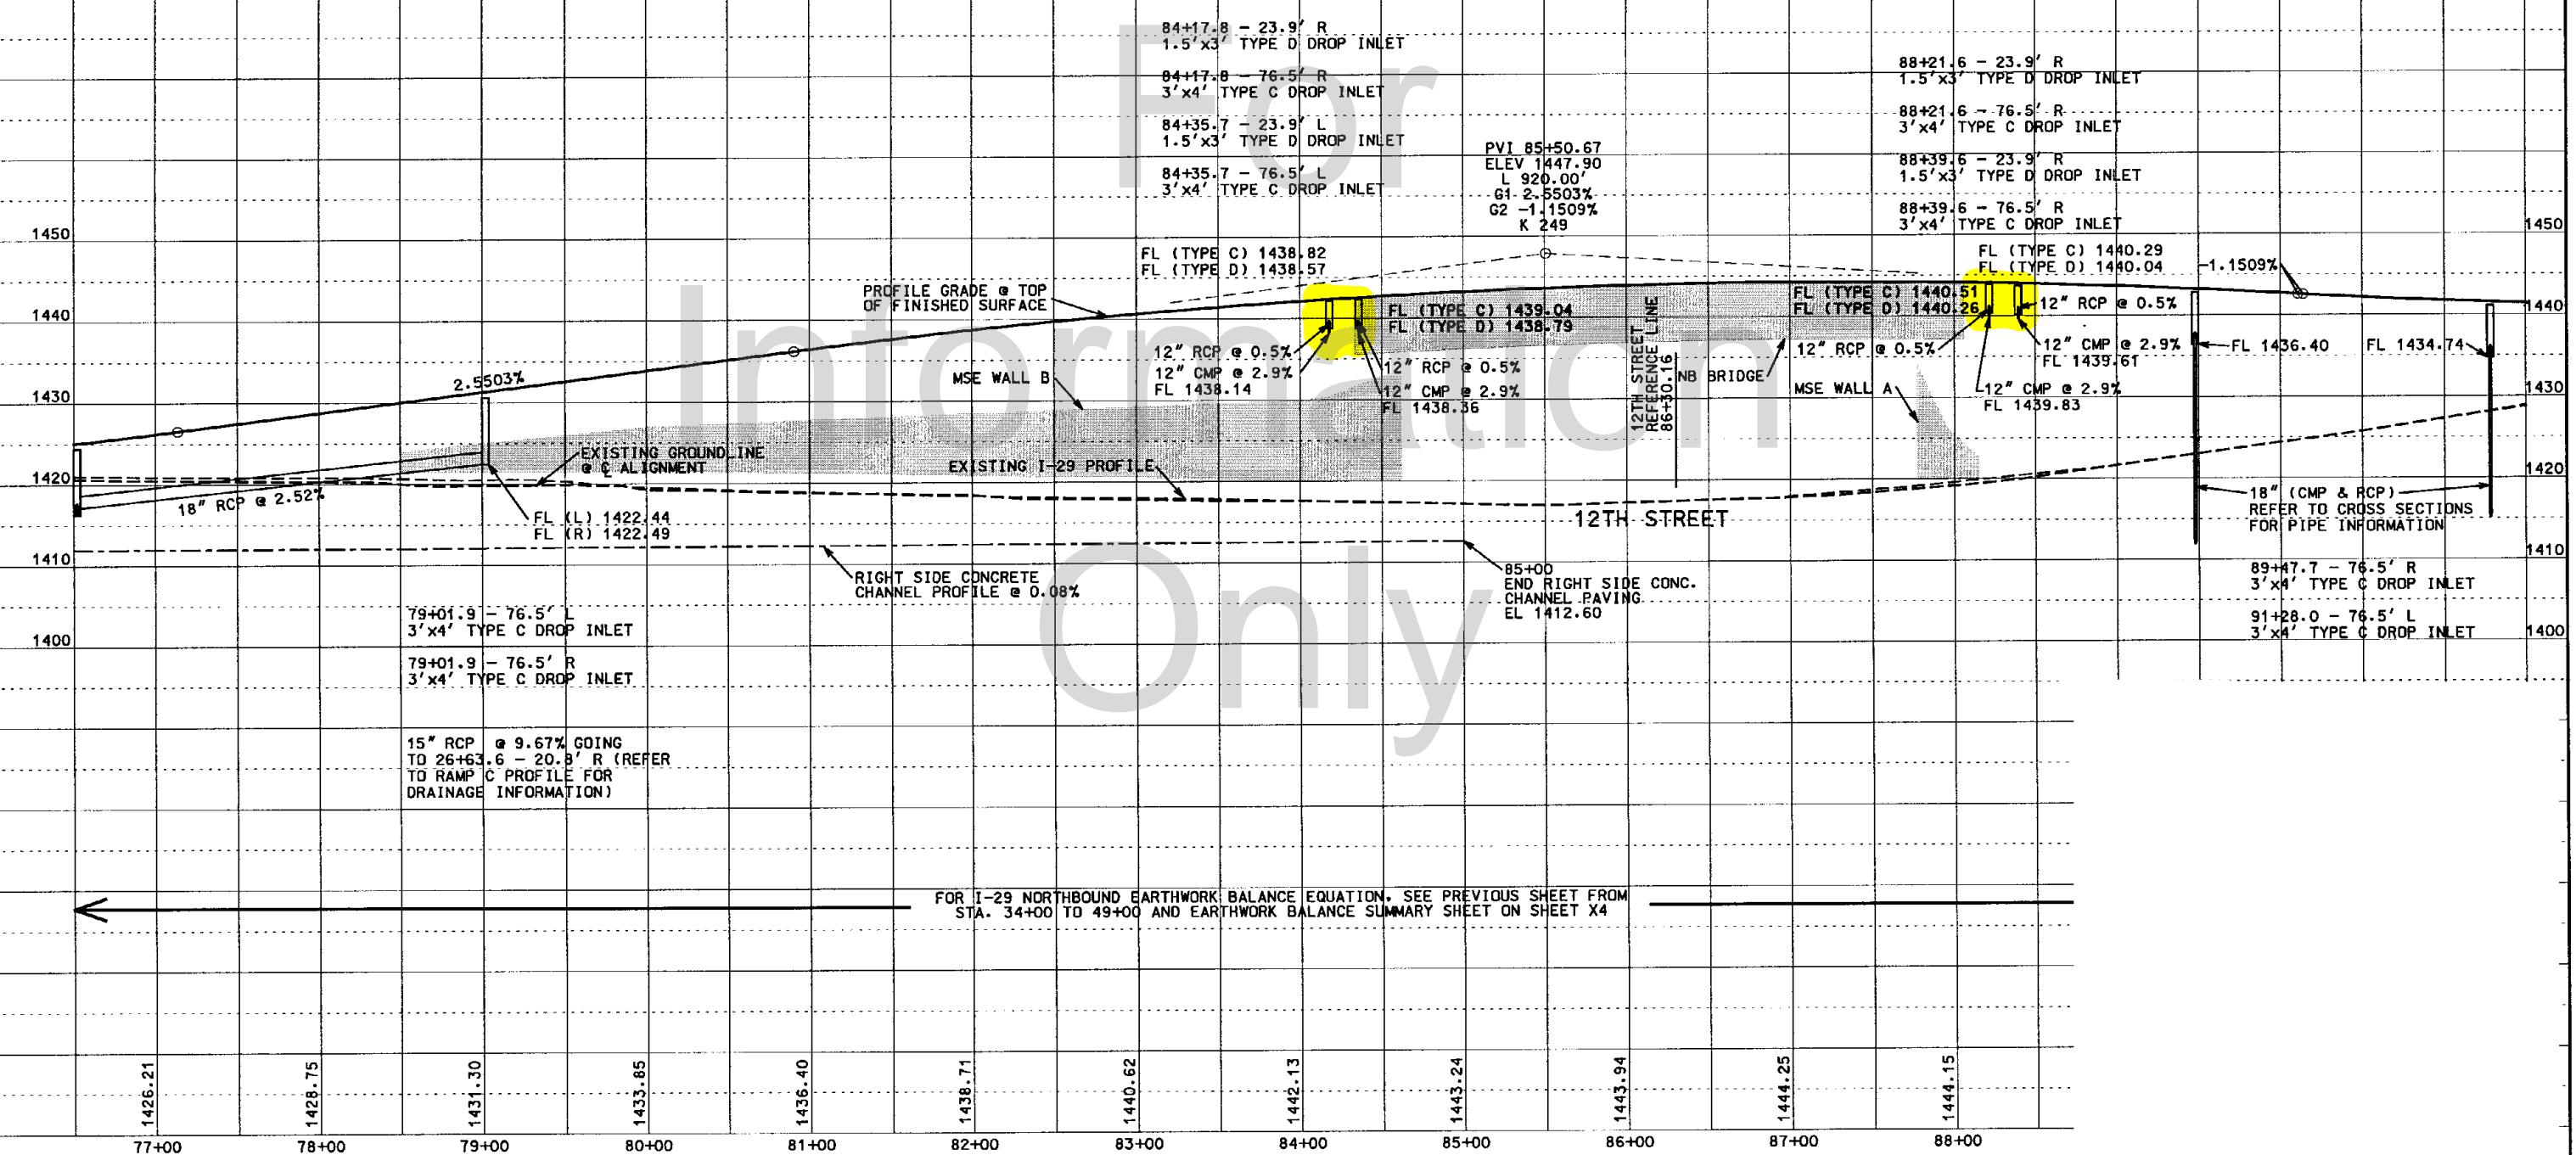

RAILROAD BRIDGE

INTERSTATE 29 NORTHBOUND

Sta. 100+58 MRM(79.530)

TO 100+43.55 R & L
2) 94'-0" COMP. STEEL
R BRIDGE
SECTION E)

1.55 - 193.0' L TO 193.0' R
MSE RETAINING WALL
SECTION E)

16.55 - 193.0' L TO 193.0' R
MSE RETAINING WALL
SECTION E)


SEC. 13-T101N-R50W

INSTALL 1.5'x3.0' TYPE D
DROP INLET, GRATE AND
COLLAR AT THE FOLLOWING
LOCATIONS:
100+58.47 - 105.6' L
100+58.47 - 23.9' L
100+58.47 - 23.9' R
100+58.47 - 105.6' R

STATE OF
SOUTH
DAKOTA

PROJECT
0001-271

SHEET
16
TOTAL
SHEETS
43

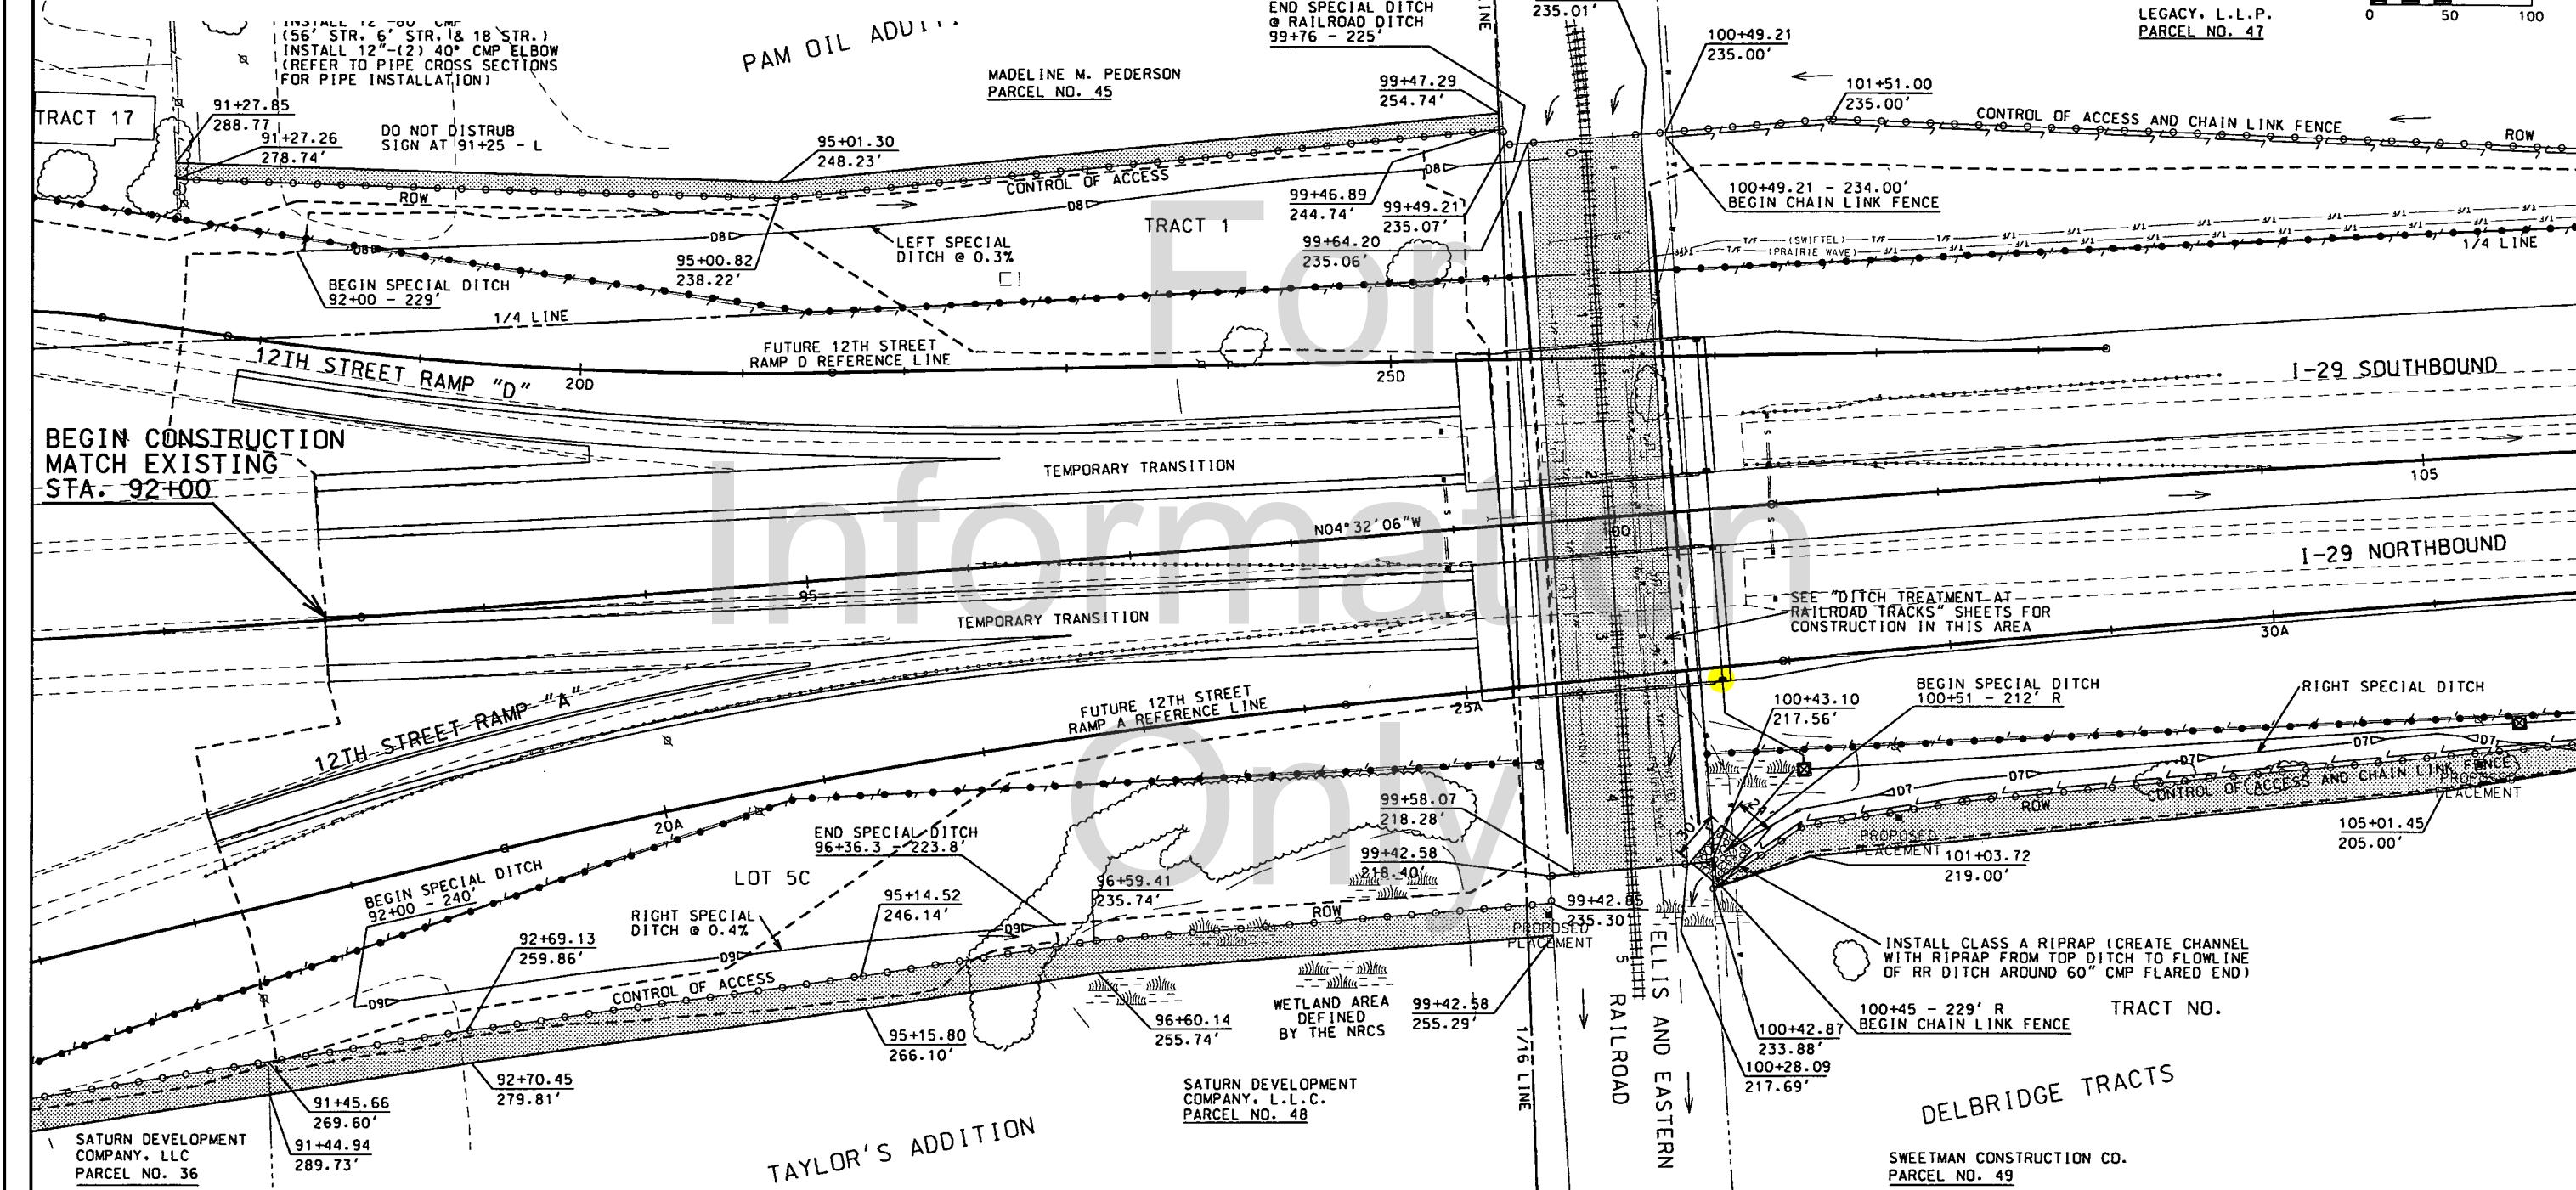

SEC. 13-T101N-R50W

PARCEL NO. 36

87+89.82 TO 91+45.66 (I-29) R
231+44.35 TO 235+18.36 (12TH STREET) L
TEMPORARY EASEMENT FOR
CUT/FILL CONTAINING 0.22 ACRES.
(9,481 SQ.FT.), MORE OR LESS

PARCEL NO. 48

91+44.94 TO 99+42.85 R
TEMPORARY EASEMENT FOR
FILL CONTAINING 0.37 ACRES.
(16,002 SQ.FT.), MORE OR LESS

PARCEL NO. 45

91+27.26 TO 99+47.29 L
TEMPORARY EASEMENT FOR
CUT/FILL CONTAINING 0.19 ACRES.
(8,200 SQ.FT.), MORE OR LESS

PARCEL NO. 46

99+58.07 TO 100+28.09 L-R
PERMANENT EASEMENT FOR
FILL CONTAINING 0.73 ACRES.
(31,723 SQ.FT.), MORE OR LESS
(THE AREA IS THE SUM OF C1-(SW1/4)
AND C1-(SE1/4))

PARCEL NO. 49

100+42.87 TO 107+82.31 R
TEMPORARY EASEMENT FOR
FILL CONTAINING 0.31 ACRES.
(13,324 SQ.FT.), MORE OR LESS

RAILROAD BRIDGE
INTERSTATE 29 NORTHBOUND
Sta. 100+58

| | | | |
|-----------------------------|----------|-------|-----------------|
| STATE OF SOUTH DAKOTA | PROJECT | SHEET | TOTAL SHEETS |
| | 0001-271 | 17 | 43 |

SEE ALSO EARTHWORK BALANCE SUMMARY IN SECTION X

A

I-29 SB FROM SOUTH PROJECT LIMITS TO MADISON ST
(PHASE 1 & 2 CONSTRUCTION)


EXCAVATION

| | |
|----------------------------|--------------------------|
| EXCAVATION UNDERCUTTING | 15.293 CY 1.365 CY |
| OBE FROM B | 16.658 CY 208.407 CY |
| OBE FROM C | 123.505 CY 348.570 CY |


| | |
|-------------------------|-------------------------------------|
| EMBANKMENT UNDERCUT | 242.242 CY +30% 72.673 CY |
| SELECT SUBGRADE TOPPING | 314.915 CY +30% 745 CY 969 CY |
| +30% | 25.143 CY 7.543 CY 32.686 CY |
| | 348.570 CY |

EMBANKMENT

OBE = OUT-OF-BALANCE EXCAVATION

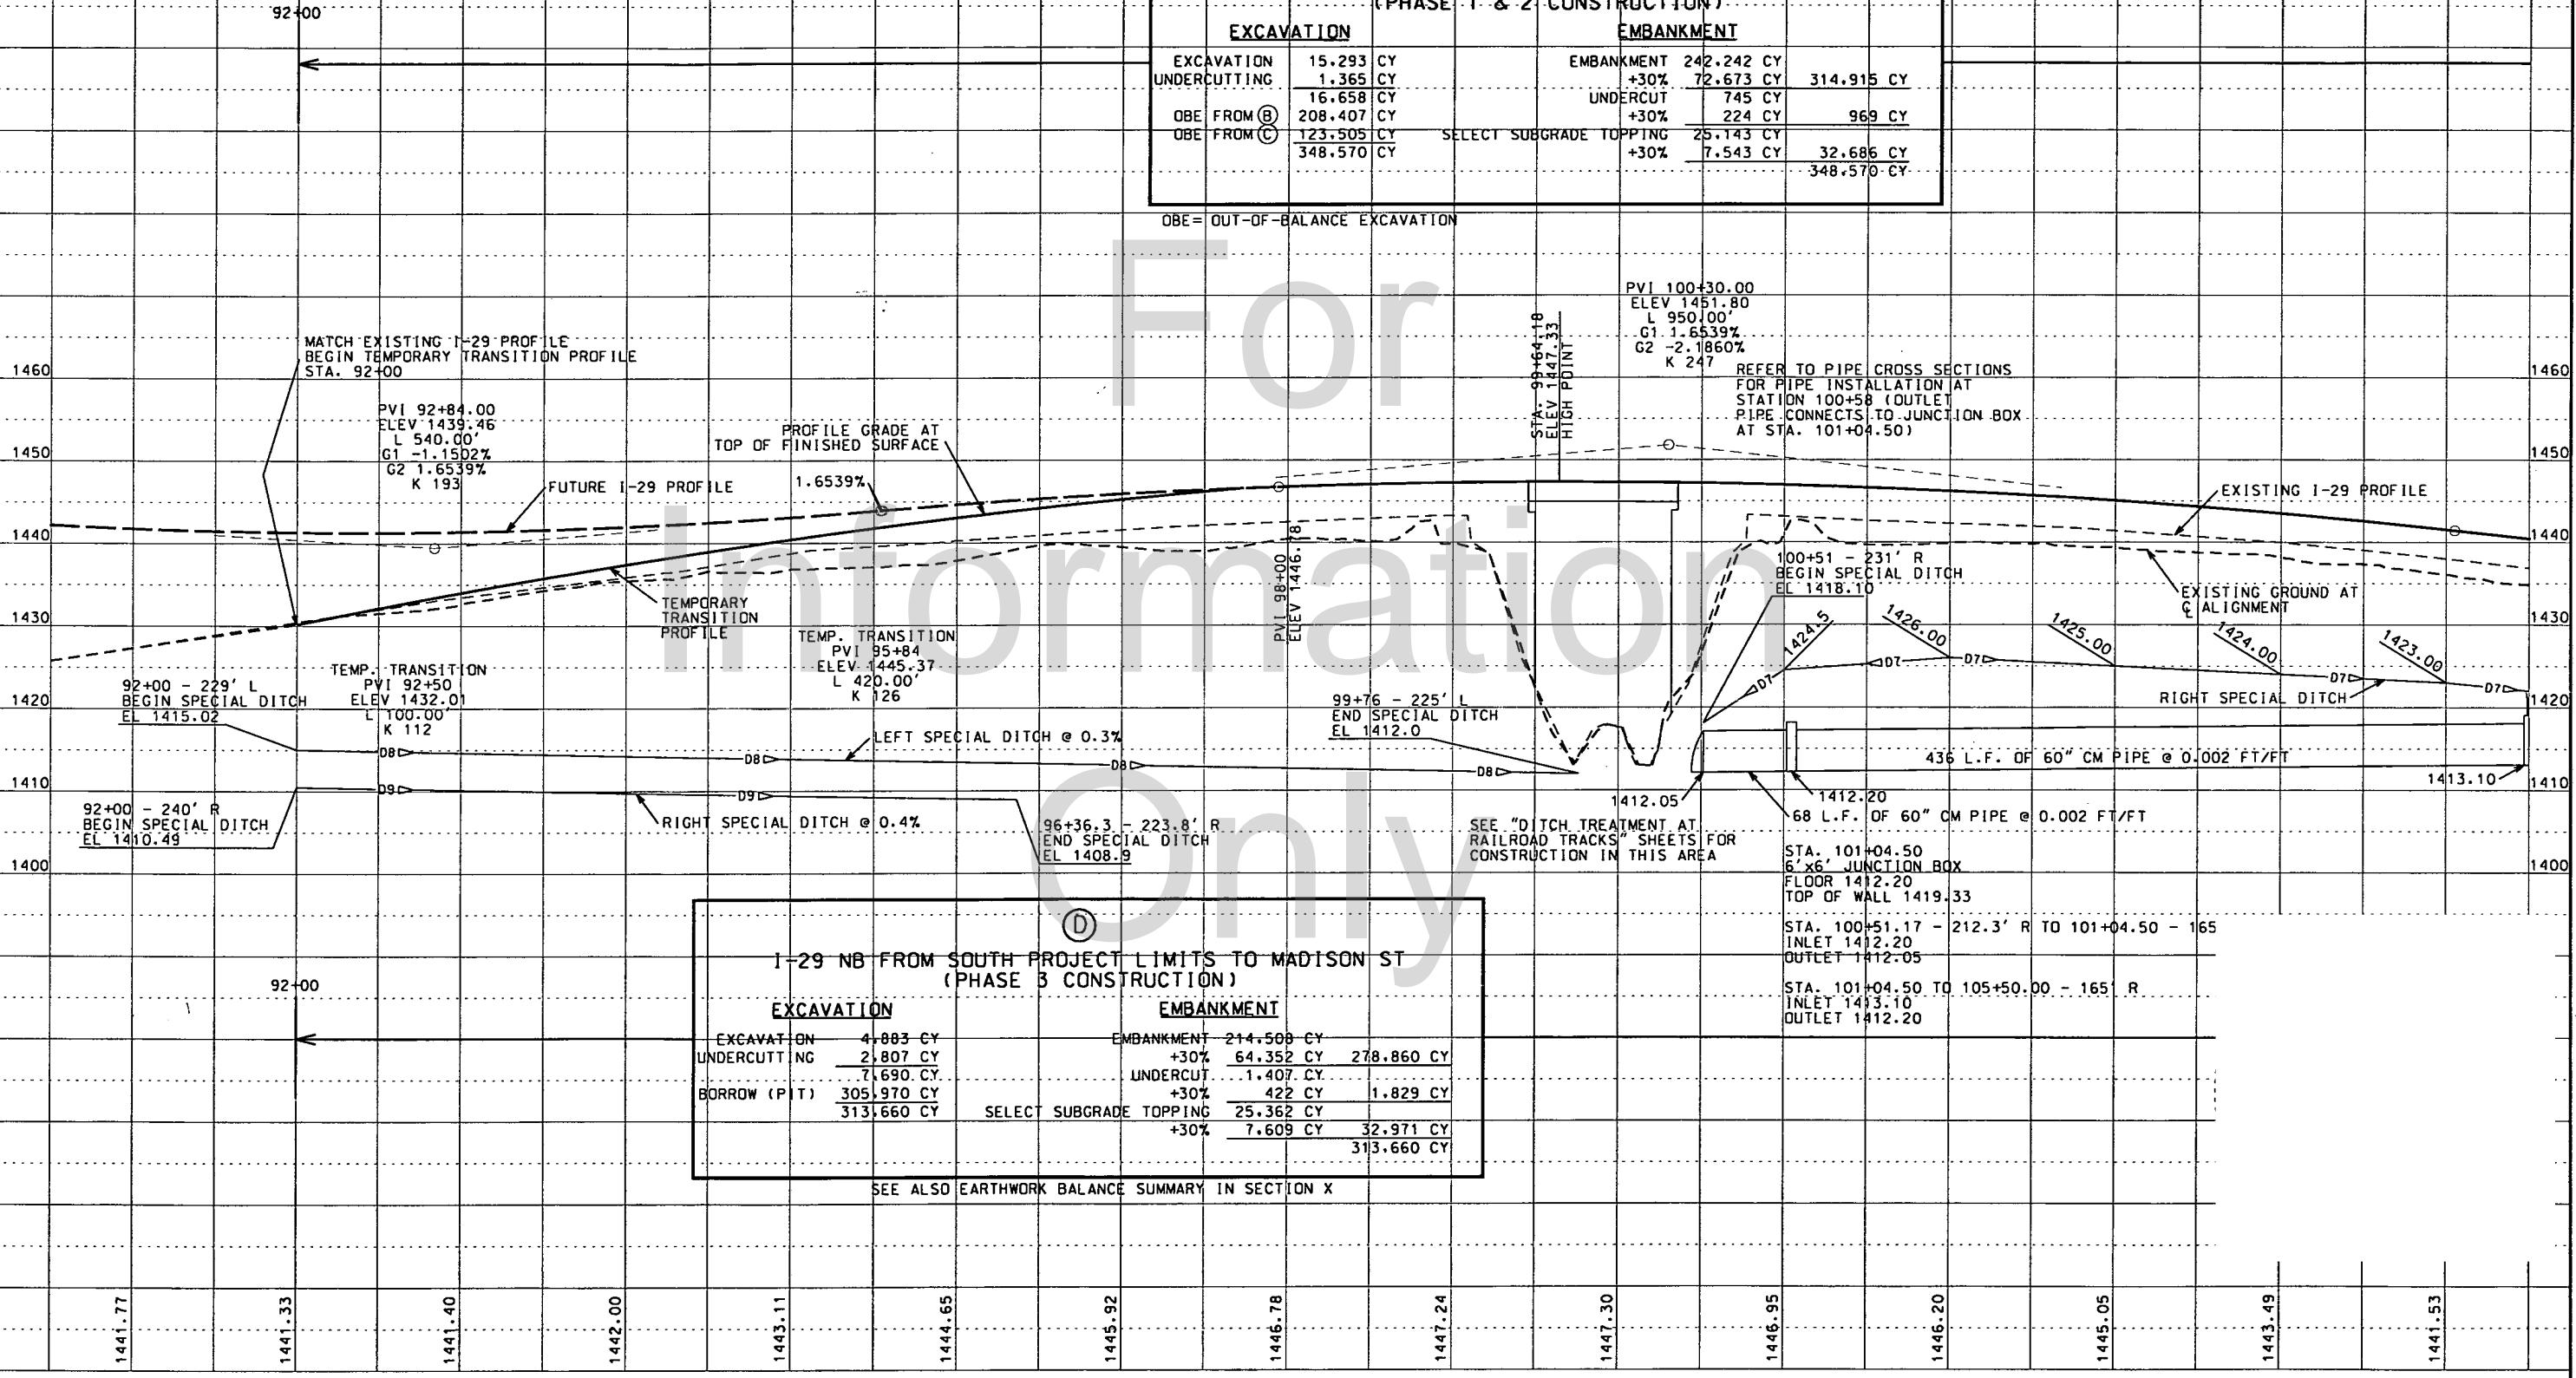


RAILROAD BRIDGE
INTERSTATE 29 NORTHBOUND
Sta. 100+58 MRM(79.530)

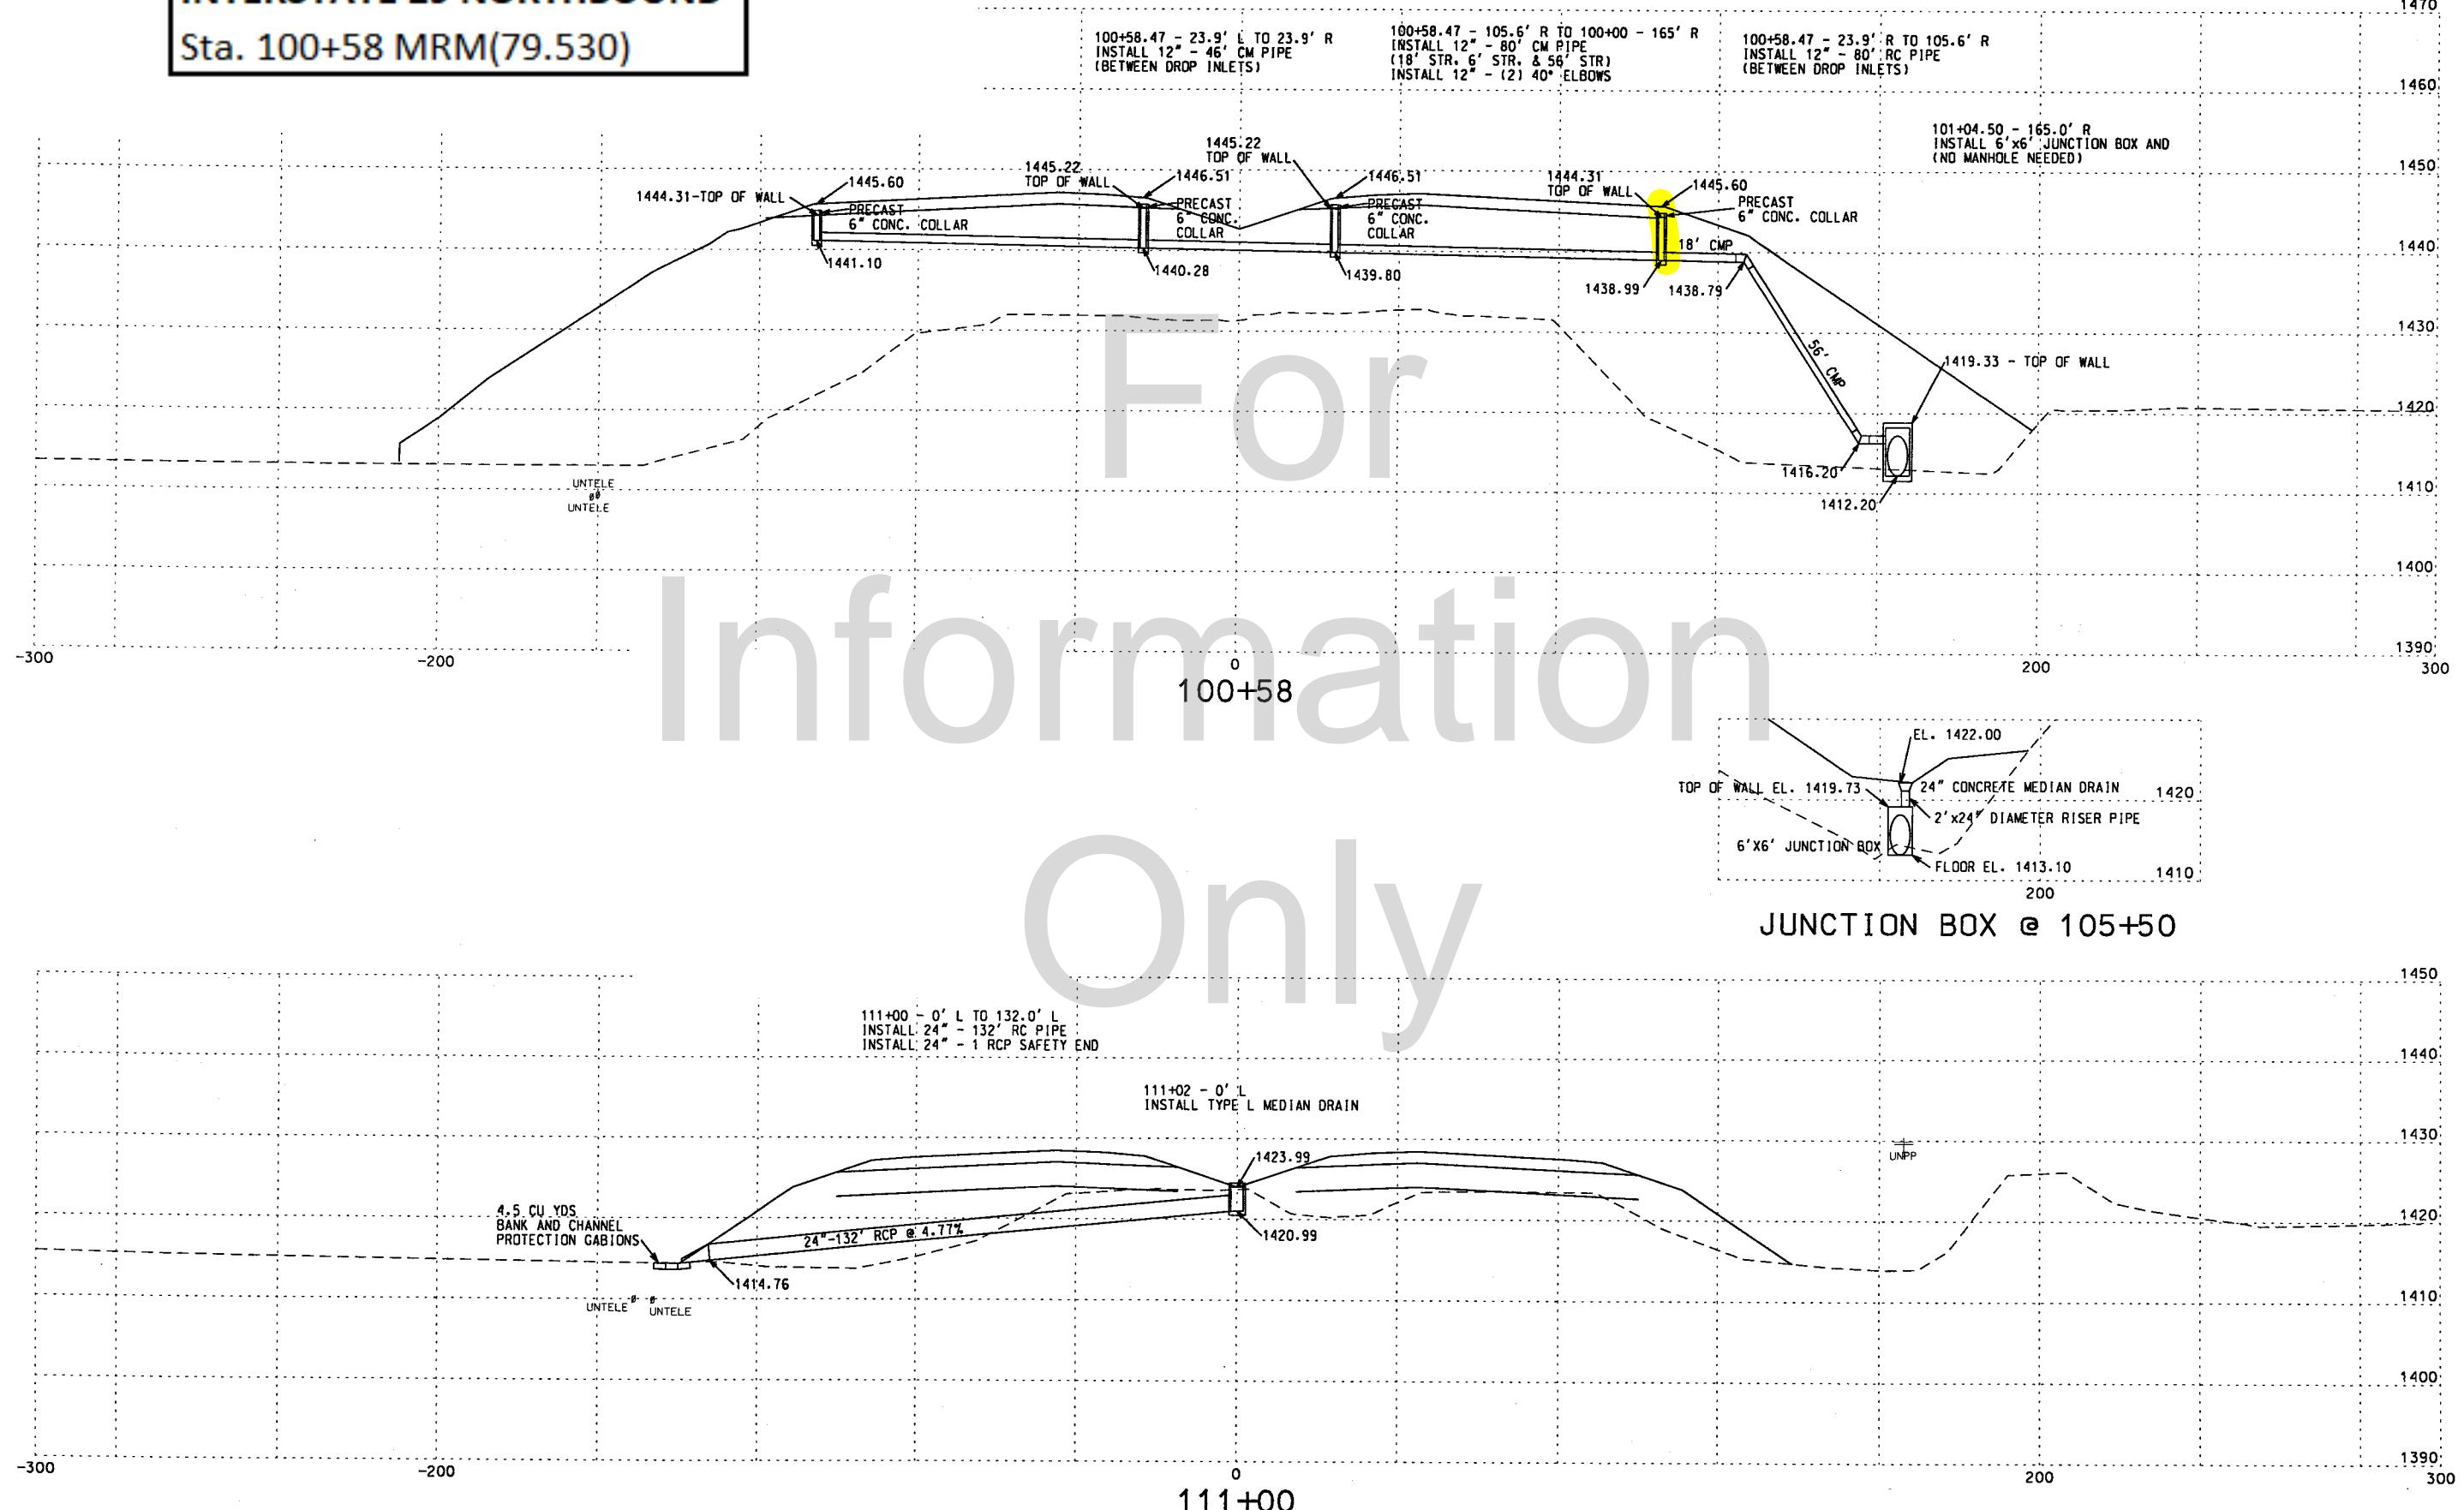

RAILROAD BRIDGE

INTERSTATE 29 NORTHBOUND

Sta. 100+58 MRM(79.530)

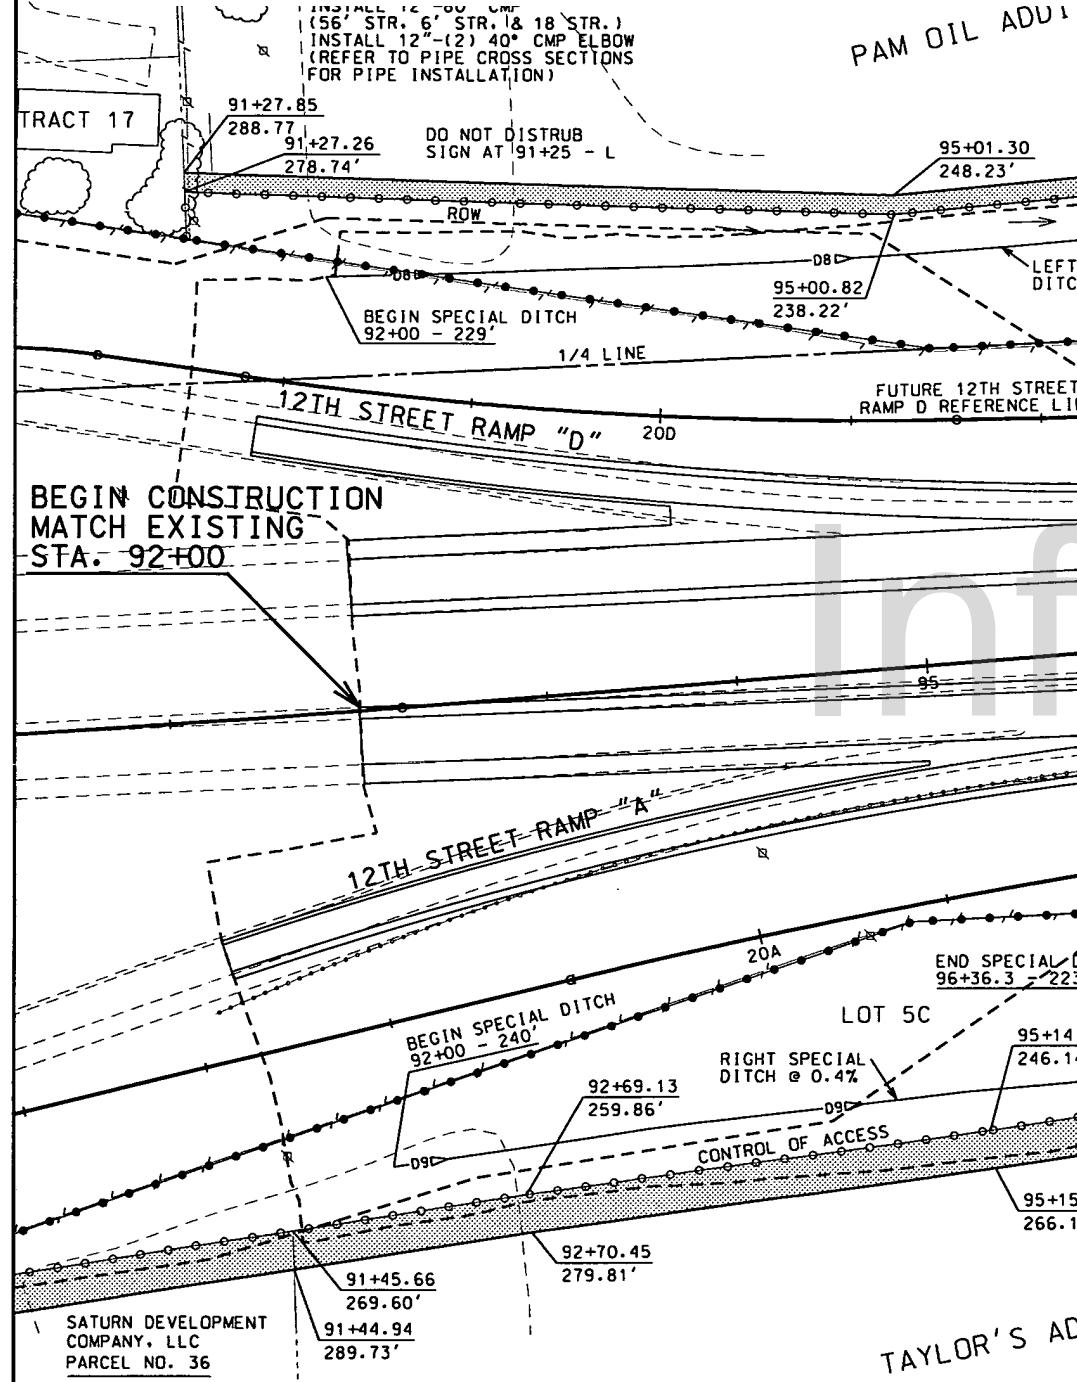

TO 100+43.55 R & L
2) 94'-0" COMP. STEEL
R BRIDGE
SECTION E)

1.55 - 193.0' L TO 193.0' R
MSE RETAINING WALL
SECTION E)

16.55 - 193.0' L TO 193.0' R
MSE RETAINING WALL
SECTION E)

INSTALL 1.5'x3.0' TYPE D
DROP INLET, GRATE AND
COLLAR AT THE FOLLOWING
LOCATIONS:
100+58.47 - 105.6' L
100+58.47 - 23.9' L
100+58.47 - 23.9' R
100+58.47 - 105.6' R

STATE OF
SOUTH
DAKOTA

PROJECT
0001-271

SHEET
19
TOTAL
SHEETS
43

SEC. 13-T101N-R50W

INSTALL 6'x6' JUNCTION BOX
(NO MANHOLE NEEDED)
AT THE FOLLOWING LOCATIONS:
101+04.50 - 165.0' R



SCALE IN FEET

0 50 100

LEGACY. L.L.P.
PARCEL NO. 47

NE 1/4, SW 1/4

I-29 SOUTHBOUND

105

I-29 NORTHBOUND

30A

RIGHT SPECIAL DITCH

PROPOSED PLACEMENT

ROW

105+01.45

205.00'

TRACT NO.

DELBRIDGE TRACTS

SWEETMAN CONSTRUCTION CO.
PARCEL NO. 49

ELLIS AND
EASTERN
RAILROAD

RAILROAD

ELLIS AND
EASTERN RAILROAD
PARCEL NO. 46

1/16 LINE

END SPECIAL DITCH
@ RAILROAD DITCH
99+76 - 225'

99+47.29
254.74'

99+46.89
244.74'

99+64.20
235.06'

99+49.21
235.07'

100+34.21
235.01'

100+49.21
235.00'

101+51.00
235.00'

100+49.21 - 234.00'
BEGIN CHAIN LINK FENCE


1/4 LINE

(SWIFTEL)
(PRAIRIE WAVE)

1/4 LINE


SEC. 13-T101N-R50W

MADISON STREET INTERCHANGE
INTERSTATE 29 NORTHBOUND
Sta. 138+78-76'R (MRM 80.250)
Sta. 142+82-76'R (MRM 80.330)
INTERSTATE 29 SOUTHBOUND
Sta. 138+78-76'L (MRM 80.325)
Sta. 142+82-76'L (MRM 80.406)

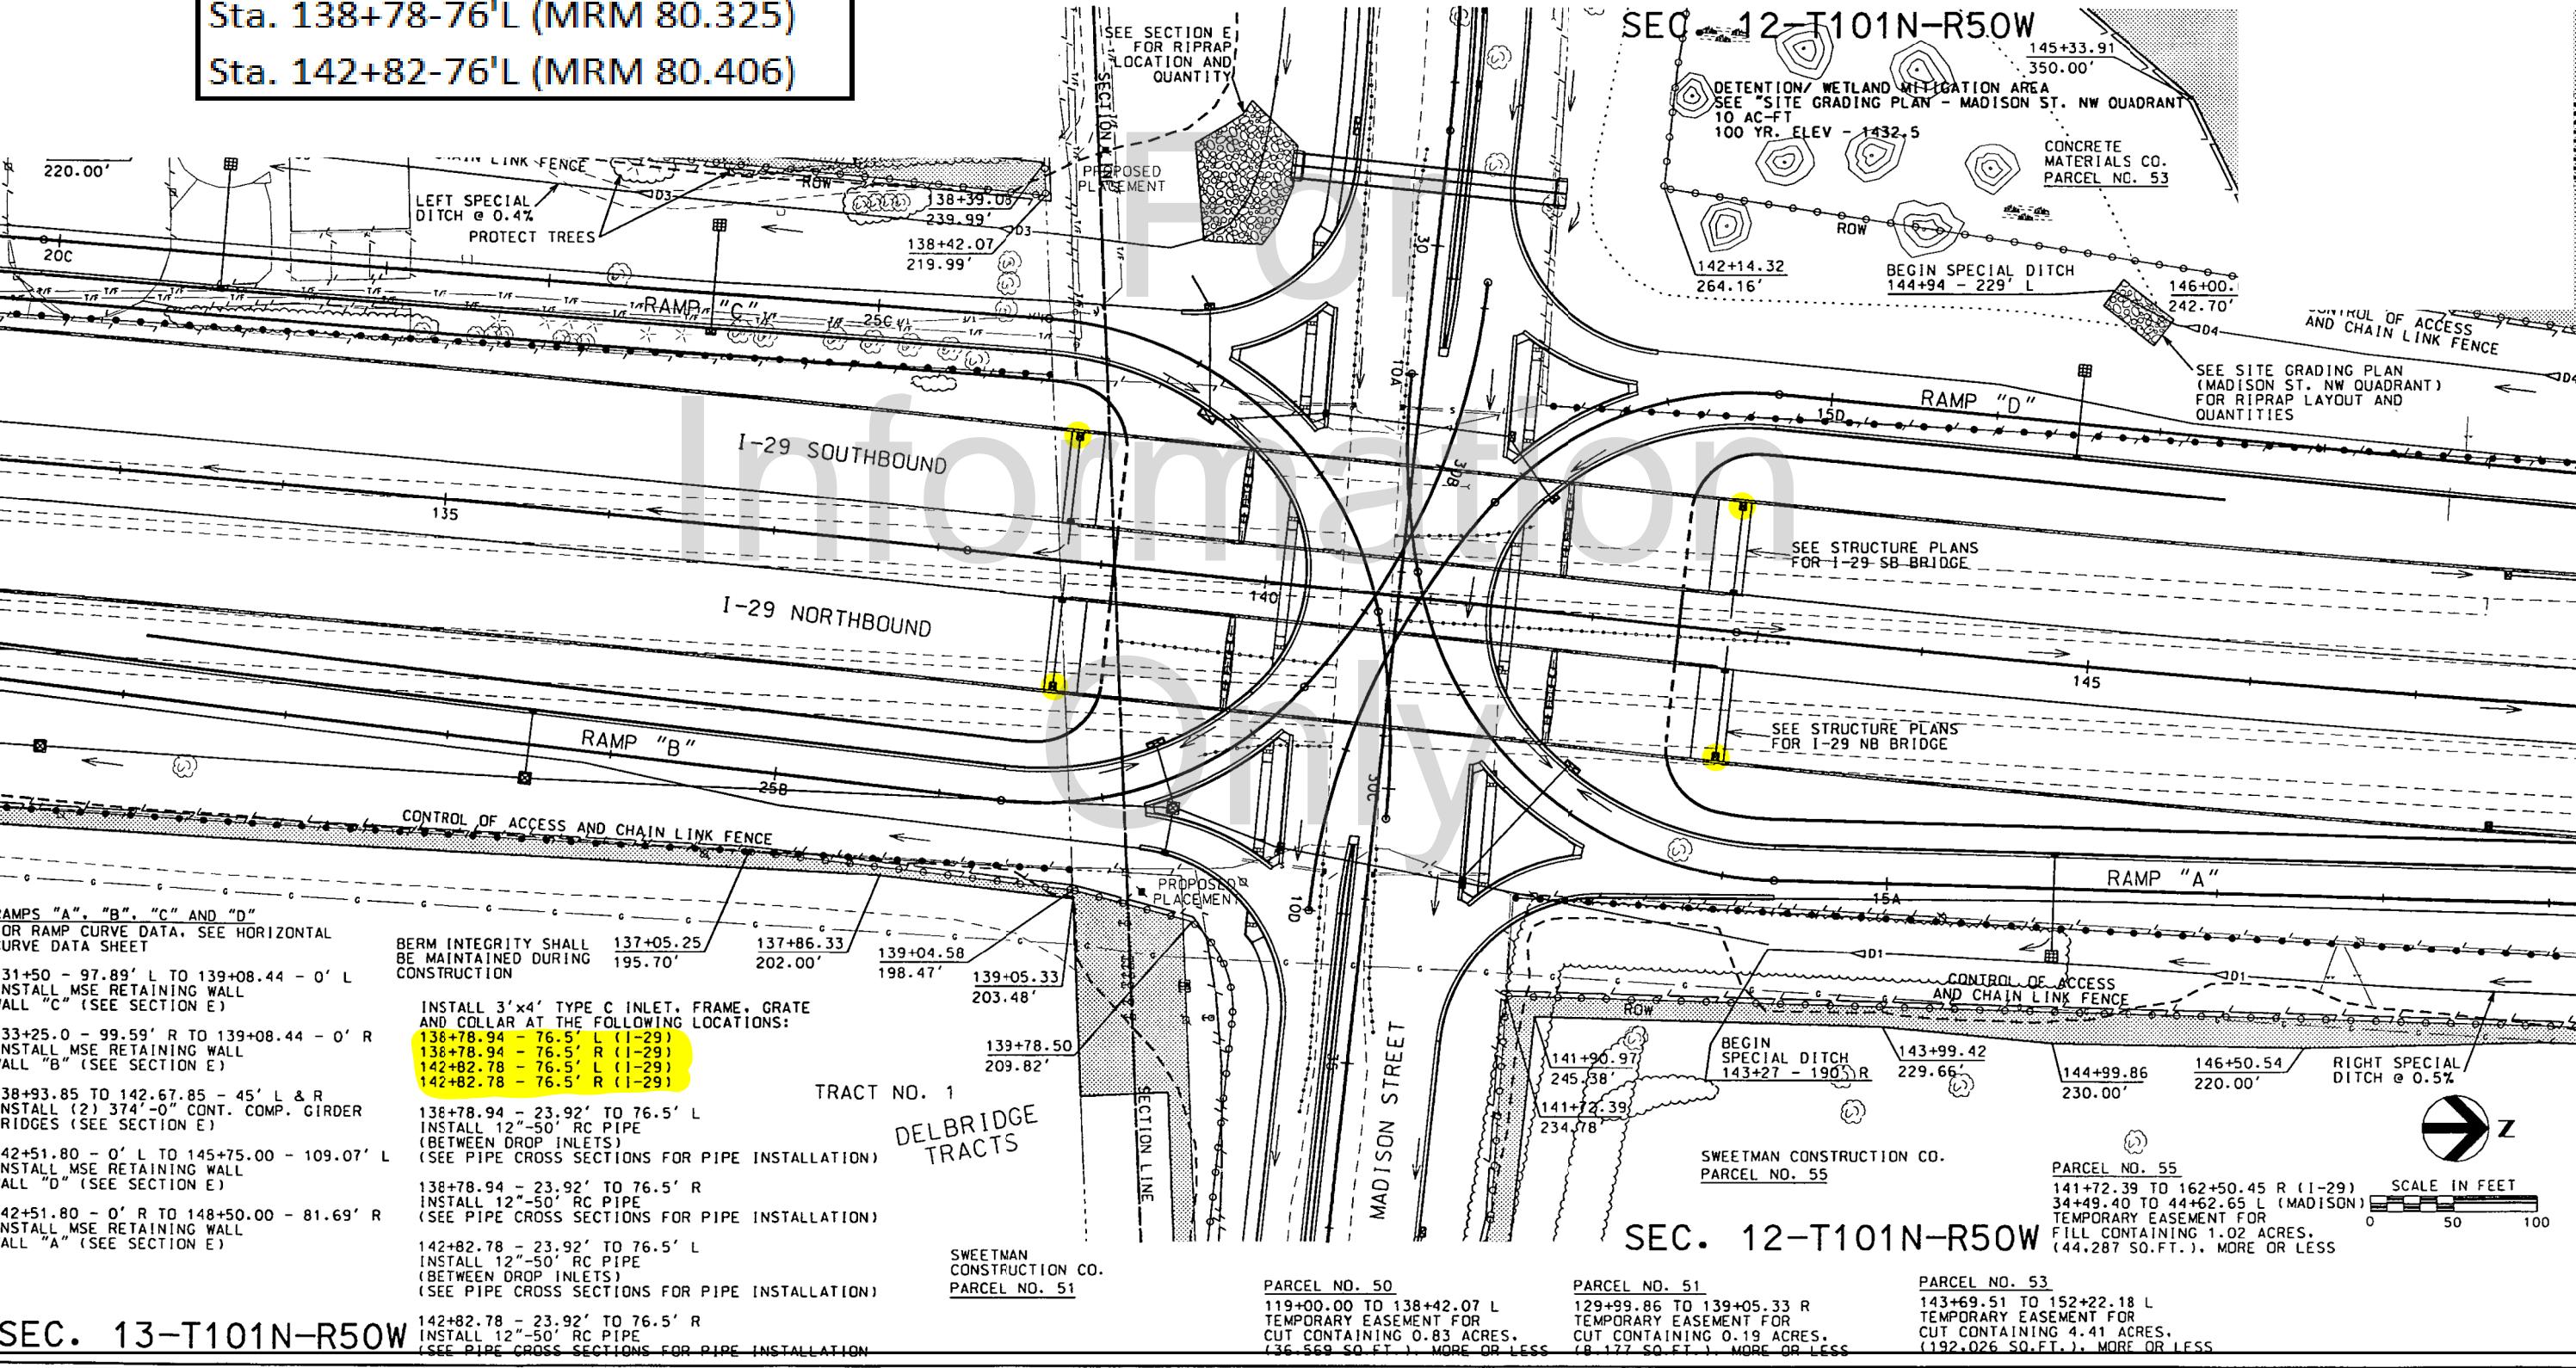


MADISON STREET INTERCHANGE
INTERSTATE 29 NORTHBOUND
Sta. 138+78-76'R (MRM 80.250)
Sta. 142+82-76'R (MRM 80.330)

INTERSTATE 29 SOUTHBOUND
Sta. 138+78-76'L (MRM 80.325)
Sta. 142+82-76'L (MRM 80.406)

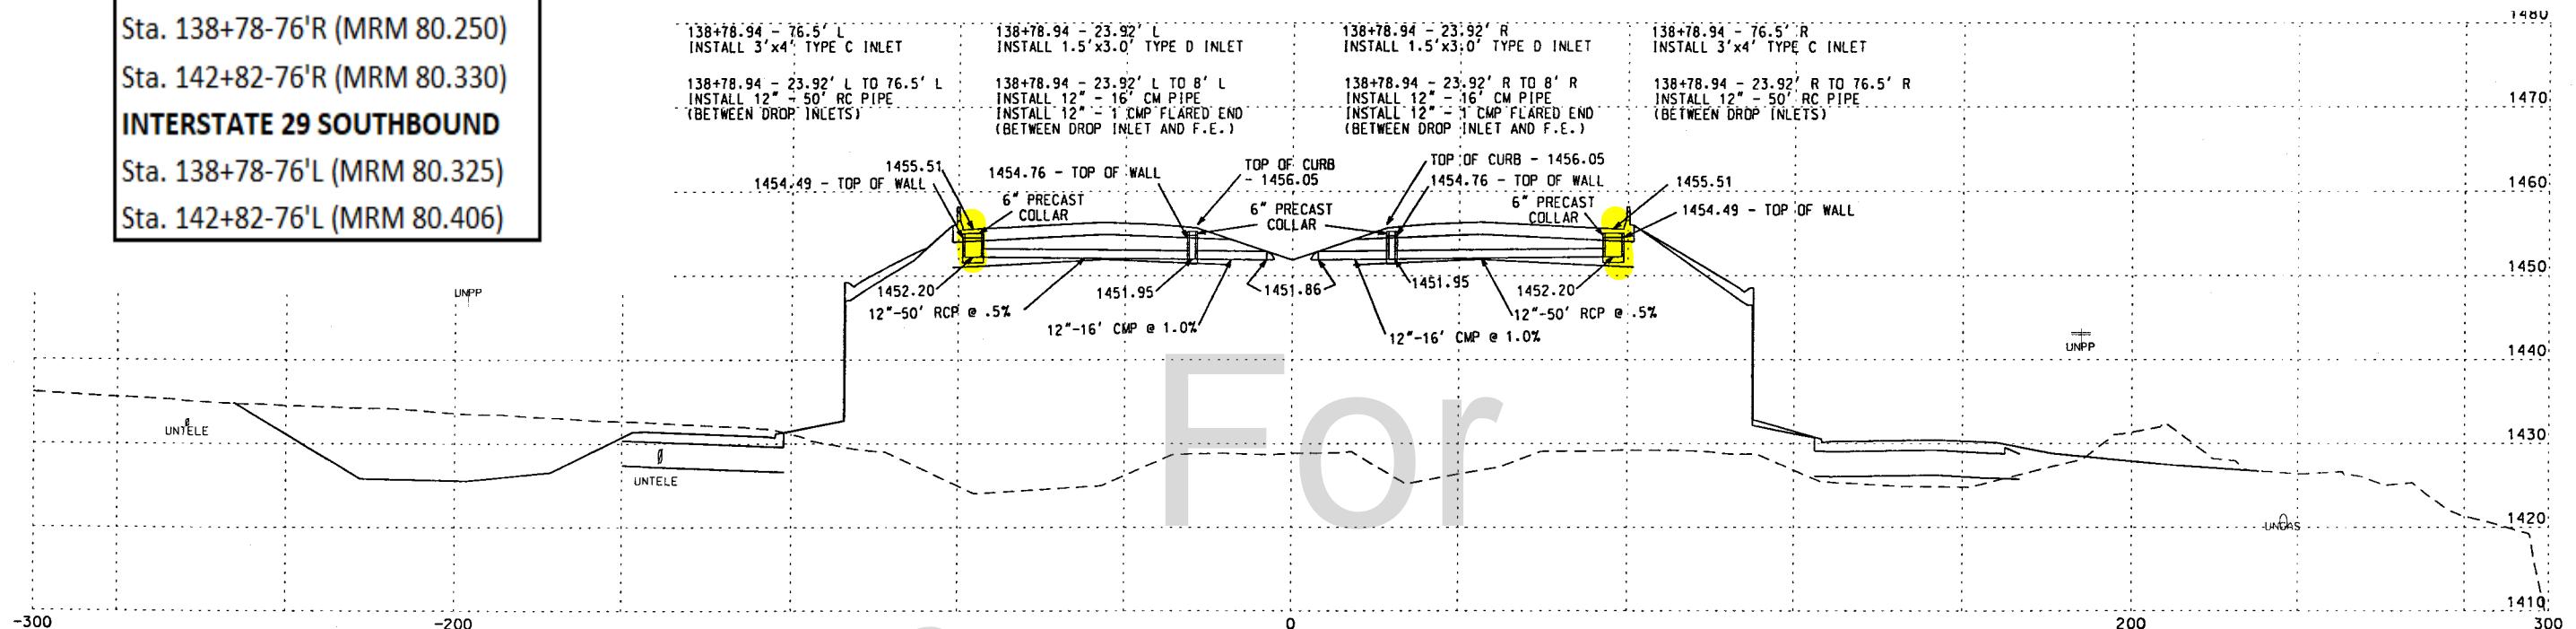

138+79

Information

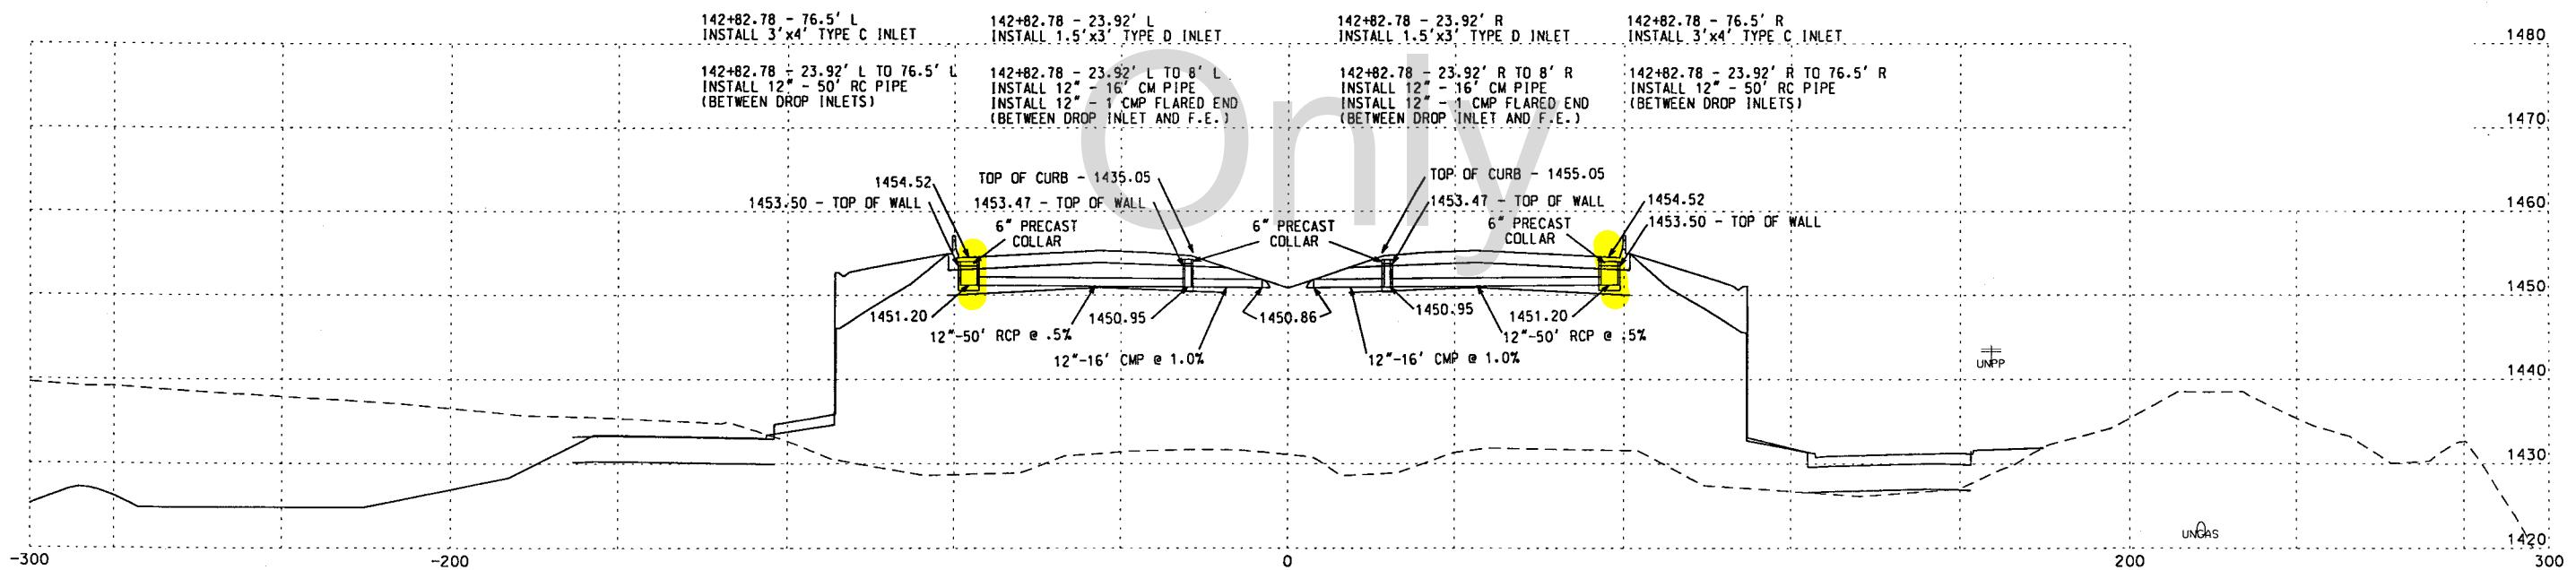

142+83

BENSON ROAD INTERCHANGE
INTERSTATE 29 SOUTHBOUND
Sta. 156+42 (MRM 82.305)


SLOPE SHOULDER PAVEMENT TO DRAIN TO INLET AT THE FOLLOWING LOCATIONS:
 141+06 - 129.7' R TO 170.5' R
 18"-36' CMP AND (2) 12.5° ELBOWS
 AND (1) SAFETY END
 142+82.5 - 76.5' L TO 163.7' L
 18"-36' RCP AND (1) SAFETY END
 (INLET CONNECTED TO DROP INLET)
 144+06-76.5' R
 141+06-76.5' R
 144+82.5-76.5' L
 142+82.5-76.5' L
 142+75 - 79' R
 INSTALL CRASH ATTENUATOR
 141+06 - 76.5' R TP 129.7' R
 18"-50' RCP AND (1) RCP
 TO CMP TRANSITION
 (INLET CONNECTED TO DROP INLET)

INSTALL (3'x4') TYPE C DROP INLETS AND TYPE C FRAME AND GRATE AT THE FOLLOWING LOCATIONS:
 144+06 - 76.5' R
 141+06 - 76.5' R
 144+82.5 - 76.5' L
 142+82.5 - 76.5' L


SCALE IN FEET
 0 50 100

SEC. 36-102-50

MARC W. TOBIAS
 PARCEL NO. 125

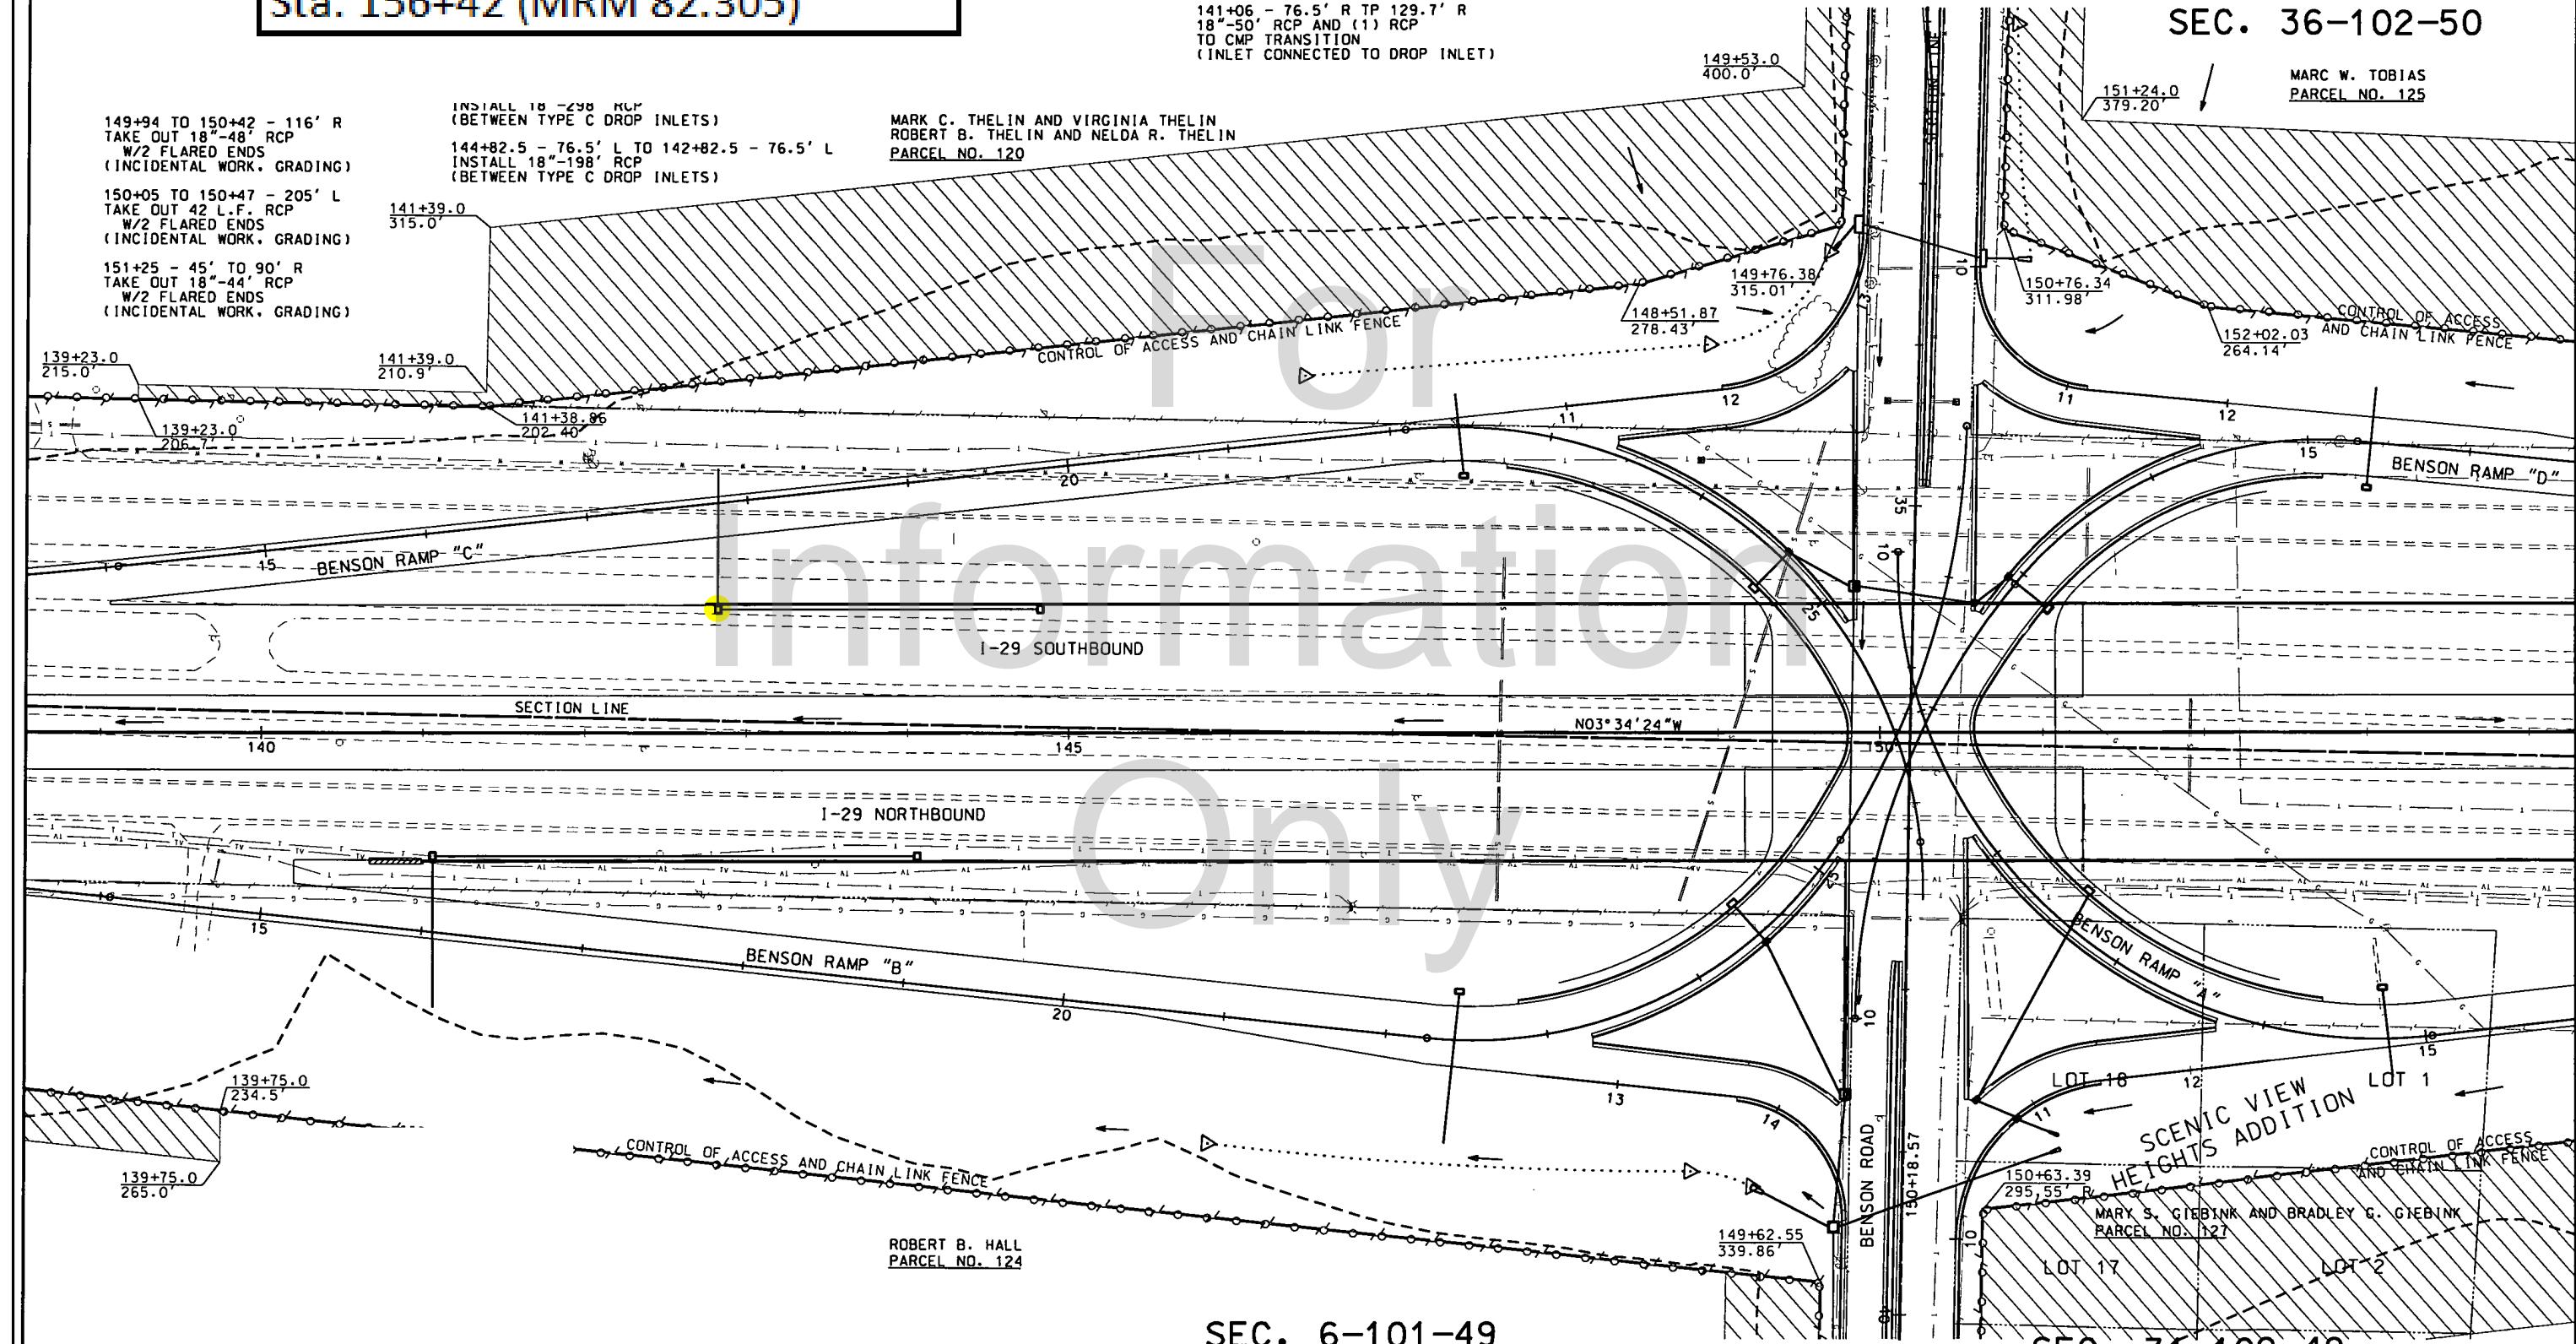

BENSON ROAD INTERCHANGE
INTERSTATE 29 SOUTHBOUND
Sta. 156+42 (MRM 82.305)

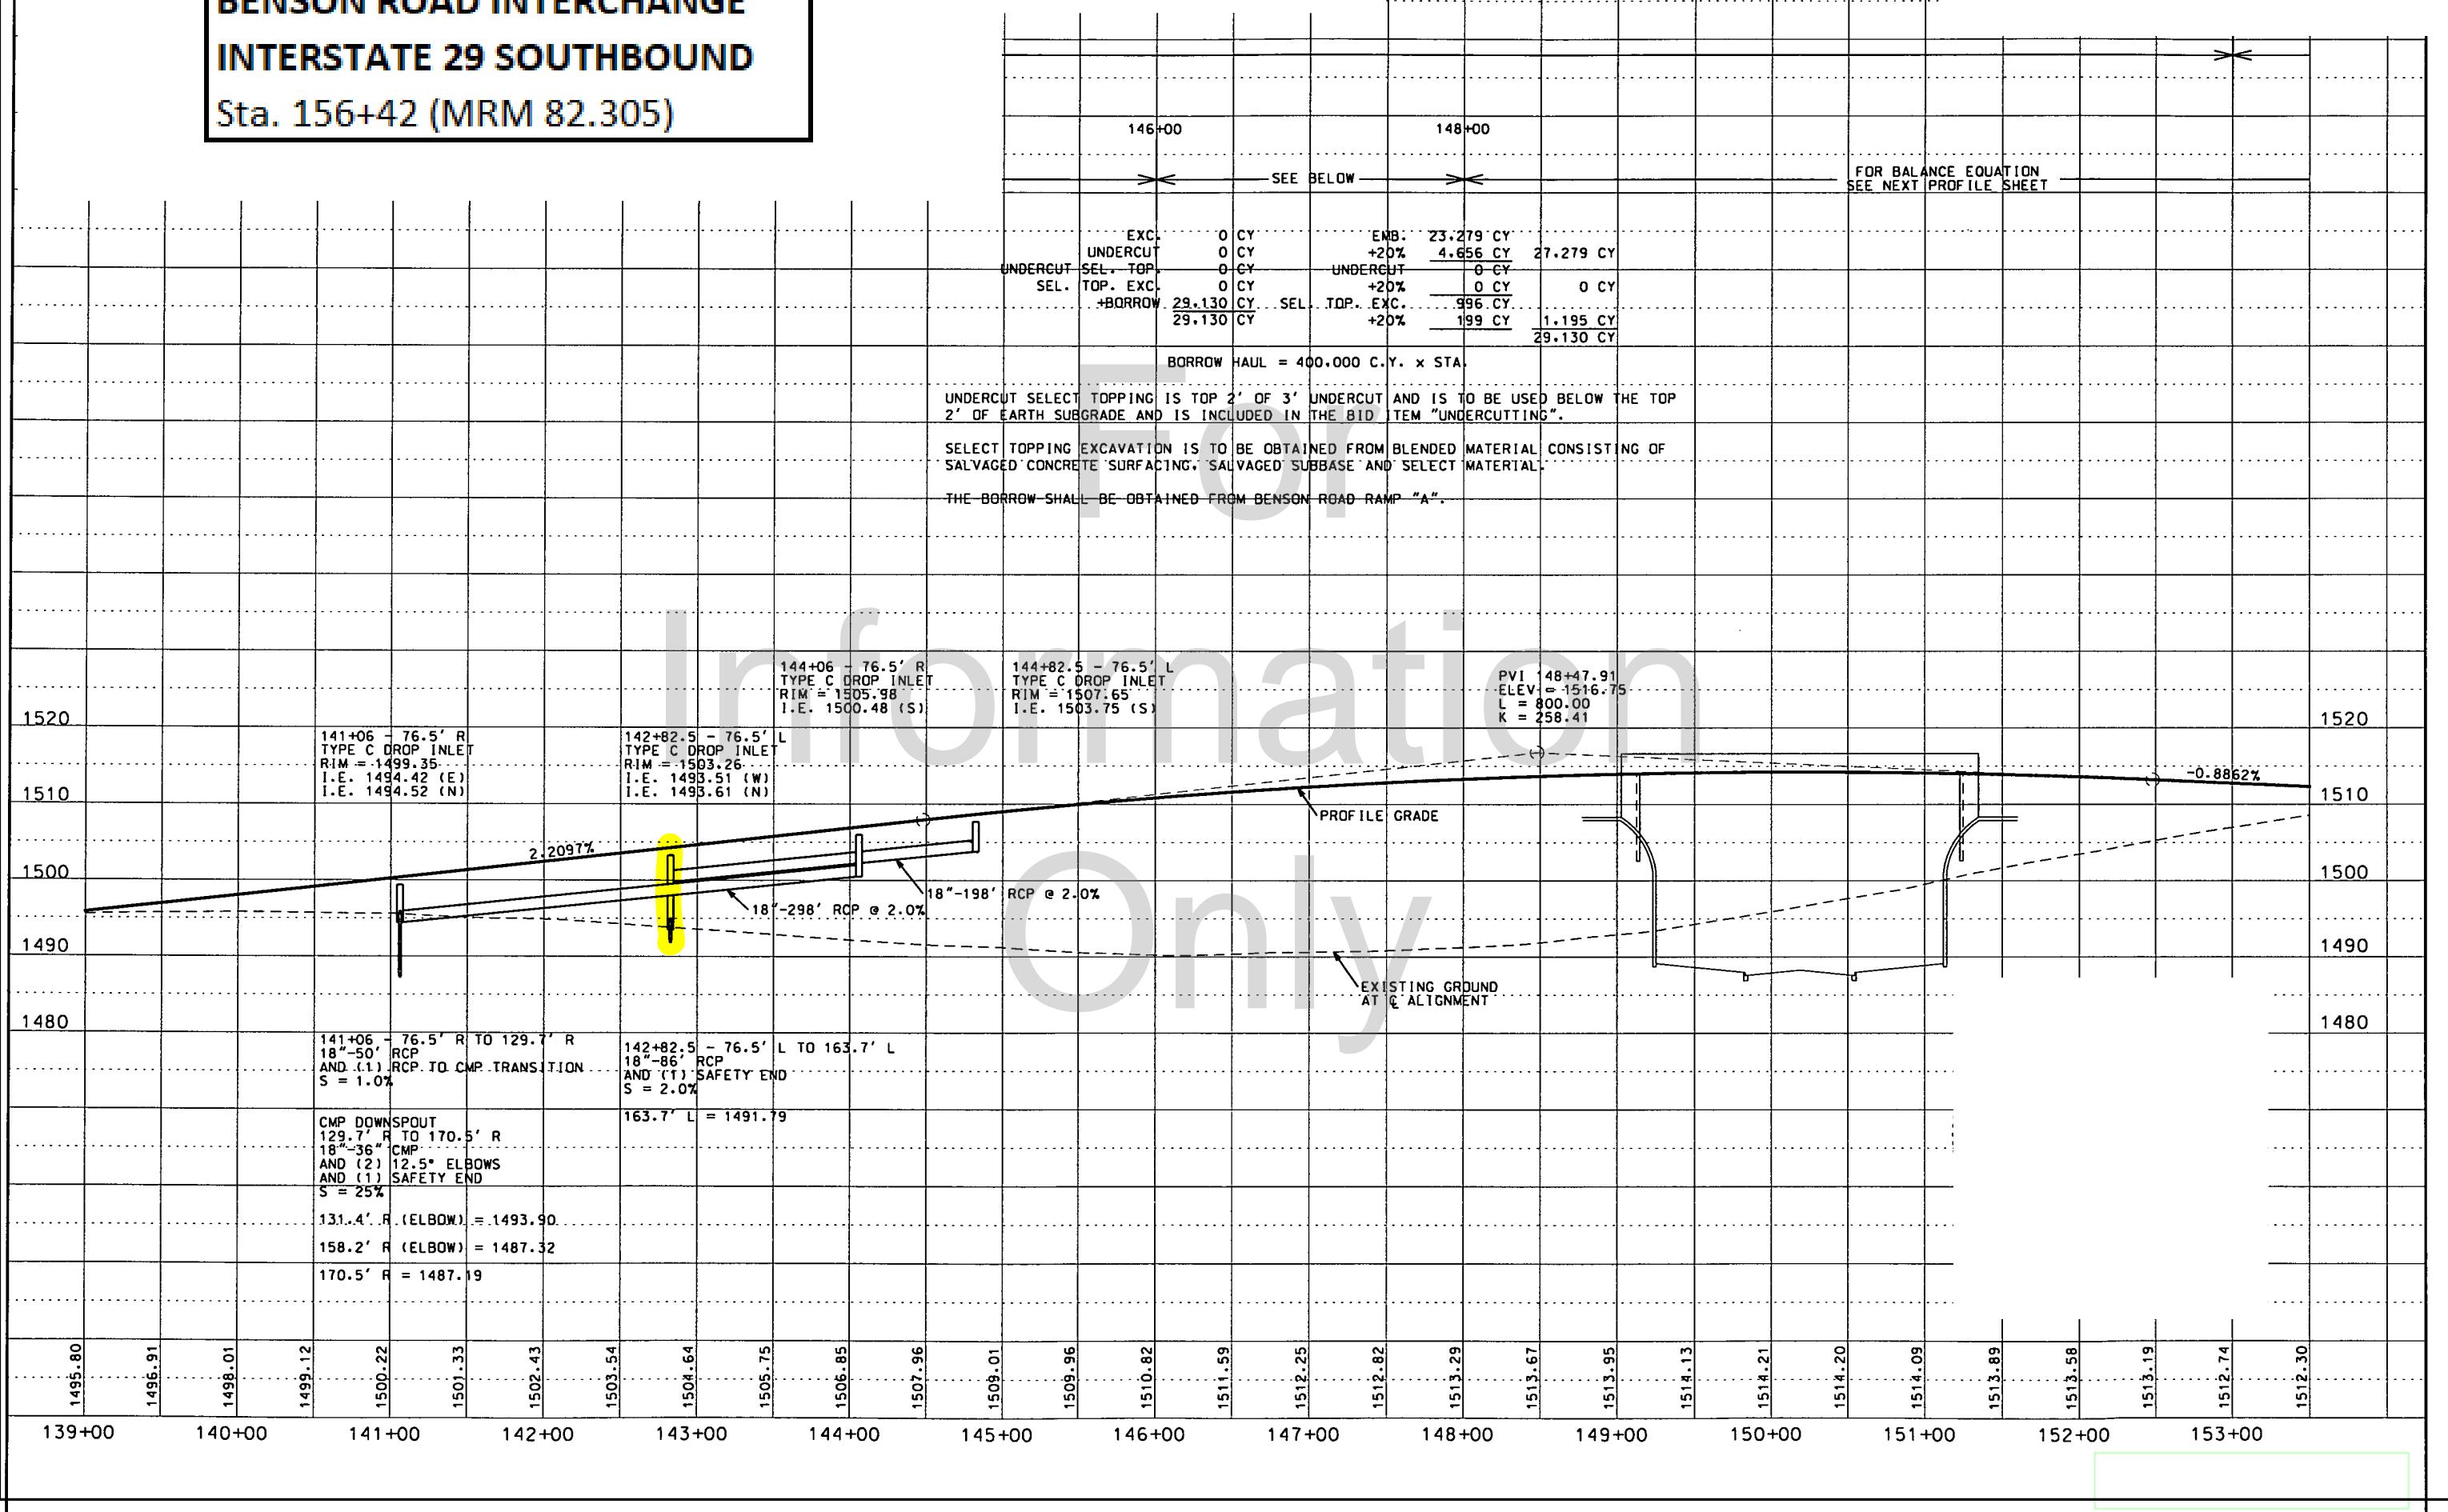

BENSON ROAD INTERCHANGE
INTERSTATE 29 SOUTHBOUND
Sta. 156+42 (MRM 82.305)

166+16 TO 166+59 - 138' R
TAKE OUT 18'-43' RCP
W/2 FLARED ENDS
(INCIDENTAL WORK, GRADING)

150+70 TO 177+82 - L
TAKE OUT 2.730' FENCE

150+62 TO 159+23 - R
TAKE OUT 861' FENCE

154+45.5 - 76.5' R TO 156+45.5 - 76.5' R
INSTALL 18"-198' RCP
(BETWEEN TYPE C DROP INLETS)

156+42.5 - 76.5' L TO 159+42.5 - 76.5' L
INSTALL 18"-298' RCP
(BETWEEN TYPE C DROP INLETS)

156+45.5 - 76.5' R TO 117.8' R
INSTALL 18"-36' CMP
AND (2) 15° ELBOWS

156+45.5 - 117.8' R TO 177.2' R
INSTALL 18"-58' RCP
AND (1) CMP TO RCP TRANSITION
AND (1) SAFETY END

159+42.5 - 76.5' L TO 140' L
INSTALL 18"-62' RCP
AND (1) SAFETY END

161+00-8.5' L TO 121.5' L (2.5 Ac.)
INSTALL 24"-114' RCP AND (2)
SLOPED ENDS (WITHOUT BARS)

166+42-9.0' L TO 107' L (3.3 Ac.)
INSTALL 30"-98' RCP
AND (2) SLOPED ENDS
(WITHOUT BARS)

SLOPE SHOULDER PAVEMENT TO
DRAIN TO INLET AT THE FOLLOWING
LOCATIONS:
154+45.5 - 76.5' R
156+45.5 - 76.5' R

156+42.5 - 76.5' L
159+42.5 - 76.5' L

168+50 - 120' R TO 169+23.4 - 134.6' L
INSTALL 24"-262' RCP AND (1) SLOPED END
(INLET END CONNECTED TO TYPE L DRAIN)
CENTERLINE STATION 168+84.79

166+42 - L
INSTALL BANK AND CHANNEL
PROTECTION GABIONS
(6.0 CU YDS)


169+23.4 - L
INSTALL BANK AND CHANNEL
PROTECTION GABIONS
(4.5 CU YDS)

151+48.20 TO 159+50 - 79' L
INSTALL BARRIER CURB & GUTTER
(SEE SECTION E)

151+48.20 TO 156+53.0 - 79' R
INSTALL BARRIER CURB & GUTTER
(SEE SECTION E)

159+50 - 79' L
INSTALL CRASH ATTENUATOR

STATE OF
SOUTH
DAKOTA
PROJECT
0001-271
SHEET
24
TOTAL
SHEETS
43

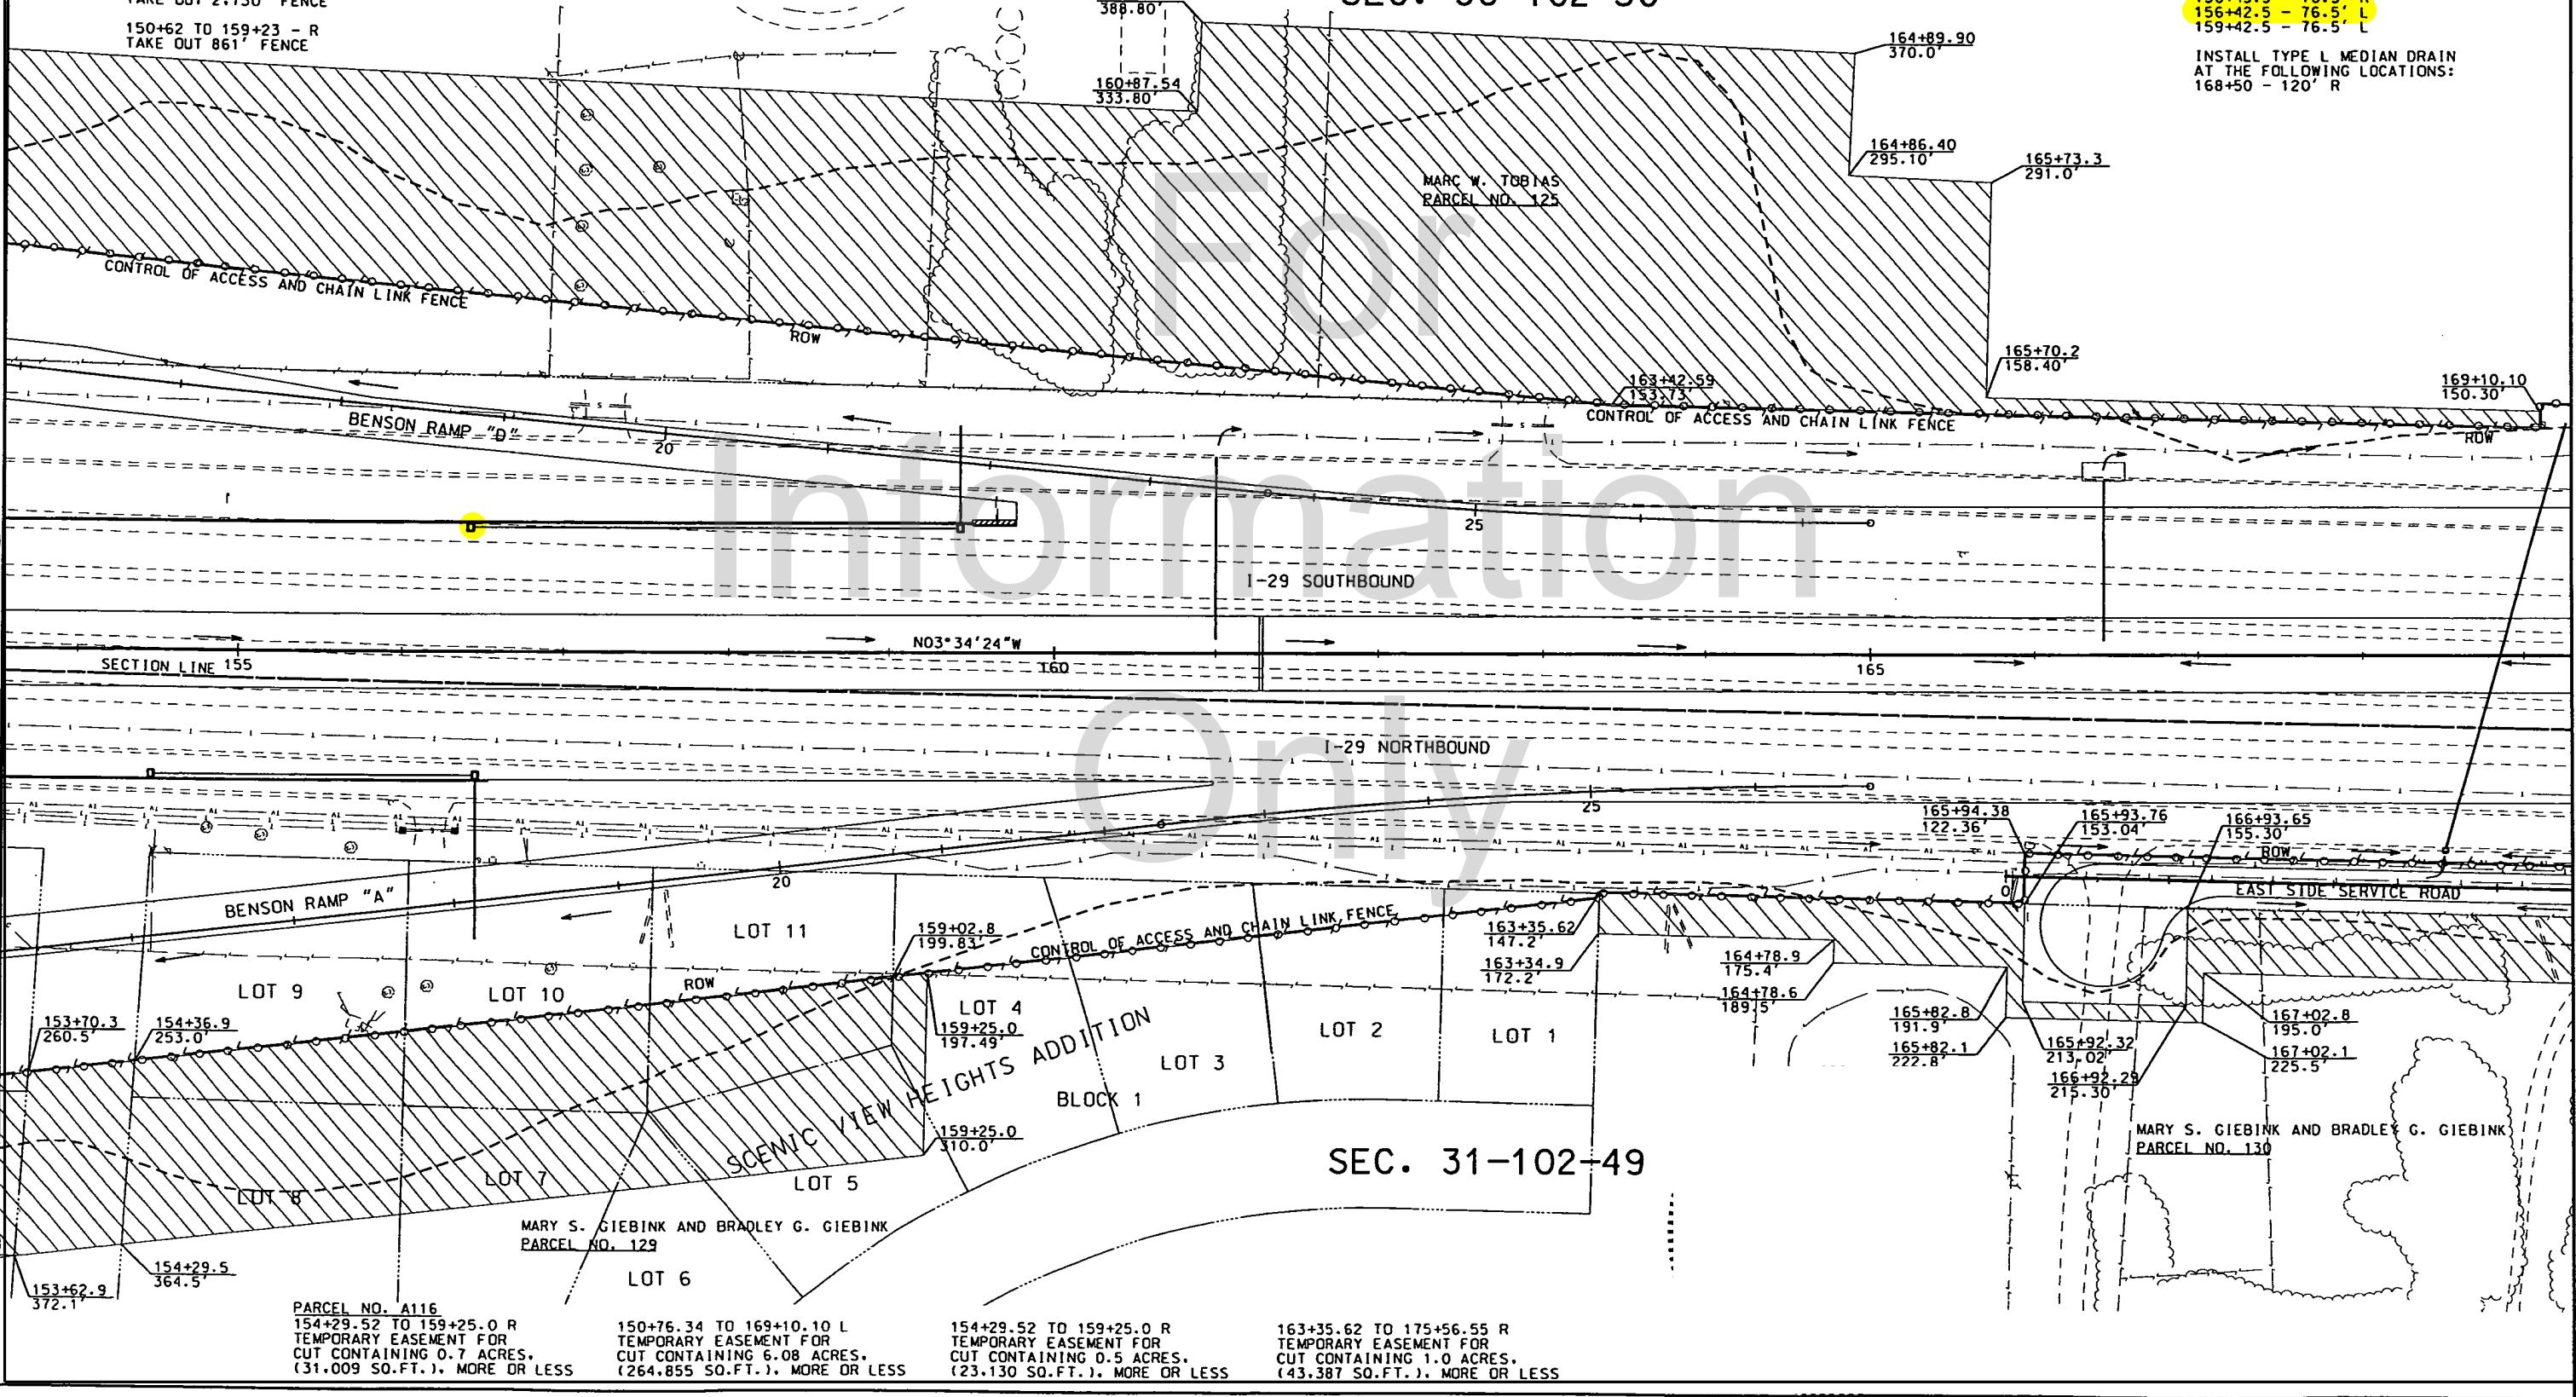

BENSON ROAD INTERCHANGE
INTERSTATE 29 SOUTHBOUND
Sta. 156+42 (MRM 82.305)

| | | | | | | | | | | | | | | | | | | | | | | | | |
|---------------------|-------------------|-----------|--|--|--|--|--|--|--|--|--|--|--|--|--|--|--|--|--|--|--|--|--|--|
| EXC. 24.008 CY | EMB. 38.195 CY | | | | | | | | | | | | | | | | | | | | | | | |
| UNDERCUT 2.608 CY | +20% 7.639 CY | 45.884 CY | | | | | | | | | | | | | | | | | | | | | | |
| SEL. TOP. 3.617 CY | UNDERCUT 2.608 CY | | | | | | | | | | | | | | | | | | | | | | | |
| TOP. EXC. 18.898 CY | +20% 522 CY | 3.130 CY | | | | | | | | | | | | | | | | | | | | | | |
| +BORROW 18.781 CY | SEL. TOP. EXC. | 15.748 CY | | | | | | | | | | | | | | | | | | | | | | |
| 67.912 CY | +20% 3.150 CY | 18.898 CY | | | | | | | | | | | | | | | | | | | | | | |

HAUL = 300,000 C.Y. x STA.

BORROW HAUL = 110,000 C.Y. x STA.

T TOPPING IS TOP 2' OF 3' UNDERCUT AND IS TO BE USED BELOW THE TOP

GRADE AND IS INCLUDED IN THE BID ITEM "UNDERCUTTING".

SELECT TOPPING EXCAVATION IS TO BE OBTAINED FROM BLENDED MATERIAL CONSISTING OF SALVAGED CONCRETE SURFACING, SALVAGED SUBBASE AND SELECT MATERIAL.

THE BORROW SHALL BE OBTAINED FROM BENSON ROAD RAMP "D".

| | | | | | | | | | | | | | | | | | | | | | | | | |
|-----------------------------|------------------------------|-----------|--|--|--|--|--|--|--|--|--|--|--|--|--|--|--|--|--|--|--|--|--|--|
| EXC. 41.462 CY | EMB. 39.865 CY | | | | | | | | | | | | | | | | | | | | | | | |
| UNDERCUT 4.208 CY | +20% 7.973 CY | 47.838 CY | | | | | | | | | | | | | | | | | | | | | | |
| UNDERCUT SEL. TOP. 7.218 CY | UNDERCUT 4.208 CY | | | | | | | | | | | | | | | | | | | | | | | |
| SEL. TOP. EXC. 21.824 CY | +20% 842 CY | 5.050 CY | | | | | | | | | | | | | | | | | | | | | | |
| 74.712 CY | SEL. TOP. EXC. +20% 3.637 CY | 21.824 CY | | | | | | | | | | | | | | | | | | | | | | |

BORROW HAUL = 420,000 C.Y. x STA.

UNDERCUT SELECT TOPPING IS TOP 2' OF 3' UNDERCUT AND IS TO BE USED BELOW THE TOP

2' OF EARTH SUBGRADE AND IS INCLUDED IN THE BID ITEM "UNDERCUTTING".

SELECT TOPPING EXCAVATION IS TO BE OBTAINED FROM BLENDED MATERIAL CONSISTING OF SALVAGED CONCRETE SURFACING, SALVAGED SUBBASE AND SELECT MATERIAL.

STA. 156+45.5 - 76.5' R
TYPE C DROP INLET
RIM = 1508.68
I.E. 1504.60 (S)
I.E. 1504.50 (E)

STA. 154+45.5 - 76.5' R
TYPE C DROP INLET
RIM = 1510.45
I.E. 1506.15

STA. 156+42.5 - 76.5' L
TYPE C DROP INLET
RIM = 1508.71
I.E. 1504.07 (N)

STA. 158+42.5 - 76.5' L
TYPE C DROP INLET
RIM = 1506.05
I.E. 1500.99 (W)
I.E. 1501.09 (S)

161+28 CL
DITCH BLOCK
EL. 1502.64

1520

1510

PVI 167+93.69
ELEV = 1499.51
L = 800.00
K = 291.37

1510

1500

1500

1490

1490

1480

STA. 166+42
INLET = 1496.26
OUTLET = 1495.14
= 15.9 CFS
= 1498.89

168+50 - 120' R
TYPE 1: MEDIAN DRAIN
RIM = 1495.76
I.E. = 1492.90 (W)

1480

1511.86

STA. 168+50 - 120' R TO
169+23.4 - 134.6' L
INLET = 1492.90
OUTLET = 1488.61
Q_{so} = 23.0 CFS
HW_{so} = 1493.80

1480

1511.41

1510.97

1510.53

1510.08

1509.64

1509.20

1508.75

1508.31

1507.87

1507.43

1506.98

1506.54

1506.10

1505.65

1505.21

1501.77

1501.32

1501.88

1501.44

1501.00

1502.61

1502.30

1502.08

1501.95

1501.91

1502.07

1502.28

1502.58

154+00

155+00

156+00

157+00

158+00

159+00

160+00

161+00

162+00

163+00

164+00

165+00


166+00

167+00

168+00

169+00

**RICE STREET INTERCHANGE
INTERSTATE 229 SOUTHBOUND
Sta. 156+89-71'R (MRM 7.850)**

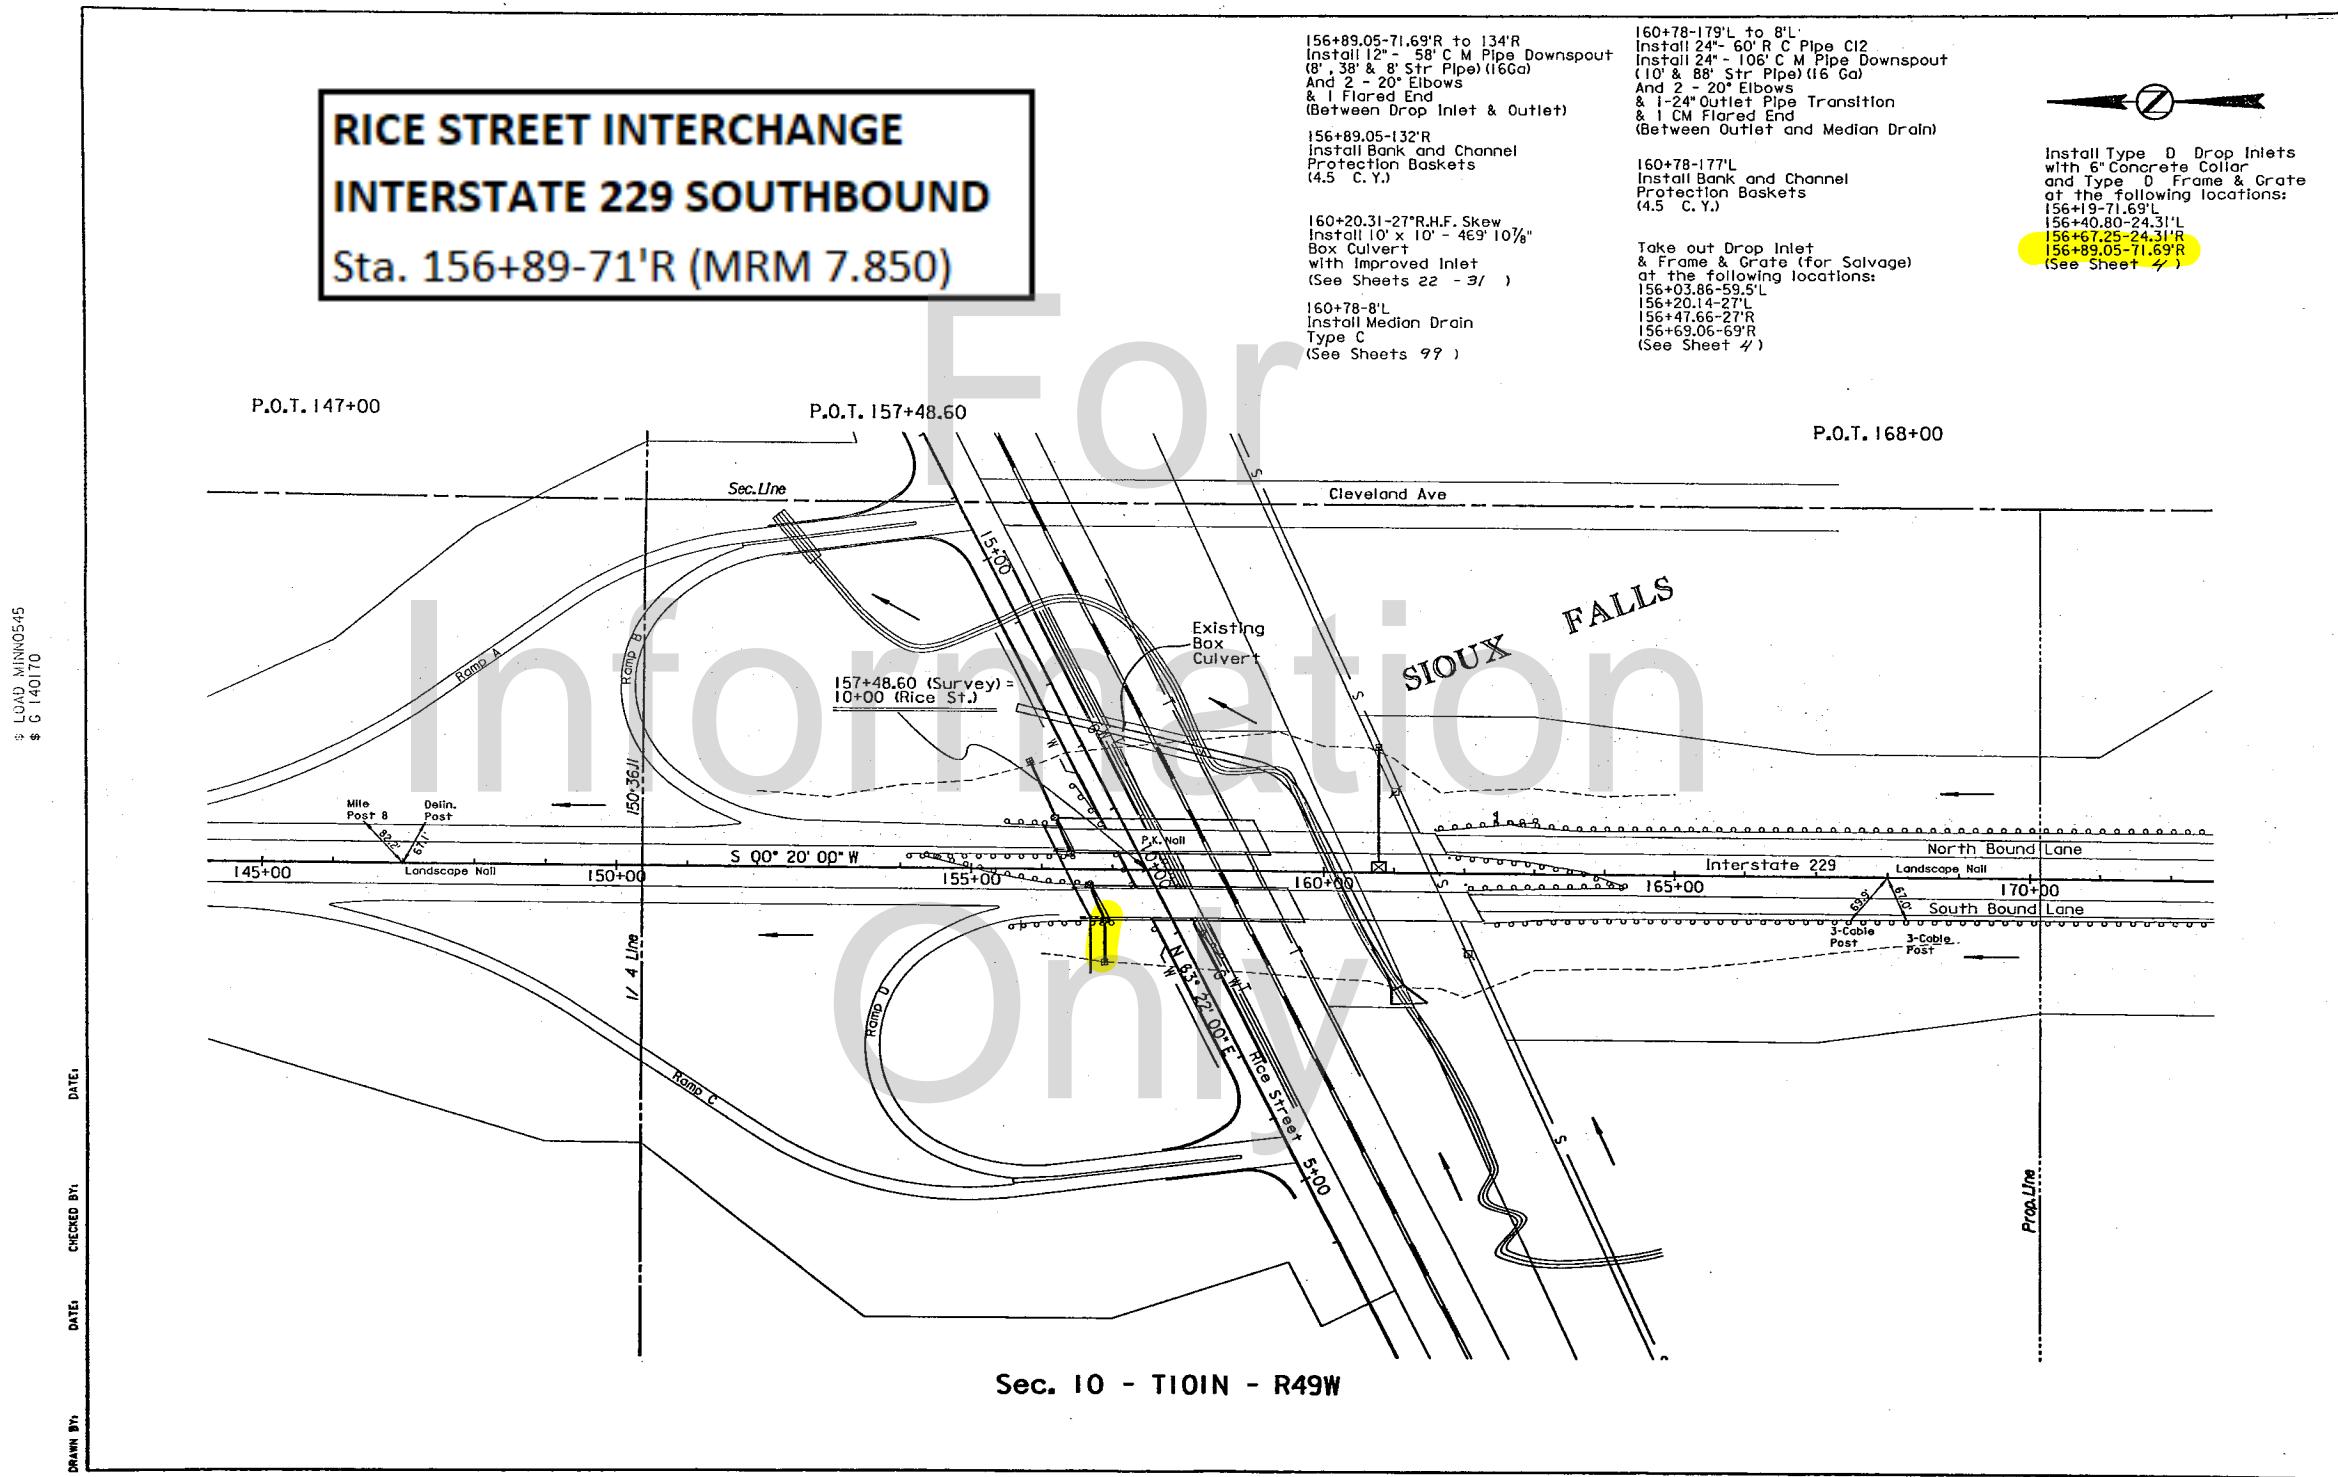


SHEET 1 OF 2 SHEETS


41+89-60' to 115' L Take out 12"- 55' C M Pipe (Incidental Work) 42+22.50 to 45+58.00 (NBL) Cont. Comp. Girder Bridge (Incidental Work-Structure) 45+96-16' to 148' L Take out 24"-131' C M Pipe (Incidental Work) 48+80.50 to 50+ Cont. Concrete (Incidental Work) 41+89-60' to 119' R Take out 12"- 58' C M Pipe (Incidental Work) 42+22.50 to 45+58.00 (SBL) Cont. Comp. Girder Bridge (Incidental Work-Structure) 48+46-58' to 172' L Take out 12"-114' C M Pipe (Incidental Work) 48+80.50 to 50+ Cont. Concrete (Incidental Work) 42+16.54-63.69'L to 107.32'L Install 12"-46' C M Pipe Downspout (4', 28' & 10' Str Pipe) (16Ga) And 2 - 17.5° Elbows & 1 F End (Between Drop Inlet & Outlet) 42+16.54-107.32'L Install Bank and Channel Protection Baskets (4.5 C.Y.) 42+16.54-24.31' L to 63.69' L Install 12"- 38' R C Pipe (CL 2) (Between Drop Inlets) 42+16.54-24.31' R to 63.69' R Install 12"- 38' R C Pipe (CL 2) (Between Drop Inlets) 42+16.54-63.69' R to 125.49' R Install 12"-64' C M Pipe Downspout (10', 40' & 10' Str Pipe) (16Ga) And 2 - 17.5° Elbows & 1 F End (Between Drop Inlet & Outlet) 42+16.54-125.49'R Install Bank and Channel Protection Baskets (4.5 C.Y.) Take out 3 Cable Guardrail at the following locations: 38+00-62' L to 42+23-58' L 34+98-21' L to 38+90-24' L 38+01-70' R to 41+07-63' R 39+76-21' L to 42+22-25' L (See Sheet 10) Take out 3 Cable Anchor Section at the following locations: 34+00-24' L (SBL) 38+10-64' R (NBL) 38+80-24' L (SBL) 39+80-24' L (SBL) (See Sheet 10) Take out Concrete Pavement at the following locations: 39+00 to 55+00 (NBL) 39+00 to 55+00 (SBL) (See Sheet 9) Install Steel W Beam Guard Rail with Breakaway Cable Terminal at the following locations: 39+97-12' L to 42+23-27' R 41+07-63' R to 42+22-63' R 45+58 to 48+81-58' L 45+58-26' L to 48+35-17' L 46+06-20' R to 48+81-26' R 45+60-63' R to 48+81-58' R 50+51 to 52+36-58' L 50+51 to 52+16-23' L 50+51 to 51+85-26' R 50+51 to 51+66-59' R (See Sheet 10) Take out W-Beam Guardrail Def. Ends at the following locations: 40+00-17' L (NBL) 41+00-80' L (NBL) 46+10-20' R (NBL) 48+30-20' L (SBL) (See Sheet 10) 42+28.50 to 45+54.00 (NBL) Install 325'-6" - 40' Rdwy Cont. Comp. Grdr. Bridge 42+28.50 to 45+54.00 (SBL) Install 325'-6" - 40' Rdwy Cont. Comp. Grdr. Bridge 42+28.50 to 45+54.00 (NBL) Install 325'-6" - 40' Rdwy Cont. Comp. Grdr. Bridge 42+28.50 to 45+54.00 (SBL) Install 325'-6" - 40' Rdwy Cont. Comp. Grdr. Bridge 45+17-95' L to 100' R Install Concrete Sidewalk (See Sheet 46) Take out Drop Inlet & Frame & Grate at the following locations: 41+89-60' L 52+03-58' L 41+89-60' R 0+46-23' L 48+46-58' L 0+55-21' R 48+46-57' R 0+55-50' R 51+32-57' R 30+04 Retain Median Crossover Take out Concrete Gutter at the following locations: 42+03 to 42+23-L 42+03 to 42+23-R 48+60 to 48+80-L 48+60 to 48+80-R 51+55 to 51+75-R 52+06 to 52+26-L (See Sheet 9) 34+69-76' L to 38+00-62' L Retain 3 Cable Guardrail 37+50-65' L Install 42'-3 Cable Anchor Section to existing 3 Cable (See Detail Sheets) (See Sheet 9)

MINN0548
dir. lot
2555
DATE:
CHECKED BY:
DRAWN BY:

**BIG SIOUX RIVER BRIDGE
NORTH OF 26TH STREET
INTERSTATE 229 NORTHBOUND
Sta. 42+16-125'R (MRM 5.460)
RAILROAD
Sta. 51+57-161'R (MRM 5.550)
INTERSTATE 229 SOUTHBOUND
Sta. 42+16-107'L (MRM 5.460)**

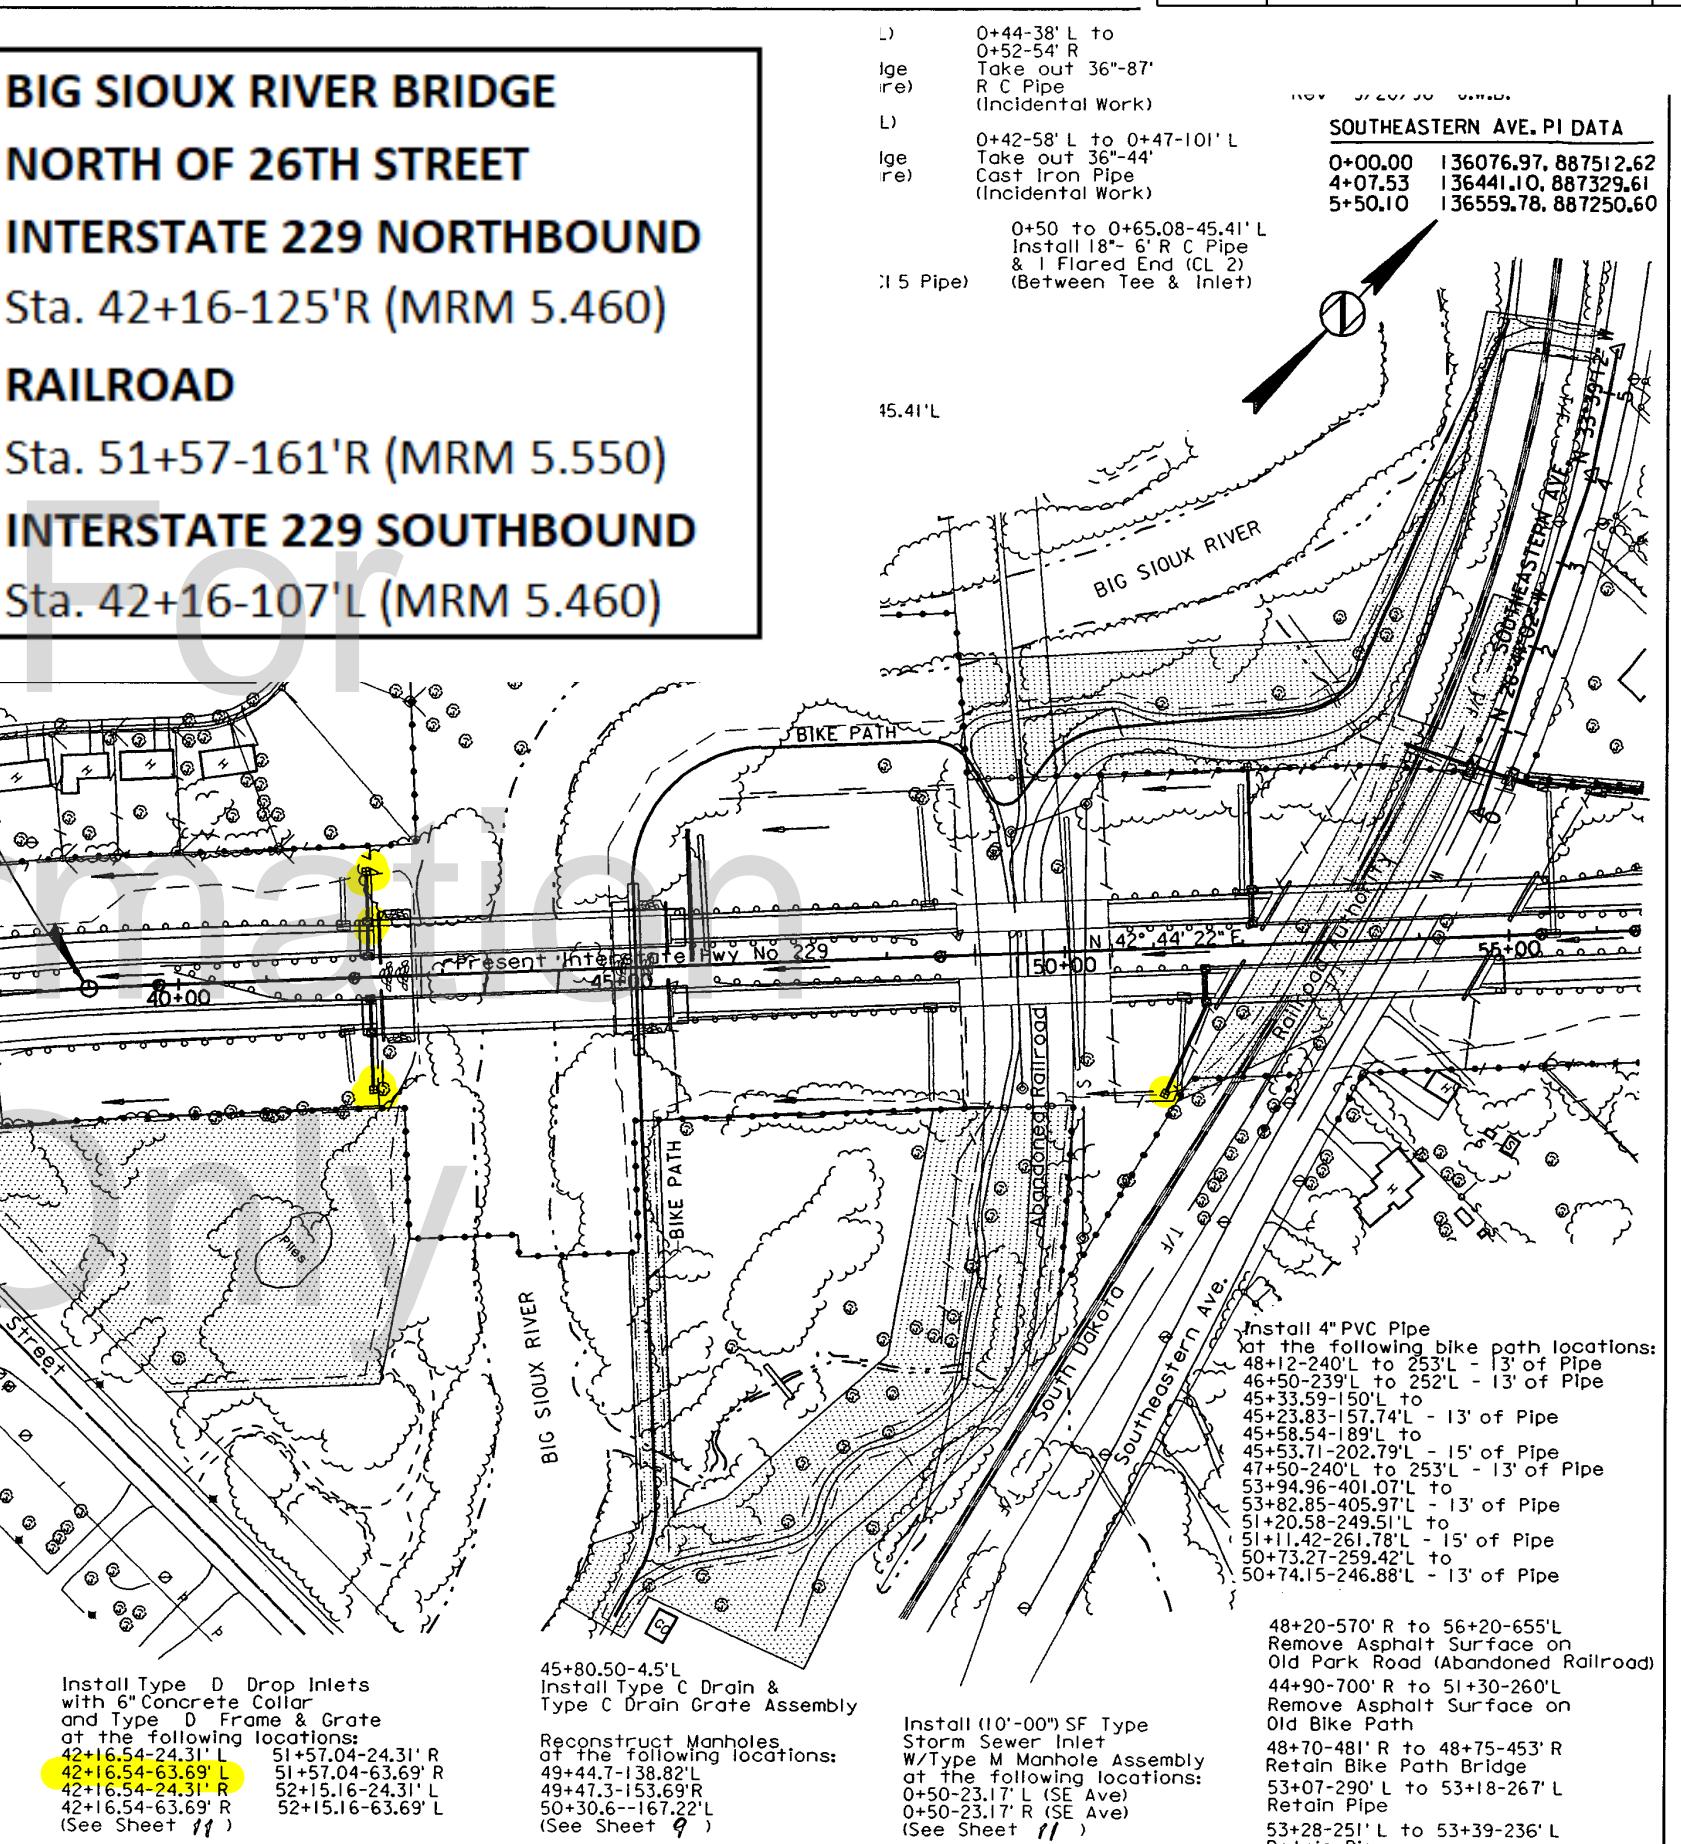


BIG SIOUX RIVER BRIDGE
NORTH OF 26TH STREET
INTERSTATE 229 NORTHBOUND
Sta. 42+16-125'R (MRM 5.460)
Sta. 51+57-161'R (MRM 5.550)
INTERSTATE 229 SOUTHBOUND
Sta. 42+16-107'L (MRM 5.460)


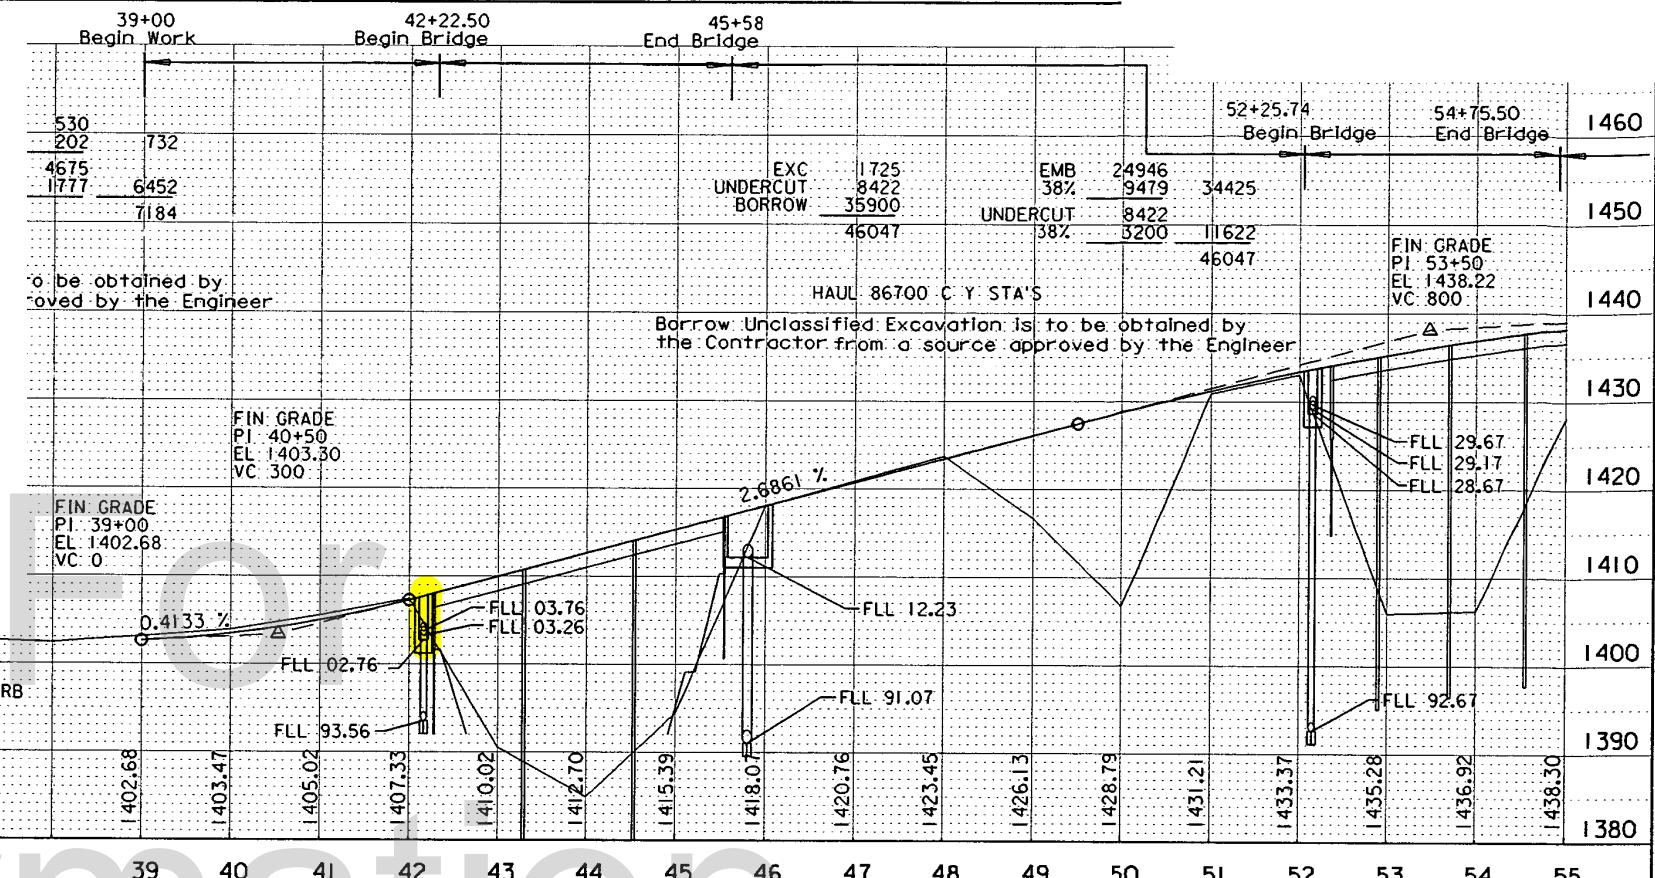


dir minn0548
file 25555
plot 25555v


DRAWN BY: DATE: CHECKED BY:

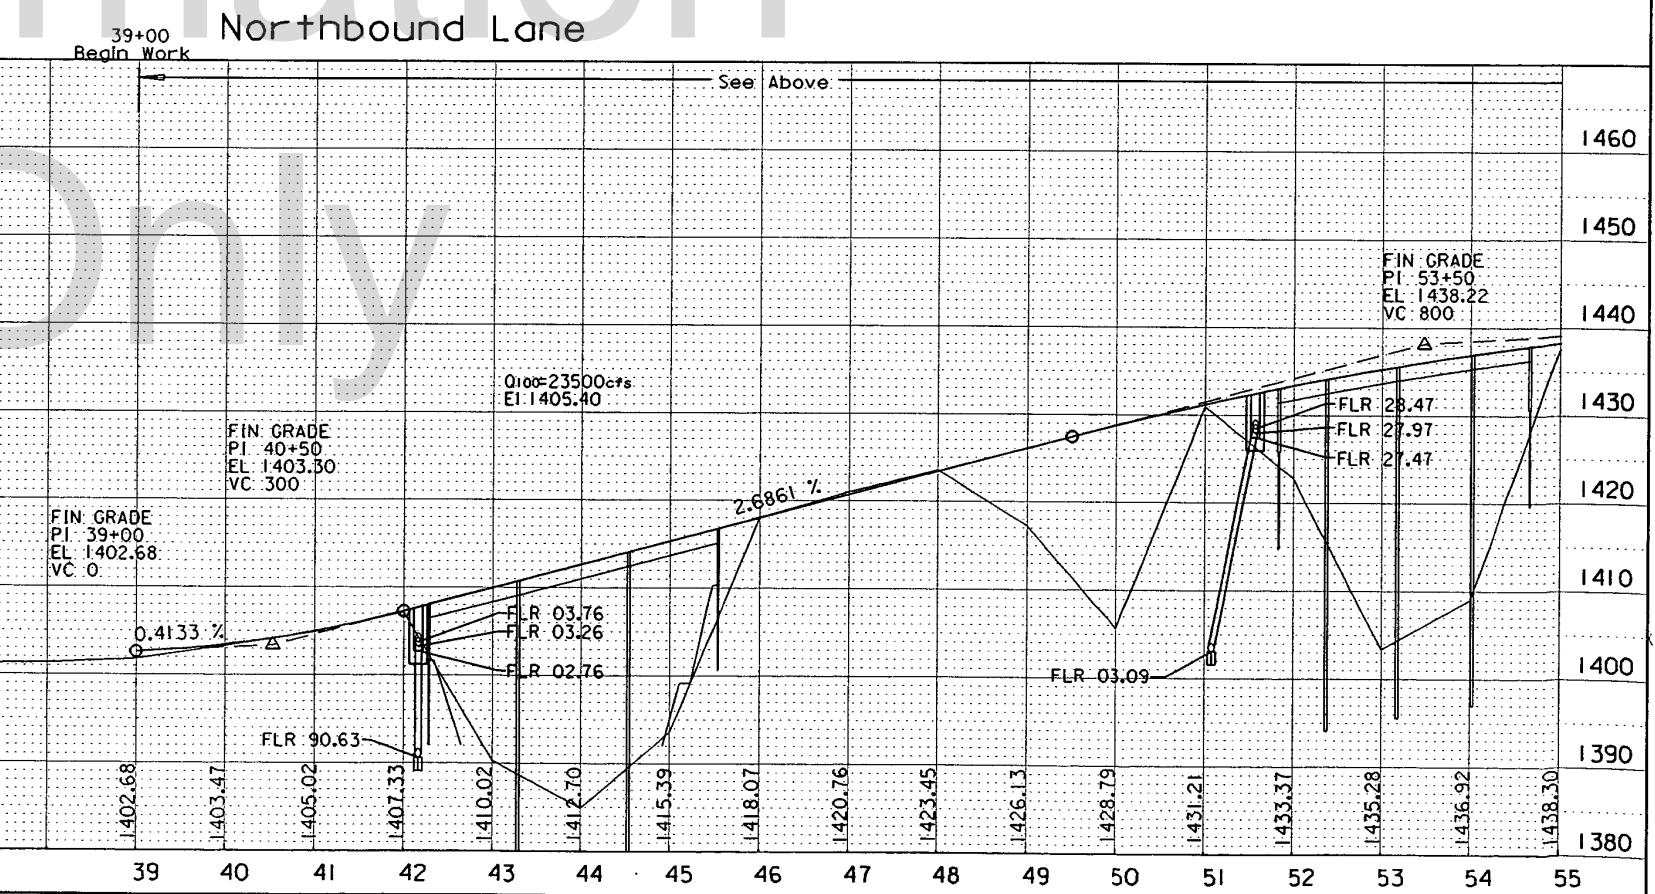

INTERSTATE 229
BETWEEN 6TH & 10TH STREETS
SOUTHBOUND
Sta. 343+80 (MRM 6.823)

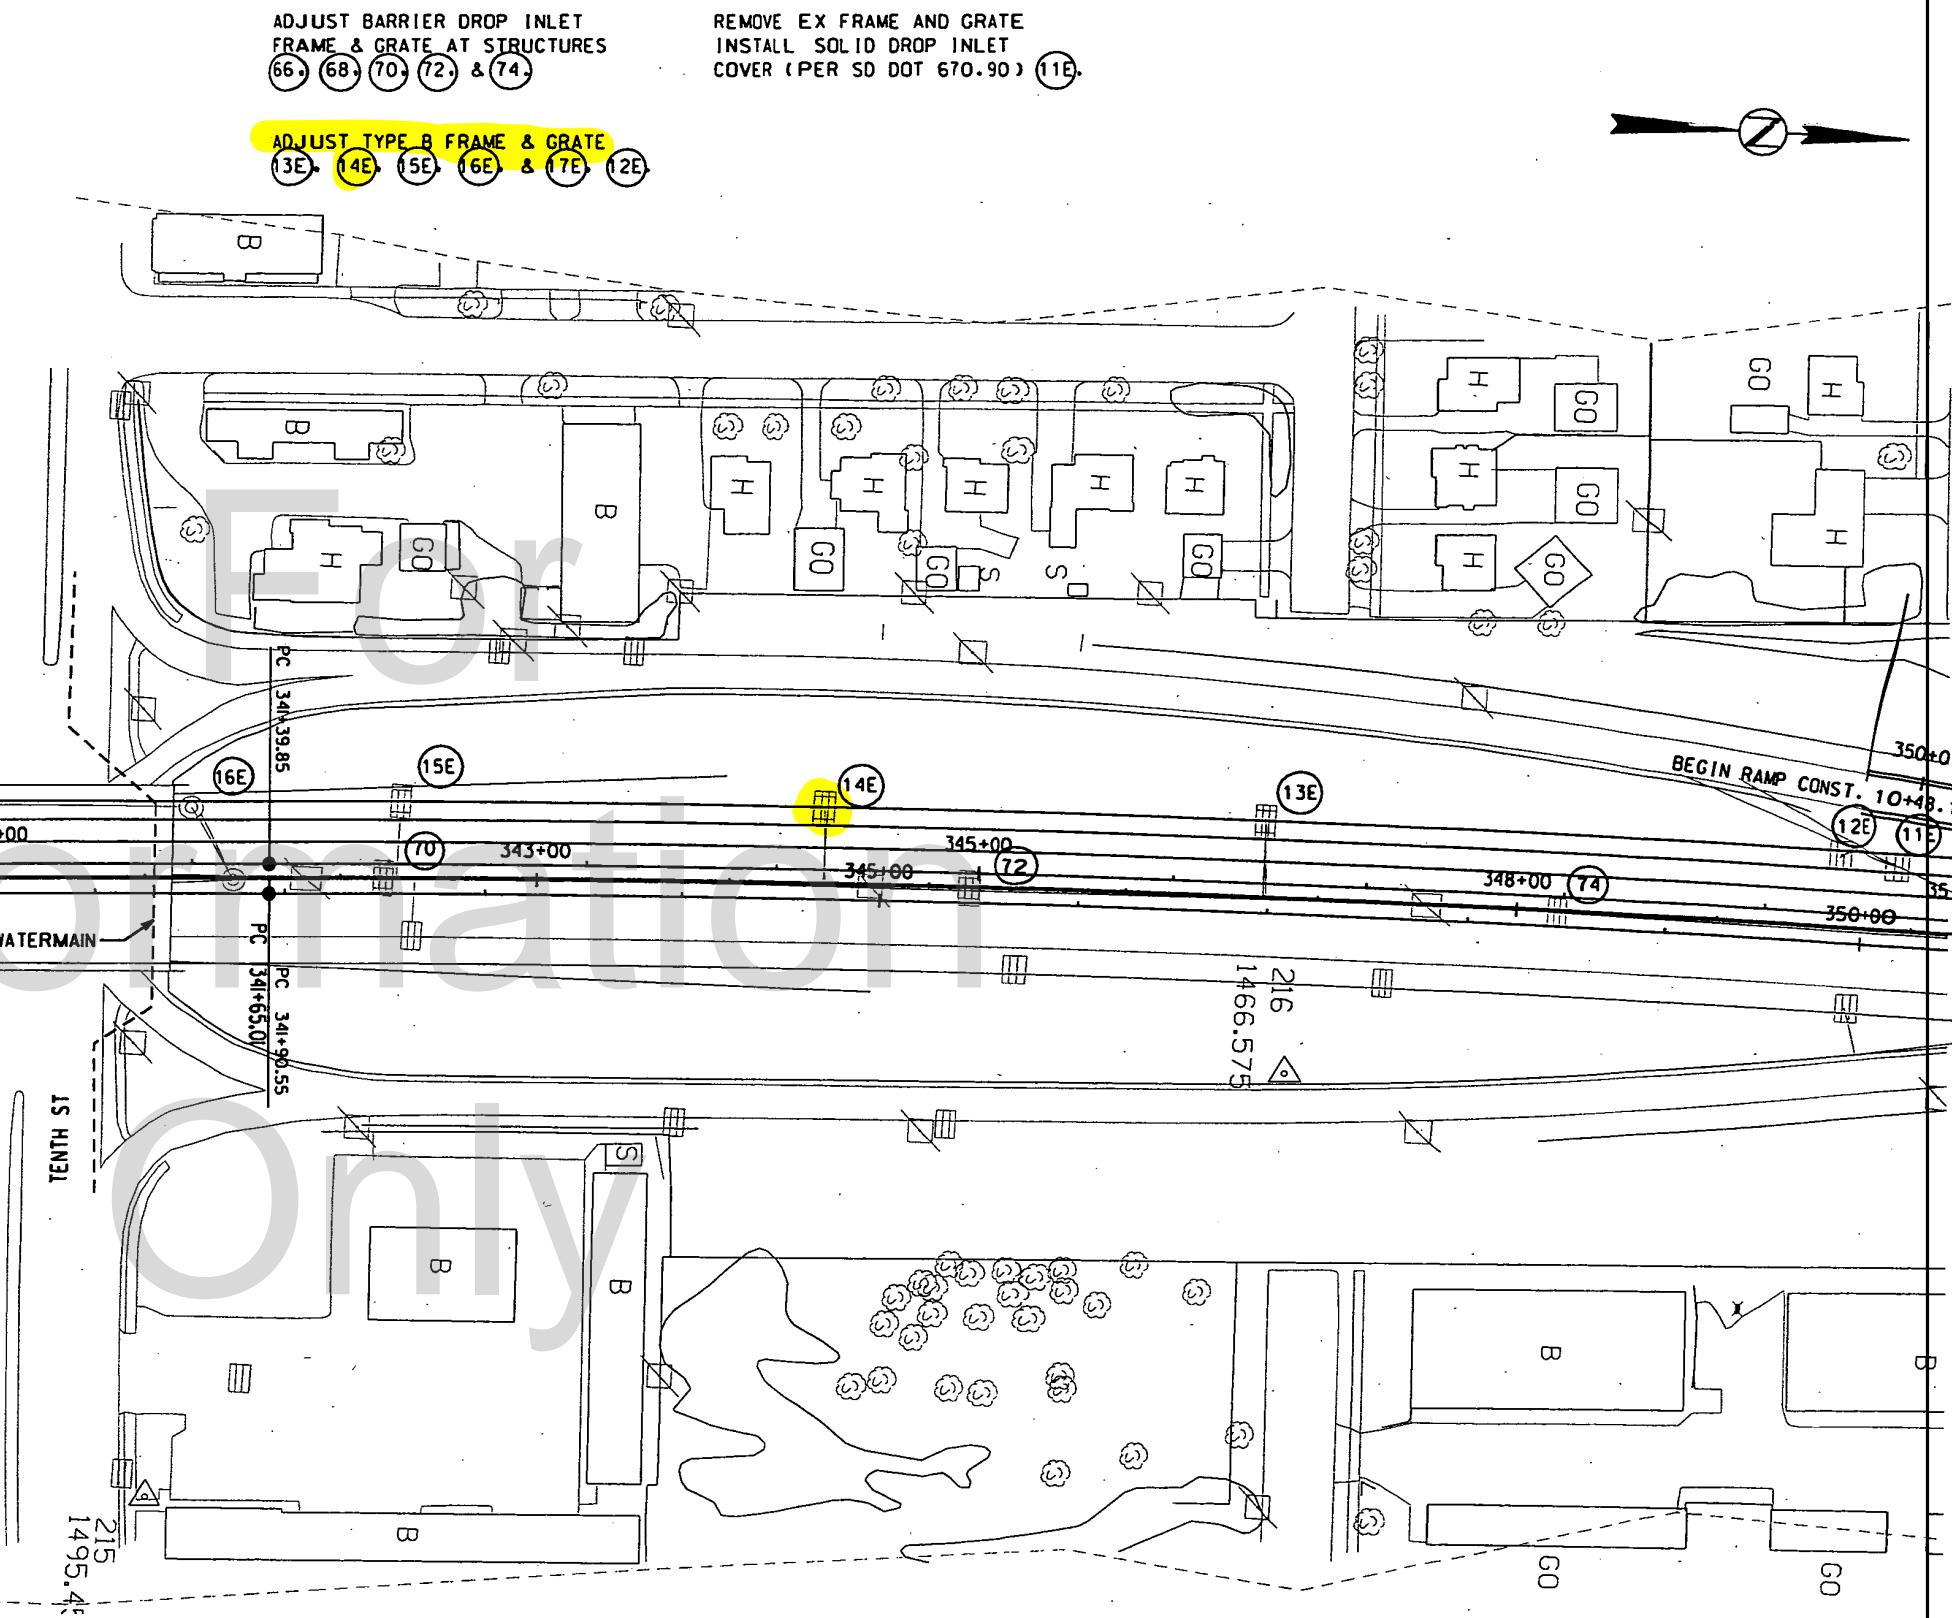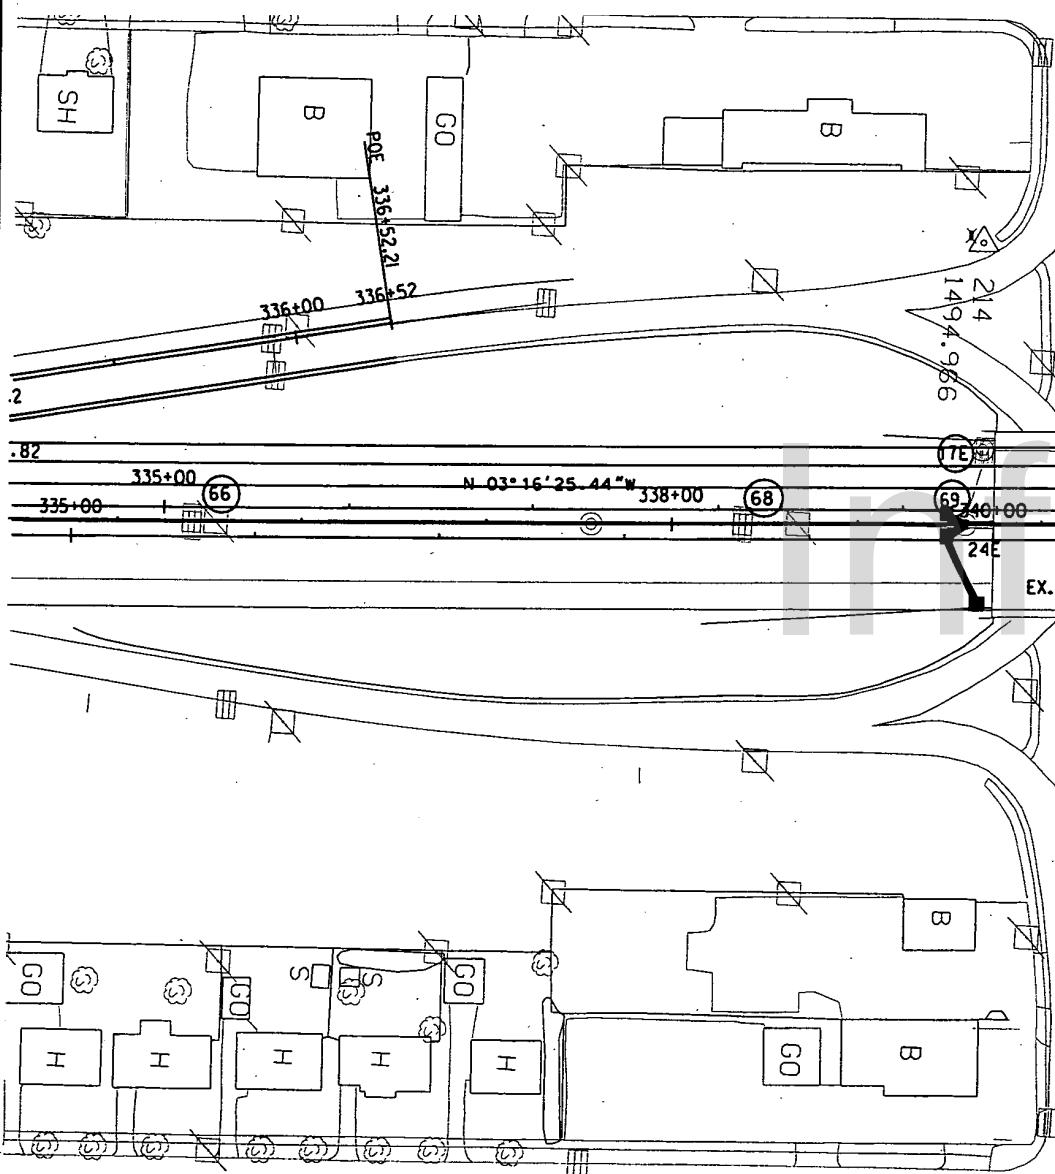


SCALE = 100'

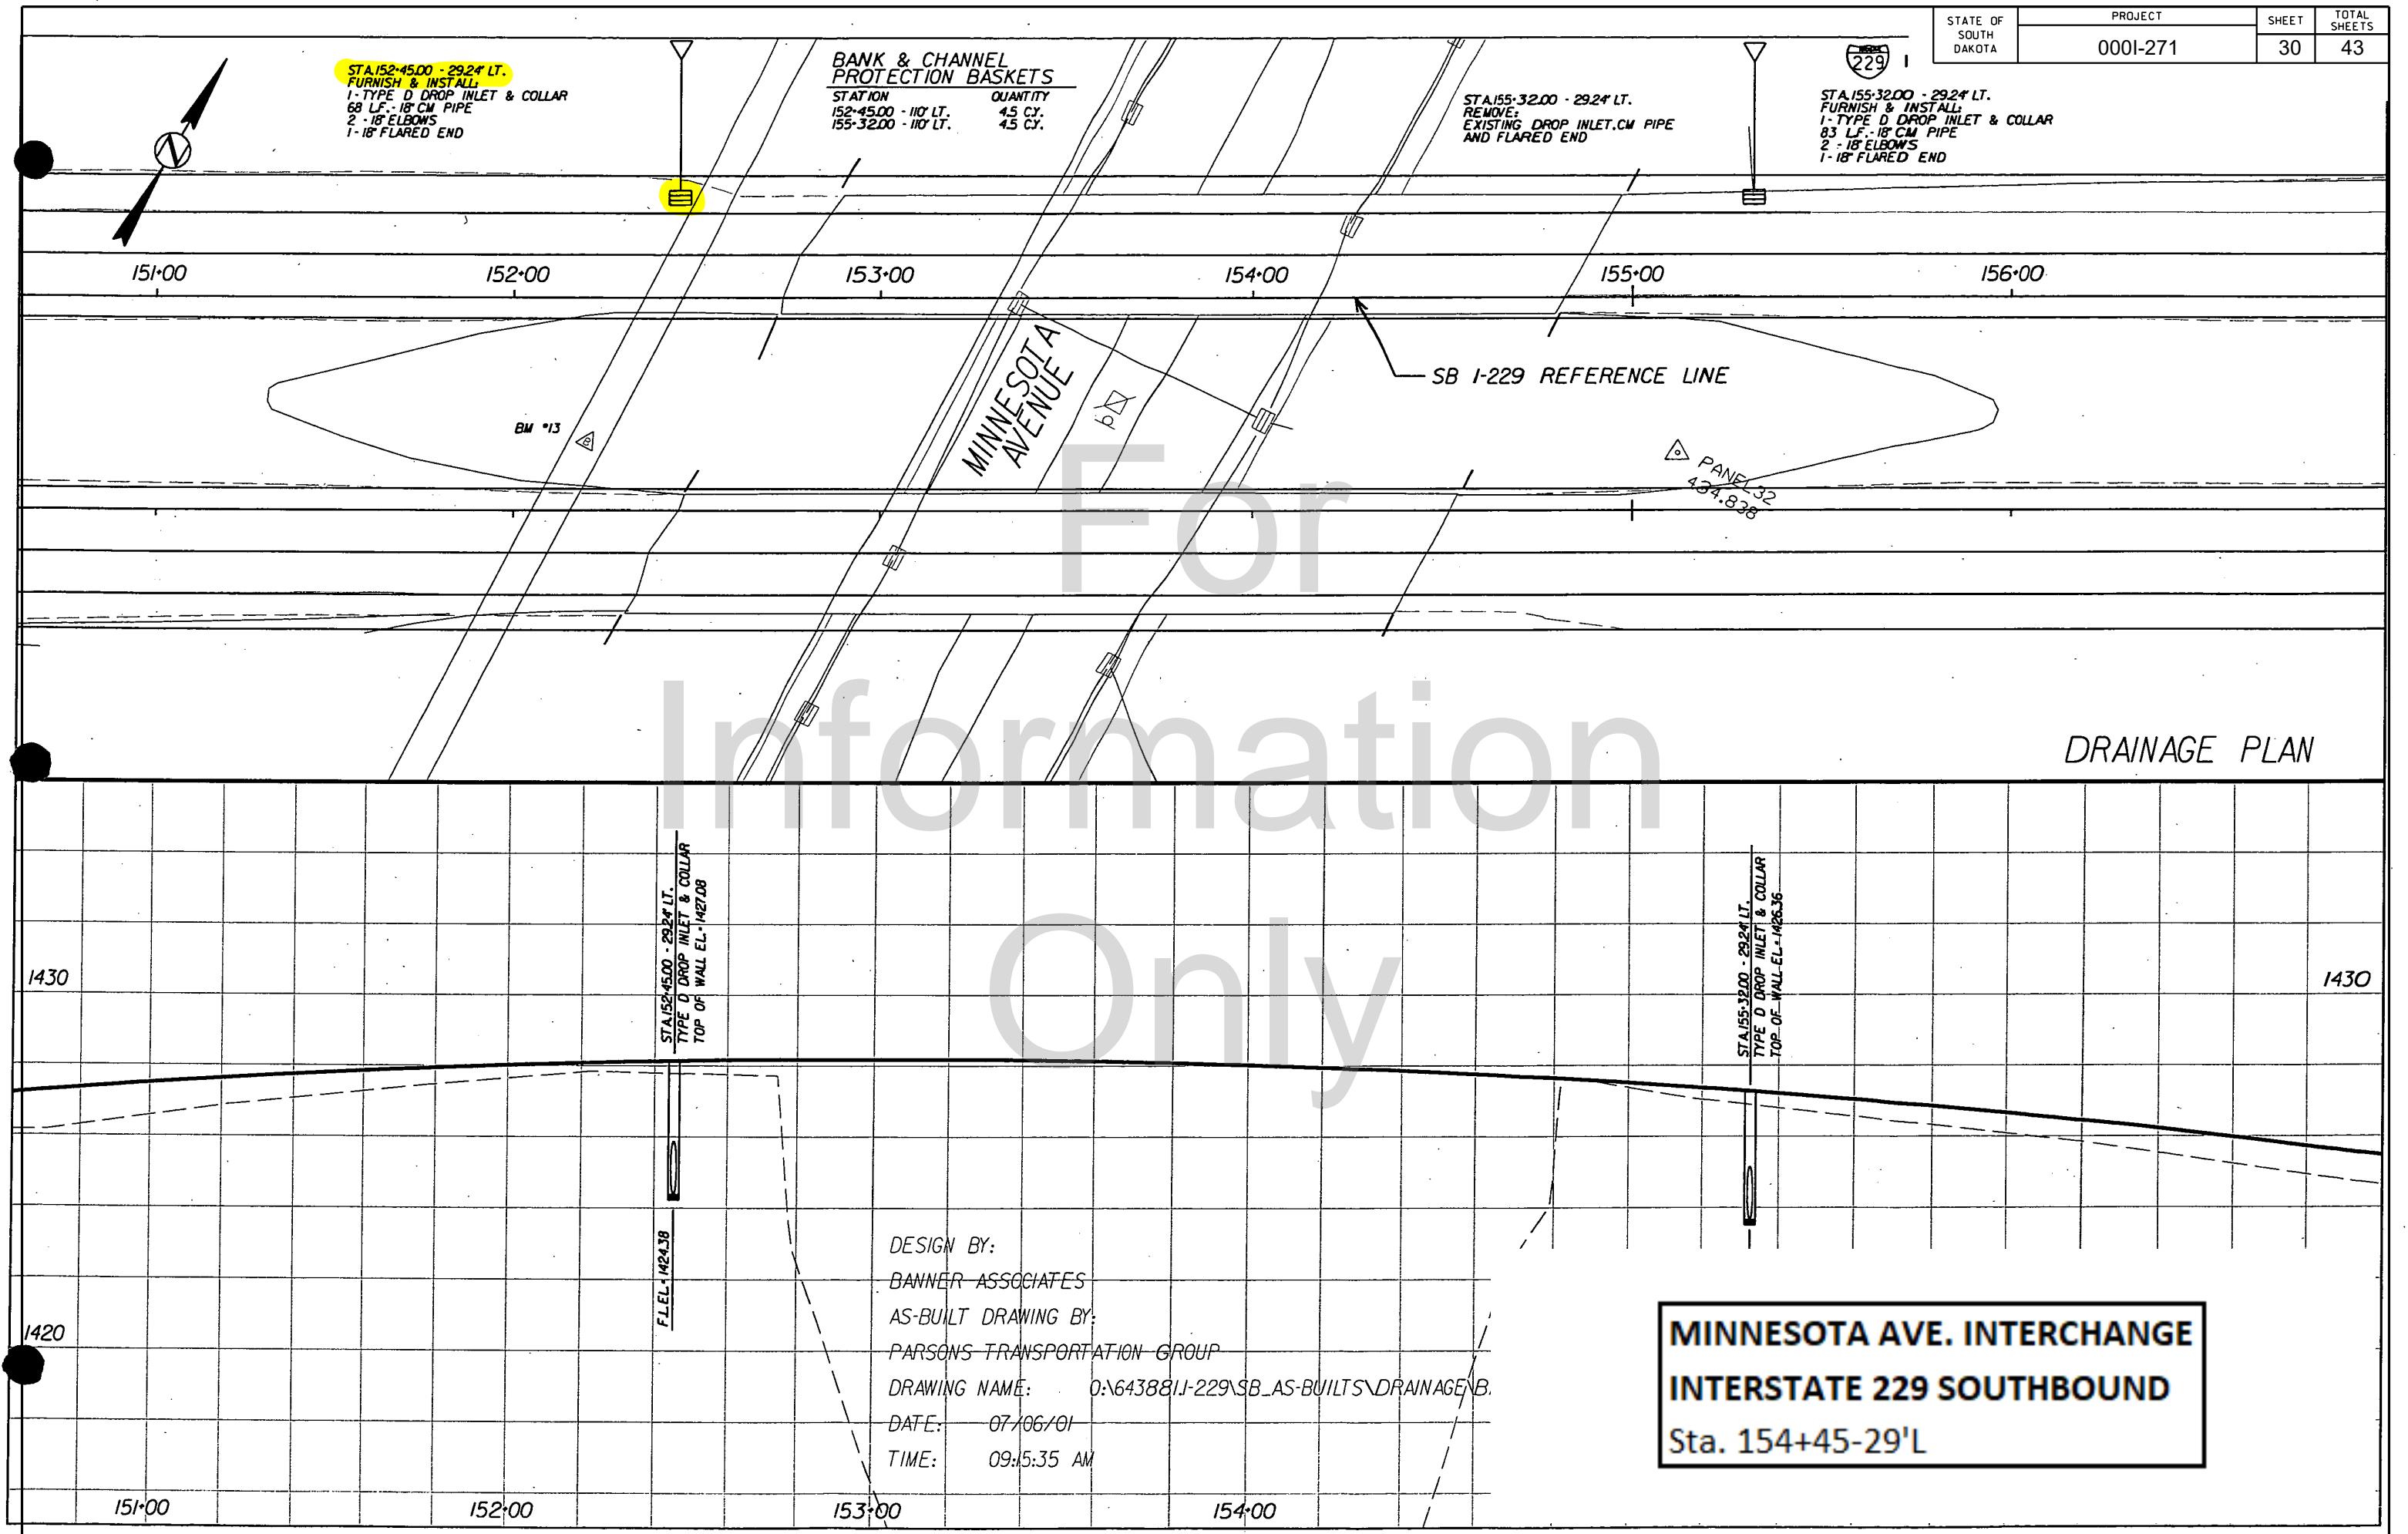

MINNESOTA AVE. INTERCHANGE
INTERSTATE 229 SOUTHBOUND
Sta. 154+45-29'L (MRM 3.010)

| | | | |
|-----------------------------|---------------------|-------------|-----------------------|
| STATE OF SOUTH DAKOTA | PROJECT 0001-271 | SHEET 31 | TOTAL SHEETS 43 |
|-----------------------------|---------------------|-------------|-----------------------|

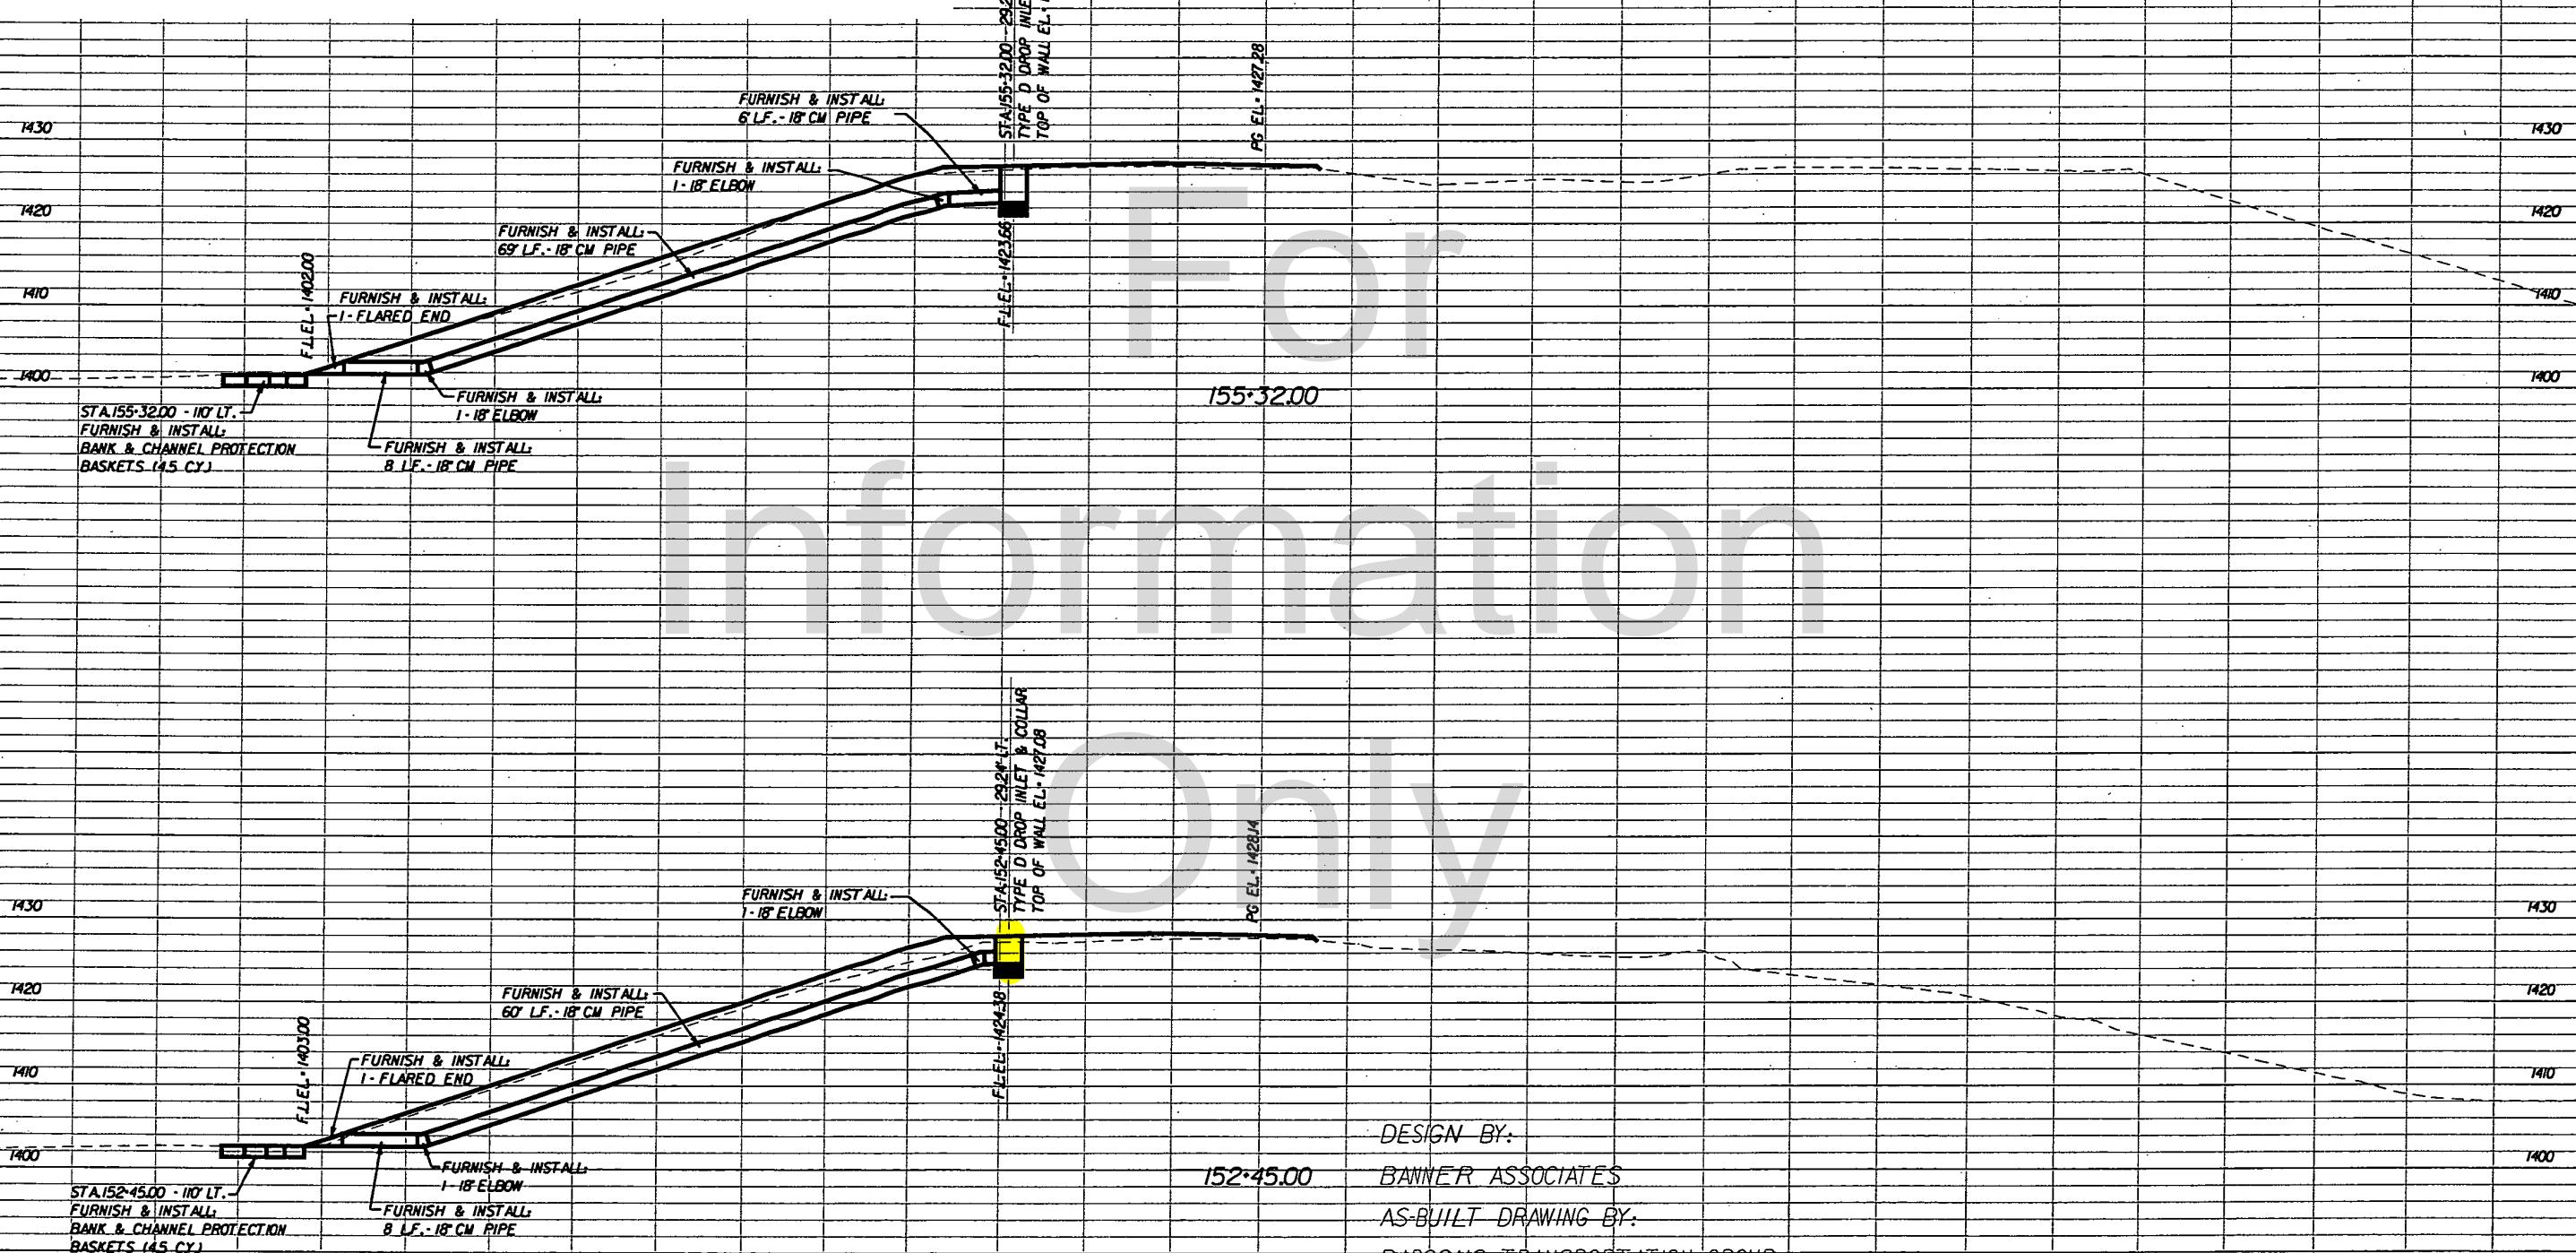

DESIGN BY:

BANNER ASSOCIATES

AS-BUILT DRAWING BY:


PARSONS TRANSPORTATION GROUP

DRAWING NAME: 0-64388I-229 SB AS-BUILTS\DRainage\Banner\Minn-Xsec.dgn

DATE: 07/06/01

TIME: 09:49:55 AM


DRAINAGE CROSS SECTION
AT MINNESOTA AVE.

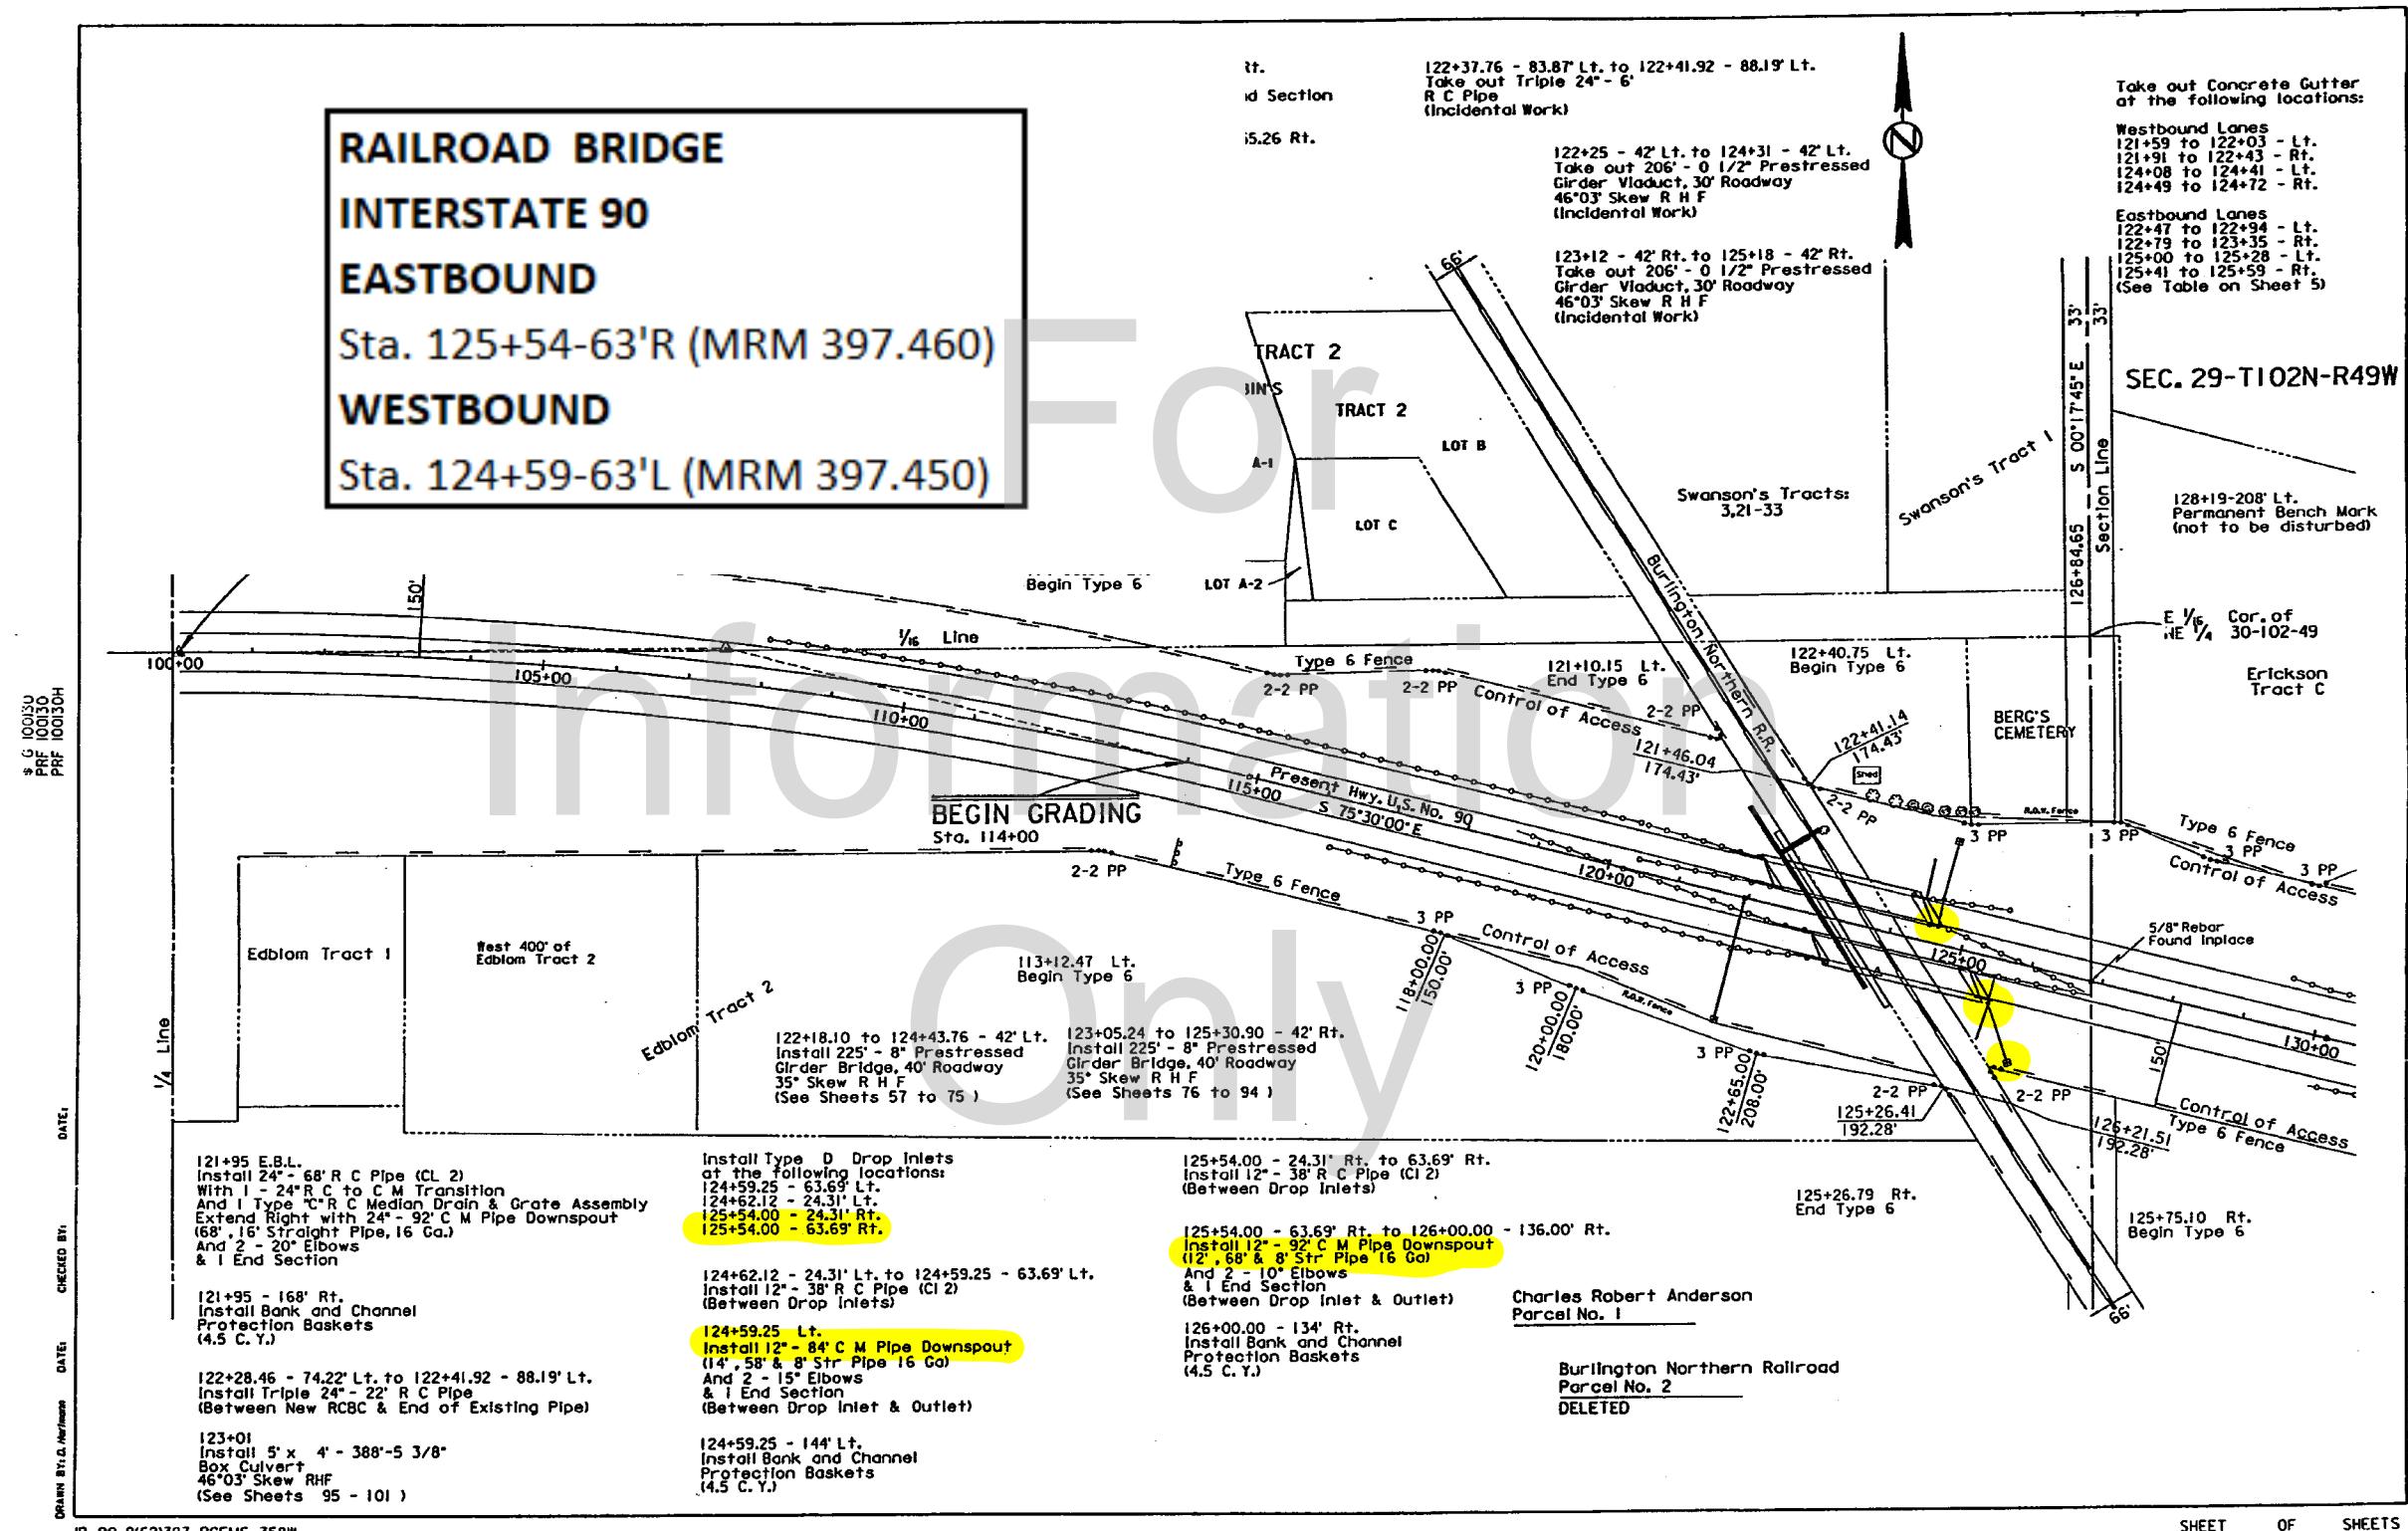



RAILROAD BRIDGE
INTERSTATE 90
EASTBOUND
Sta. 125+54-63'R (MRM 397.460)
WESTBOUND
Sta. 124+59-63'L (MRM 397.450)
PNT LOGISOP
PRF LOGISOPHDRAWN BY D. Normann
DATE

CHECKED BY

DATE

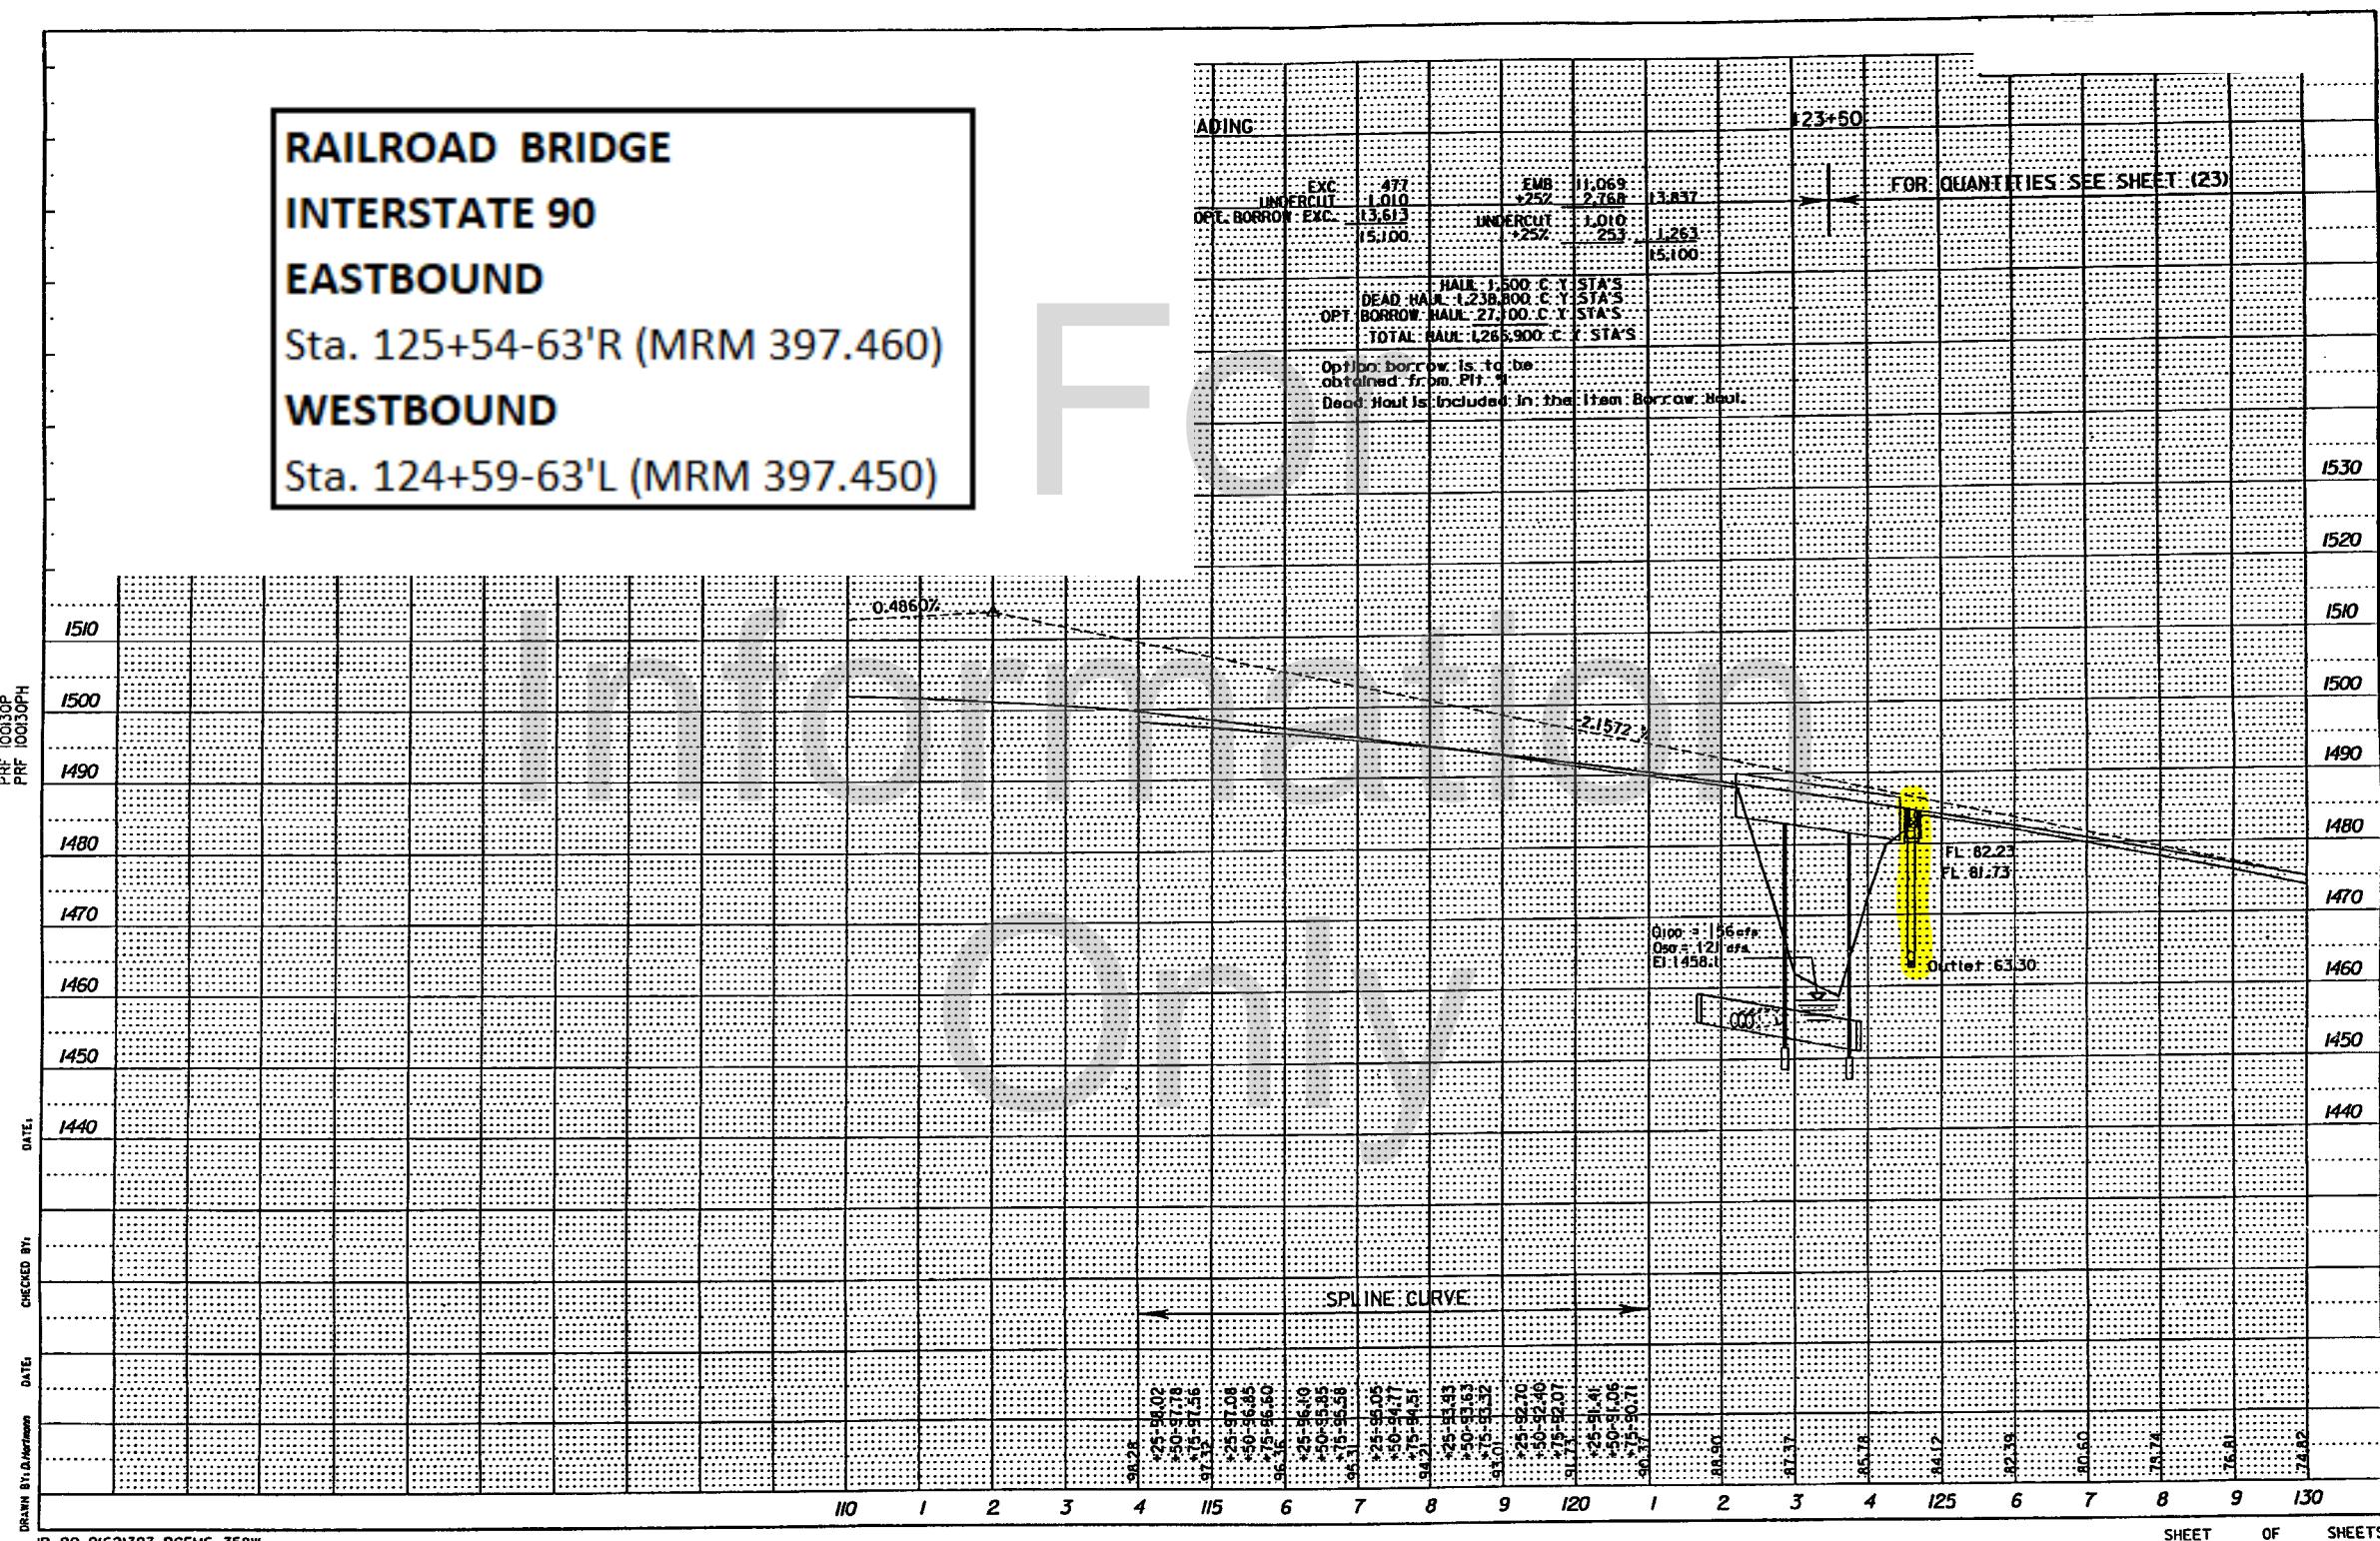

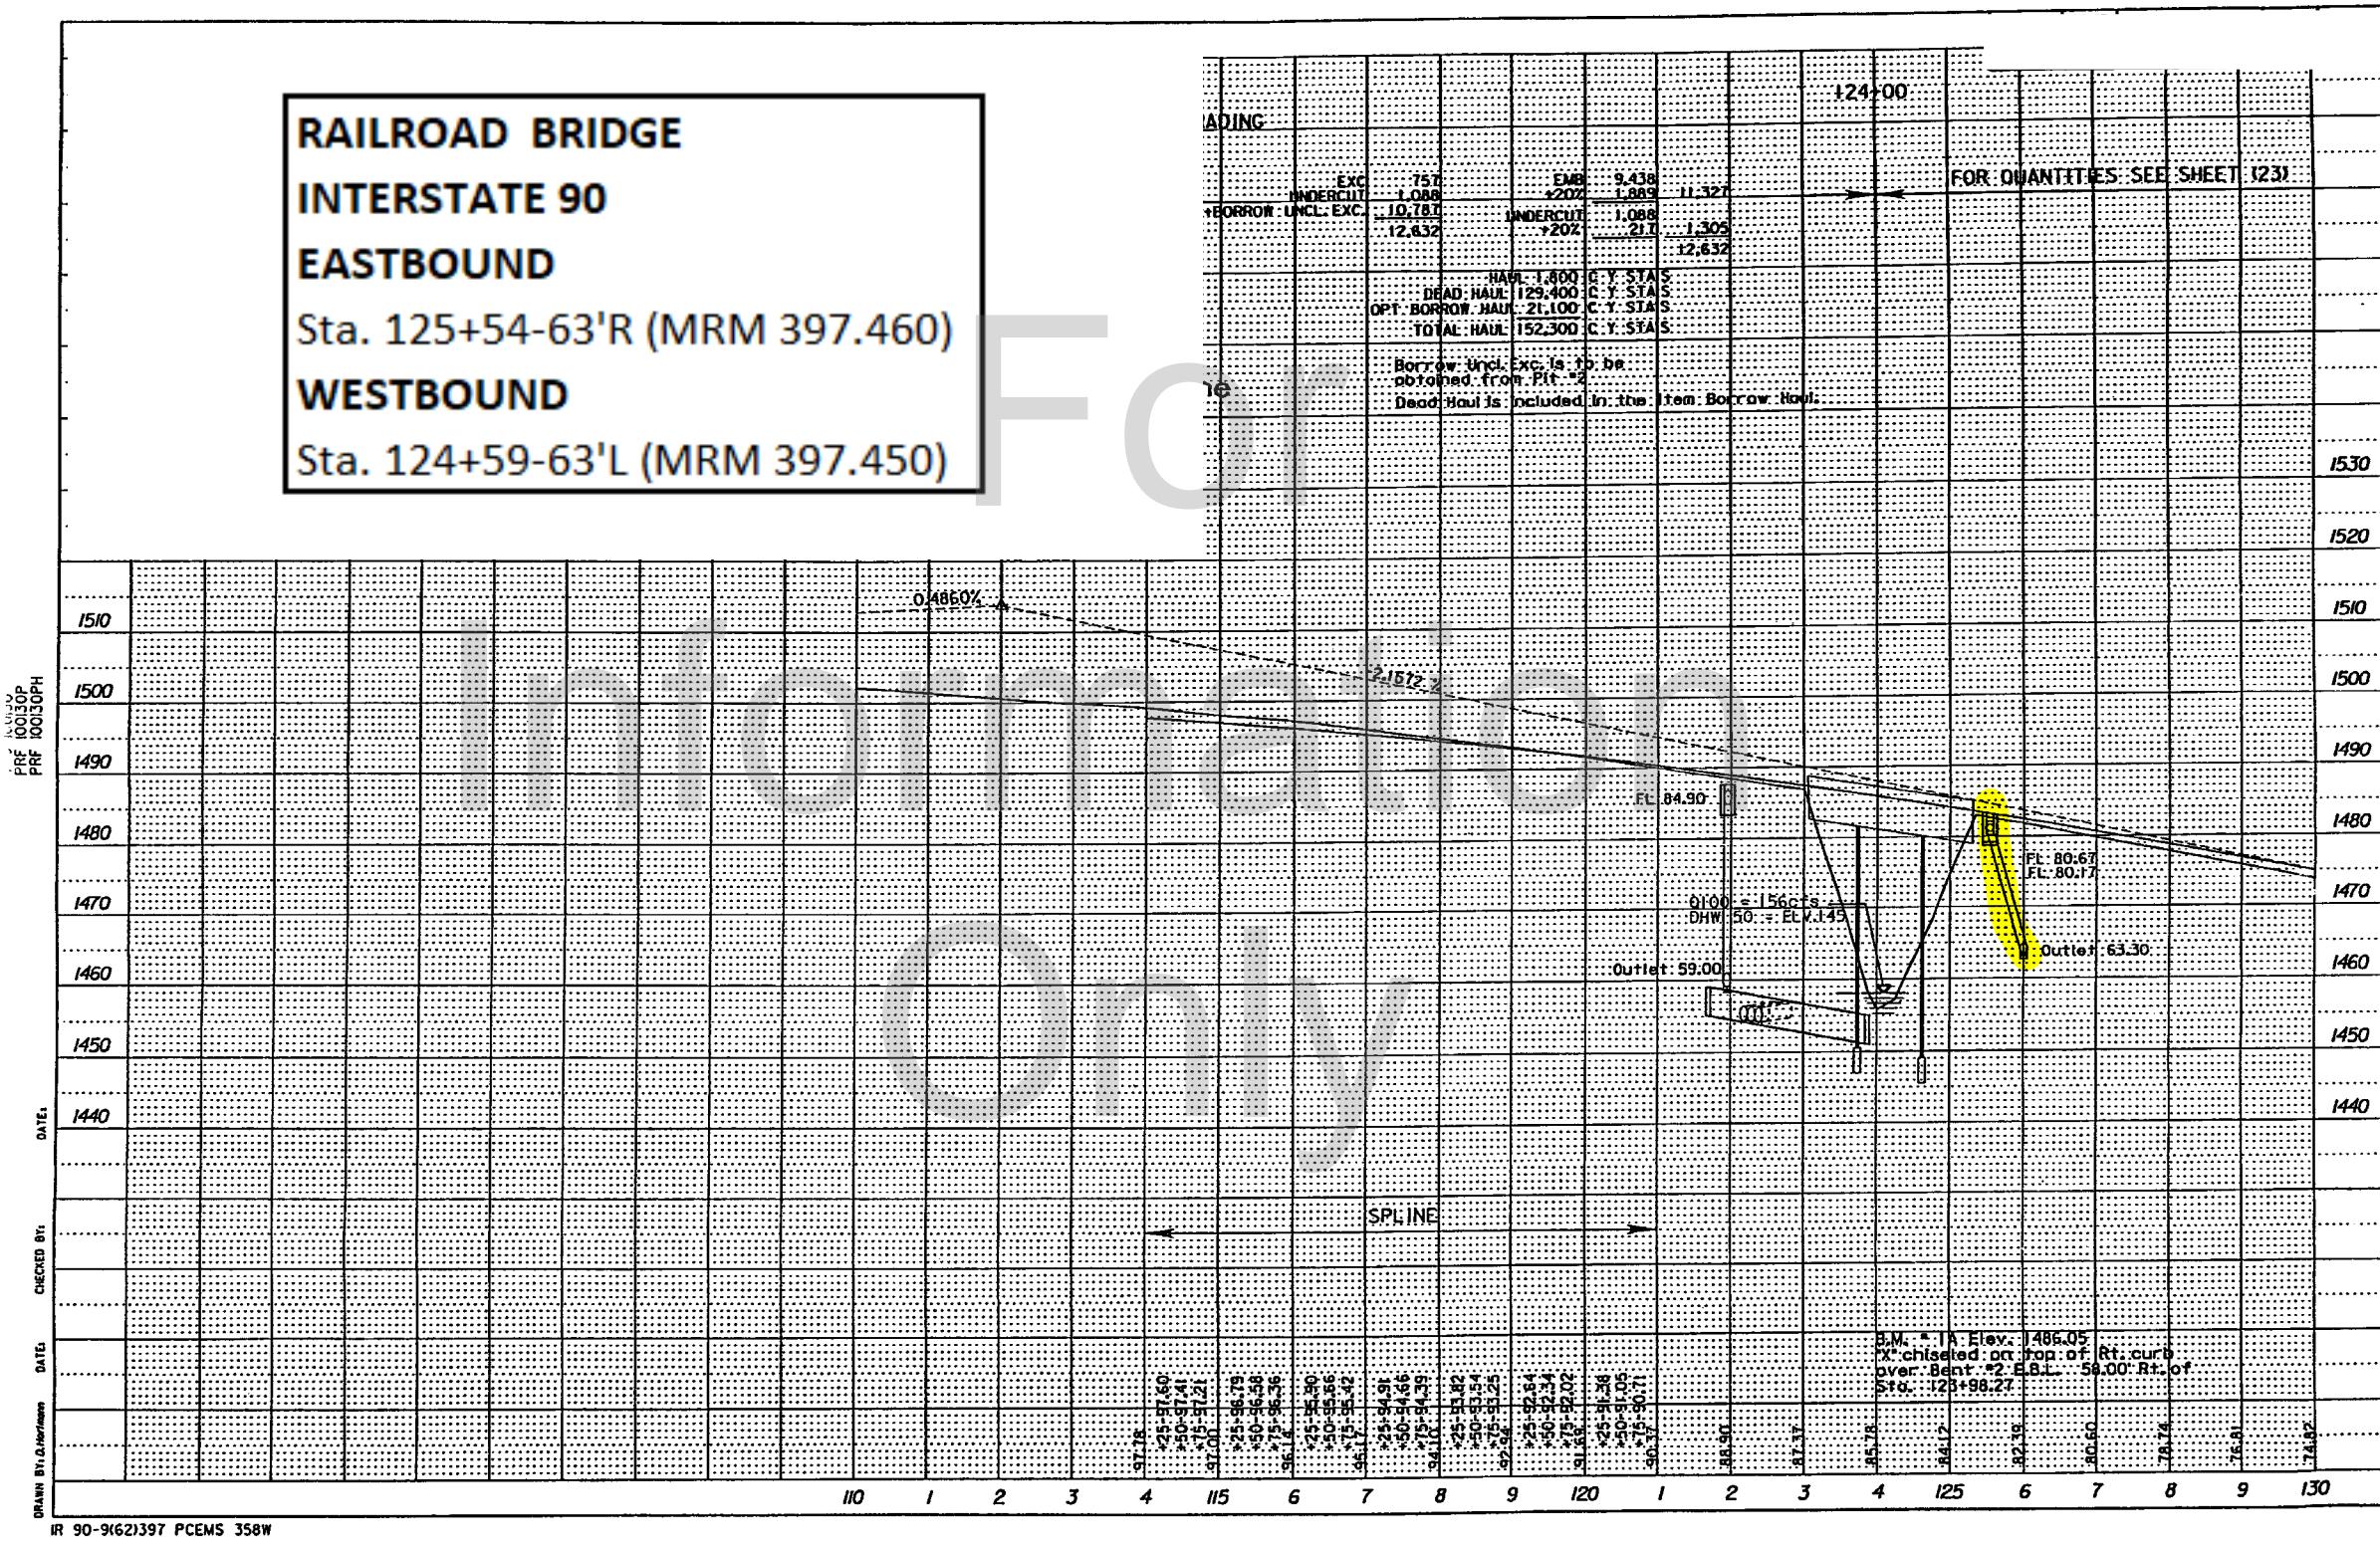

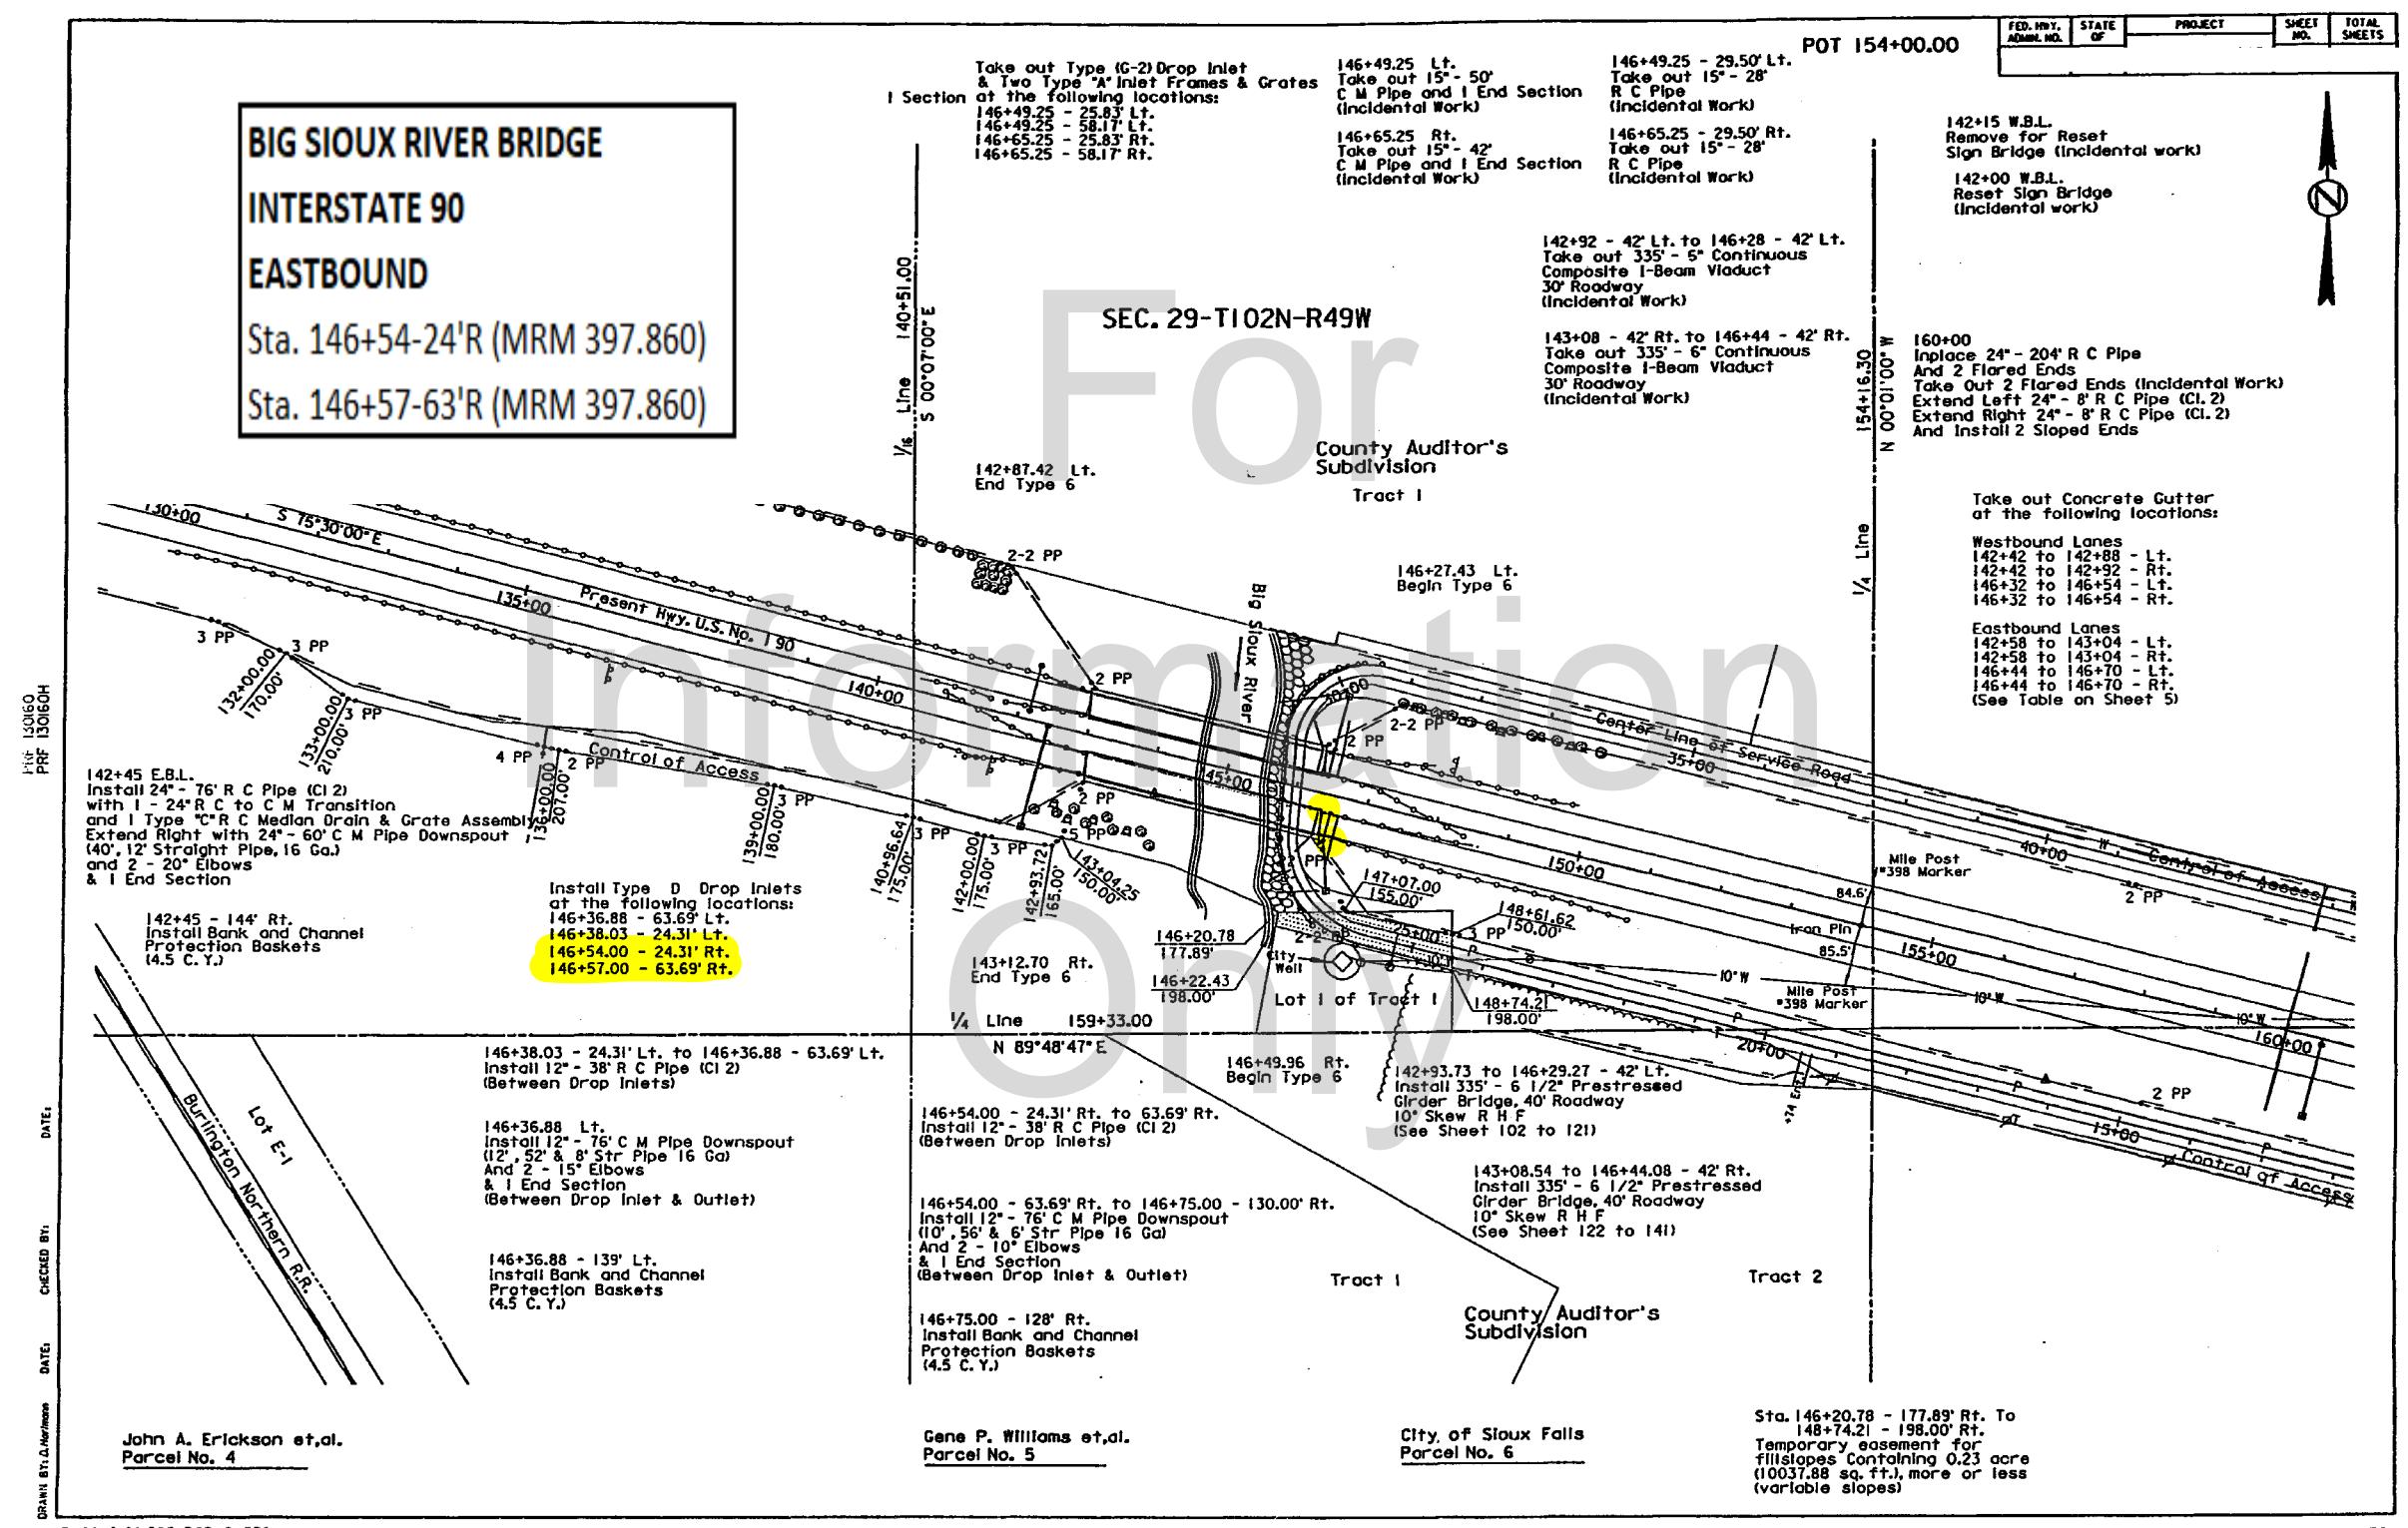

BIG SIOUX RIVER BRIDGE

INTERSTATE 90

EASTBOUND


Sta. 177+72-24'R (MRM 398.450)

WESTBOUND


Sta. 177+09-24'L (MRM 398.440)

Sta. 177+09-63'L (MRM 398.440)


PRF 16090
PRF 16090H

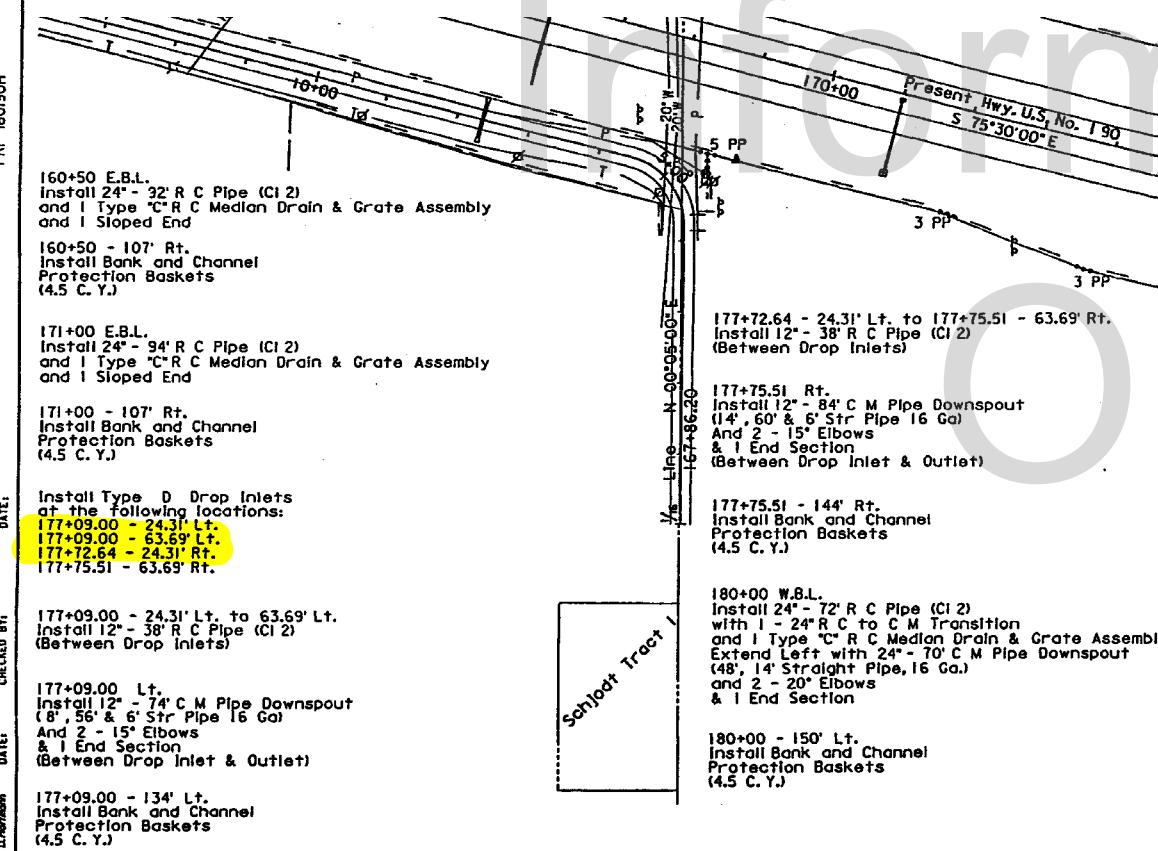

IR 90-9(62)397 PCEMS 358W

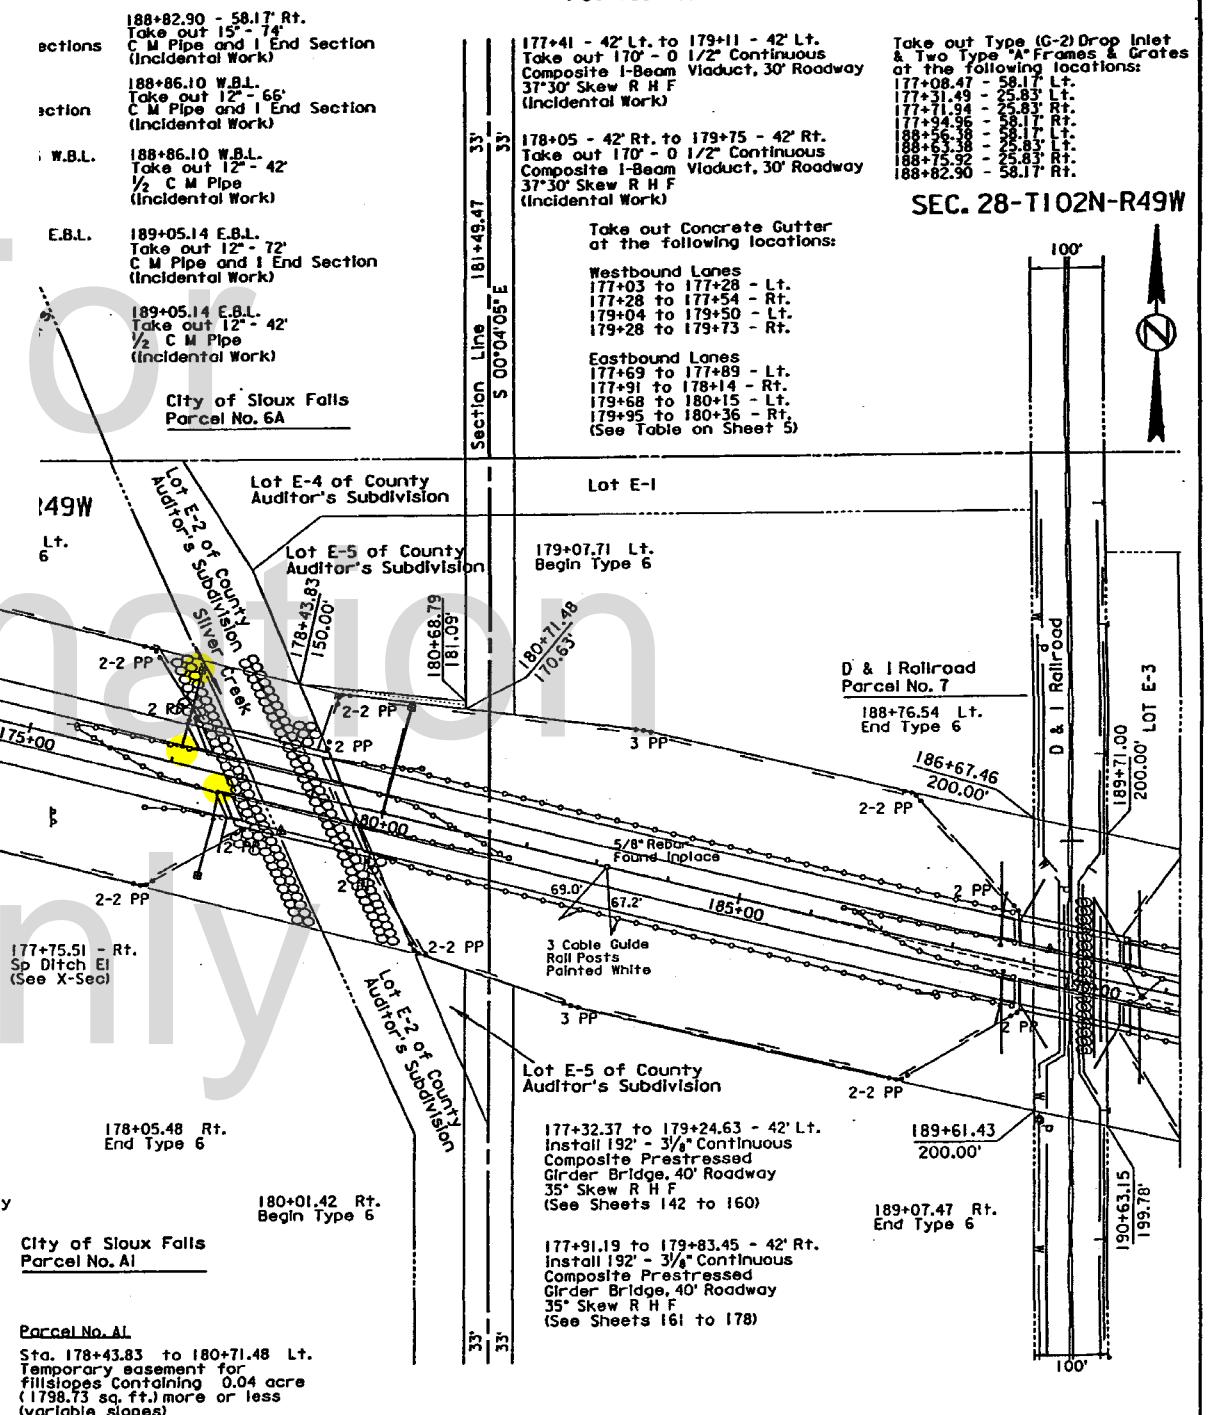

SHEET NO. SHEETS

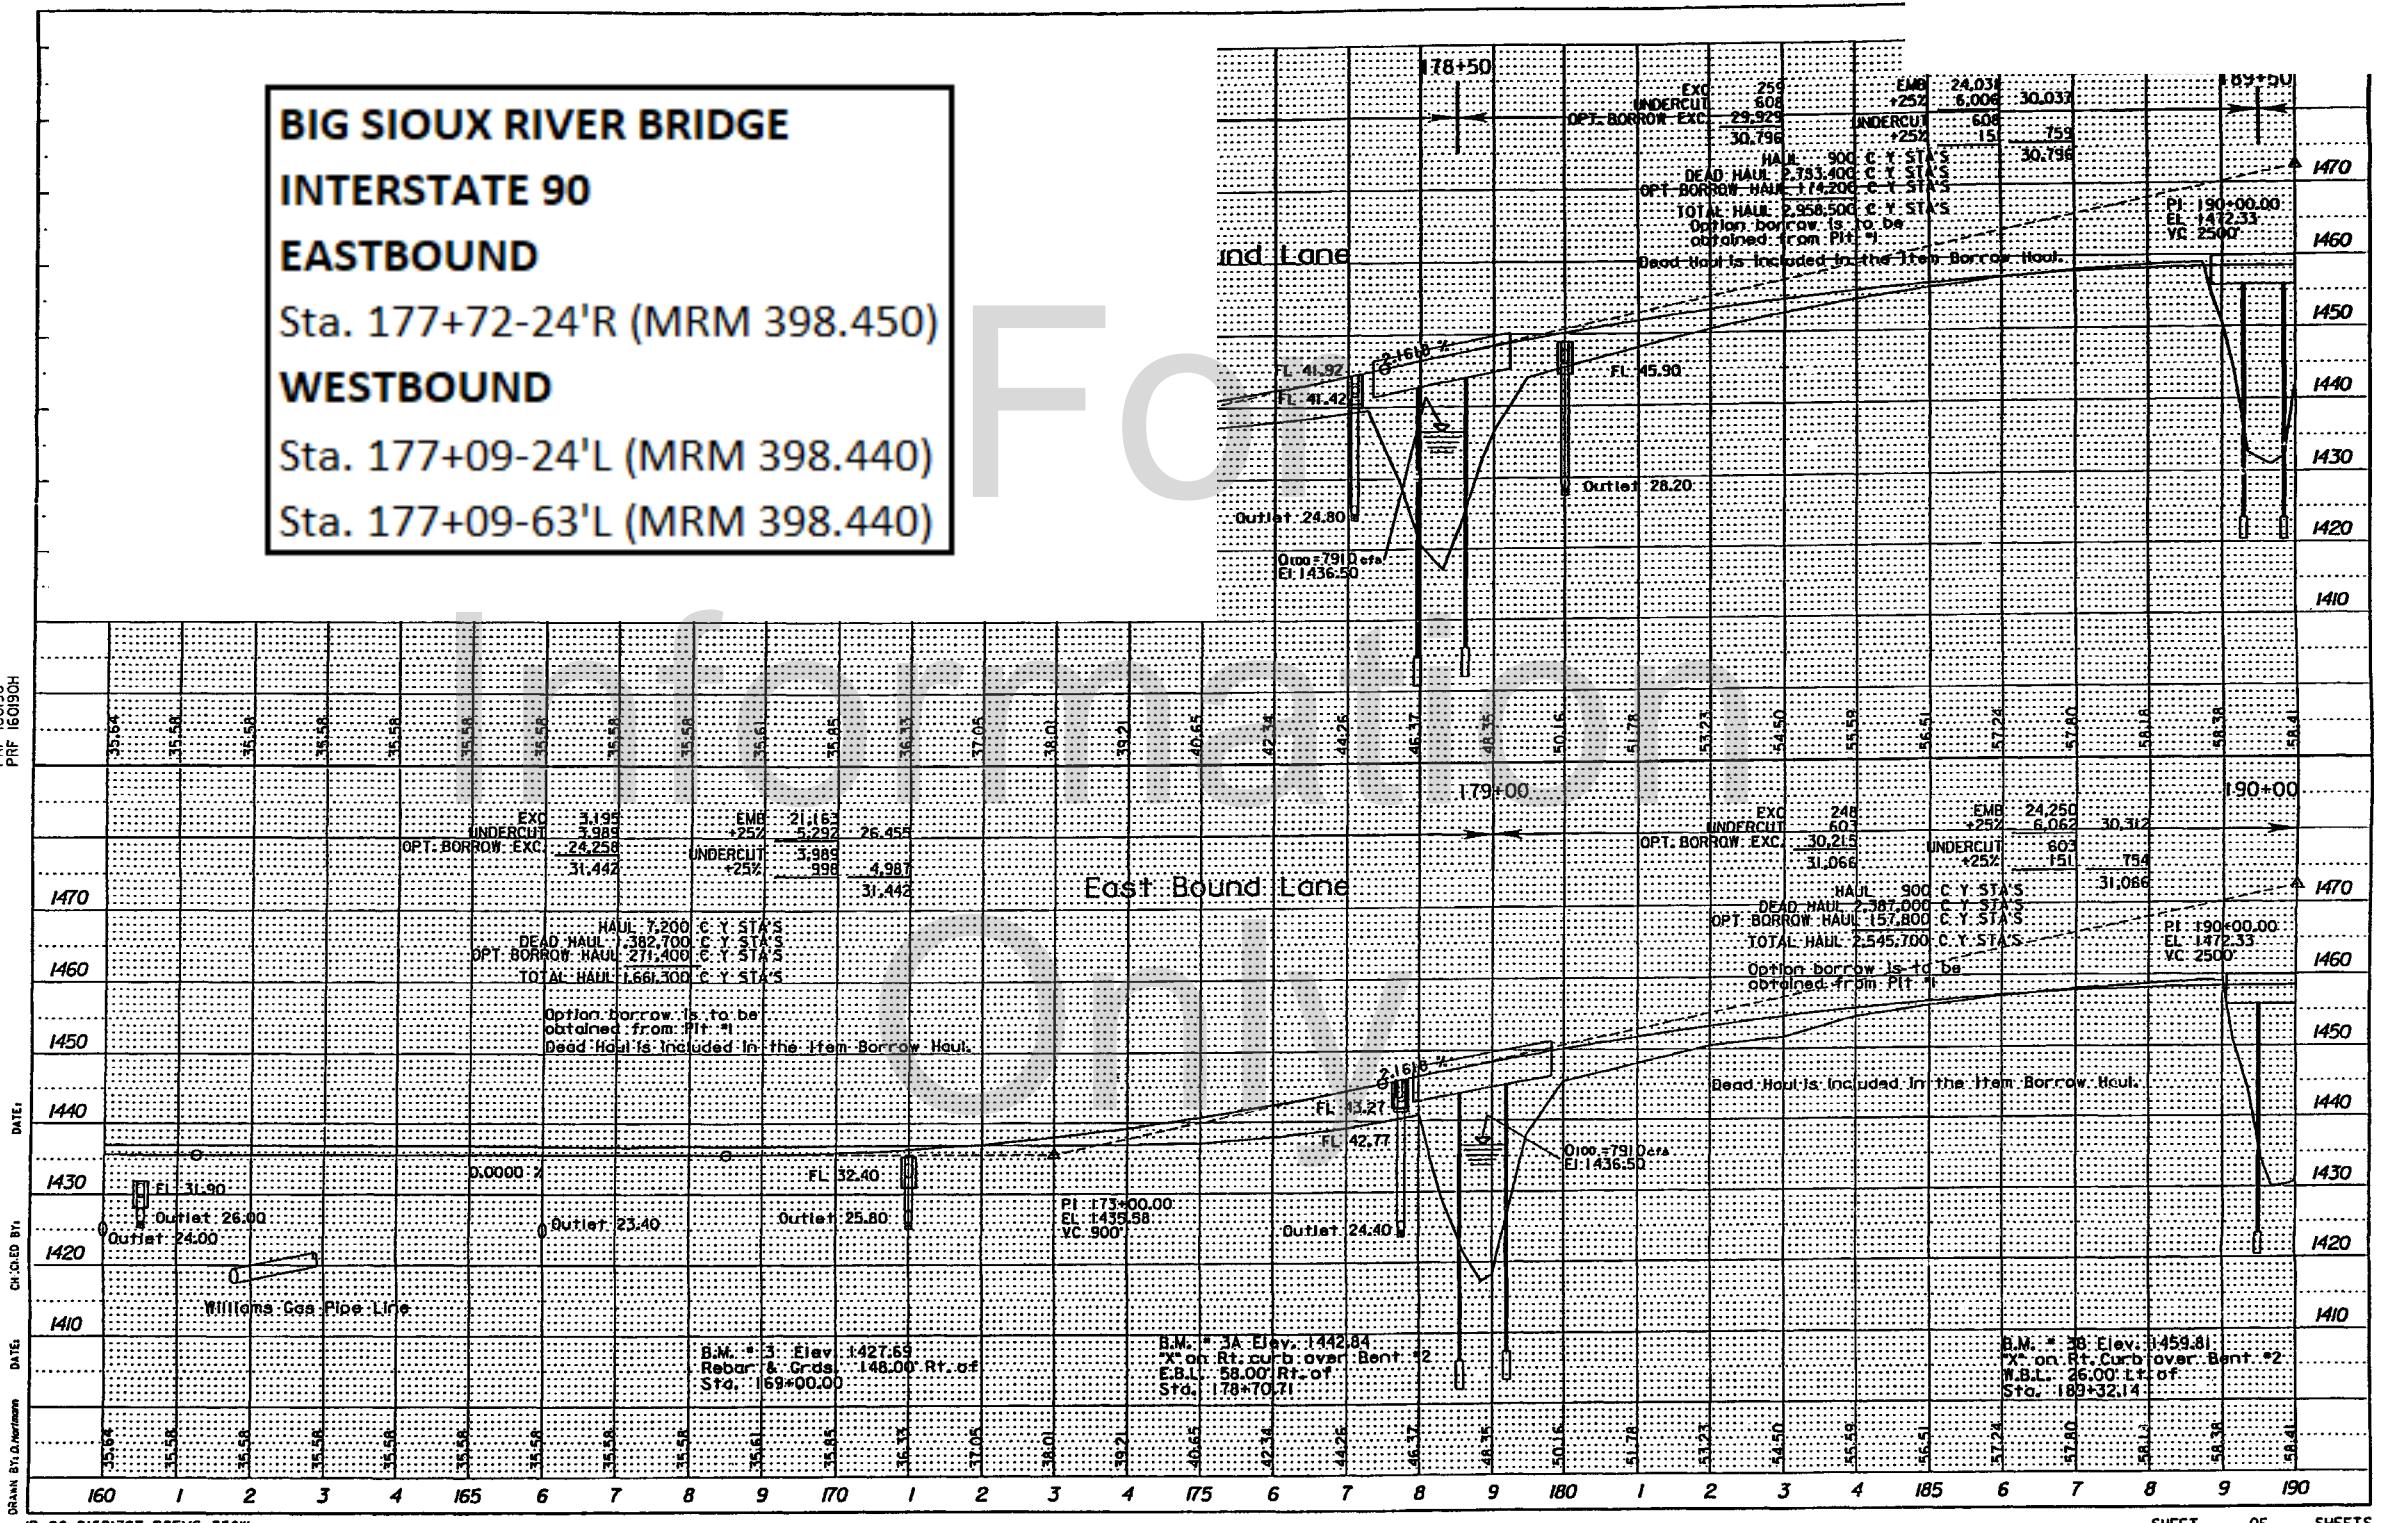

INTERSTATE 90 CLIFF AVE.


EASTBOUND

Sta. 56+13-24'R (MRM 399.460)

WESTBOUND

Sta. 56+13-24'L (MRM 399.460)


Sta. 56+13-63'L (MRM 399.460)

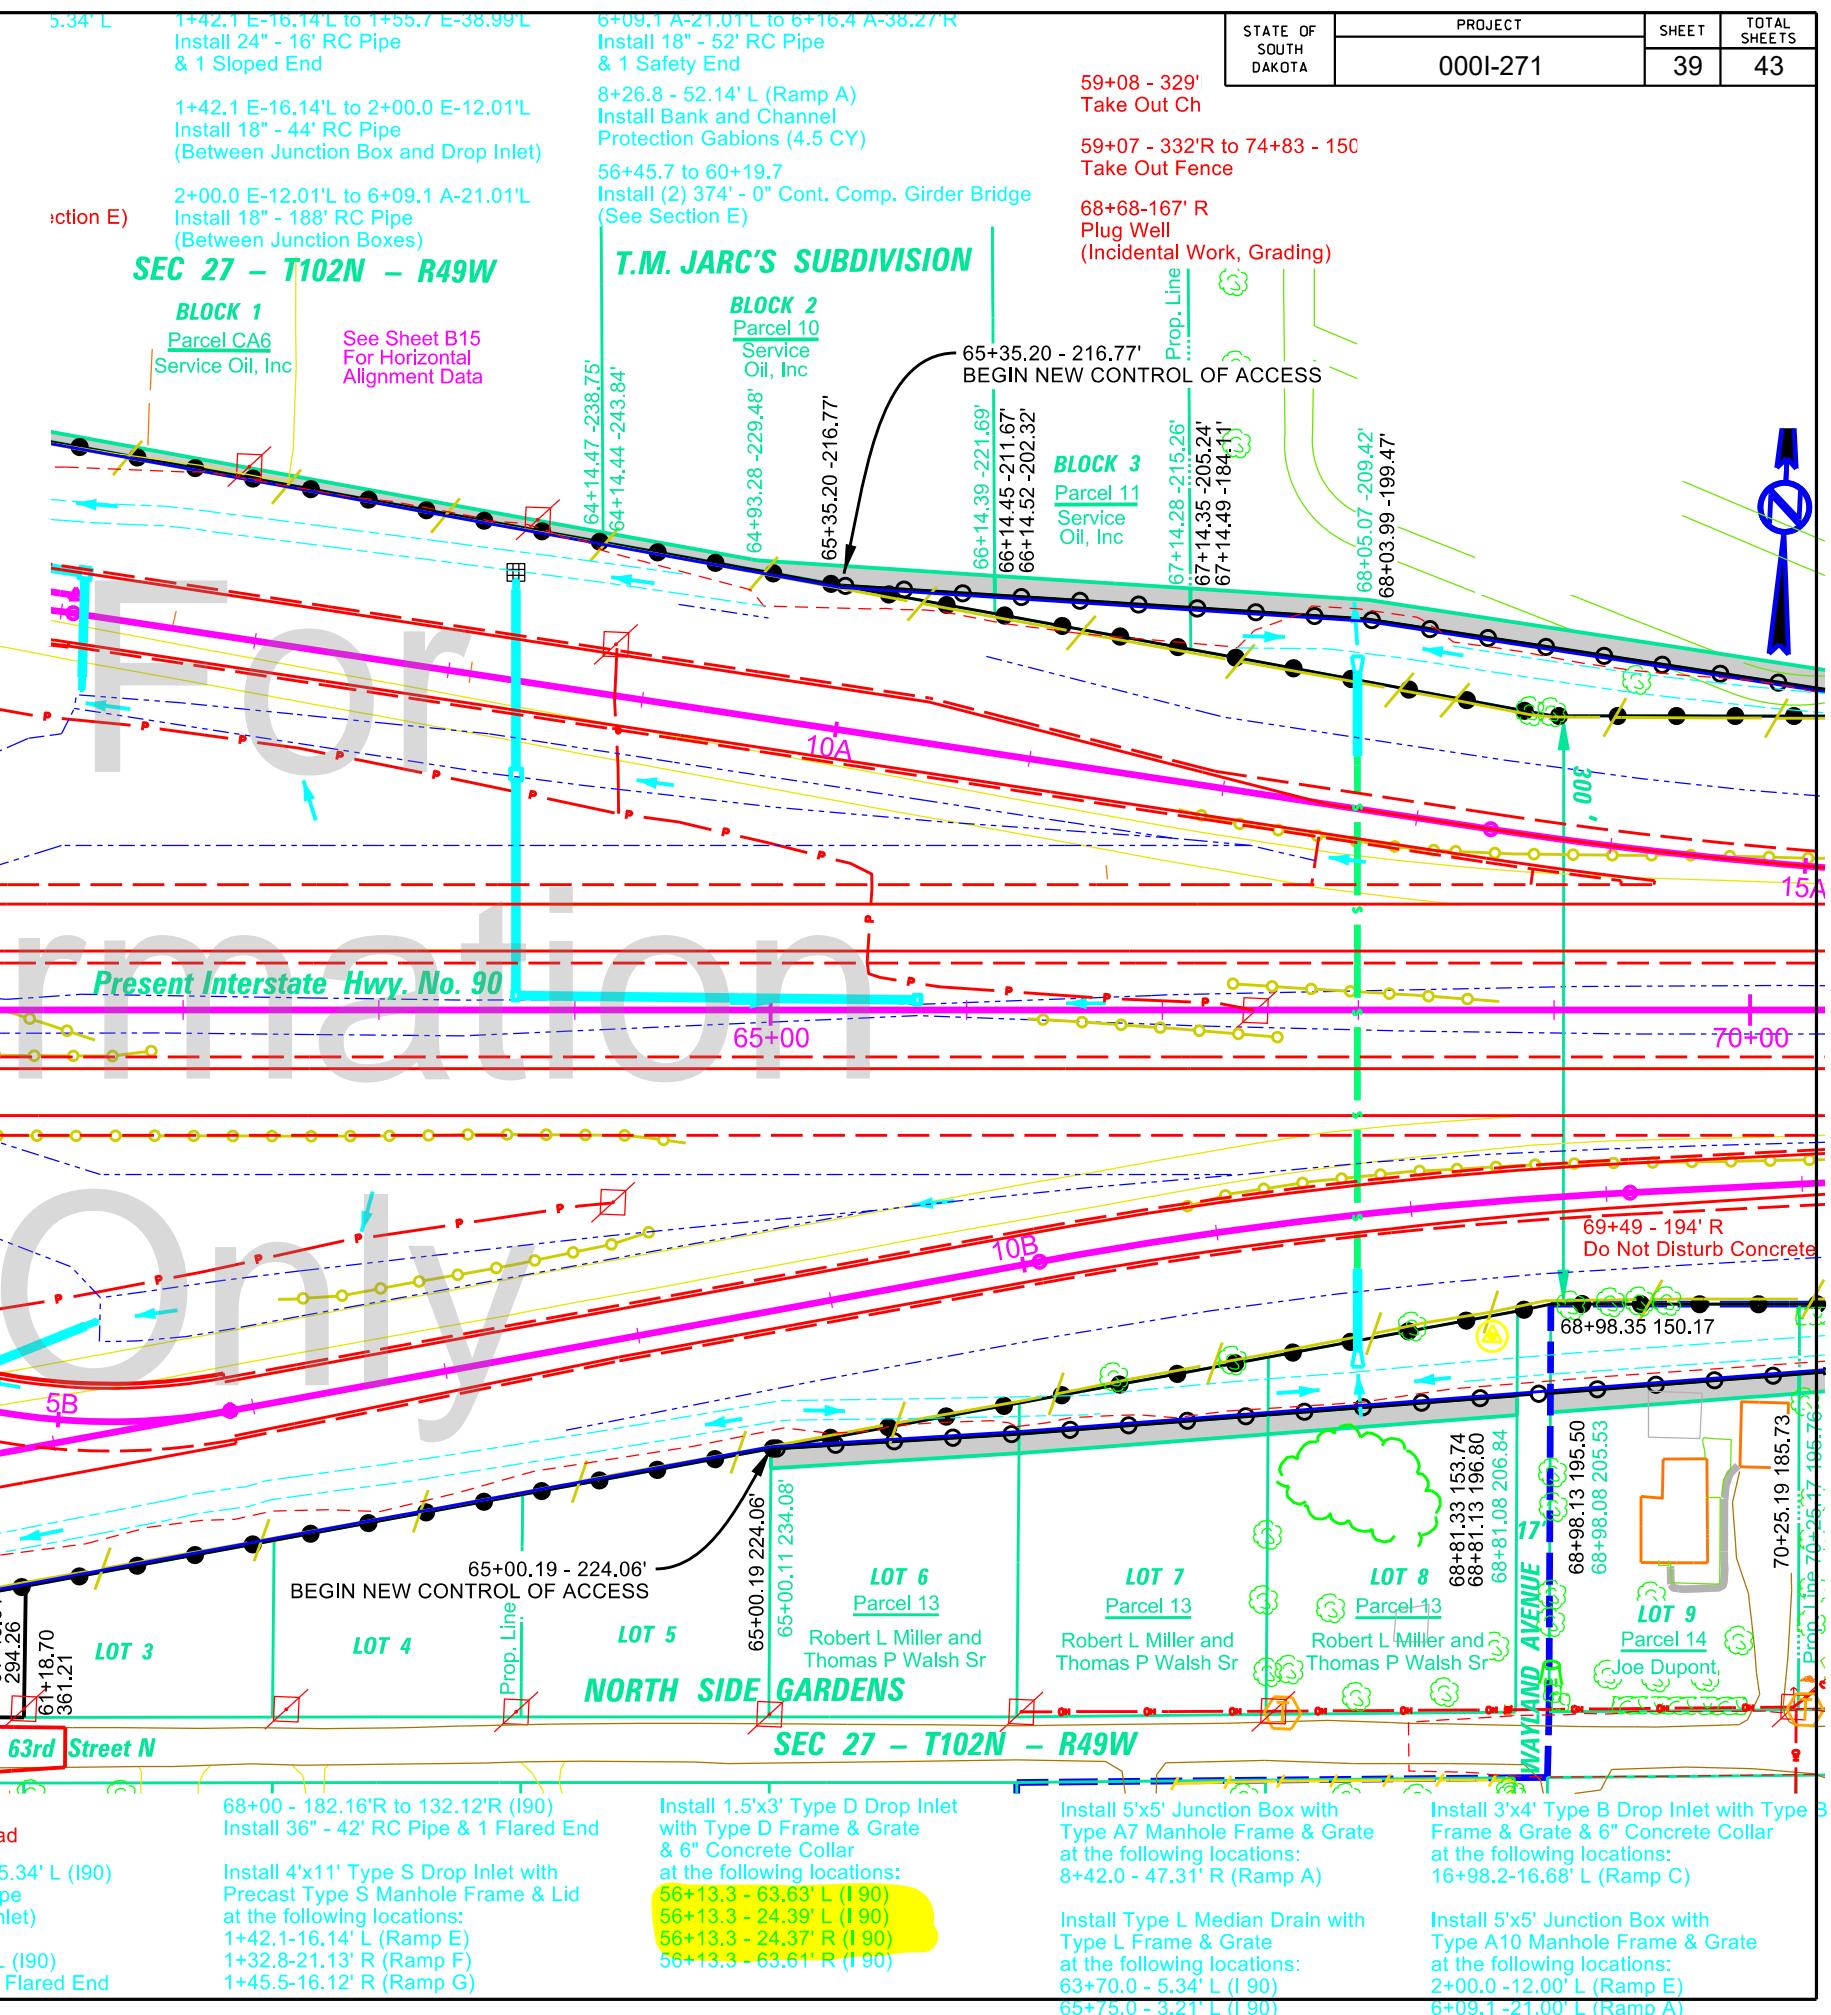

INTERSTATE 229 CLIFF AVE.
EASTBOUND
Sta. 56+13-24'R (MRM 399.460)
WESTBOUND
Sta. 56+13-24'L (MRM 399.460)
Sta. 56+13-63'L (MRM 399.460)

| | | | |
|-----------------------------|---------------------|-------------|-----------------------|
| STATE OF SOUTH DAKOTA | PROJECT 0001-271 | SHEET 40 | TOTAL SHEETS 43 |
|-----------------------------|---------------------|-------------|-----------------------|

I-90 MAINLINE

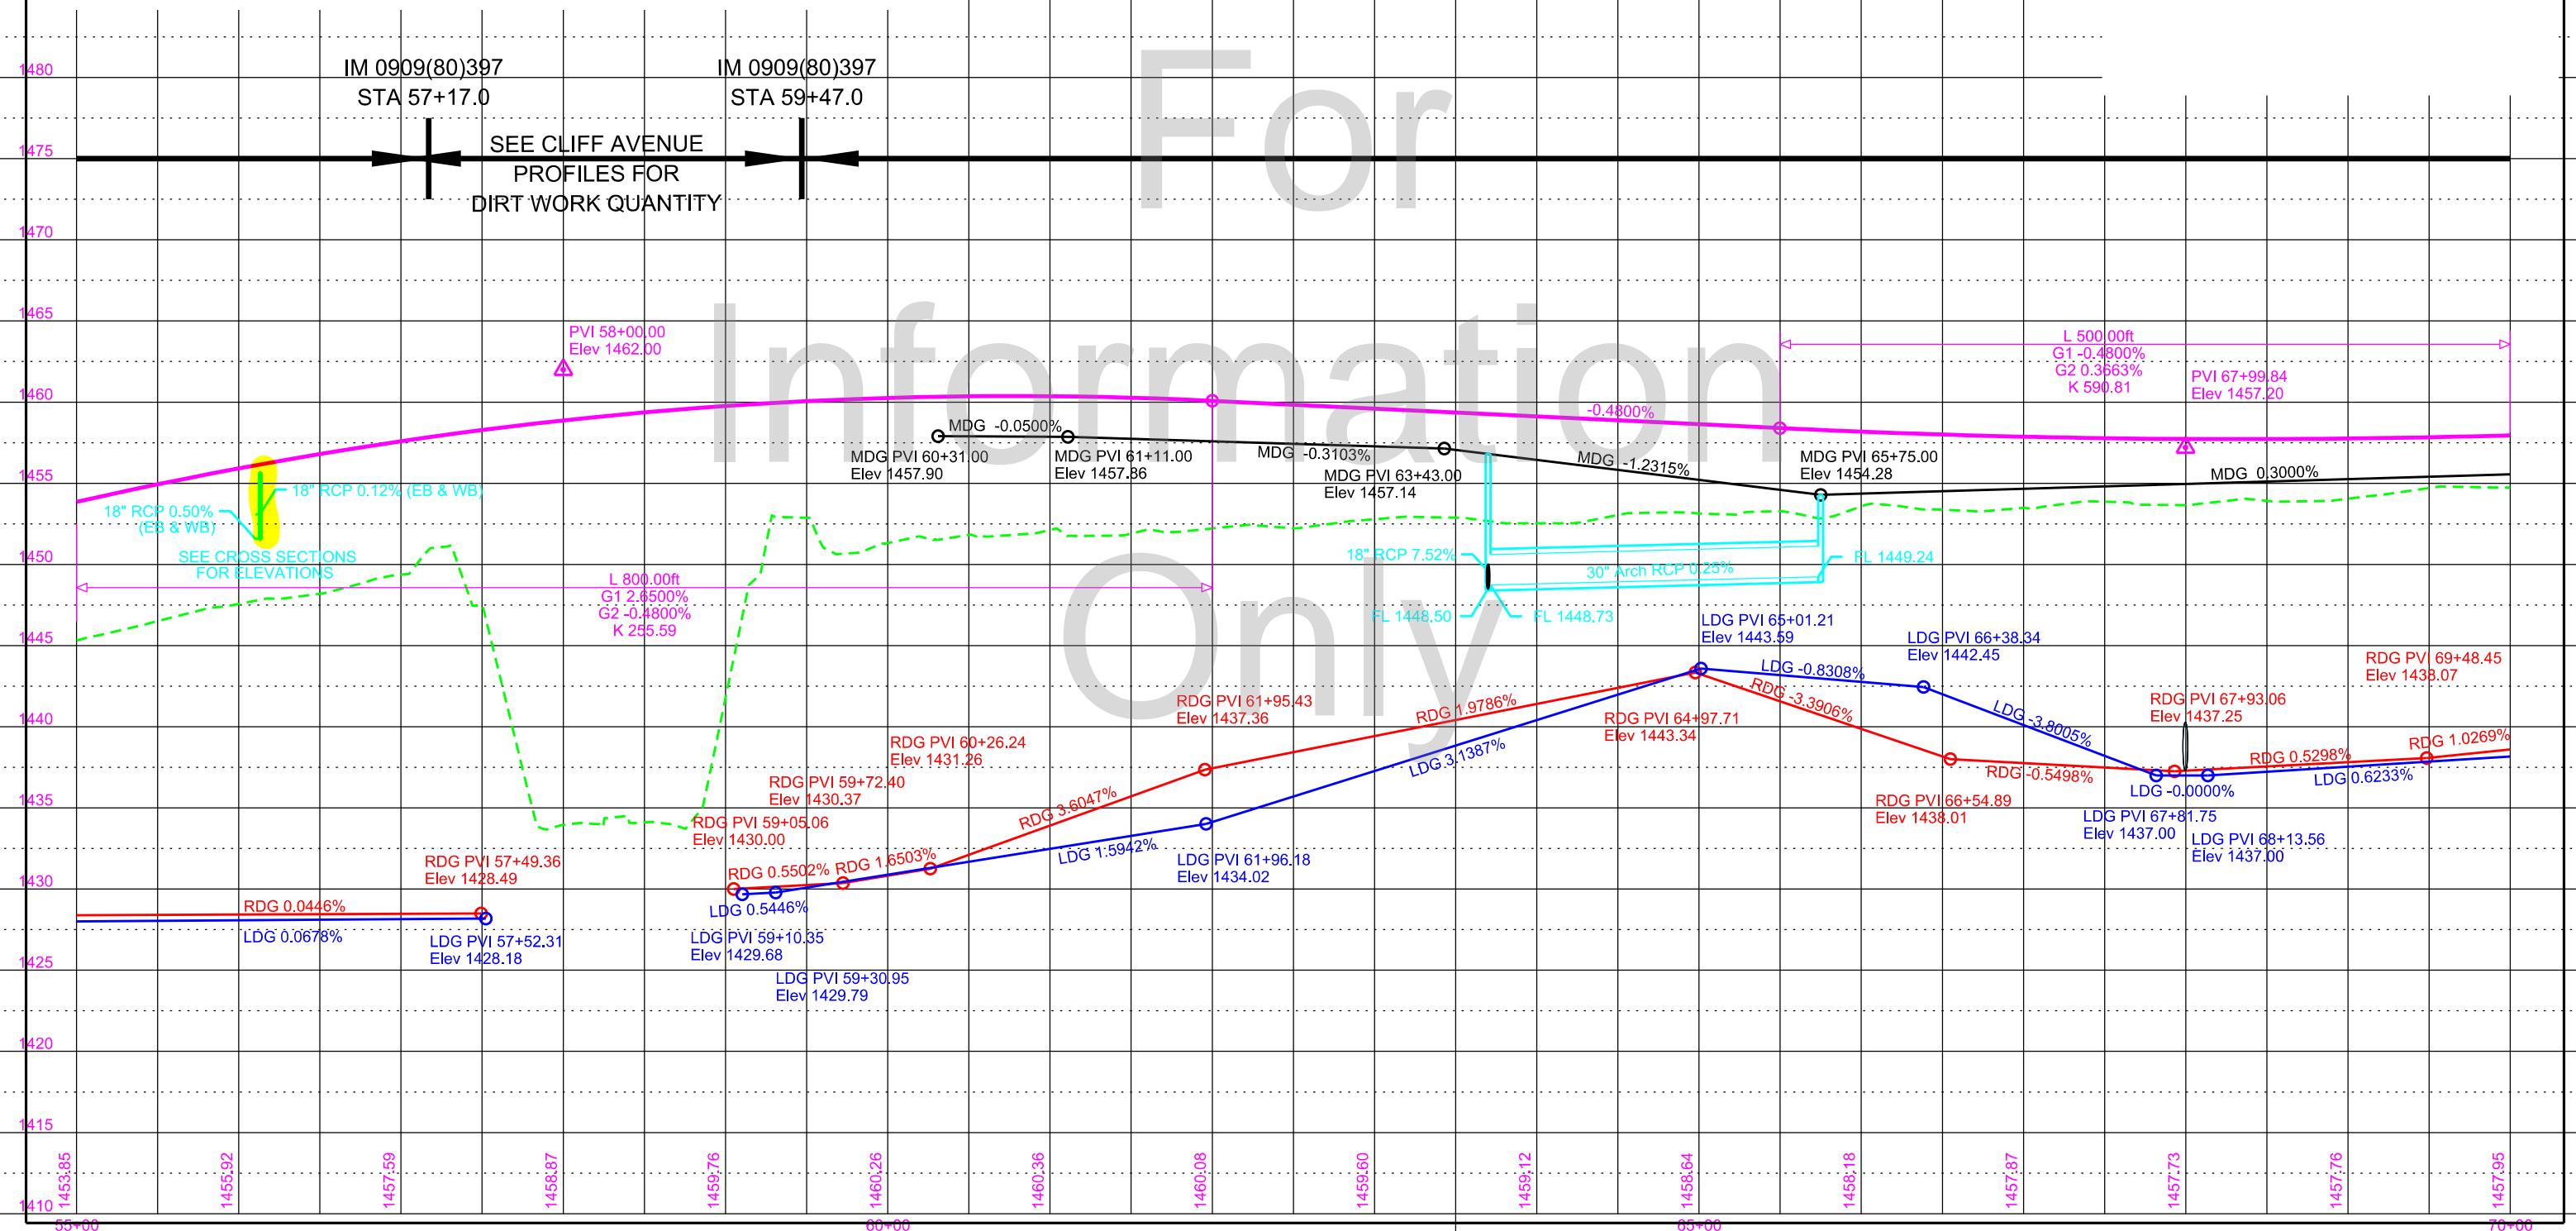

329 + 47 - 113' Rt.
Remove for reset I Fl. End
Extend Rt. 24" - 24" RCP pipe
& Reset Flared End

329 + 89.04 to 332 + 18.06 - 42' R
Take out 229' - 0 1/4" Cont. Comp.
Girder Bridge (E. B. L.)
(Incidental Work - Structure)

329 + 99.14 to 332 + 28.16 - 42' L
Take out 229' - 0 1/4" Cont. Comp.
Girder Bridge (W. B. L.)
(Incidental Work - Structure)

For Guardrail Details
See Guardrail Layout.

330 + 12.42 to 331 + 94.43 - 42' R
Install 182' - 0 1/8" Cont. Comp. Girder
Bridge (E. B. L.)
(See Bridge Construction Sheets)

330 + 22.57 to 332 + 04.58 - 42' L
Install 182' - 0 1/8" Cont. Comp. Girder
Bridge (W. B. L.)
(See Bridge Construction Sheets)

330 + 24.56 and 331 + 92.42
Install M. S. E. Retaining Walls
(See Wall Construction Sheets)

Install Type D Drop Inlets with 6"
Concrete Collar and Type D Frame
& Grate at the following locations :

332 + 03.79 - 63.69 R
332 + 08.59 - 24.31 R
332 + 14.42 - 24.31 L
332 + 19.94 - 69.69 L
(See Standard Plates)

INTERSTATE 90 & 229


EASTBOUND

Sta. 332+08-24'R (MRM 400.550)


WESTBOUND

Sta. 332+14-24'L (MRM 400.550)


Sta. 332+19-69'L (MRM 400.550)

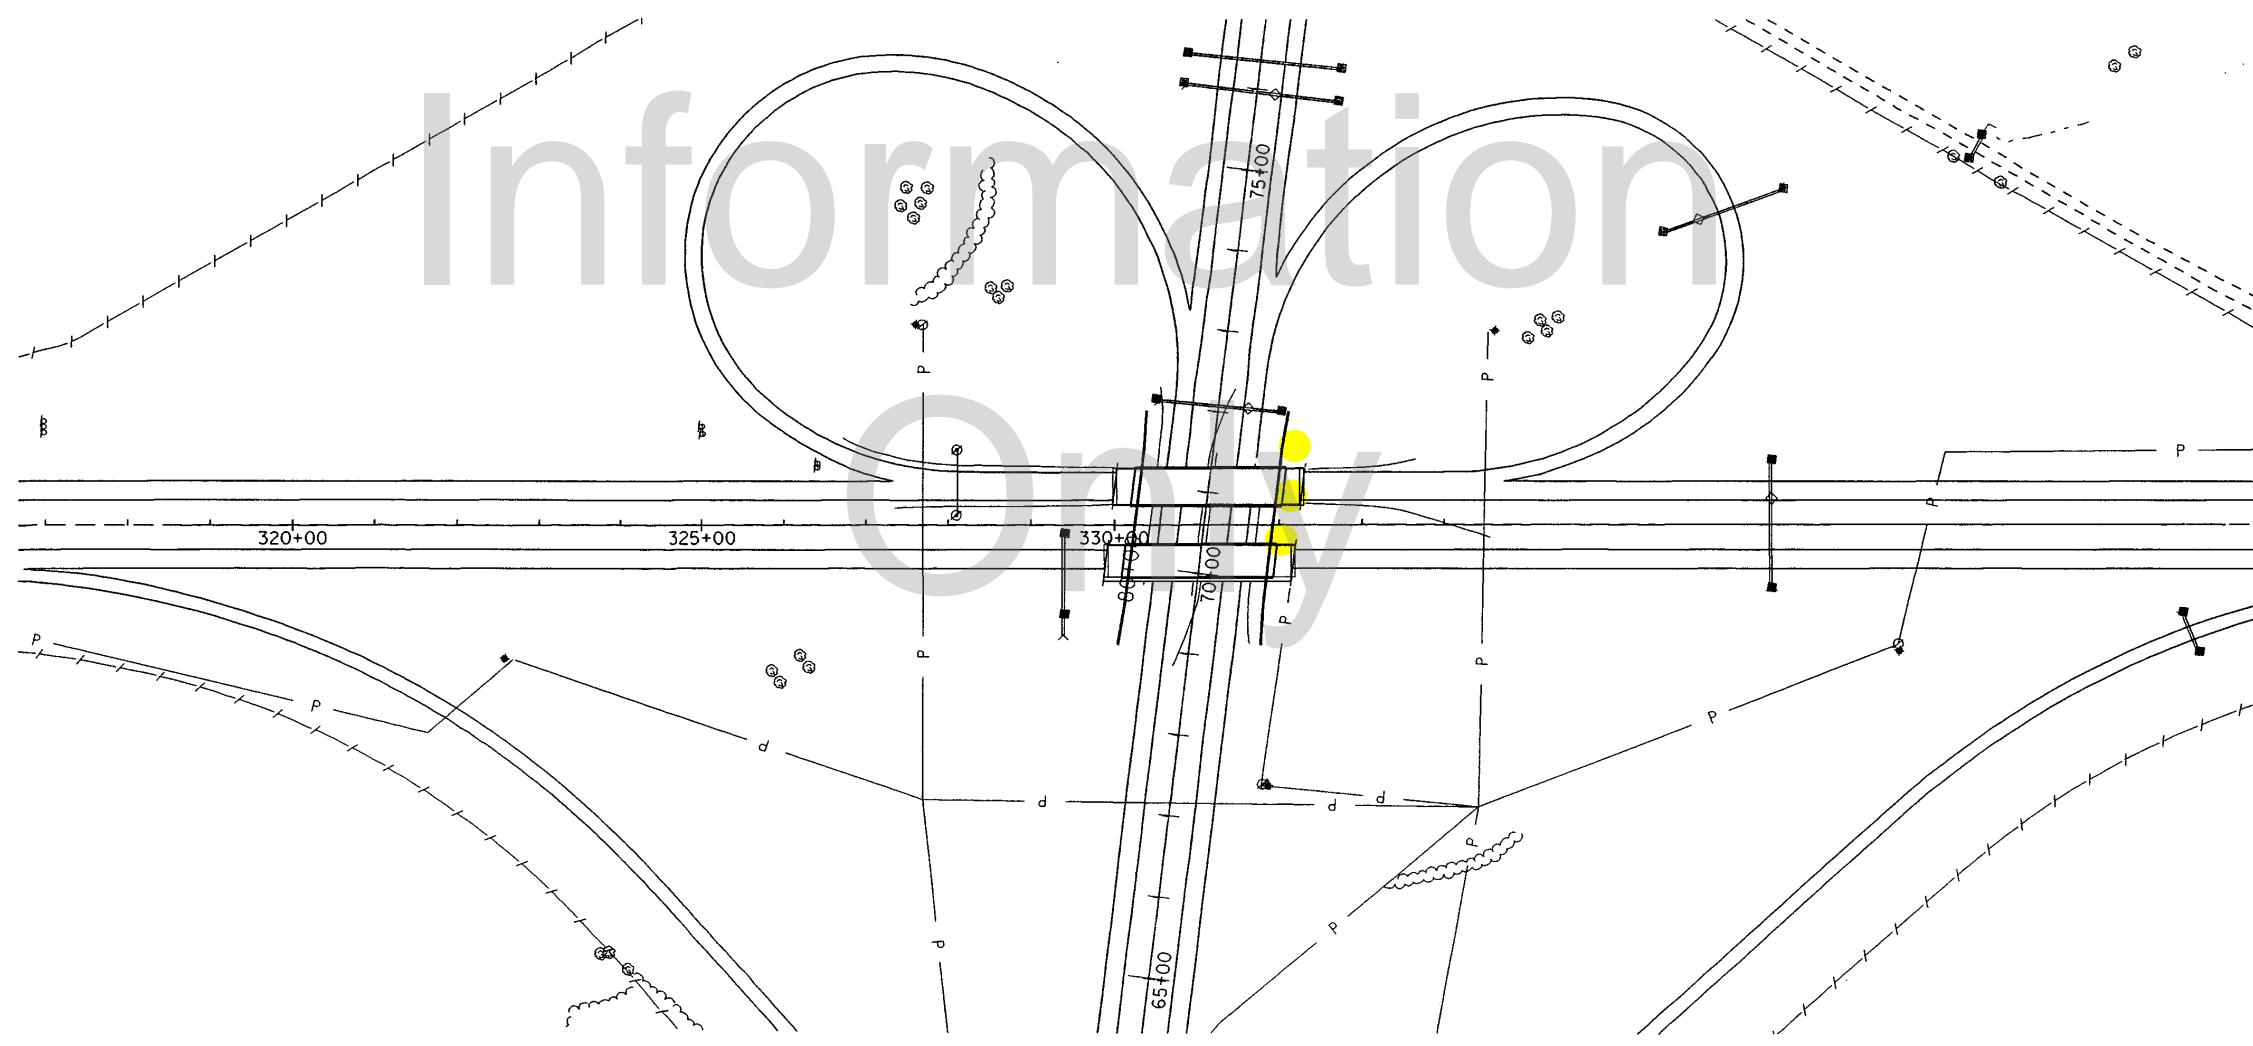

Plot Scale - 1:200

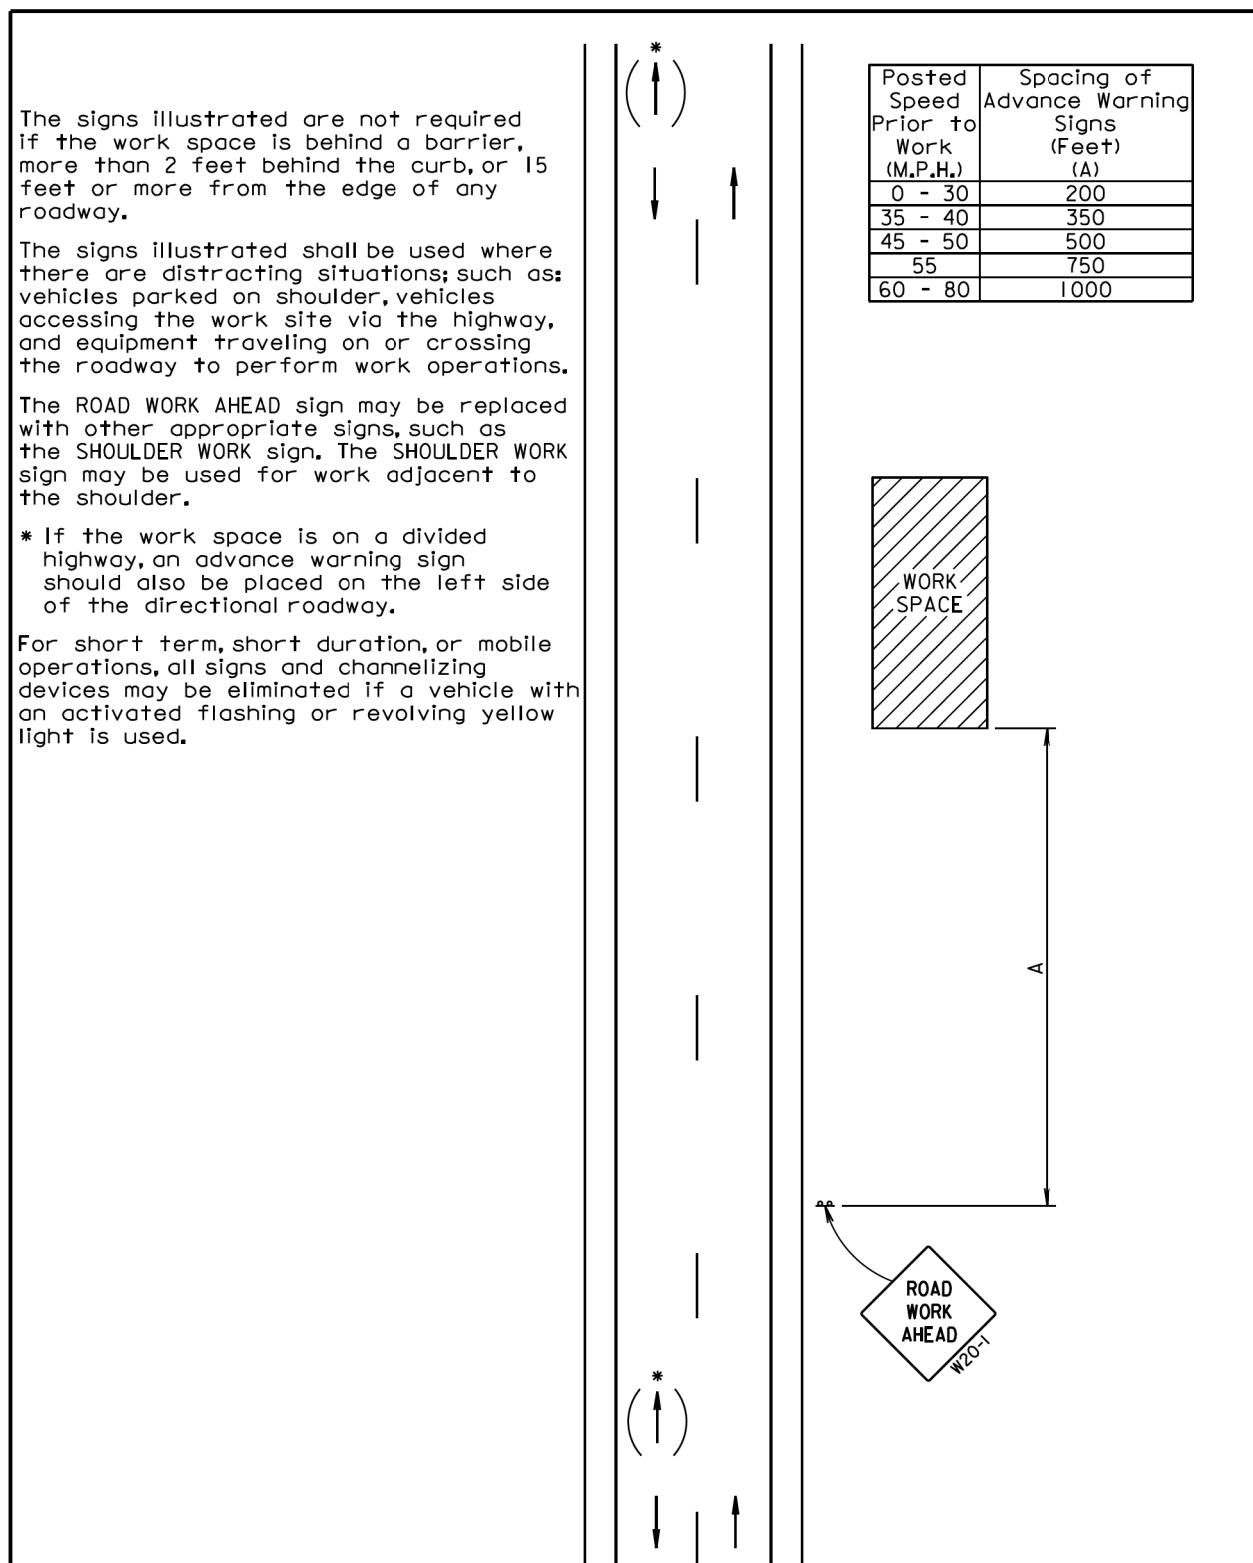

| | | | |
|-------------------------------|-------------|------------------------------------------------------------------------|------------------------|
| Published Date: 2nd Qtr. 2019 | SDOT | GUIDES FOR TRAFFIC CONTROL DEVICES WORK BEYOND THE SHOULDER | PLATE NUMBER 634.01 |
| | | | Sheet 1 of 1 |


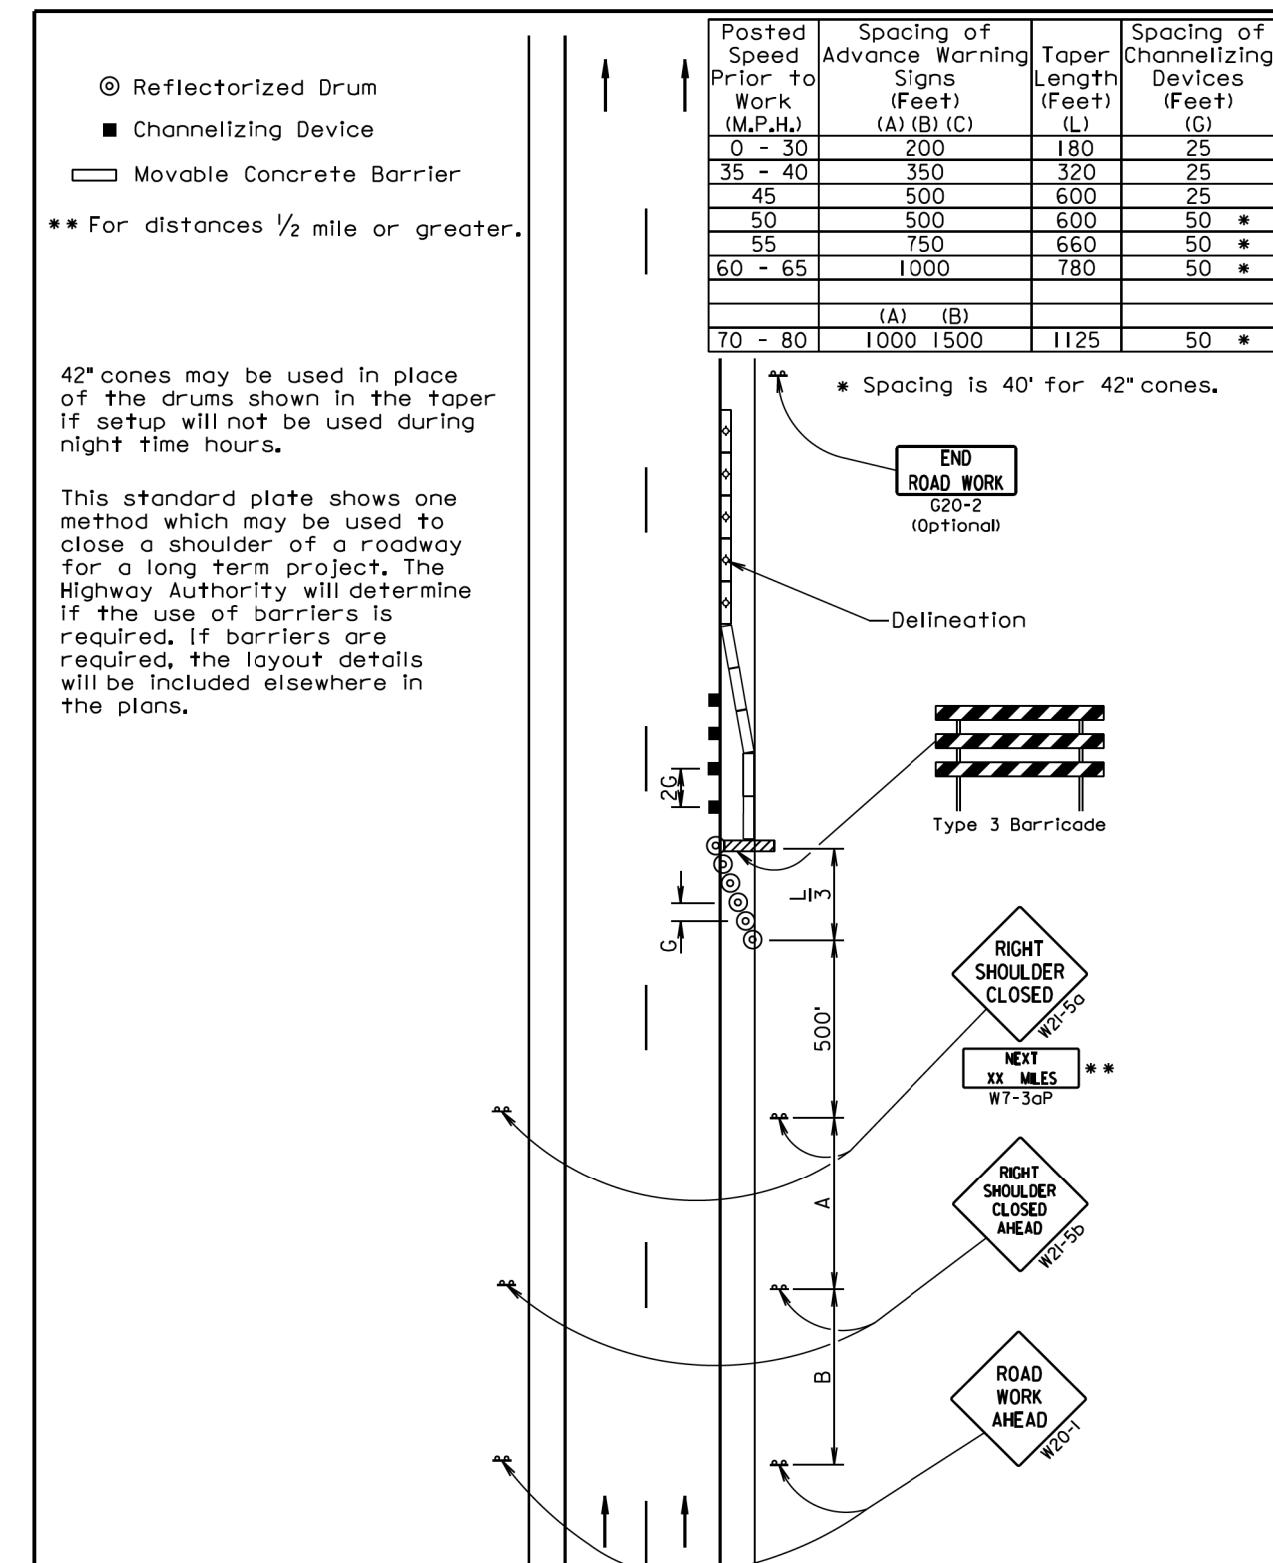


| | | | |
|-------------------------------|-------------|---------------------------------------------------------------|------------------------|
| Published Date: 2nd Qtr. 2019 | SDOT | GUIDES FOR TRAFFIC CONTROL DEVICES SHOULDER CLOSED | PLATE NUMBER 634.61 |
| | | | Sheet 1 of 1 |

Plot Scale -

TRMINT15



Plotted From -

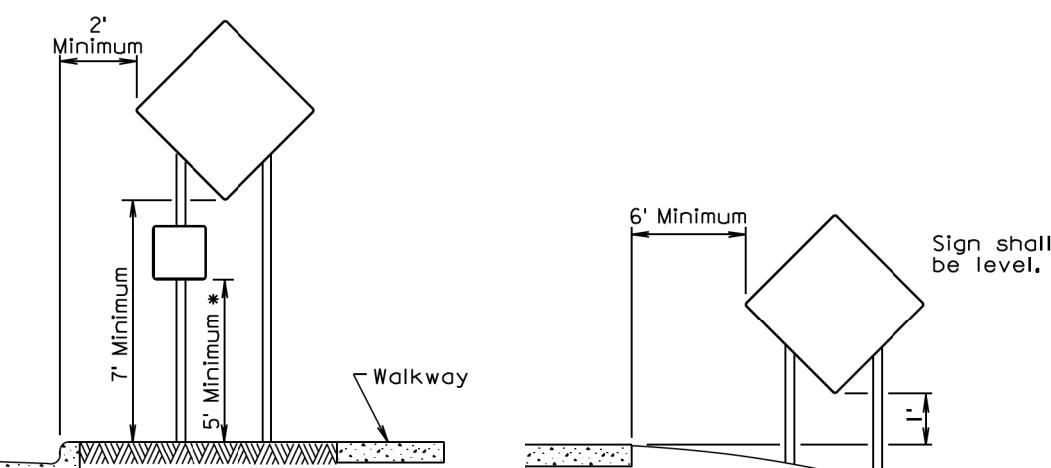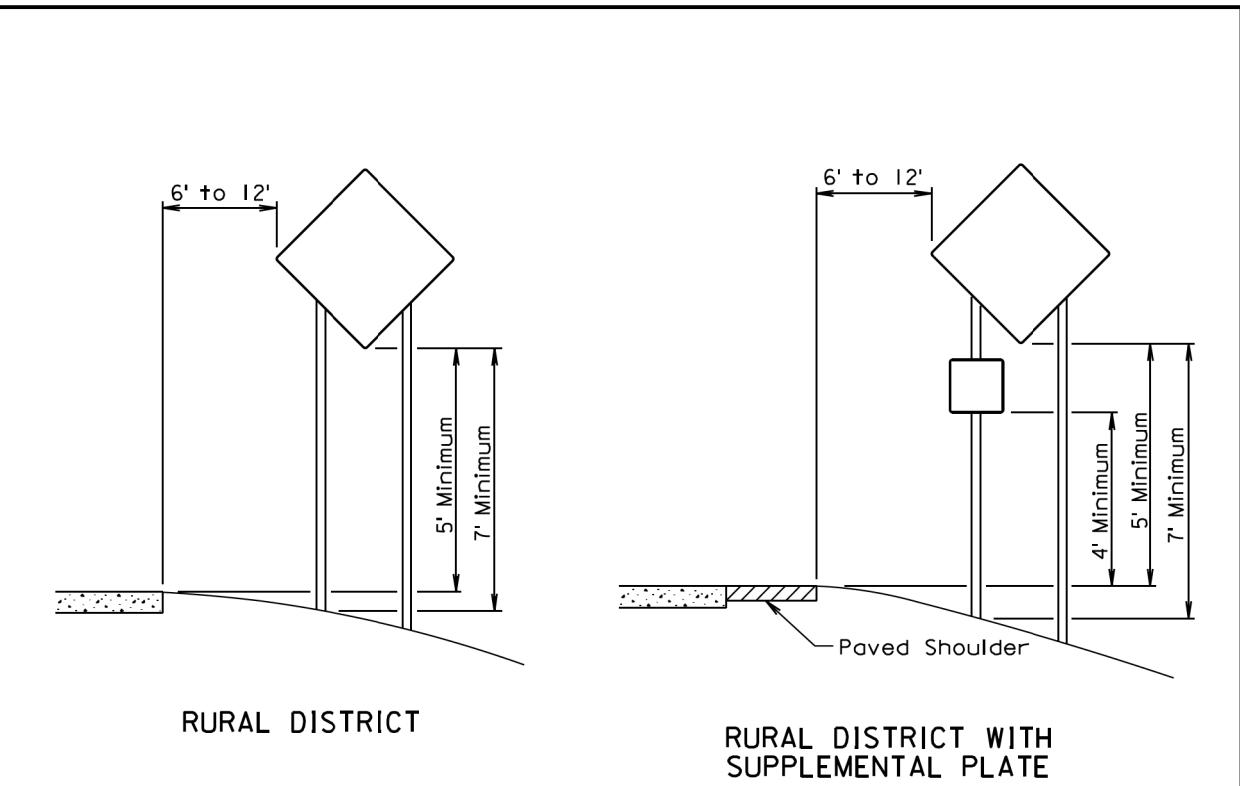

* If the bottom of supplemental plate is mounted lower than 7 feet above a pedestrian walkway, the supplemental plate should not project more than 4" into the pedestrian facility.

September 22, 2014

| | | | |
|-------------------------------|----------------------------------|---------------------------------------------------------------------|-------------------------------|
| Published Date: 2nd Qtr. 2019 | S D D O T | CRASHWORTHY SIGN SUPPORTS (Typical Construction Signing) | PLATE NUMBER 634.85 |
| | | | Sheet 1 of 1 |

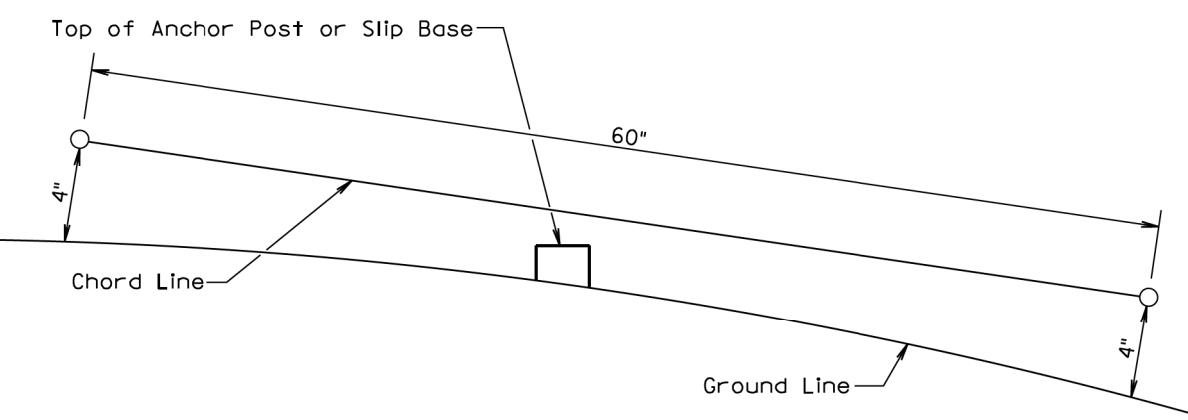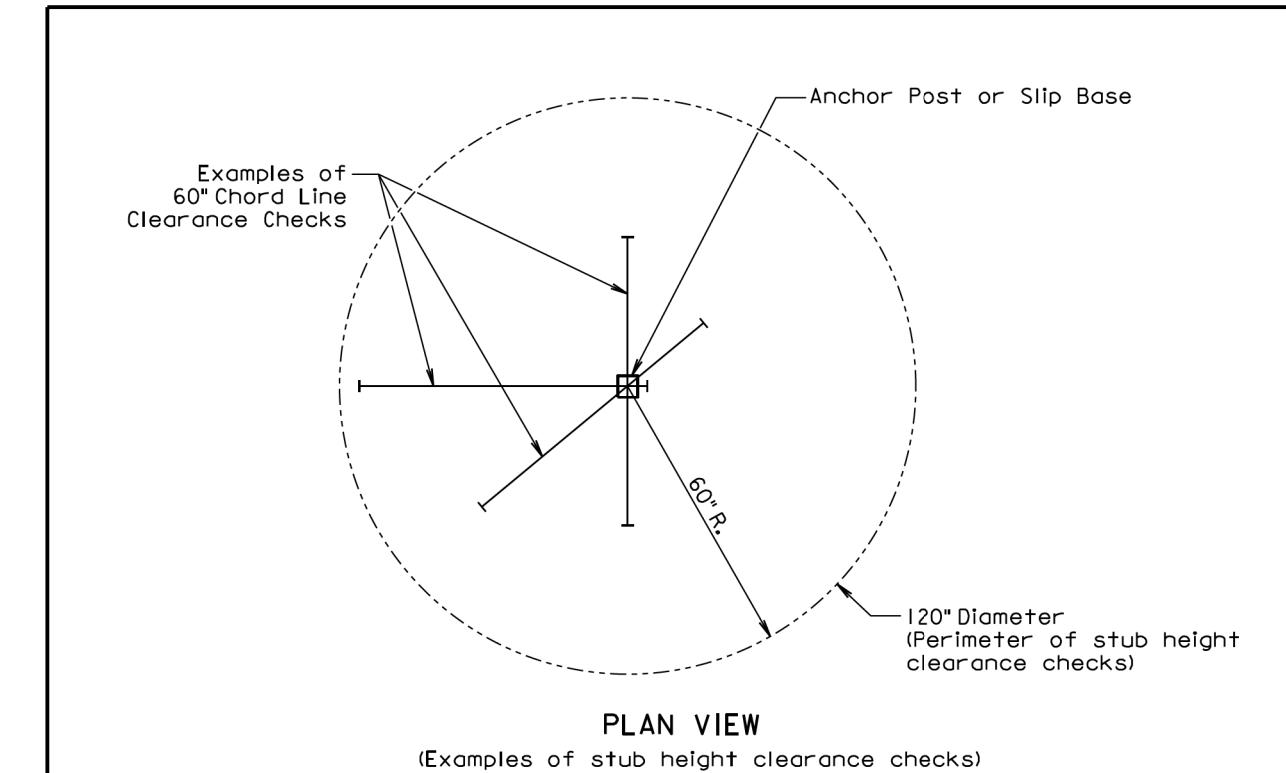**GENERAL NOTES:**

The top of anchor posts and slip bases SHALL NOT extend above a 60" chord line within a 120" diameter circle around the post with ends 4" above the ground.

At locations where there is curb and gutter adjacent to the breakaway sign support, the stub height shall be a maximum of 4" above the ground line at the localized area adjacent to the breakaway support stub.

The 4" stub height clearance is not necessary for U-channel lap splices where the support is designed to yield (bend) at the base.

July 1, 2005

| | | | |
|-------------------------------|----------------------------------|-----------------------------------------|-------------------------------|
| Published Date: 2nd Qtr. 2019 | S D D O T | BREAKAWAY SUPPORT STUB CLEARANCE | PLATE NUMBER 634.99 |
| | | | Sheet 1 of 1 |