

Plot Scale - 1:200

Plotted From - trp14286

STATE OF SOUTH DAKOTA  
DEPARTMENT OF TRANSPORTATION  
PLANS FOR PROPOSED  
**PROJECT P 034-451**  
**MEADE COUNTY**  
CAMERA SYSTEM  
PCN 139R

STATE OF SOUTH DAKOTA	PROJECT	SHEET	TOTAL SHEETS
	P 034-451	1	107

Plotting Date: 04/02/2014

INDEX OF SHEETS

- 1 General Layout With Index
- 2 - 5 Estimate With General Notes & Tables
- 6 - 11 BHP Pole Locations
- 12 - 55 Camera Locations & Existing Signal Layouts
- 56 - 80 Fiber Path
- 81 - 107 Existing Conduit Layouts
- 108 - XX Span Wire Detail & Standard Plates





1:200  
Plot Scale -  
Plotted From -  
trp14286

ESTIMATE OF QUANTITIES

Bid Item Number	Item	Quantity	Unit
009E0010	Mobilization	Lump Sum	LS
250E0010	Incidental Work	Lump Sum	LS
635E9924	24 Strand Fiber Optic Cable	2,650	Ft

SPECIFICATIONS

Standard Specifications for Roads & Bridges, 2004 Edition and Required Provisions, Supplemental Specifications and/or Special Provisions as included in the Proposal.

SUPPLYING AS BUILT PLANS

If the camera system is constructed differently than what is stated in the plans, the Contractor shall supply as built plans to the SDDOT Project Engineer and a copy shall be sent to the SDDOT Traffic Design Engineer. The as built plans may include conduit layouts, wiring diagrams, or other drawings depicting the changes from the original plans.

SHOP DRAWING AND CATALOG CUTS SUBMITTALS

The Contractor shall submit shop drawings and catalog cuts to the SDDOT Traffic Design Engineer in accordance with Section 985 of the SDDOT Standard Specifications or in Adobe PDF format.

Adobe PDF submittals shall be sent to the following email addresses:

Stacy.Bartlett@state.sd.us

ON-SITE INSPECTION

An on-site inspection of the camera system shall be conducted before acceptance of the project, once the cameras are installations are completed and operational. The on-site inspection shall be conducted by SDDOT and SDDCI with the Contractor, Sturgis City Manager and Sturgis Police Department present.

INCIDENTAL WORK

Incidental work includes, but is not limited to, the restoration of all disturbed areas to the satisfaction of the SDDOT Project Engineer.

FIBER OPTIC CABLE INTERCONNECTION

The Contractor shall install fiber optic cable to allow the existing fiber network to transmit video imagery to the SDDOT Sturgis Maintenance Shop on a single mode fiber optic cable pair from multiple specified camera locations. Daisy chained single mode fiber cable links shall connect various locations of cameras by managed multiport Ethernet switches with fiber optic uplink ports.

Cameras Locations 13 – 33 shall have Gigabit Ethernet communication over singlemode fiber optic cable. Communication between Cameras 13- 33 to the SDDOT Sturgis Maintenance Shop shall be Gigabit Ethernet. Camera IP schemes shall be devised and programmed by SDBIT and SDDCI.

The existing fiber network consists of fiber optic cable owned by the SDDOT and City of Sturgis. The SDDOT network is underground from along SD34/Lazelle St from 8<sup>th</sup> St to Junction Ave, along Junction Ave from SD34/Lazelle St to Ballpark Rd, from the intersection of Junction Ave & Ballpark Rd to Exit 32, from Exit 32 to SDDOT Maintenance Building and from Exit 32 to Exit 30. The City network is underground from the Public Works Office to the intersection of 1<sup>st</sup> St and the alley between Main St & Sherman St and aerial from the intersection of 1<sup>st</sup> St and the alley between Main St & Sherman Street to the Sturgis Police Department.

Black Hills Power (BHP) poles are identified by numbers 1 – 30 on the plan sheets. The Contractor shall install the fiber optic cable on BHP poles 1-23. The Contractor shall coordinate the installation of the fiber optic cable with BHP and notify BHP 10 days before beginning fiber optic cable installation. The BHP contact is Dean Sigman at (605) 720-3304.

The Contractor shall determine the adequate length of fiber optic cable between poles. The distance between BHP Poles 1- 23 is listed in the Table of Span. An estimated length of fiber is given in the plans. The Contractor shall determine the method to adequately attach span cable to the support poles.

The Contractor shall install aerial fiber optic cable on BHP poles 1 – 18 from Location 14, BHP pole 1 on the west side of Junction Ave intersecting with the alley between SD34/Lazelle St and Main St west to the intersection with 4<sup>th</sup> St, Location 28, BHP pole 18.

The Contractor shall install aerial fiber optic cable on BHP poles 18 – 22 along the east side of 4<sup>th</sup> St both north and south of Location 28, BHP pole 18 on the east side of 4<sup>th</sup> St intersecting with the alley between SD34/Lazelle St & Main St.

The Contractor shall install aerial fiber optic cable on BHP poles 18 & 19 from camera Location 28 north to the SE quadrant of the intersection with SD34/Lazelle St. The Contractor shall run the aerial fiber optic cable down BHP pole 19 to ground level, covering the aerial fiber optic cable with U guard. The aerial fiber optic cable shall be hand trenched underground, to junction box JF6.

STATE OF SOUTH DAKOTA	PROJECT	SHEET	TOTAL SHEETS
	P 034-451	2	107

Plotting Date: 04/02/2014

FIBER OPTIC CABLE INTERCONNECTION (continued)

The Contractor fusion splice the 24 single mode aerial fiber optic cable to the existing single mode fiber optic cable in JF6 or terminate in at the patch panel in the traffic signal controller at the intersection of SD34/Lazelle St & 4<sup>th</sup> St. The existing fiber optic cable is 48 strand single mode. 8 strands of the existing 48 strand single mode fiber optic cable are terminated at a patch panel in the traffic signal controller.

The Contractor shall fusion splice the fiber optic cable at BHP poles 6, 13 & 18 to continue fiber path camera locations 18, 25 & 28.

The Contractor shall install aerial fiber optic cable on BHP poles 18, 20 - 22 & from Location 28 south to the NE quadrant of the intersection with the alley between Main St & Sherman St. The Contractor shall install the aerial fiber optic cable on the BHP pole 22 to ground level, covering the aerial fiber optic cable with U Guard. The existing City aerial 12 strand single mode fiber optic cable runs east to 1<sup>st</sup> St and west into the Sturgis Police Department. The Contractor shall locate the conduit entering the Sturgis Police Department at the intersection of 4<sup>th</sup> St and the alley between Main St & Sherman St and continue the fiber optic run along 4<sup>th</sup> St into the Sturgis Police Department.

The conduit entering the Sturgis Police Department is owned by Midcontinent. The Contractor shall notify Midcontinent 5 days before installing fiber optic cable in the conduit entering the Sturgis Police Department. The Midcontinent contact is Terry Hofer at (605) 209-2113.

The Contractor shall splice the City's existing fiber optic network to terminating fiber optic pairs at Camera Locations 23, 24 & 29 for video imagery transmission. Fiber is coiled on BHP poles 23, 25 & 29 and shall be used for slack when terminating the fiber ends at Camera Locations 23, 24 & 29. The City fiber optic cable is 12 strand single mode and one pair (2 strands) may be used for the video imagery transmit.

The Contractor shall coordinate the installation of the span cable and fusion splicing of existing aerial fiber optic cable with the City and notify the City 10 days before installing fiber optic cable in the conduit entering the Sturgis Police Department. The City contact is Rick Bush at (605) 490-1152.

Fiber splicing shall be in accordance with the manufacturer's recommendations. Splices shall be of the fusion type. Fiber splicing shall be in an environmentally safe weatherproof and dust protected containment.

The Contractor shall indicate to the Project Engineer or Traffic Design Engineer and label which single mode fiber optic cable pair shall be used in the existing fiber optic network to daisy chain transmit video imagery to the SDDOT Sturgis Maintenance Shop.

All costs for materials and equipment to connect new fiber optic cable to existing fiber optic cable, splice fiber optic cable, coordinating installs, labor, and testing required to and transmit video imagery from Camera Locations 13- 33 to the SDDOT Sturgis Maintenance Shop on fiber optic cable shall be incidental to the contract unit price per each for "24 Strand Fiber Optic Cable".

File - ...DPS\CameraLocationsTable.dgn

1:200  
Plot Scale -  
trp14286  
Plotted From -

FIBER OPTIC CABLE

The fiber optic cable shall be a self-supporting cable that can be installed in an aerial environment without the use of a messenger. The self-supporting cable shall be Figure-8 type.

The fiber optic cable shall be a 24 strand single mode fiber optic cable with a each buffer containing 12 fibers. The buffer tubes shall be color coded according to EIA/TIA specifications.

Fiber optic cable shall meet the latest applicable EIA/TIA Specifications and REA PE-90 Specifications for single mode. The fiber optic cable shall be rated for outdoor use.

Singlemode optical cable shall have the following optical and physical characteristics:

- 1. Cladding diameter of 125µm +/- 2µm.
- 2. Zero dispersion slope shall be 0.092 ps/ (nm<sup>2</sup>•km) or less.
- 3. Zero dispersion wavelength, 1300 to 1322 nm.
- 4. Cutoff wavelength, less than 1250 nm.
- 5. Maximum attenuation at 1310 nm shall be 0.4 dB per Kilometer.
- 6. The outside diameter shall be less than 22.1 nm.
- 7. One factory fusion splice per kilometer per fiber shall be allowed.

The fiber optic cable shall have a seven-core configuration, dielectric central strength member, and thermoplastic tubes. The minimum bending radii of the cable shall be 209.5 mm under a static load and 419.1 mm during installation. The installation tensile load rating shall be 2.7 kPa.

The cable core interstices shall be filled with water blocking material. If a gel compound is used, the gel compound shall be readily removable with a nontoxic solvent.

The fiber optic cable shall be installed in accordance with the manufacturer's recommendations and the NEC. Slack cable shall be left in each camera housing enclosure, traffic signal cabinet, junction box 6 at the intersection of SD34/Lazelle St & 4<sup>th</sup> St and inside the Sturgis Police Department. Fiber switch cabinets shall have 2' of slack, junction box 6 shall have 20' of slack and the Sturgis Police Department shall have 50' of slack. Slack cable shall be coiled and tied in a minimum of three places around the coil. No splices shall be allowed in the fiber optic cable except at the locations specified. The contractor shall test the fiber optic cable after the installation to verify the integrity of the fiber for video transmission to SDDOT Sturgis Maintenance Shop.

The payment for supplying and installing fiber optic cable and fiber optic cable mounting and attachment hardware and testing the fiber optic cable for video transmission shall be incidental to the contract unit price per foot for "24 Strand Fiber Optic Cable".

TABLE OF SPAN

BHP POLE NUMBER	TO	BHP POLE NUMBER	DISTANCE (FT)
1 (Camera 14 Location)	-	2	104
2	-	3	96
3	-	4	101
4	-	5	117
5	-	6 (fusion splice)	106
6 (fusion splice)	-	7	96
6 (fusion splice)	-	23	75
7	-	8A	37
8A	-	8B	53
8B	-	9	98
9	-	10 (Camera 20 Location)	79
10 (Camera 20 Location)	-	11	102
11	-	12	109
12	-	13 (fusion splice)	99
13 (fusion splice)	-	14	113
14	-	15	89
15	-	16A	84
16A	-	16B	23
16B	-	17	59
17	-	18 (Camera 28 Location & fusion splice)	59
18 (Camera 28 Location & fusion splice)	-	19	56
18 (Camera 28 Location & fusion splice)	-	20	119
20	-	21	117
21	-	22	325

The Contractor shall coordinate the installation of fiber optic cable attachment and mounting hardware and splice containments on BHP Poles with BHP. The BHP contact is Dean Sigman at (605) 720-3304. All costs for fiber optic cable attachment and mounting hardware and coordinating installs shall be incidental to the contract unit price per each for "24 Strand Fiber Optic Cable".

STATE OF SOUTH DAKOTA	PROJECT	SHEET	TOTAL SHEETS
	P 034-451	3	107

Plotting Date: 04/02/2014

FIBER OPTIC CABLE TERMINATION

The Contractor shall terminate all fiber optic strands at each Camera Locations 14, 18, 20, 23, 24, 25, 28, 29, 32 (18 strands), the Sturgis Police Department (14 strands) and at the SDDOT Sturgis Maintenance Shop (2 strands) with LC single mode connectors. The SDDOT Maintenance Building is where the video imagery shall be transferred.

Fiber optic cable shall be terminated in camera housing enclosures and traffic signal controllers with a wall mounted distribution enclosure or patch panel. The distribution enclosure or patch panel shall be dust and moisture resistant. The size of the distribution enclosure or patch panel shall be adequate for the number of fibers installed. The distribution enclosure or patch panel shall be mounted in the camera housing where it does not interfere with normal cabinet maintenance. The fiber optic cable shall be prepared in accordance with the manufacturer's recommendations and have sufficient length to reach the fiber switch.

The camera housing shall be supplied and installed by DCI. The Contractor shall provide a temporary weatherproof enclosure for the terminated fiber ends if the fiber ends are terminated before the camera housing is installed. The Contractor shall coordinate the termination of fiber optic ends with DCI. The DCI contact is Chad Carpenter at (605) 520-2854.

All work involved in the termination connections of the fiber optic strands shall be incidental to the contract unit price per foot for "24 Strand Fiber Optic Cable".

CABLE LABELS

Fiber optic cable and Cat-5 cable shall be identified in fiber switches, traffic signal controllers and pole bases. Labels shall be wrapped around cable to indicate the camera that it is connected to. Labels shall be self-adhesive vinyl cloth with a preprinted legend.

File - ...DPS\CameraLocationsTable.dgn



1:200  
Plot Scale -  
Plotted From -

FIBER SWITCH – provided for informational purposes only

SDDOT shall supply managed Ethernet switches with Gigabit fiber optic uplink ports at Camera Locations 13, 14, 15, 17, 18, 20, 23, 24, 25, 28, 29, 30, 31, 32 and 33 and in the Sturgis Police Department. The fiber switches shall be managed by Milestone video management software.

The fiber switch will be housed in a camera enclosure. The fiber switch size shall not exceed 7.5"x3"x5.5". The fiber switch shall meet or exceed the following specifications; IEEE 1613 (electric utility substations), IEC 61850-3 (electric utility substations), IEC 61800-3 (variable speed drive systems), IEC 61000-6-2 (generic industrial), NEMA TS-2 (traffic control equipment) and IEEE 802.1p. The fiber switch shall have Hazardous Location Certification Class 1, Division 2

The fiber switch shall have the specified Gigabit fiber optic Ethernet ports and fast Ethernet copper ports or greater. The fiber switch shall have connector type LC. The fiber switch shall operate at -40 degrees Celsius to 85 degrees Celsius. The fiber switch shall support Gigabit distances to 70km. The fiber switch shall have 128-bit encryption.

The integrated fiber switch power supply shall have a universal high voltage range: 88-300VDC or 85-264VACpower supply. The fiber switch shall have dual low voltage DC inputs: 24VDC (10-36VDC) or 48VDC (36-72VDC).

The RuggedSwitch RS900G or equivalent meets the fiber switch requirements.

Fiber Switch A shall be installed at Location 14, BHP pole 1 on the west side of Junction Ave intersecting with the alley between SD34/Lazelle St and Main St. Camera 14 shall connect to Fiber Switch A with copper. Fiber switch A shall have 2 Gigabit fiber optic Ethernet ports and 2 fast Ethernet copper ports.

Fiber Switch B shall be installed in the housing for Camera 18, building in the NE quadrant of 1<sup>st</sup> St & Main St. Cameras 18 & 19 shall connect to Fiber Switch B with copper. Fiber switch B shall have 2 Gigabit fiber optic Ethernet ports and 2 fast Ethernet copper ports.

Fiber Switch C shall be installed at Location 20, BHP pole 10 on the east side of 2nd St intersecting with the alley between SD34/Lazelle St and Main St. Camera 20 shall connect to Fiber Switch C with copper. Fiber switch A shall have 2 Gigabit fiber optic Ethernet ports and 2 fast Ethernet copper ports.

Fiber Switch D shall be installed in the housing for Camera 25, building in the NE quadrant of 3<sup>rd</sup> St & Main St. Cameras 25 & 26 shall connect to Fiber Switch D with copper. Fiber switch D shall have 2 Gigabit fiber optic Ethernet ports and 2 fast Ethernet copper ports.

Fiber Switch E shall be installed at Location 23, BHP pole 24 in the NW quadrant of the intersection of 1<sup>st</sup> St and the alley between Main St & Sherman St. Cameras 21, 22 & 23 shall connect to Fiber Switch E with copper. Fiber switch E shall have 2 Gigabit fiber optic Ethernet ports and 4 fast Ethernet copper ports.

Fiber Switch F shall be installed in the housing for Camera 24, BHP pole 25 in the NE quadrant of the intersection of 3<sup>rd</sup> St and the alley between Main St & Sherman St. Camera 24 shall connect to Fiber Switch F with copper. Fiber switch F shall have 2 Gigabit fiber optic Ethernet ports and 2 fast Ethernet copper ports.

FIBER SWITCH (continued) – provided for informational purposes only

Fiber Switch G shall be installed in the housing for Camera 29, BHP pole 26 in the alley between Main St & Sherman St east of 4<sup>th</sup> St. Camera 29 shall connect to Fiber Switch G with copper. Fiber switch G shall have 2 Gigabit fiber optic Ethernet ports and 2 fast Ethernet copper ports.

Fiber Switch H shall be installed in the housing for Camera 28, BHP pole 18 on the east side of 4<sup>th</sup> St intersecting with the alley between SD34/Lazelle St and Main St. Camera 28 shall connect to Fiber Switch H with copper. Fiber switch H shall have 2 Gigabit fiber optic Ethernet ports and 2 fast Ethernet copper ports.

Fiber Switch O shall be located in the Sturgis Police Department. Camera 27 shall connect to Fiber Switch O with copper. The City aerial fiber shall connect to Fiber Switch O with the daisy chained pair connecting cameras 21-24 and 29. Fiber for connection to Milestone video management software shall terminate at Fiber Switch O. Fiber Switch O shall have 8 Gigabit fiber optic Ethernet ports and 2 fast Ethernet copper ports.

Fiber Switch I shall be installed in the traffic signal controller at the in the NW of SD34/Lazelle St & Junction Ave. Camera 13 shall connect to Fiber Switch I with copper. Fiber switch I shall have 2 Gigabit fiber optic Ethernet ports and 2 fast Ethernet copper ports. 8 strands of the existing 48 strand single mode fiber optic cable is terminated in the traffic signal controller.

Fiber Switch P shall be installed in the housing for Camera 15. Fiber shall connect Fiber Switch P to Fiber Switch I. Fiber exists in the base of Luminaire Pole EL37 to the electrical service cabinet. Cameras 15 & 16 shall connect to Fiber Switch P with copper. Fiber Switch P shall have 2 Gigabit fiber optic Ethernet ports and 2 fast Ethernet copper ports.

Fiber Switch J shall be installed in the electrical service cabinet next to Location 17, BHP pole on the east side of Junction Ave intersecting with the alley between Main St & Sherman St. Camera 17 shall connect to Fiber Switch J with copper. Fiber shall connect Fiber Switch P to Fiber Switch I. Fiber Switch J shall have 4 Gigabit fiber optic Ethernet ports and 2 fast Ethernet copper ports.

Fiber Switch K shall be installed in the traffic signal controller at the in the NW quadrant of Junction Ave & Ballpark Ave. Camera 30 shall connect to Fiber Switch J with copper. Fiber switch J shall have 2 Gigabit fiber optic Ethernet ports and 2 fast Ethernet copper ports. 8 strands of the existing 48 strand single mode fiber optic cable is terminated in the traffic signal controller.

Fiber Switch L shall be installed in the traffic signal controller at the in the SE quadrant of SD34/Lazelle St & WB off ramp. Camera 32 shall connect to Fiber Switch L with copper. Fiber switch L shall have 2 Gigabit fiber optic Ethernet ports and 2 fast Ethernet copper ports. 8 strands of the existing 24 strand single mode fiber optic cable is terminated in the traffic signal controller.

Fiber Switch M shall be installed in the housing for Camera 33, SDDOT pole at Exit 30 EB off ramp. Camera 33 shall connect to Fiber Switch M with copper. Fiber exists in the base of Pole VD2 to the traffic signal controller Fiber switch M shall have 2 Gigabit fiber optic Ethernet ports and 2 fast Ethernet copper ports.

Fiber Switch N shall be installed in the housing for Camera 31, SDDOT pole at Exit 32 EB off ramp. Fiber exists in the base of Luminaire Pole AL1 to the traffic signal controller. Camera 31 shall connect to Fiber Switch N with copper. Fiber switch N shall have 2 Gigabit fiber optic Ethernet ports and 2 fast Ethernet copper ports.

STATE OF SOUTH DAKOTA	PROJECT	SHEET	TOTAL SHEETS
	P 034-451	4	107

Plotting Date: 04/02/2014

TABLE OF CAMERAS– provided for informational purposes only

Camera Location	Camera Type	Coordinate Equipment Install
1	PTZ	BHP
2	PTZ	private
3	FIXED - 180	N/A
4	FIXED - 180	N/A
5	PTZ	Butte Electric
6	PTZ	N/A
7	FIXED - 180	N/A
8	PTZ	N/A
9	FIXED - 180	N/A
10	PTZ	BHP
11	PTZ	N/A
12	PTZ	BHP
13	FIXED - 180	N/A
14	FIXED - CUSTOM	BHP
15	PTZ	N/A
16	FIXED - 180	N/A
17	CUSTOM	BHP
18	PTZ	private
19	FIXED - 180	private
20	FIXED - CUSTOM	BHP
21	PTZ	private
22	FIXED - 180	private
23	FIXED - CUSTOM	BHP
24	FIXED - 180	BHP
25	PTZ	private
26	FIXED - 180	private
27	FIXED - 180	City
28	FIXED - 180	BHP
29	PTZ	N/A
30	PTZ	N/A
31	PTZ	N/A
32	PTZ	N/A
33	PTZ	N/A

CAMERAS– provided for informational purposes only

The cameras are identified by number on the plan sheets. The cameras are PTZ and Fixed type. The camera location, type of camera and coordination of equipment install are stated in the Table of Cameras. There are 16 PTZ cameras and 17 fixed cameras. The fixed cameras shall provide either 180 degree viewing area or a custom viewing area. The cameras shall be installed by SDDCI in an outdoor housing system.

Installation of equipment shall be coordinated with the party indicated. The BHP contact is Dean Sigman at (605) 720-3304. The City contact is Rick Bush at (605) 490-1152. The Project Engineer shall provide contact information for locations listed private.

File - ...DPS\CameraLocationsTable.dgn



1:200  
Plot Scale -  
Plotted From -  
tpr14286

**PTZ CAMERAS– provided for informational purposes only**

The PTZ camera shall be outdoor enclosure ready. The PTZ external source shall be 24 VAC or 12VDC. The PTZ camera shall function at -10 degrees Celsius to 50 degrees Celsius. The PTZ camera shall have electronic image stabilization.

The PTZ camera shall have day/night functionality. The PTZ shall have minimum illumination color: 0.4 lux at 50 IRE F1.6; b/w: 0.02 lux at 50 IRE F1.6. The PTZ camera shall support H.264 video compression format.

The PTZ camera shall have a 20x optical zoom and 12x digital zoom with auto focus. The PTZ camera shall have 1920x1080 (HDTV 2.1 megapixel) resolution or greater. The PTZ camera shall have 340 degree pan. The PTZ camera shall have a horizontal viewing angle of 60 degrees and a vertical viewing angle of 35 degrees.

The Cannon VB-H41 or equivalent meets the PTZ camera requirements.

**FIXED CAMERAS– provided for informational purposes only**

The fixed cameras shall be a dual encoder (H.264 & MJPEG) and having no more than 20 Megapixels of resolution. The fixed cameras shall be IP addressable with no less than 180 degrees of panoramic Day/Night IP capabilities.

The fixed camera shall provide an all-in-one solution with no less than four integrated high sensitivity 5 megapixel sensors, with the option of gimbals that allow independent camera orientation. The fixed camera should allow multiple lens options ranging from 2.8mm to 16mm. The housing shall be a vandal resistant dome enclosure with IP66 rating for water and dust protection along with a heater/blower option.

The fixed camera shall be a PoE (IEEE 802.3af) compliant camera with color and a Day/Night features along with all the necessary heater & bower configurations. The fixed camera shall have the ability to output multiple image formats to allow the simultaneous viewing of full resolution field of views and regions of interest for high definition forensic zooming capabilities. The fixed camera shall have binning technique which shall provide low-light performance and increase sensitivity

The fixed camera shall include any all necessary wall mount and or pole mount bracket. Also every fixed camera will be supplied with a premade 15m in length, outdoor shielded CAT5E FTP cable that is no less than 24AWG solid copper wire.

The fixed camera shall be made in the USA complying with the made in the USA standards.

The Arecont Vision AV20185DN or equivalent meets the fixed camera requirements.

**CAMERA HOUSING SYSTEM– provided for informational purposes only**

The camera housing systems shall be installed by SDDCI at Camera Locations 1-33. The camera housing shall be compatible with IP and analog PTZ and fixed cameras. The camera enclosure shall internal brackets for camera mounting. The camera enclosure shall contain internal mounting space for camera components. Fiber switches shall be placed in the camera housing

The camera housing shall contain 12 VDC and 24 VAC for camera and component power. The camera housing shall have 24VAC/VDC or 110-220 VAC input power source options.

The camera housing shall be vandal-resistant and weatherproof. The camera housing shall be IP66 rated against dust and water and IP68 rated for water proof connection ports. The camera housing shall be thermostatically controlled with a heater and blower. The camera housing system shall provide an operating system of -32 degrees Celsius to 60 degrees Celsius.

STATE OF SOUTH DAKOTA	PROJECT	SHEET	TOTAL SHEETS
	P 034-451	5	107

Plotting Date: 04/02/2014





Plotted From -

Imp14286

Plot Scale -

1:40

STATE OF SOUTH DAKOTA	PROJECT P 034-451	SHEET 6	TOTAL SHEETS 107
Plotting Date -	09/12/2014		





Plotted From: -  
Imp14286

Plot Scale: -  
1:40

STATE OF SOUTH DAKOTA	PROJECT P 034-451	SHEET 7	TOTAL SHEETS 107
Plotting Date: 04/02/2014			





Plot Scale - 1:40

Plotted From - Imp14286

STATE OF SOUTH DAKOTA	PROJECT P 034451	SHEET 6	TOTAL SHEETS 107
Plotting Date:	04/02/2014		





STATE OF	PROJECT	SHEET	TOTAL
SOUTH DAKOTA	P 034-451	9	107

Plotting Date: 04/02/2014

Plot Scale - 1"=40'

Plotted From - ttp14286





Plot Scale - 1:40

Plotted From - Imp14286



# CAMERA LOCATIONS





CAMERA LOCATIONS



MATCH POINT

PTZ  
5



# SD HWY 34 & 131st AVE LOCATION 1/2/3



NOT TO SCALE

180  
③

SD HWY 34

PTZ ①

ALKALI RD

PTZ ②

131st AVE











# SD HWY 34 & 131st AVE

Location 3



NOT TO SCALE





# SD HWY 34 & SD HWY 79 LOCATION 4

17 107

SD 79


SD HWY 34

④  
180



NOT TO SCALE



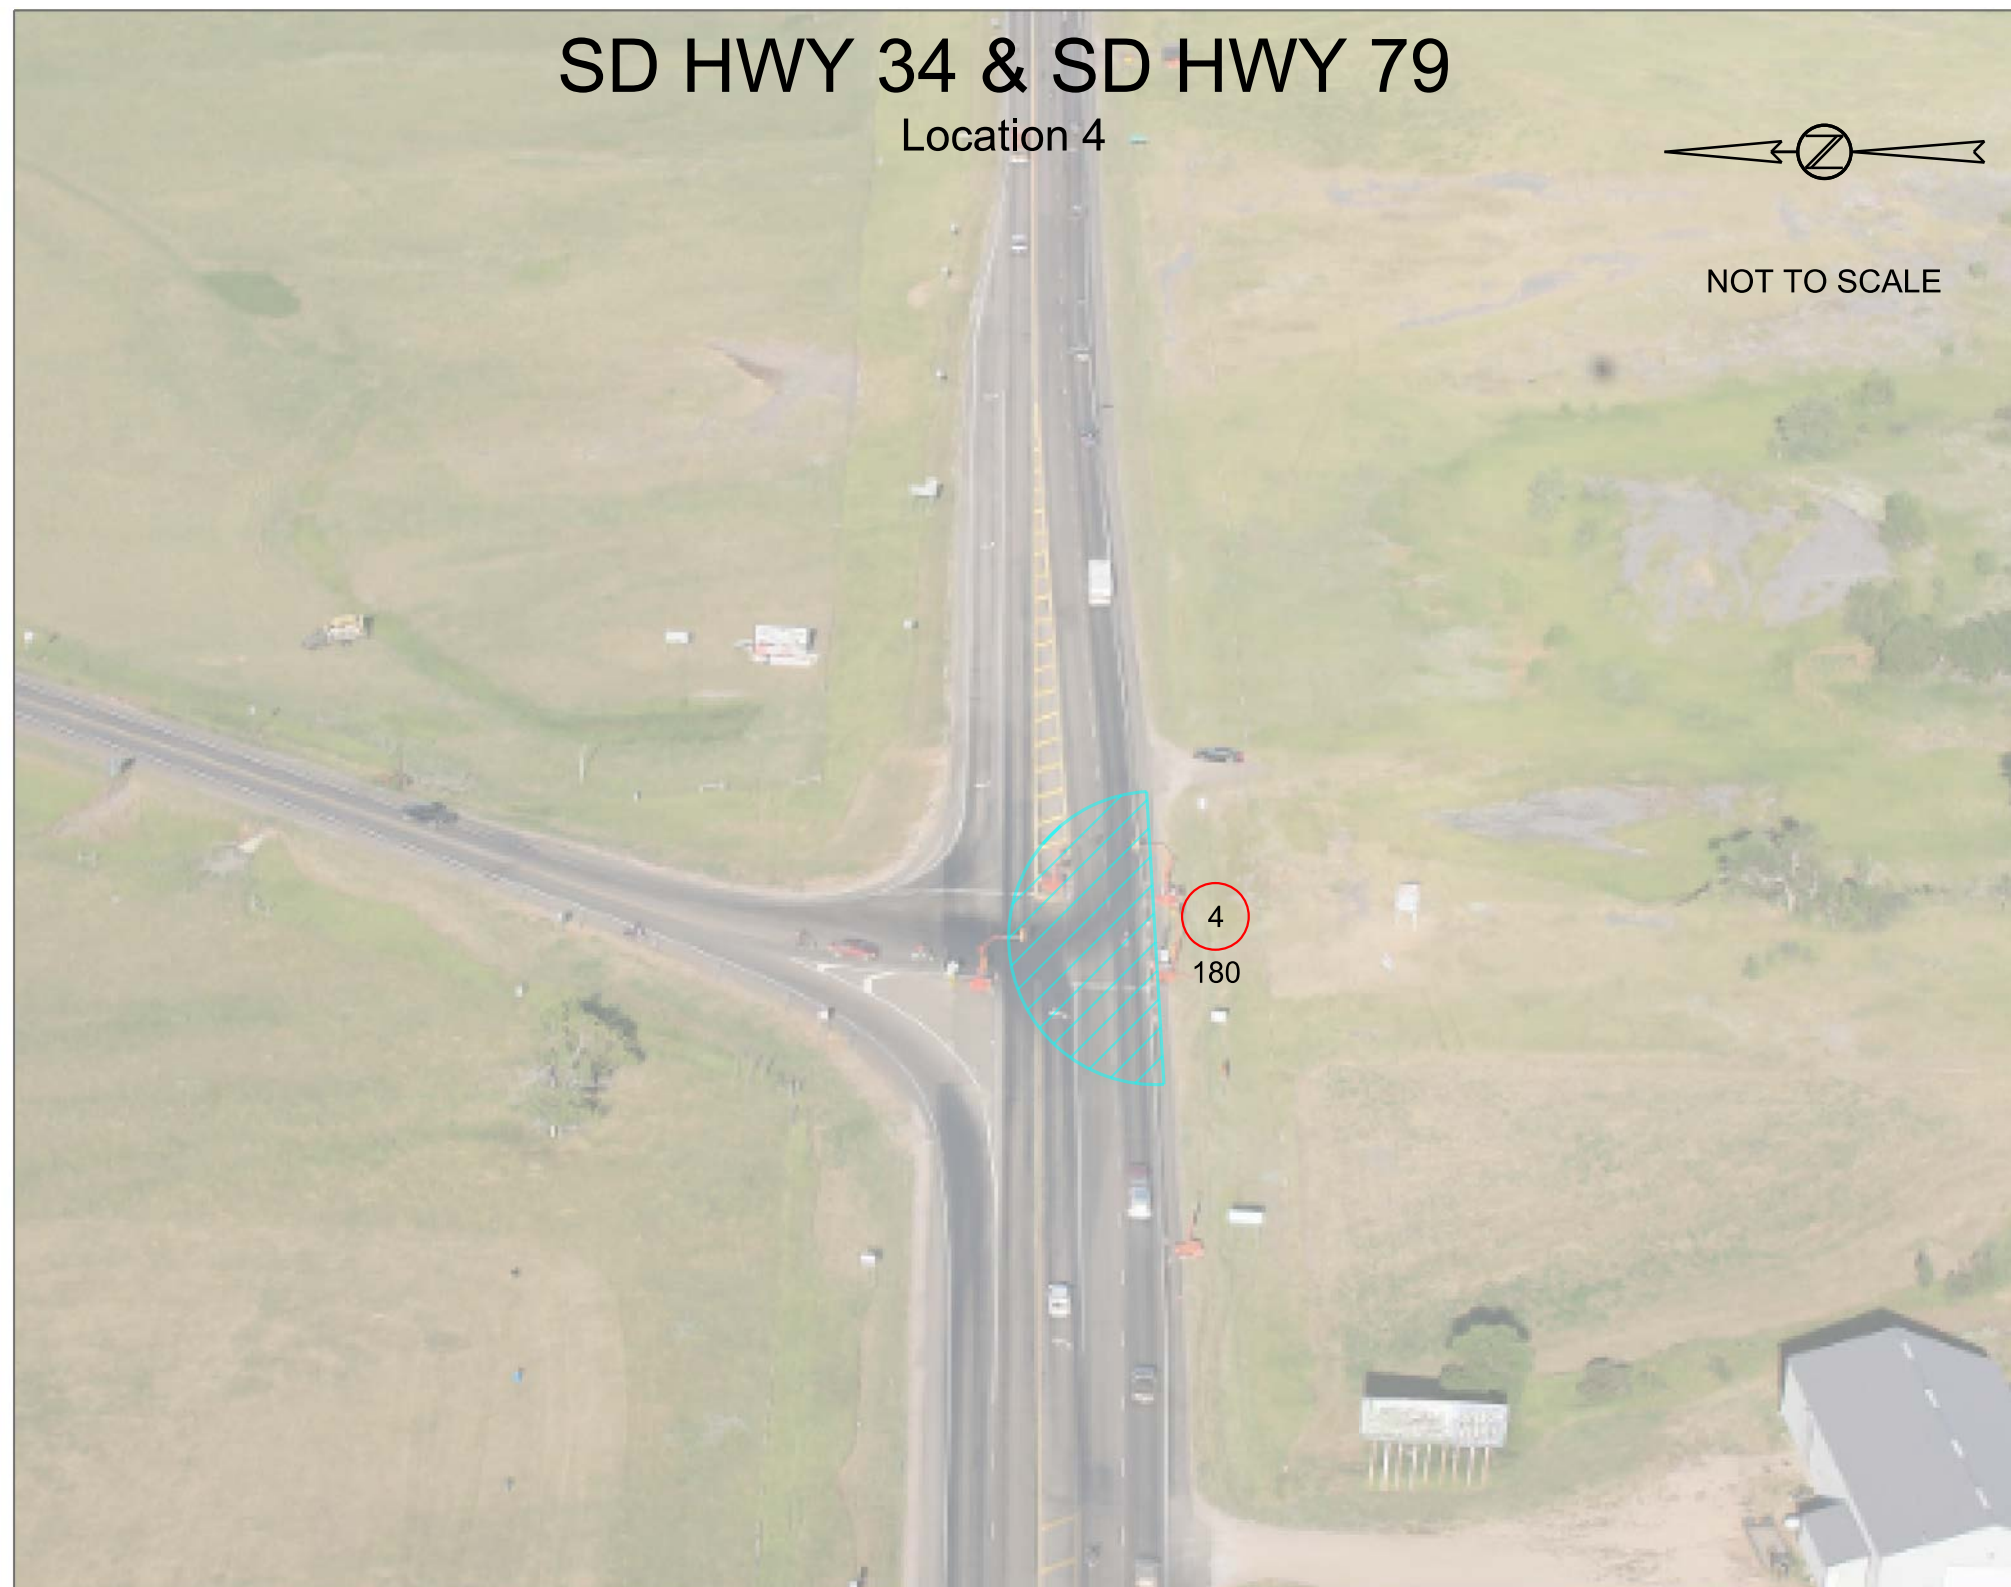



# SD HWY 34 & SD HWY 79

Location 4





# SD HWY 79 LOCATION 5



NOT TO SCALE

PTZ ⑤


130th AVE/SD HWY 79

BROKEN SPOKE SALOON  
CAMPGROUND








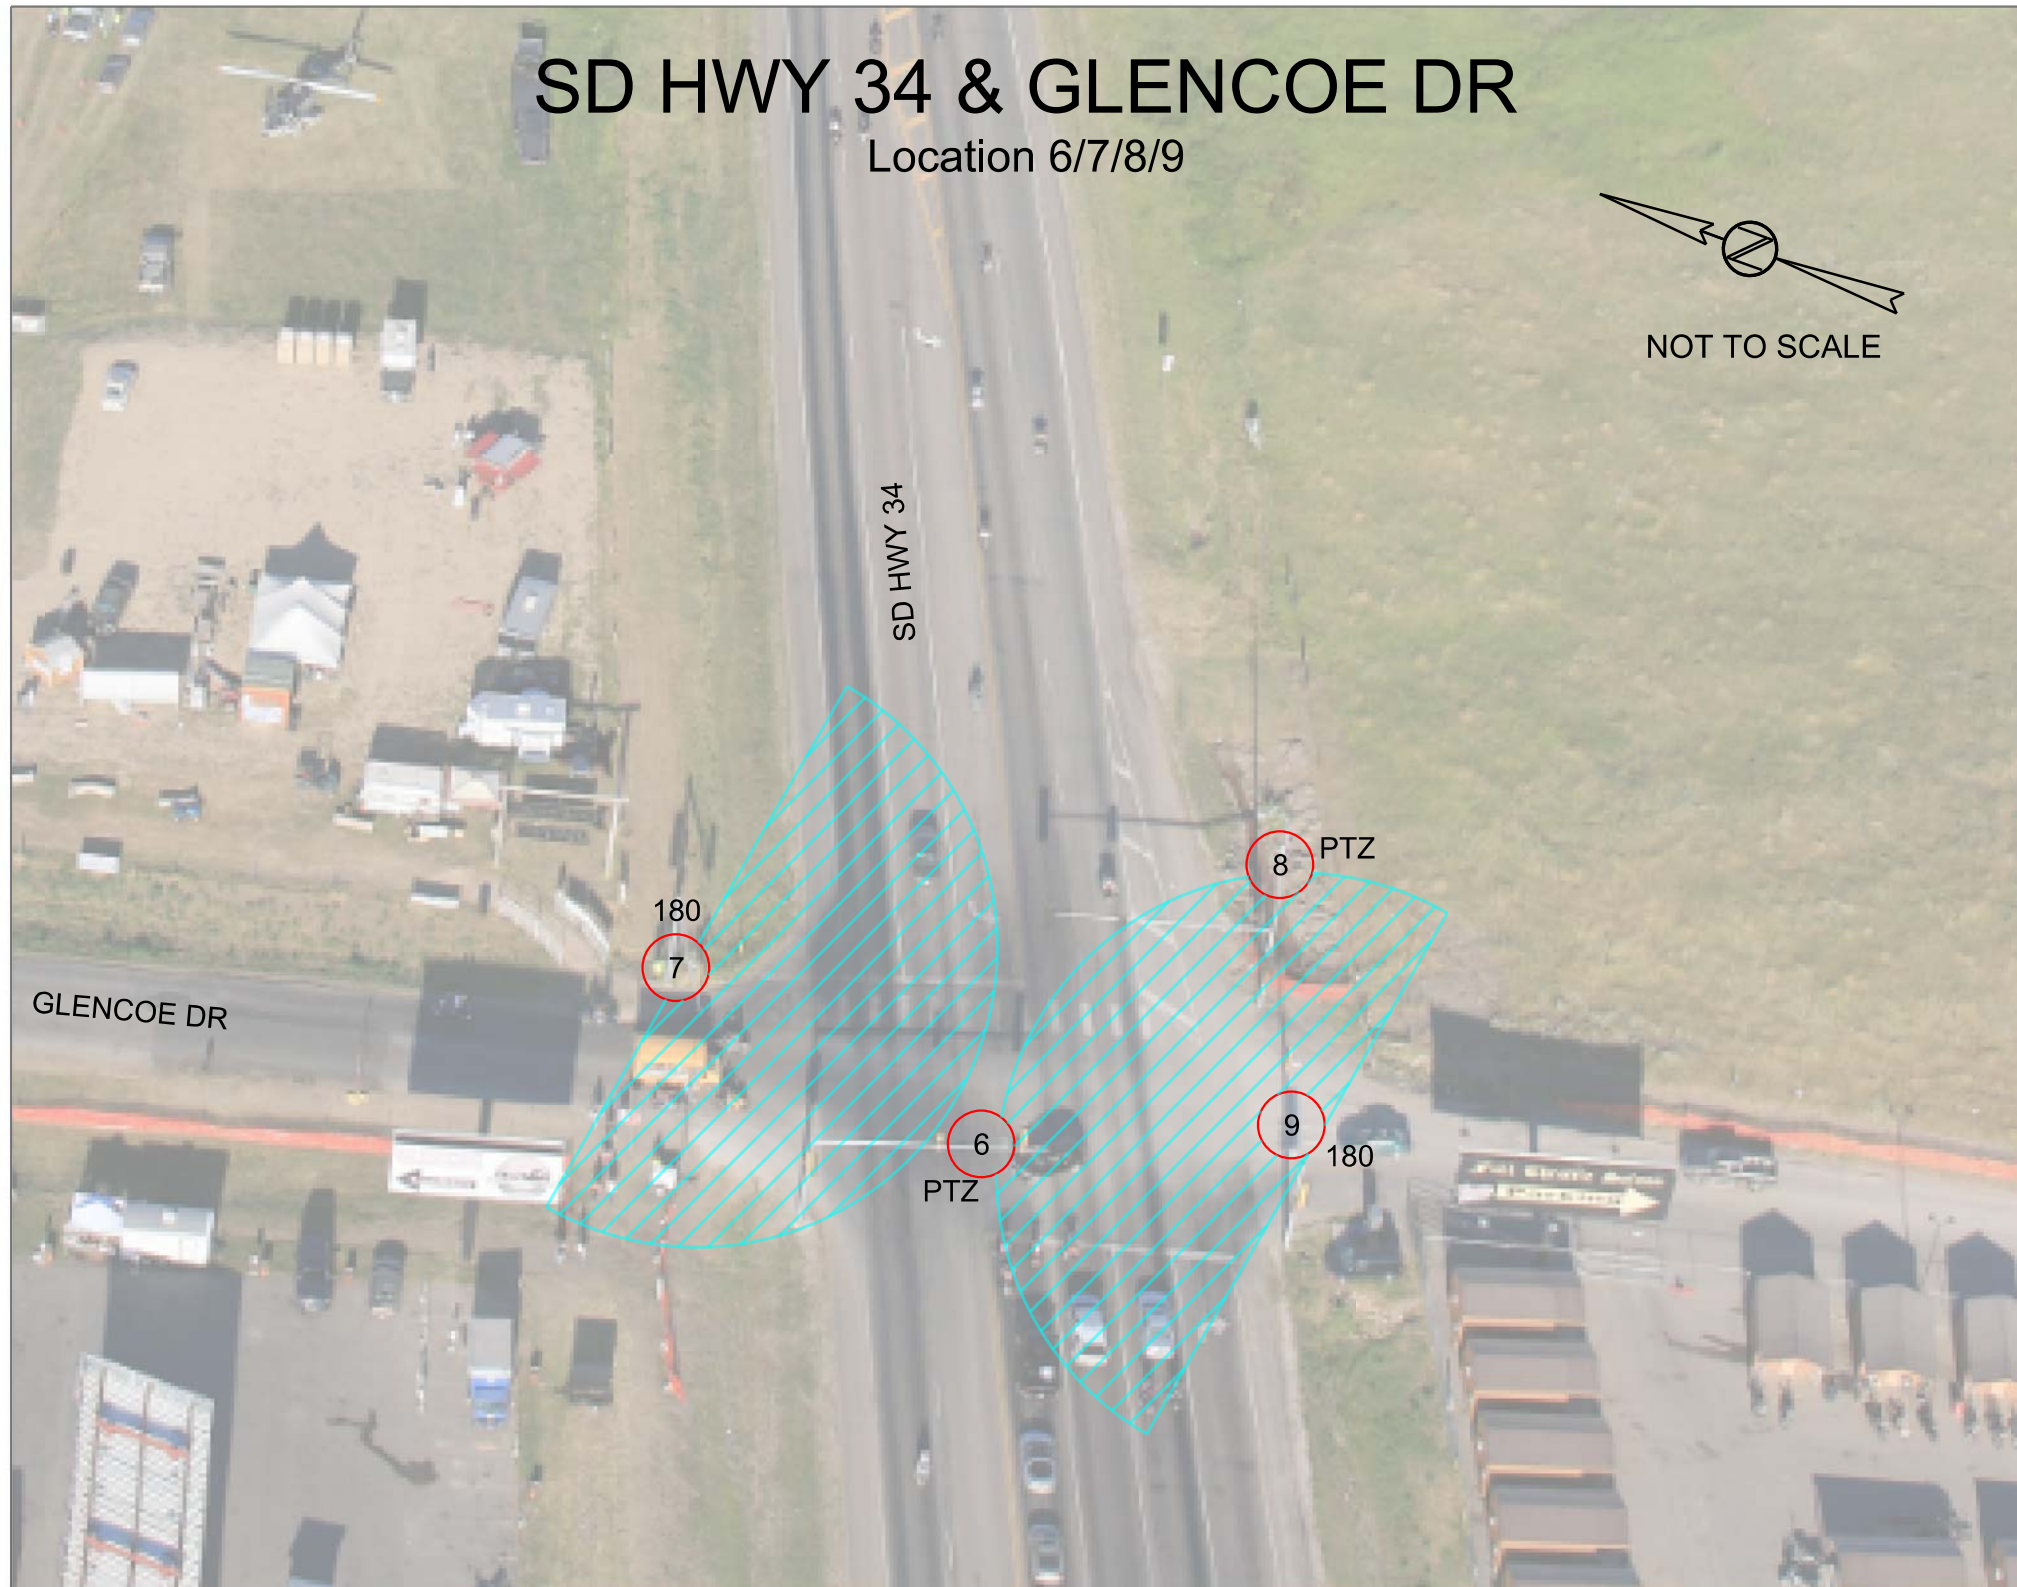



# SD HWY 34 & GLENCOE DR

Location 6/7/8/9

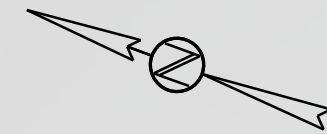

NOT TO SCALE





# SIGNAL LAYOUT







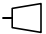


## SD HWY 34 & GLENCOE/FULL THROTTLE ENTRANCES


STATE OF SOUTH DAKOTA	PROJECT	SHEET	TOTAL SHEETS
	P 034-451	24	107

Plotting Date: 04/02/2014

 

SCALE  
1" = 40'

KEY	ITEM
	SIGNAL POLE WITH LUMINAIRE ARM (S1)
	LUMINAIRE POLE WITH MAST ARM (S2-S4)
	SIGNAL HEAD (3-Section)(3,4,7,8,11,14)
	SIGNAL HEAD (5-SECTION)(1,2,5,6,9,10,12,13)
	TRAFFIC SIGNAL CONTROLLER
	VIDEO DETECTION SYSTEM (15,16,17,18)
	PEDESTRIAN SIGNAL HEAD (19,20)
	PEDESTRIAN PUSH BUTTON
	PEDESTRIAN CROSSING SIGN (1 LEFT,1 RIGHT)

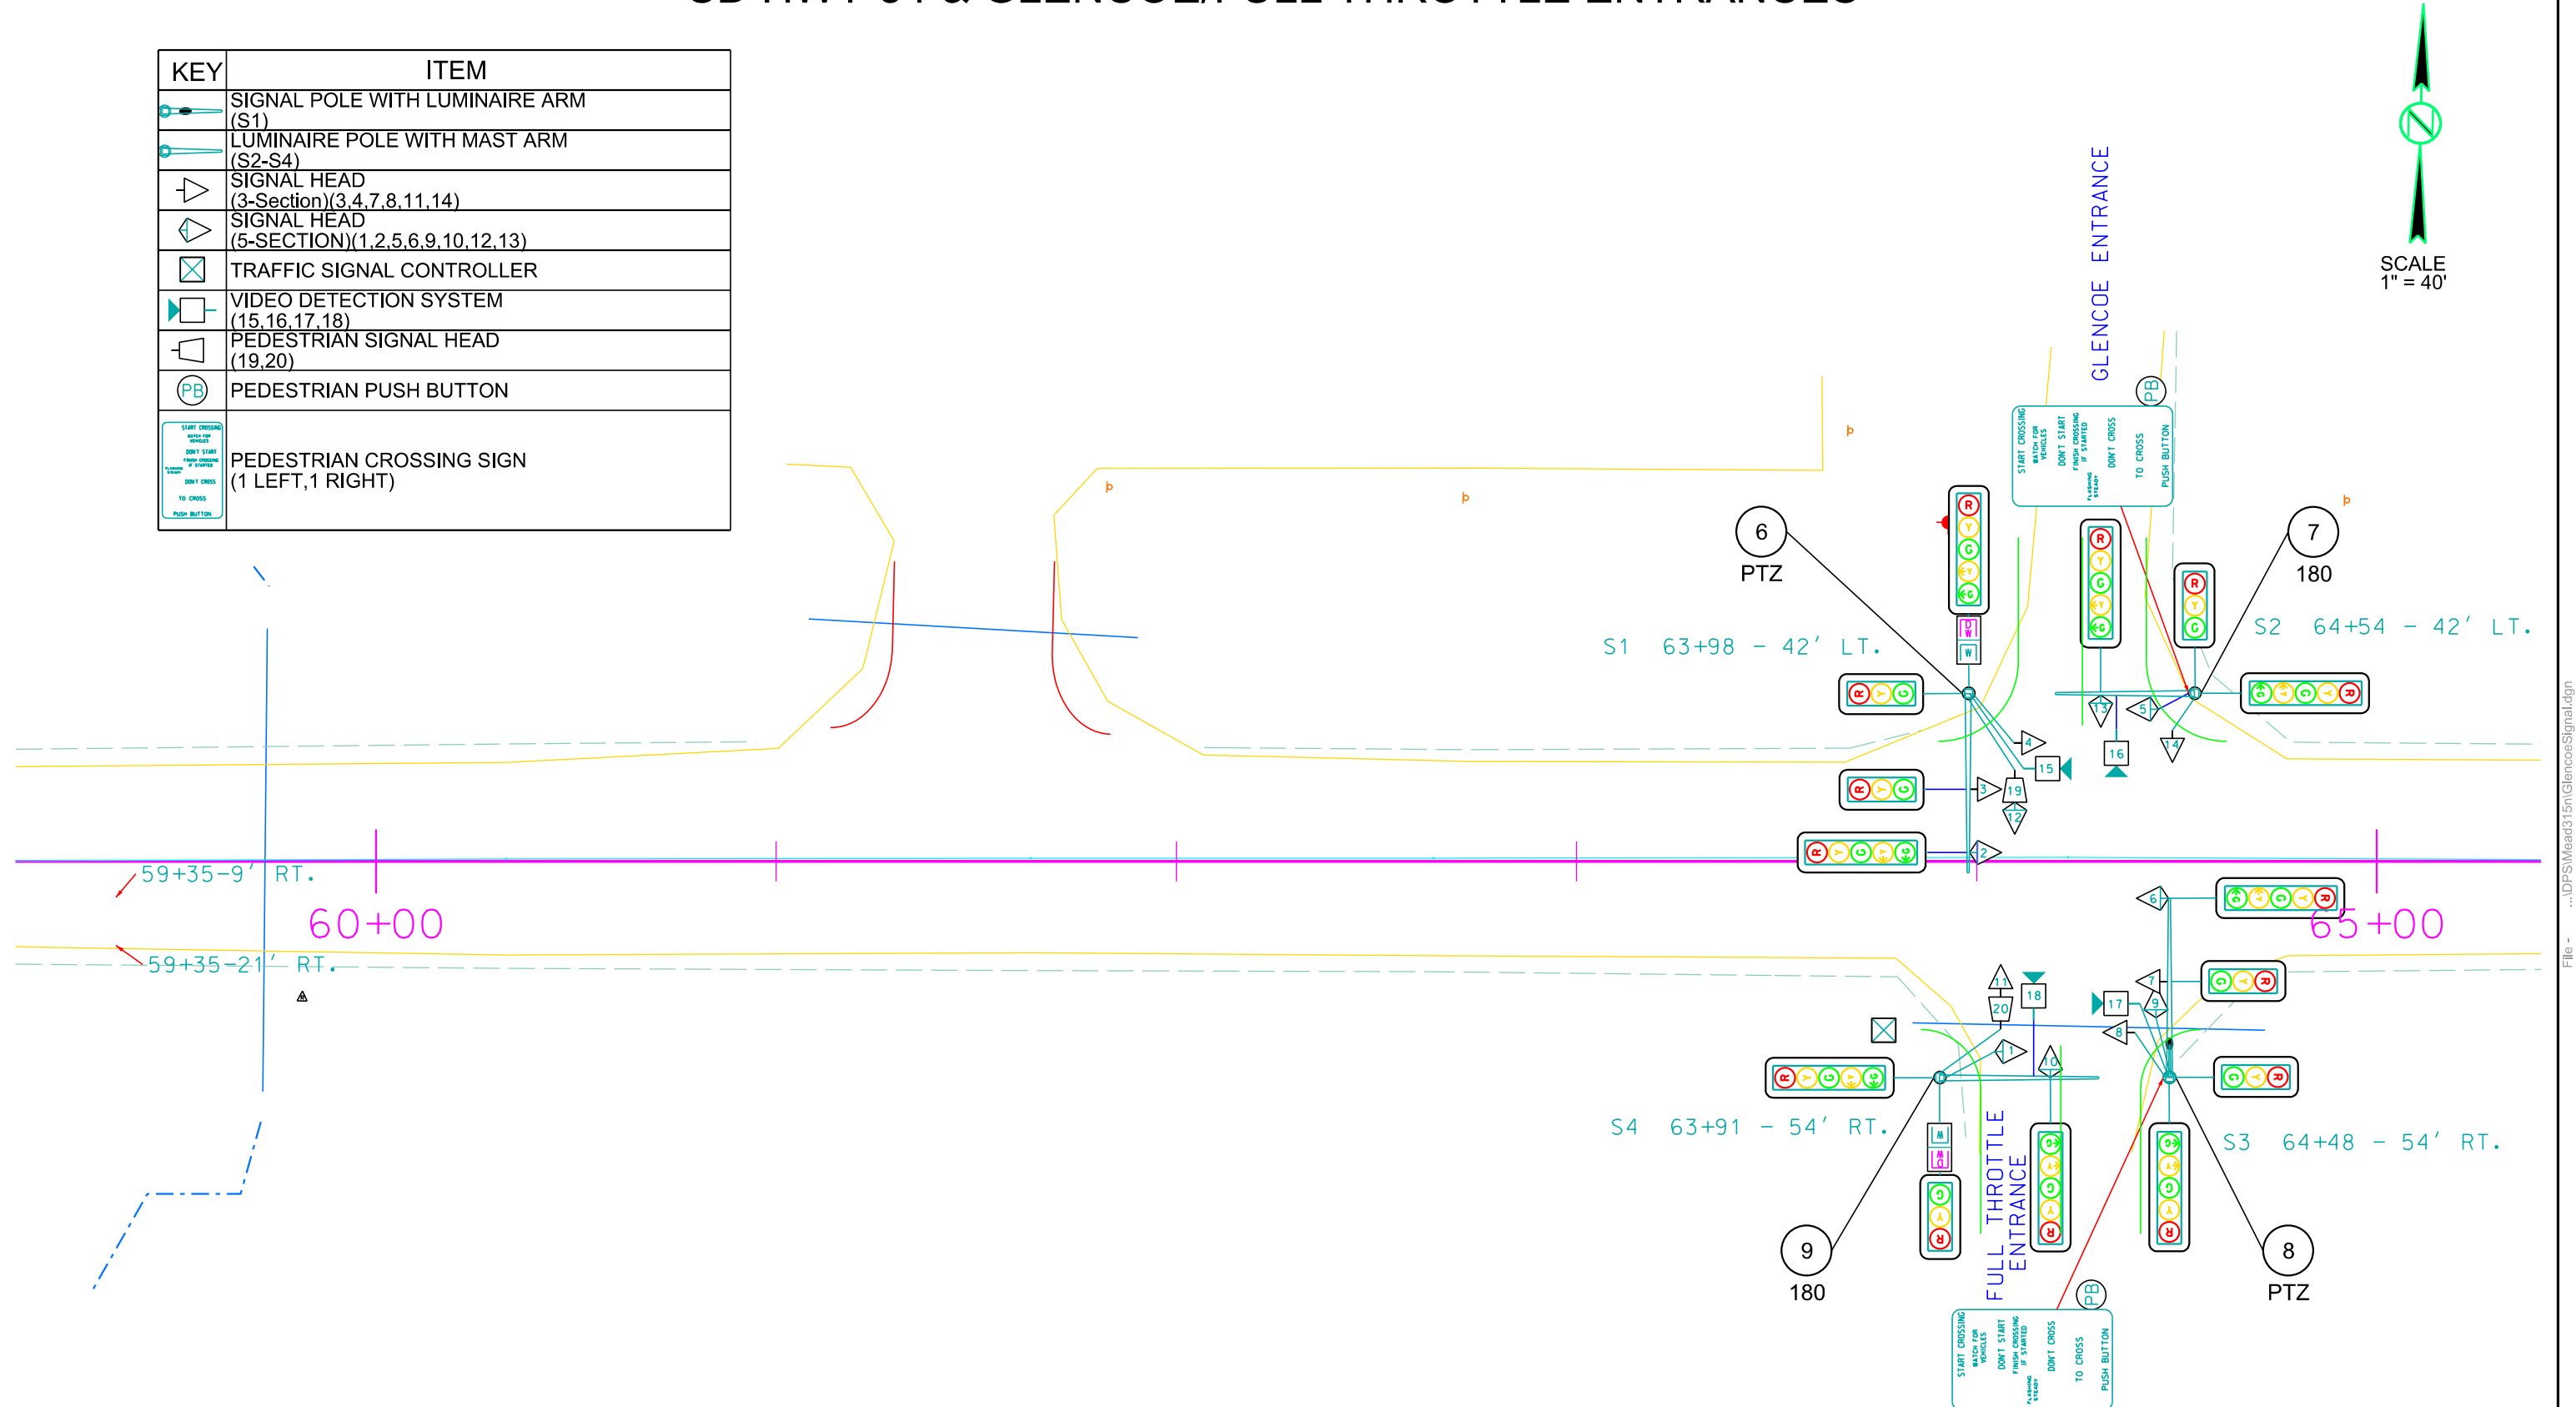



GLENCOE DR  
LOCATION 10



NOT TO SCALE

SD HWY 34

GLENCOE DR

GLENCOE DR

10  
PTZ  
29



GLENCOE DR  
LOCATION 10



PTZ  
10



NOT TO SCALE

GLENCOE DR



# LAZELLE ST/SD HWY 34 & NELLIE ST LOCATION 11



NOT TO SCALE

11  
PTZ

LAZELLE ST/SD HWY 34

NELLIE ST







# CAMERA LOCATIONS 12-20













# JUNCTION AVE & LAZELLE ST

Location 13



NOT TO SCALE





SIGNAL LAYOUT  
SD HWY 34/LAZELLE STREET & JUNCTION AVENUE  
LOCATION 13


STATE OF SOUTH DAKOTA	PROJECT	SHEET	TOTAL SHEETS
	P 034-451	33	107

Plotting Date: 04/02/2014  
Revised Date: 07/11/2012 SB


SCALE  
1" = 40'



EXISTING ITEMS	
KEY	ITEM
	SIGNAL POLE W/MAST ARM & LUMINAIRE ARM (ED1-ED4)
	ROADWAY LUMINAIRE, 400W WITH P.E. (ED1-ED4)
	3 SECTION VEHICLE SIGNAL HEAD (3,4,7,8,11-16)
	5 SECTION VEHICLE SIGNAL HEAD (1,2,9,10)
	PEDESTRIAN SIGNAL HEAD W/COUNTDOWN TIMER (17-24)
	VIDEO DETECTION CAMERA NOT A BID ITEM (27-30)
	5 SECTION VEHICLE SIGNAL HEAD (25,26)
	MISCELLANEOUS SIGNAL PARTS
	PEDESTRIAN PUSH BUTTON
	PEDESTRIAN PUSH BUTTON POLE (PD1-PD4)
	PEDESTRIAN CROSSING SIGN R10-3e (2-LEFT,2-RIGHT )
	MISCELLANEOUS ELECTRICAL OUTLET RECEPTACLE ON ED1 & ED4

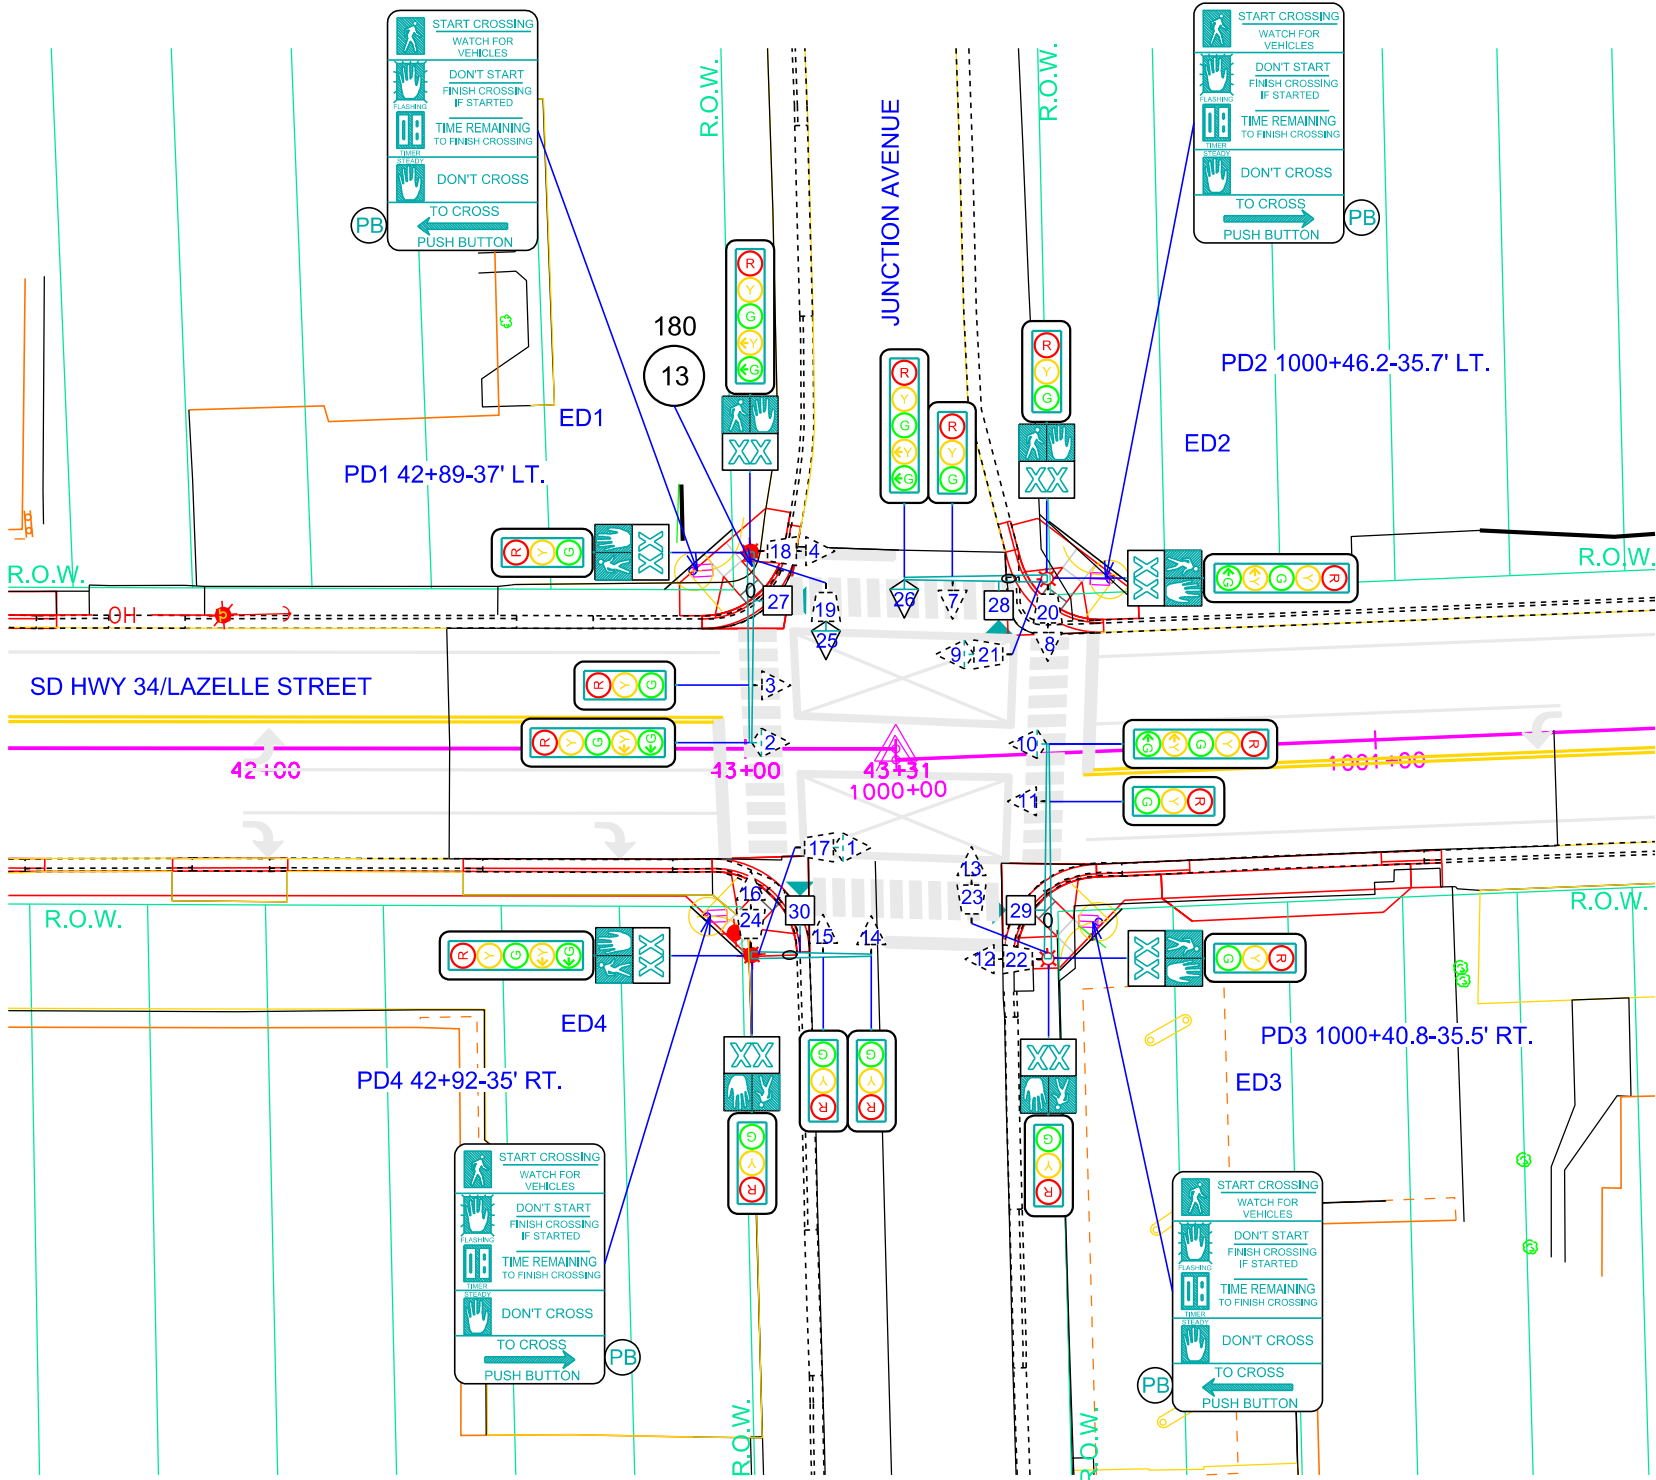



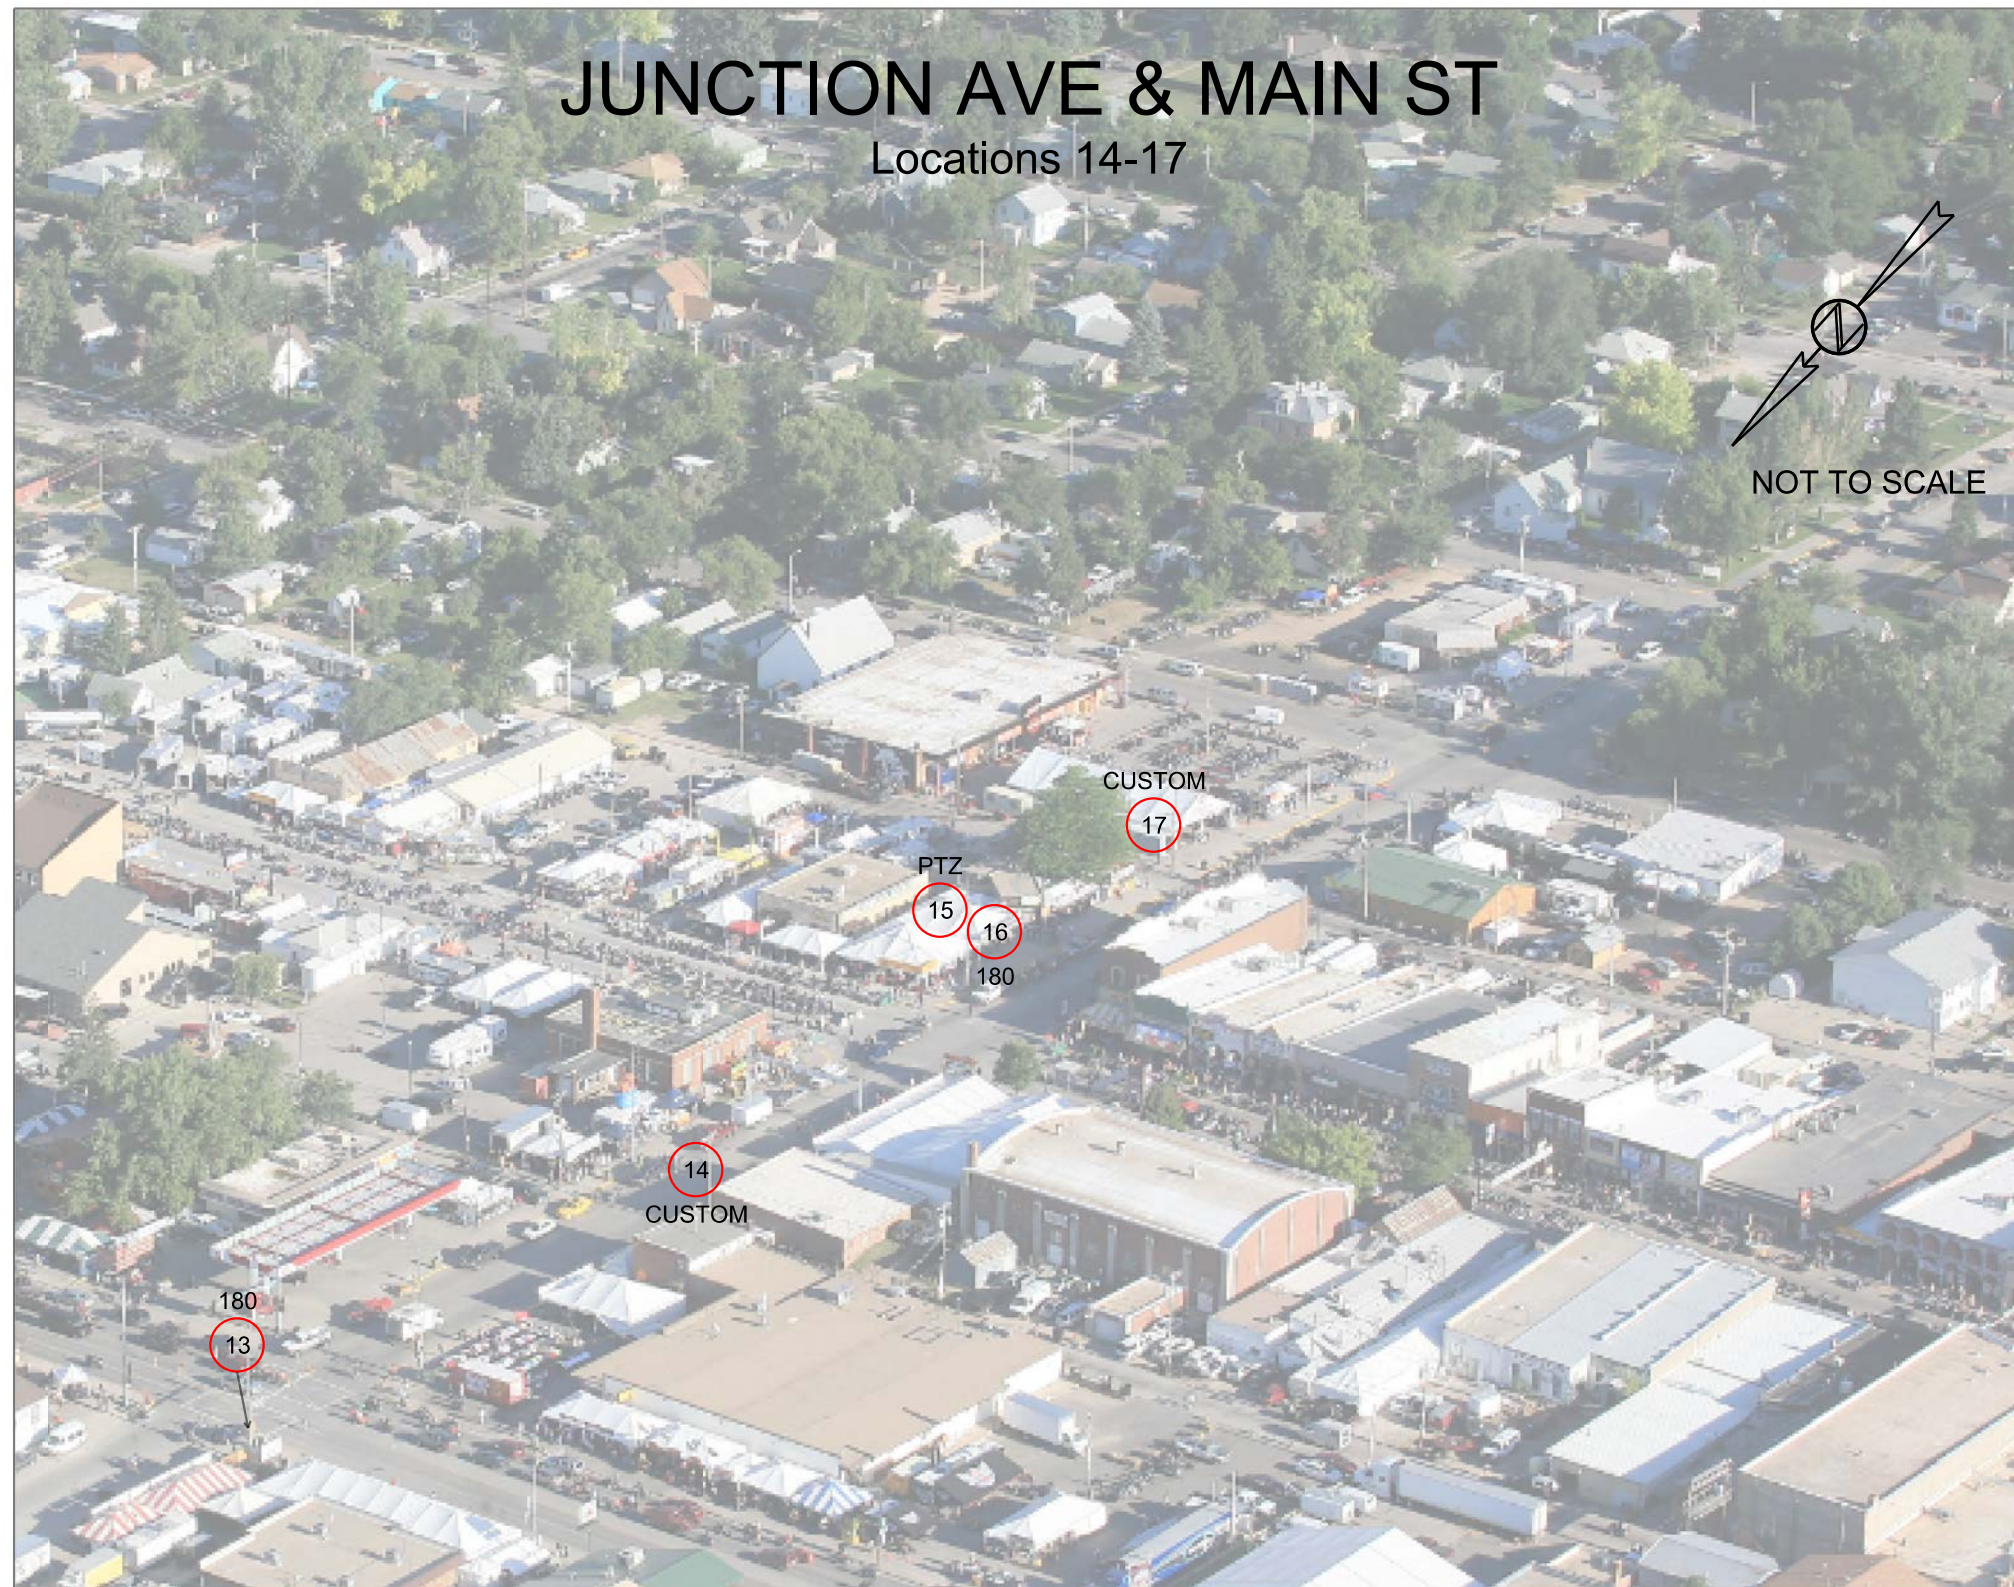



# JUNCTION AVE & ALLEY BETWEEN LAZELLE ST & MAIN ST

Location 14














# CAMERA LOCATIONS 13-29

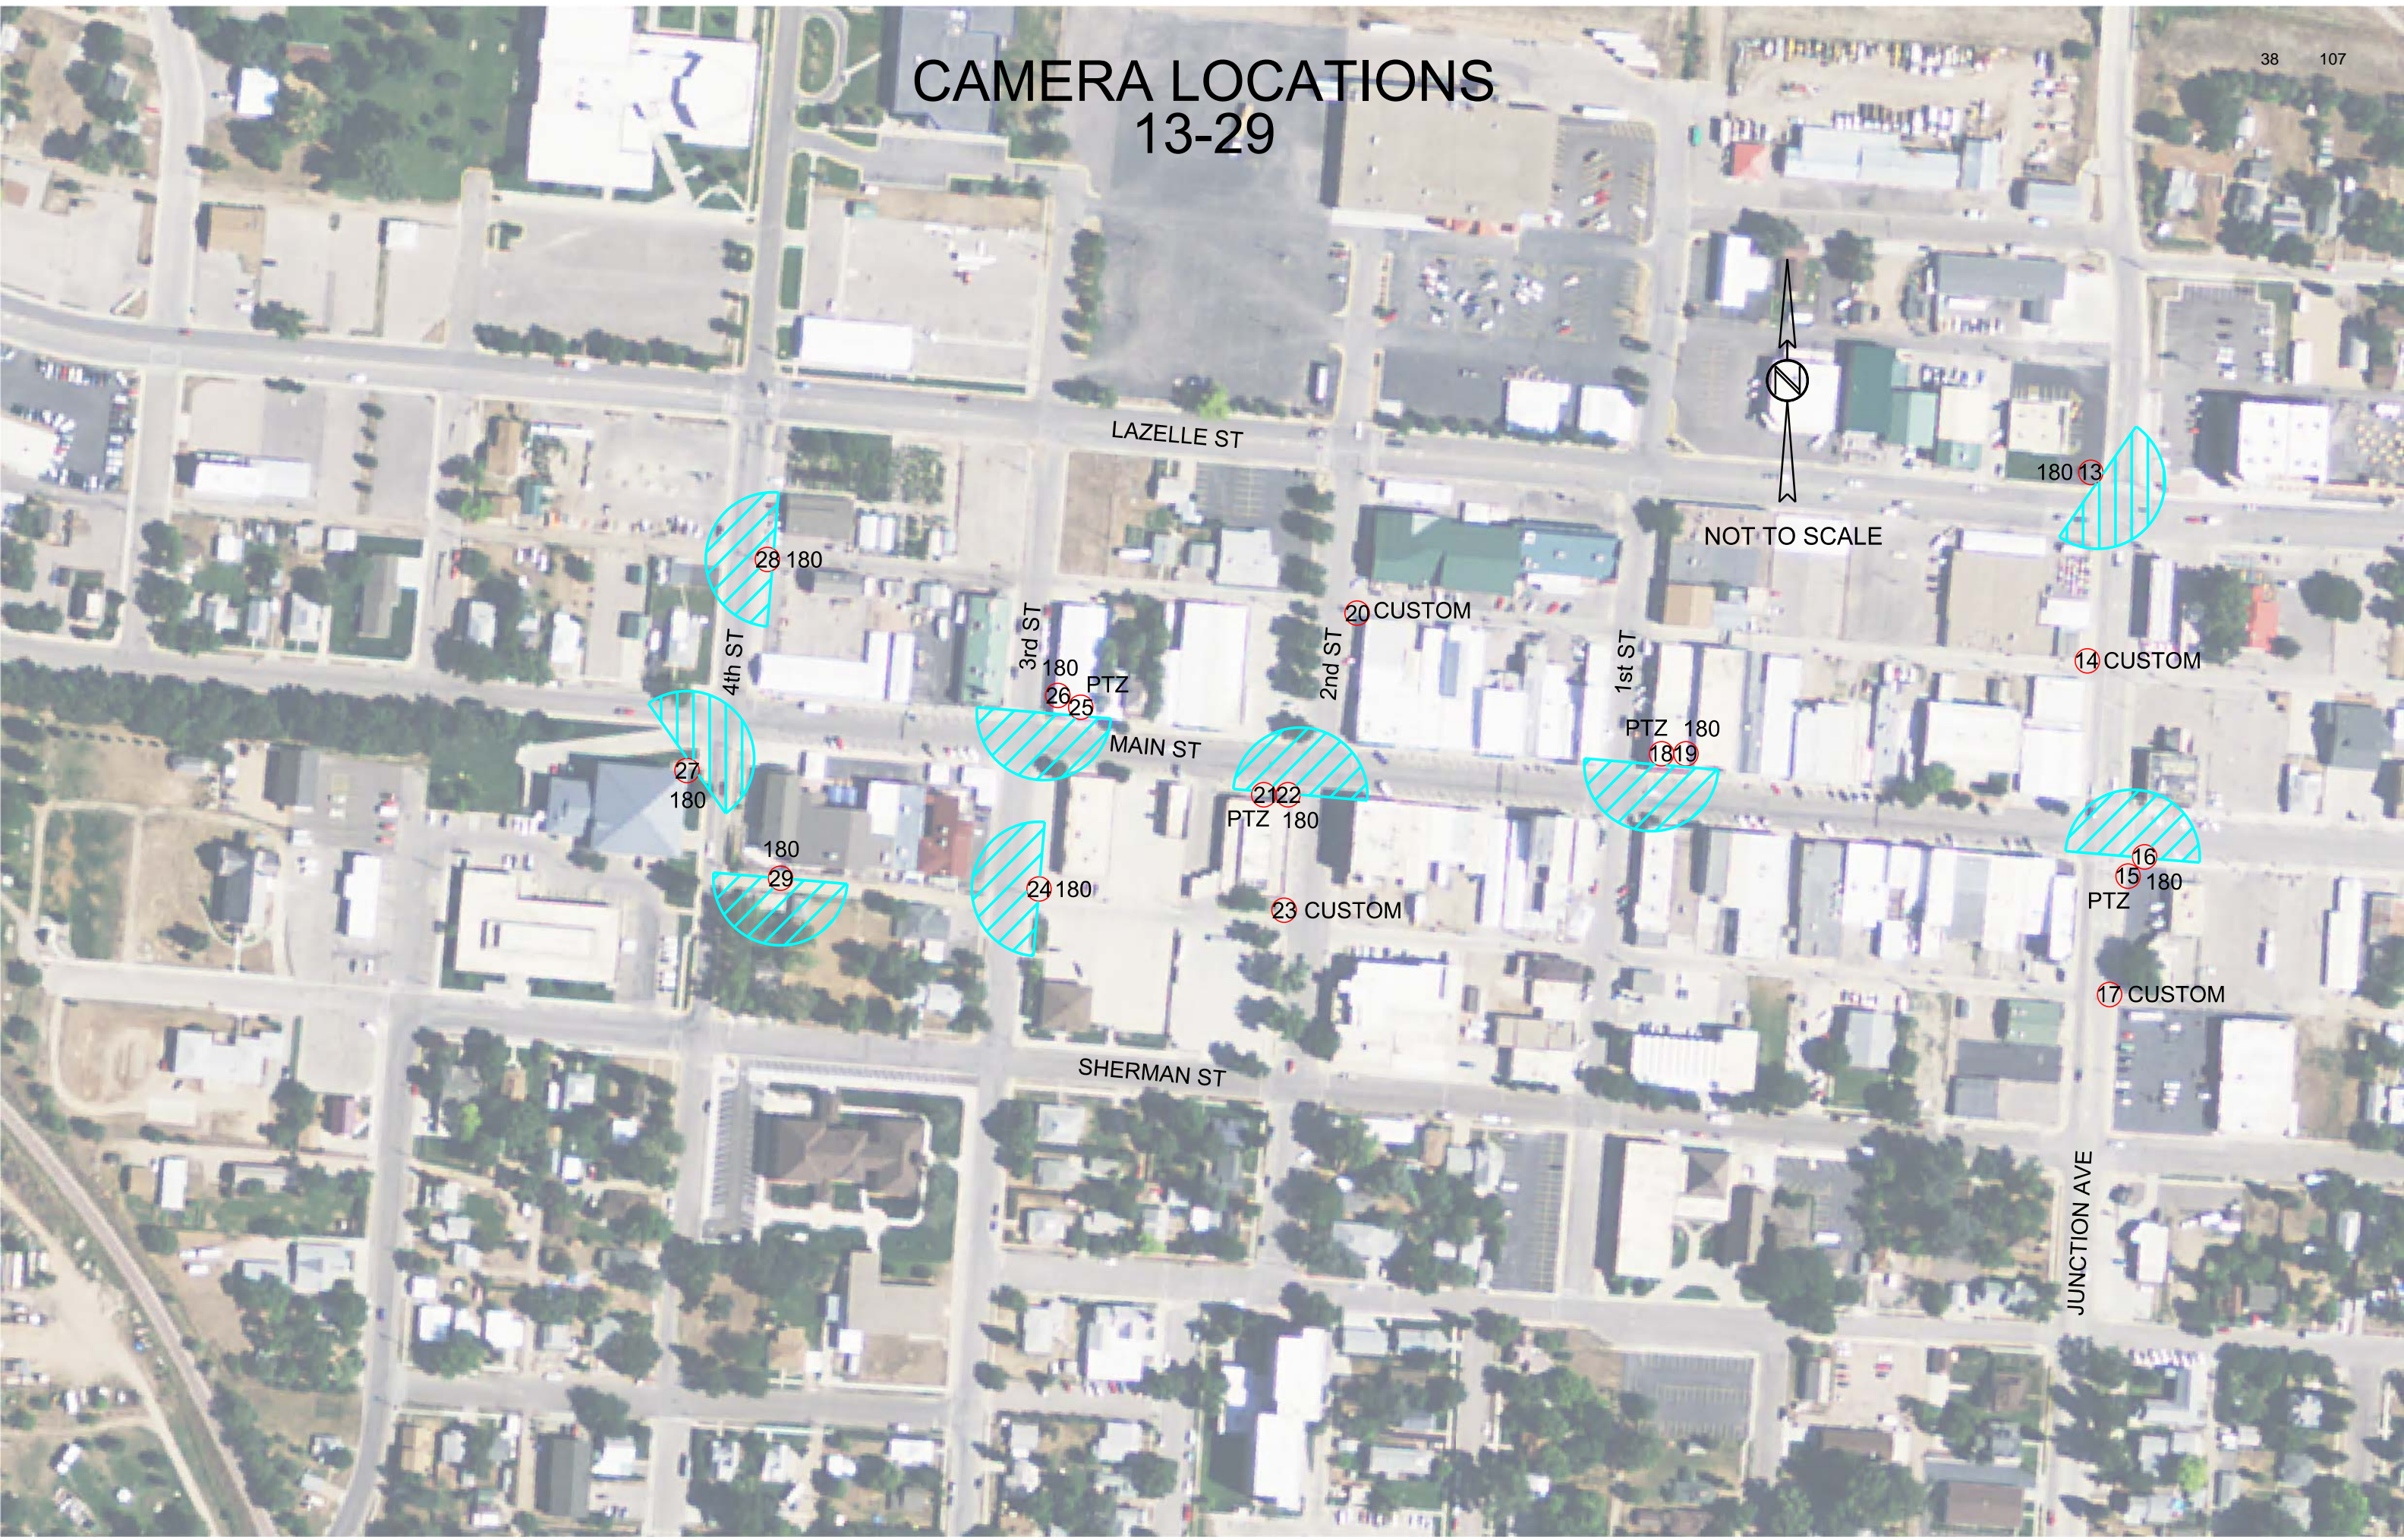

NOT TO SCALE

LAZELLE ST

MAIN ST

SHERMAN ST

4th ST

3rd ST

2nd ST

1st ST

JUNCTION AVE

180 13

14 CUSTOM

16 PTZ 180

15 180

17 CUSTOM

PTZ 180

18 19

20 CUSTOM

21 22 PTZ 180

23 CUSTOM

180 PTZ

25 26

24 180

28 180

180

29

27 180

















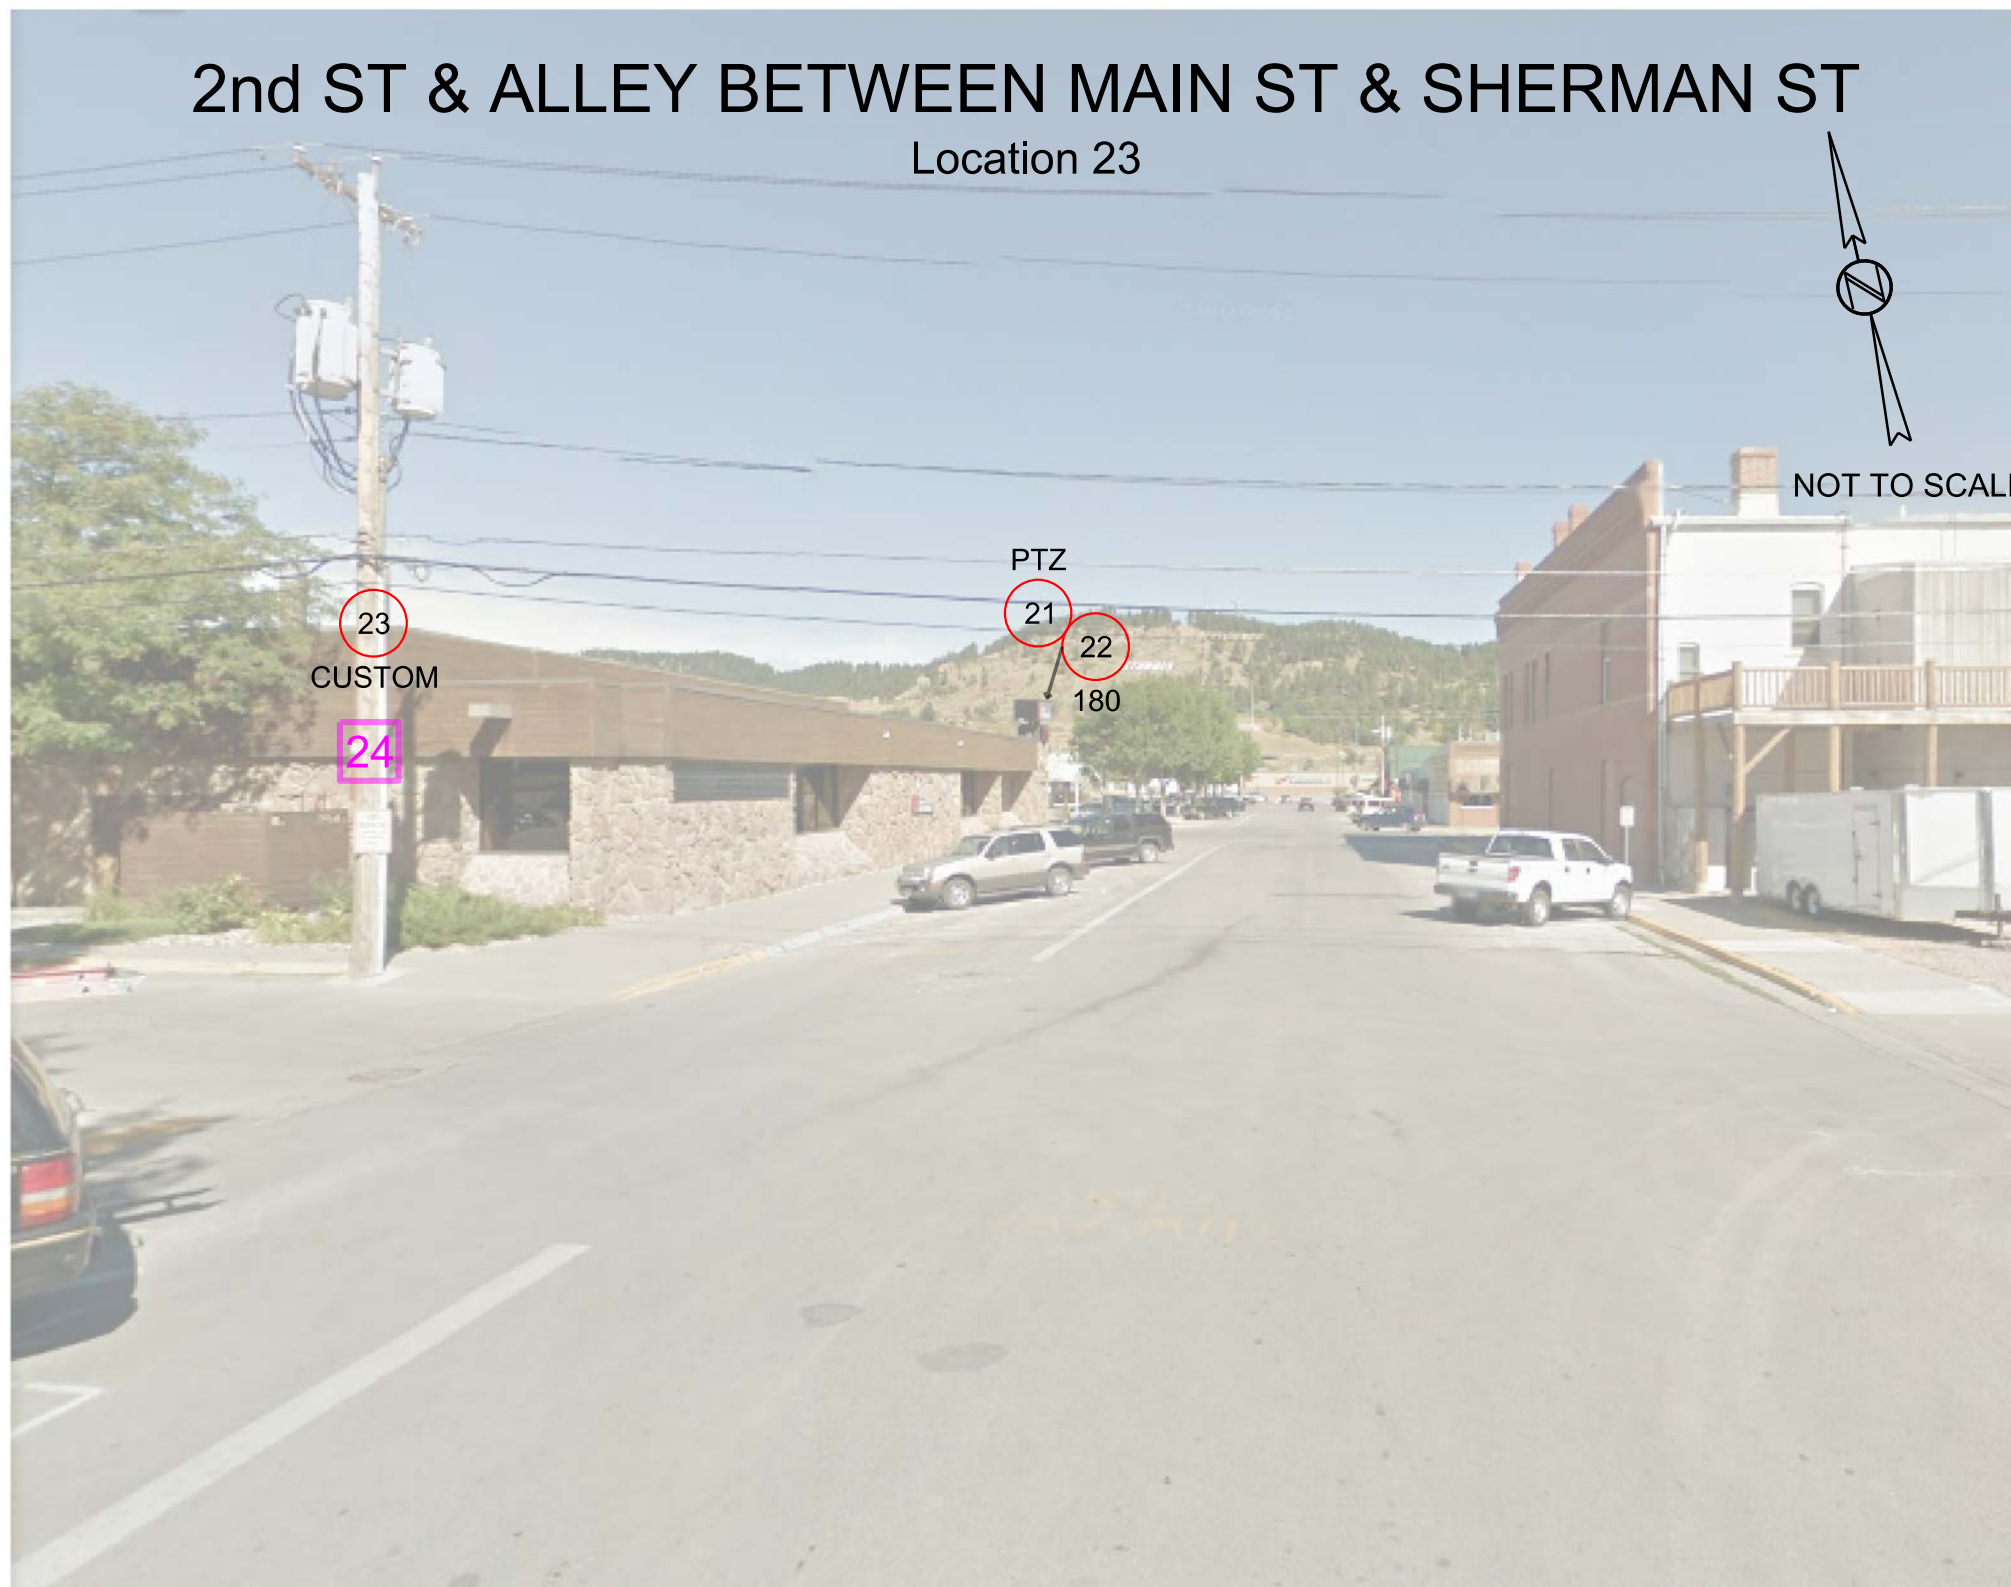



# 3rd ST & ALLEY BETWEEN MAIN ST & SHERMAN ST

Location 24

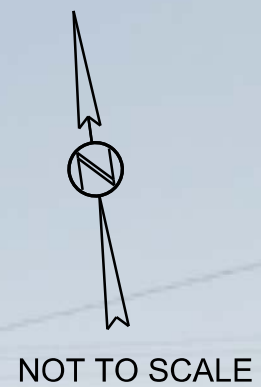











# 4th ST & ALLEY BETWEEN LAZELLE ST & MAIN ST


Location 28




NOT TO SCALE





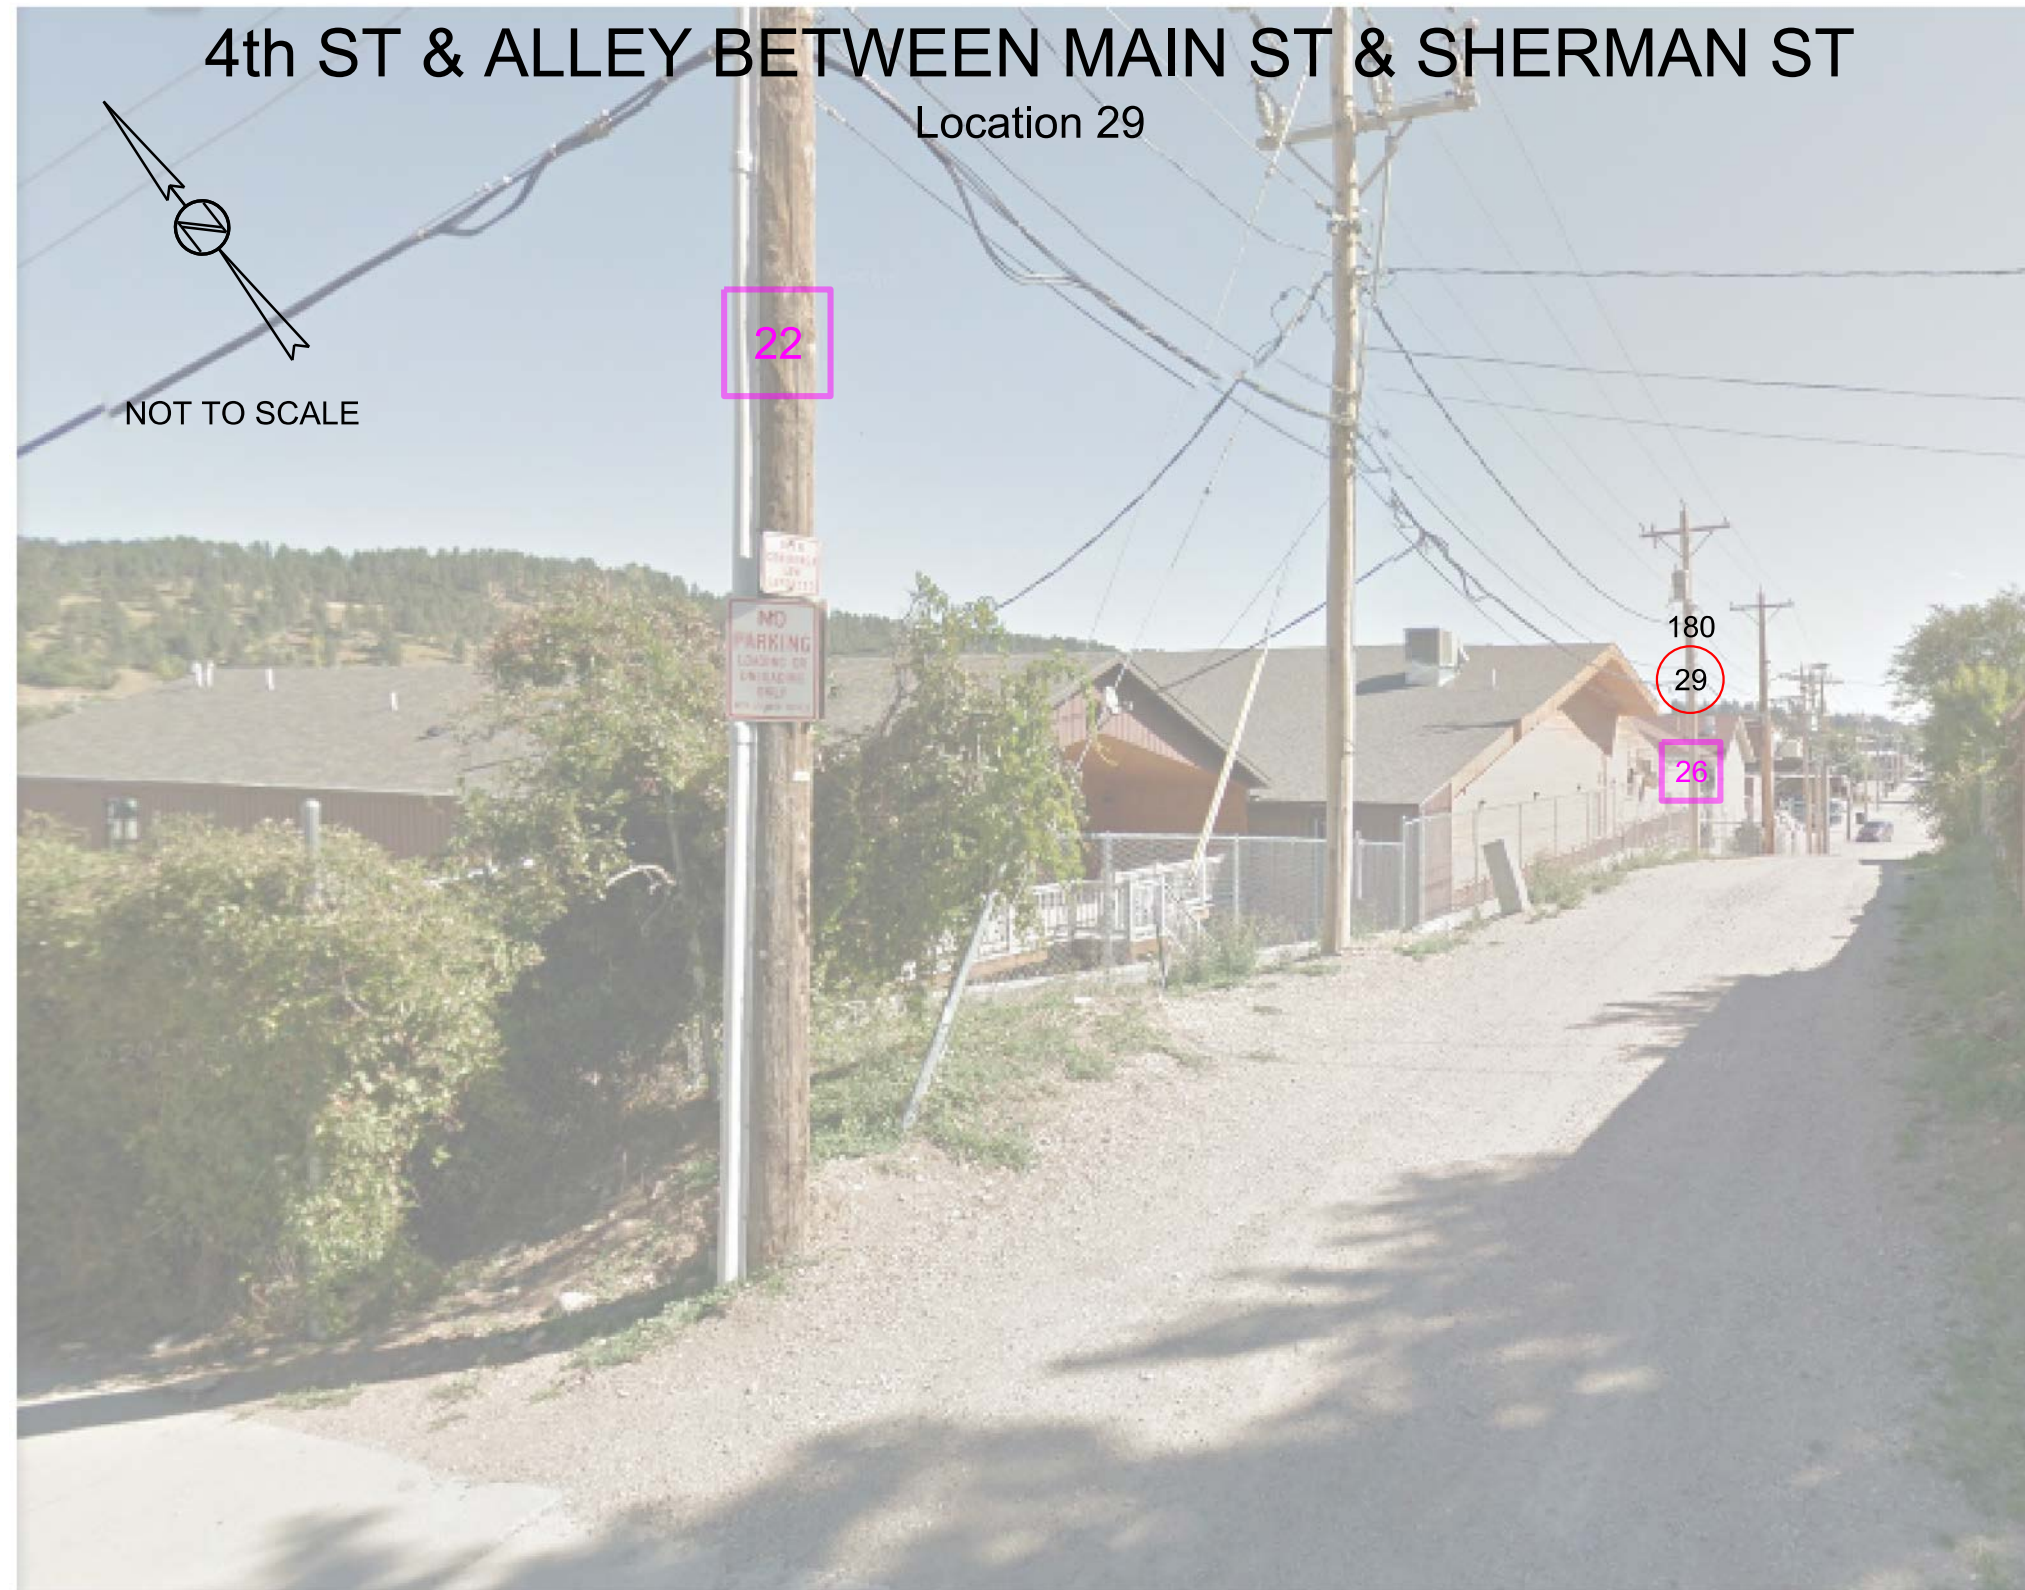



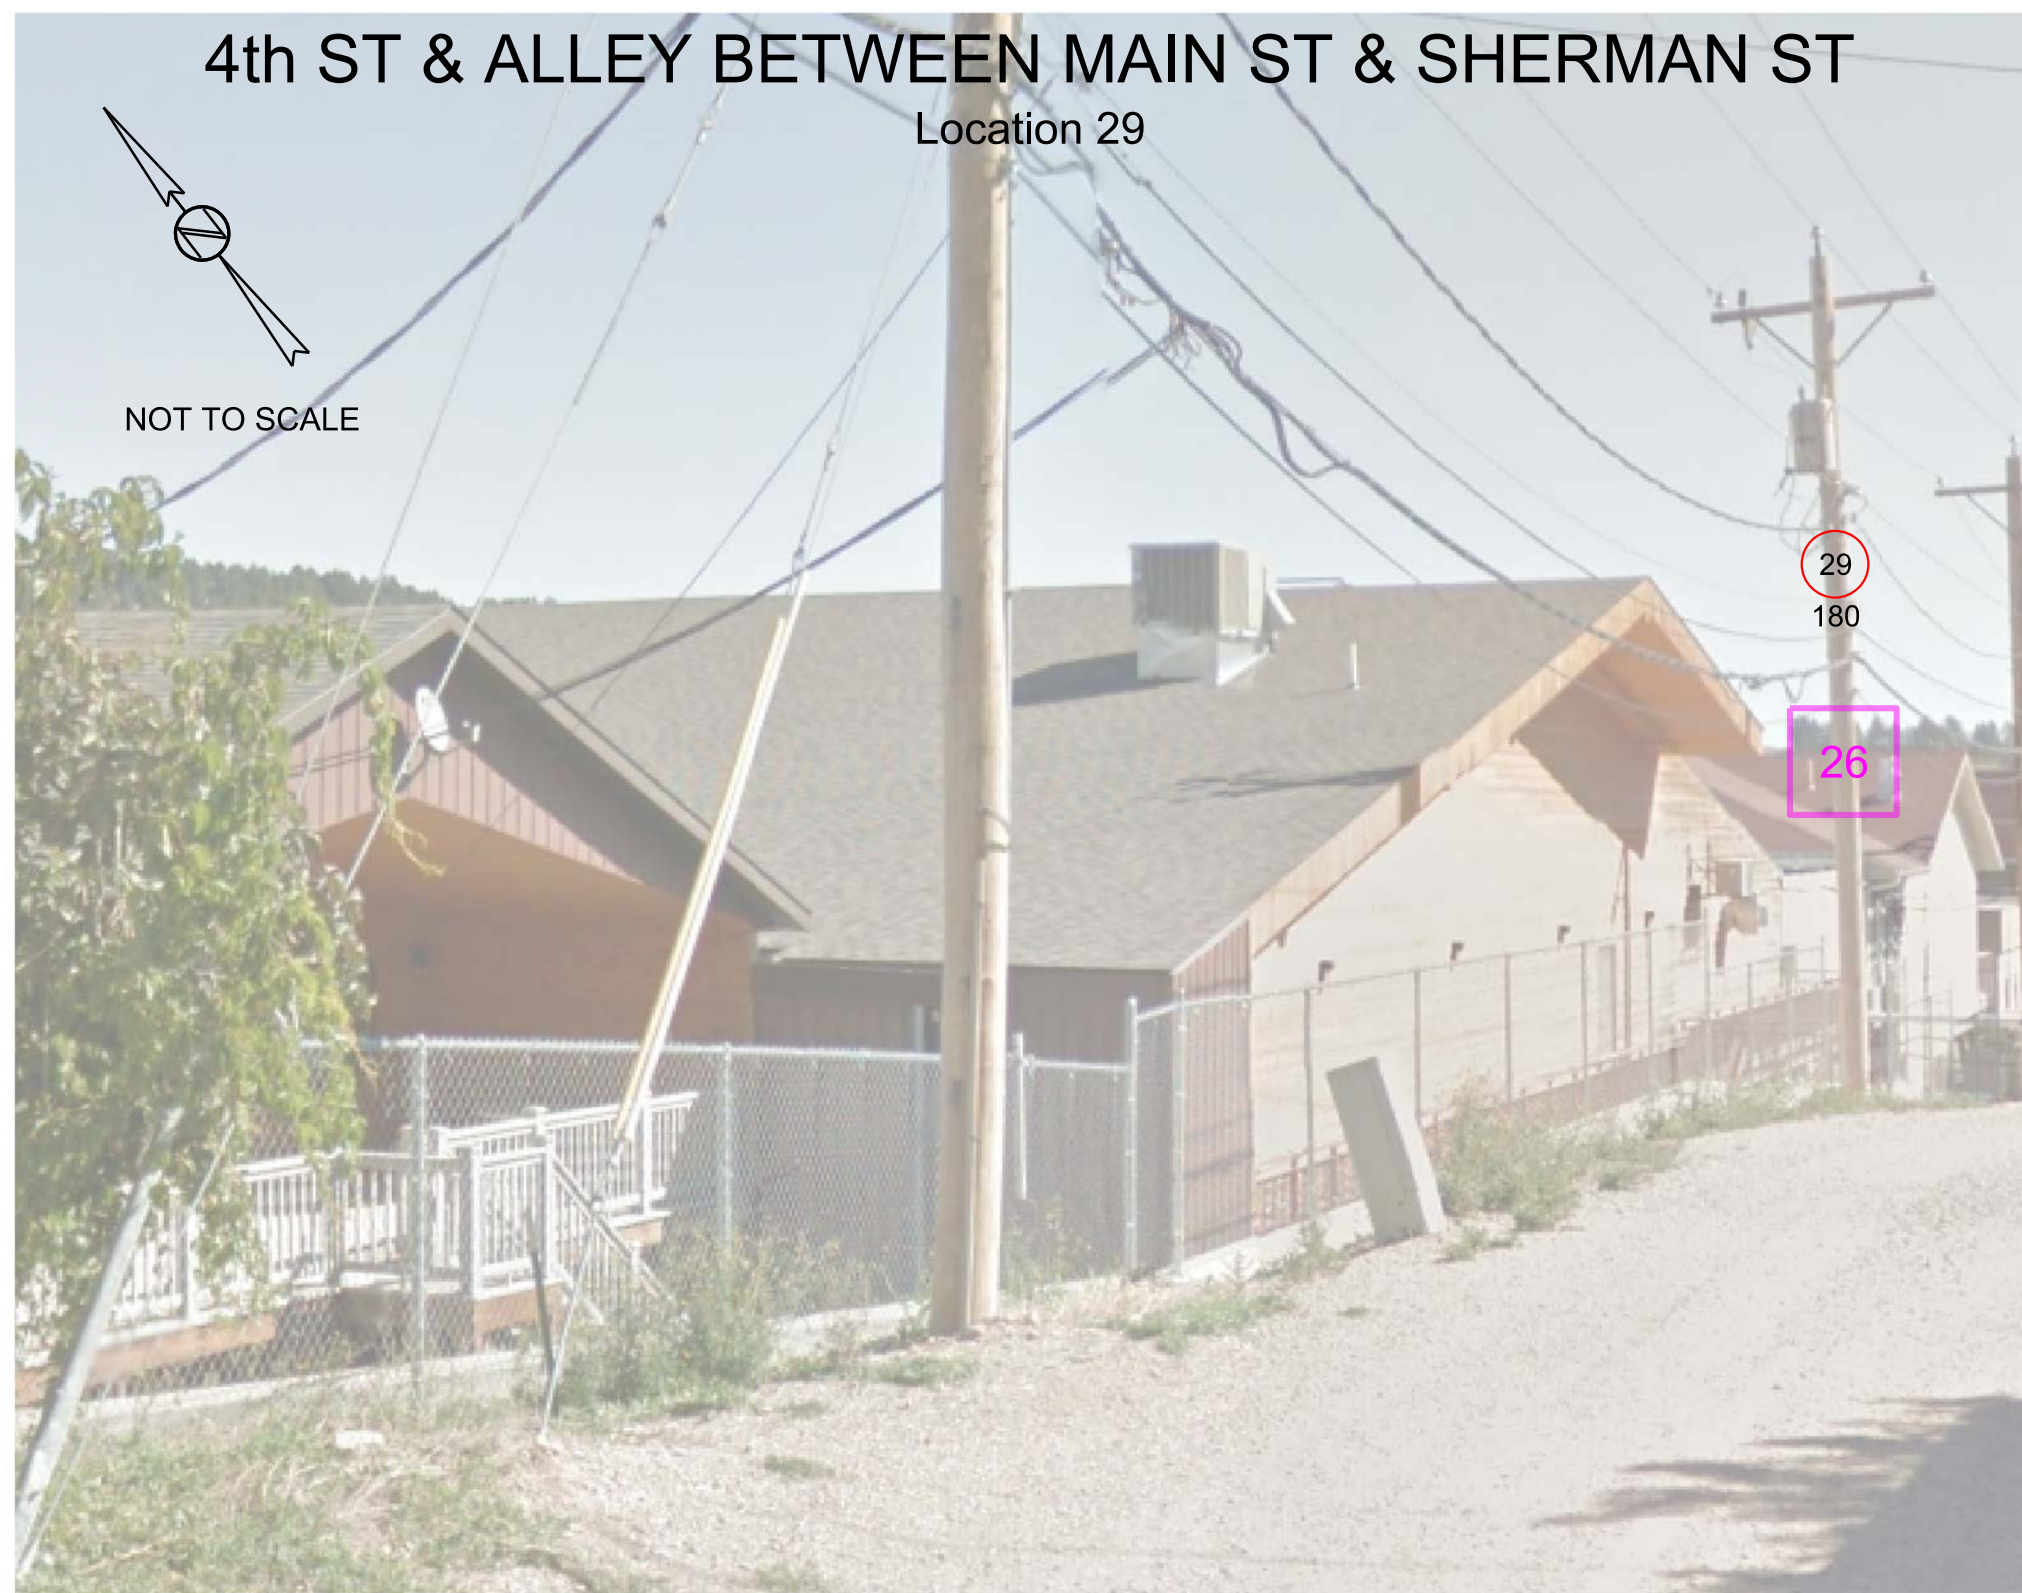



# I90/ EXIT 32 WEST BOUND & JUNCTION AVE LOCATION 30 & 31

BALLPARK ROAD 30PTZ



NOT TO SCALE

31PTZ

INTERSTATE 90

JUNCTION AVE

EXIT 32





# BALLPARK ROAD & JUNCTION AVE

Location 30











# I90/EXIT 32 EB OFF RAMP & JUNCTION AVE

Location 31

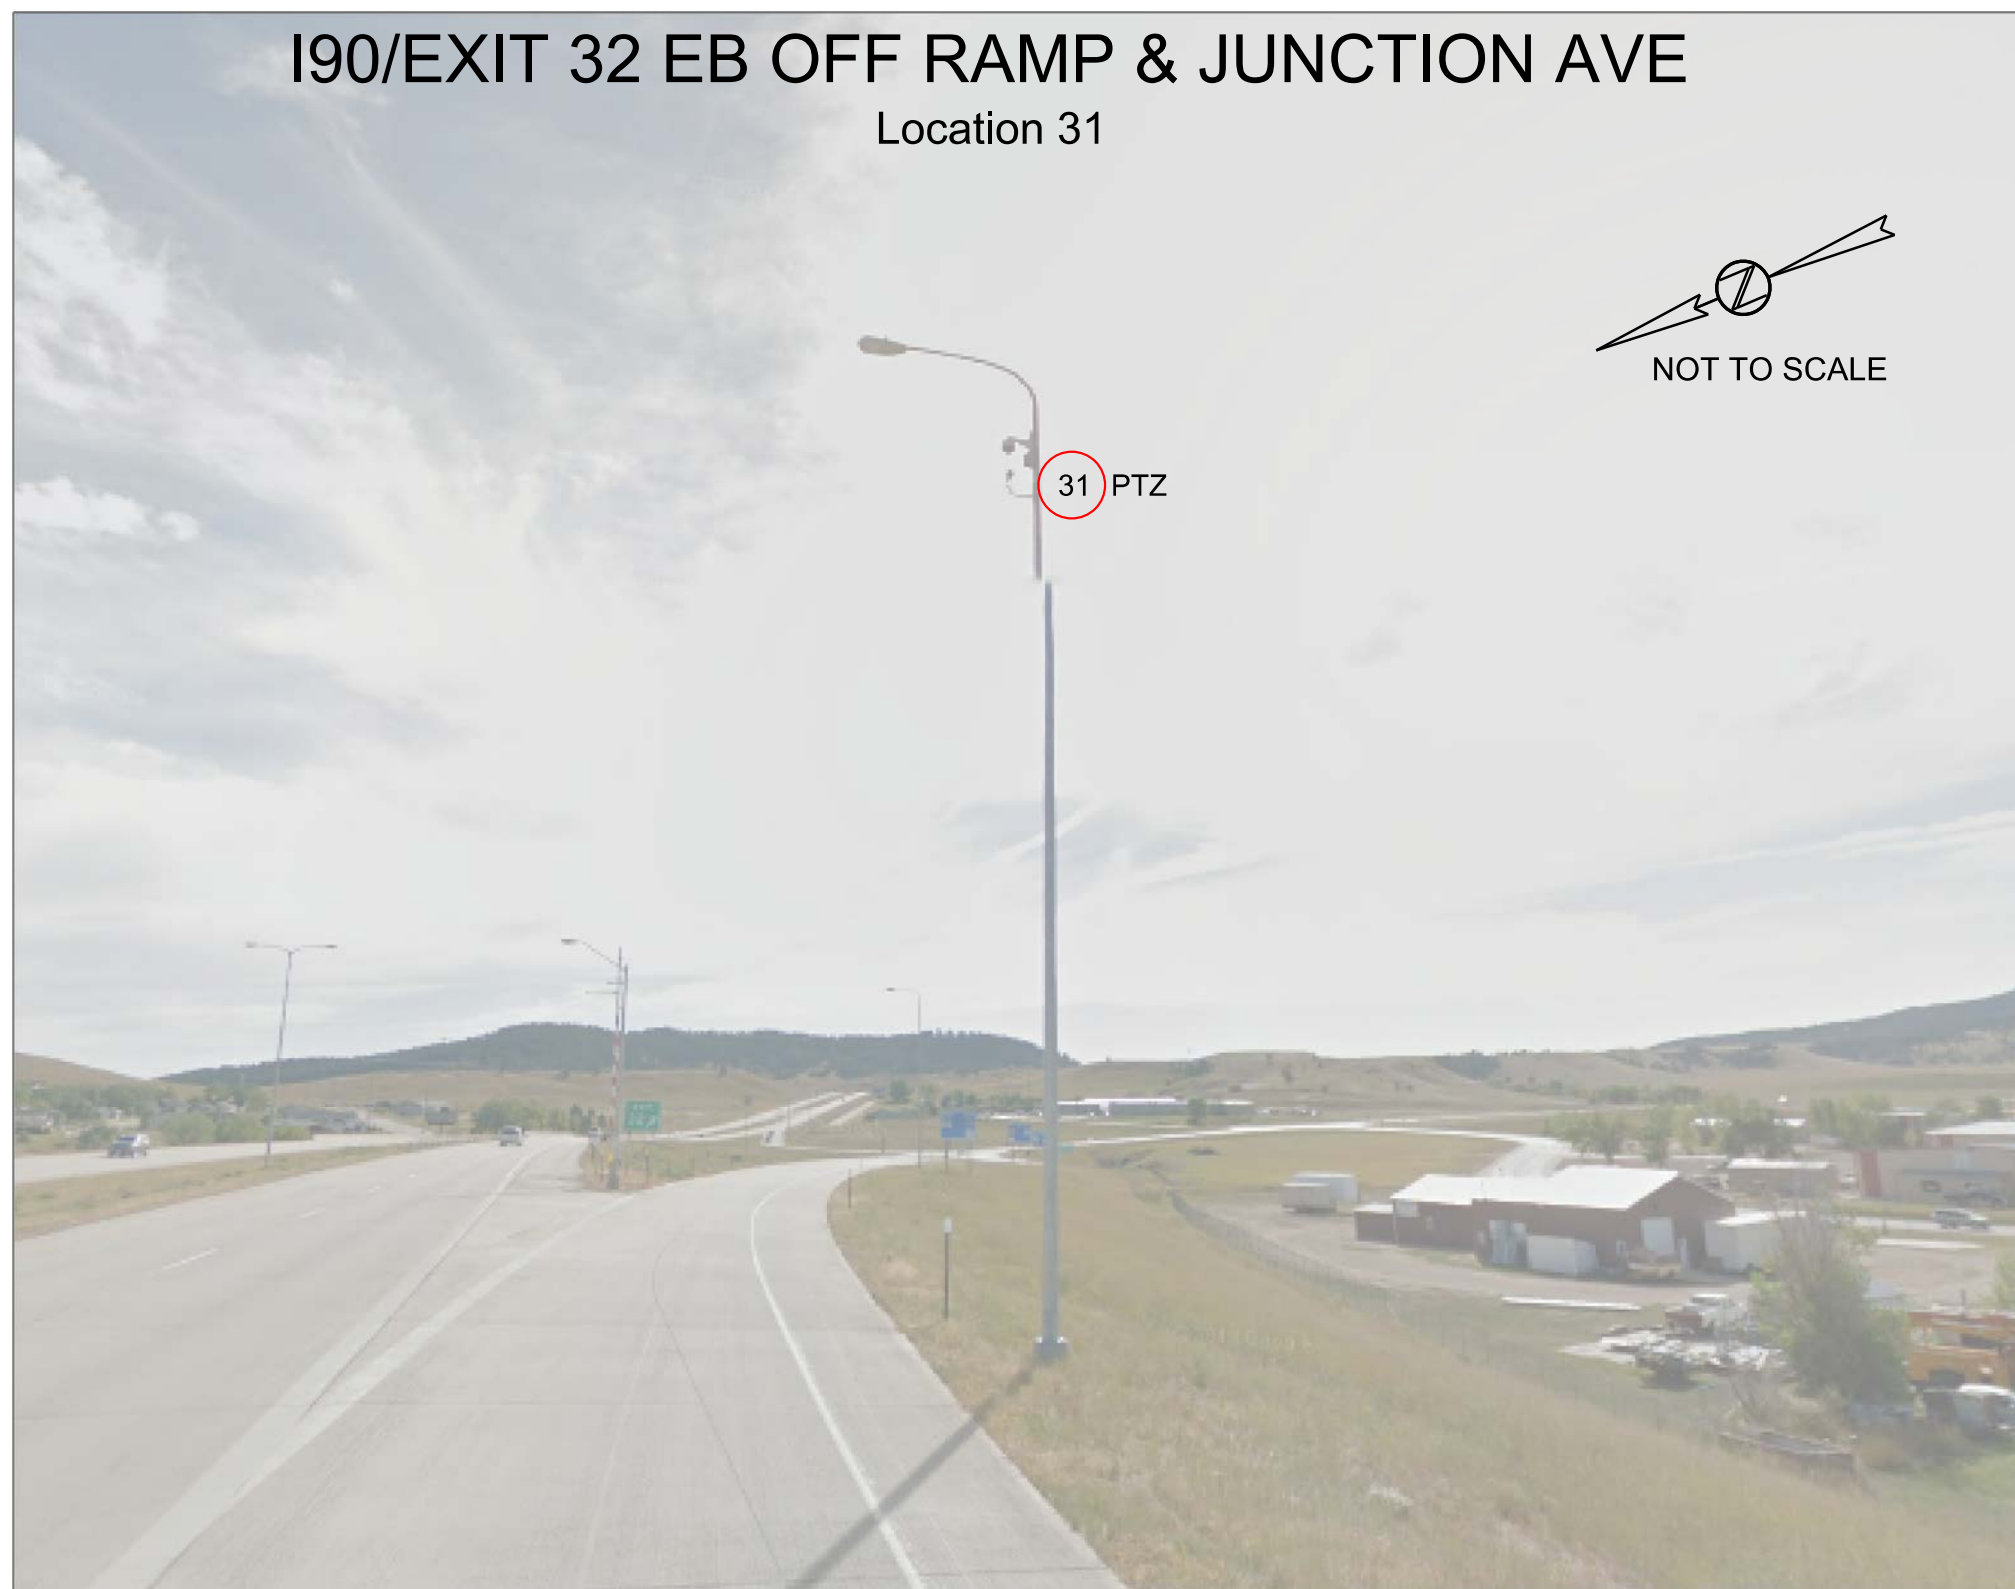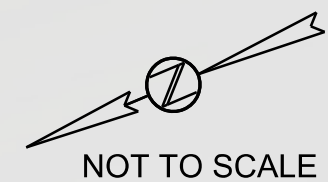



# I90/EXIT 30 EB OFF RAMP & LAZELLE ST LOCATION 32/33

33 PTZ



NOT TO SCALE

EXIT 30

LAZELLE ST

INTERSTATE 90


32 PTZ



# I90/EXIT 30 WEST BOUND & LAZELLE ST

Location 32

32 PTZ  
NOT TO SCALE

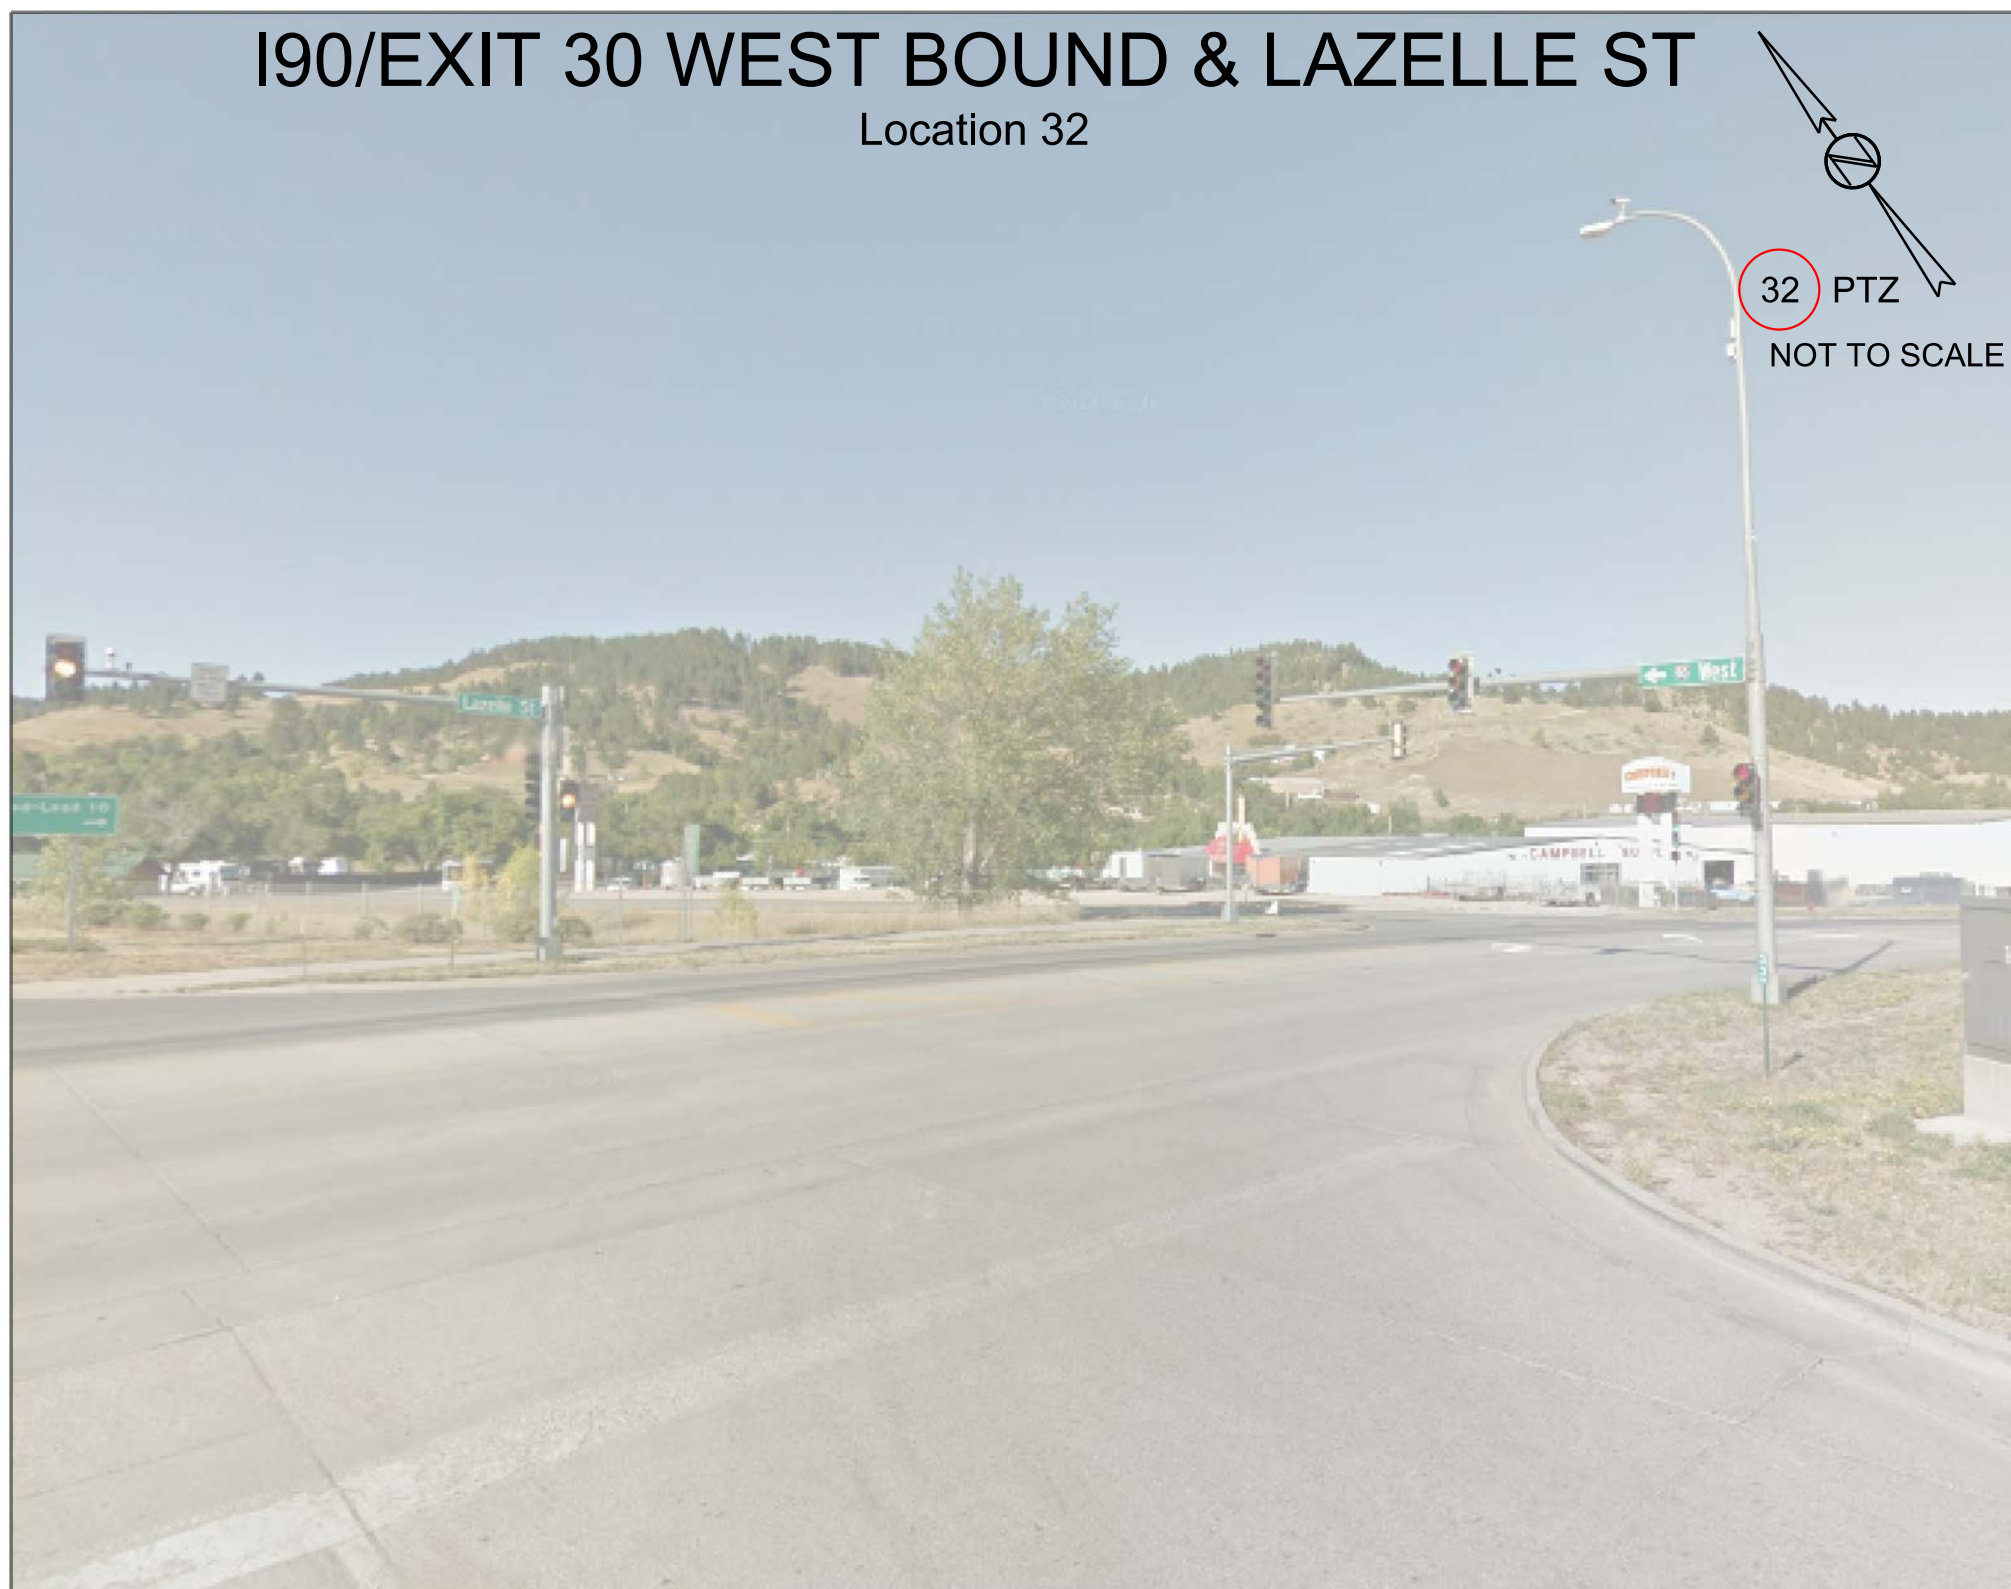



# I90/EXIT 30 EAST BOUND & LAZELLE ST

Location 33



NOT TO SCALE






# FIBER PATH

56 107



NOT TO SCALE

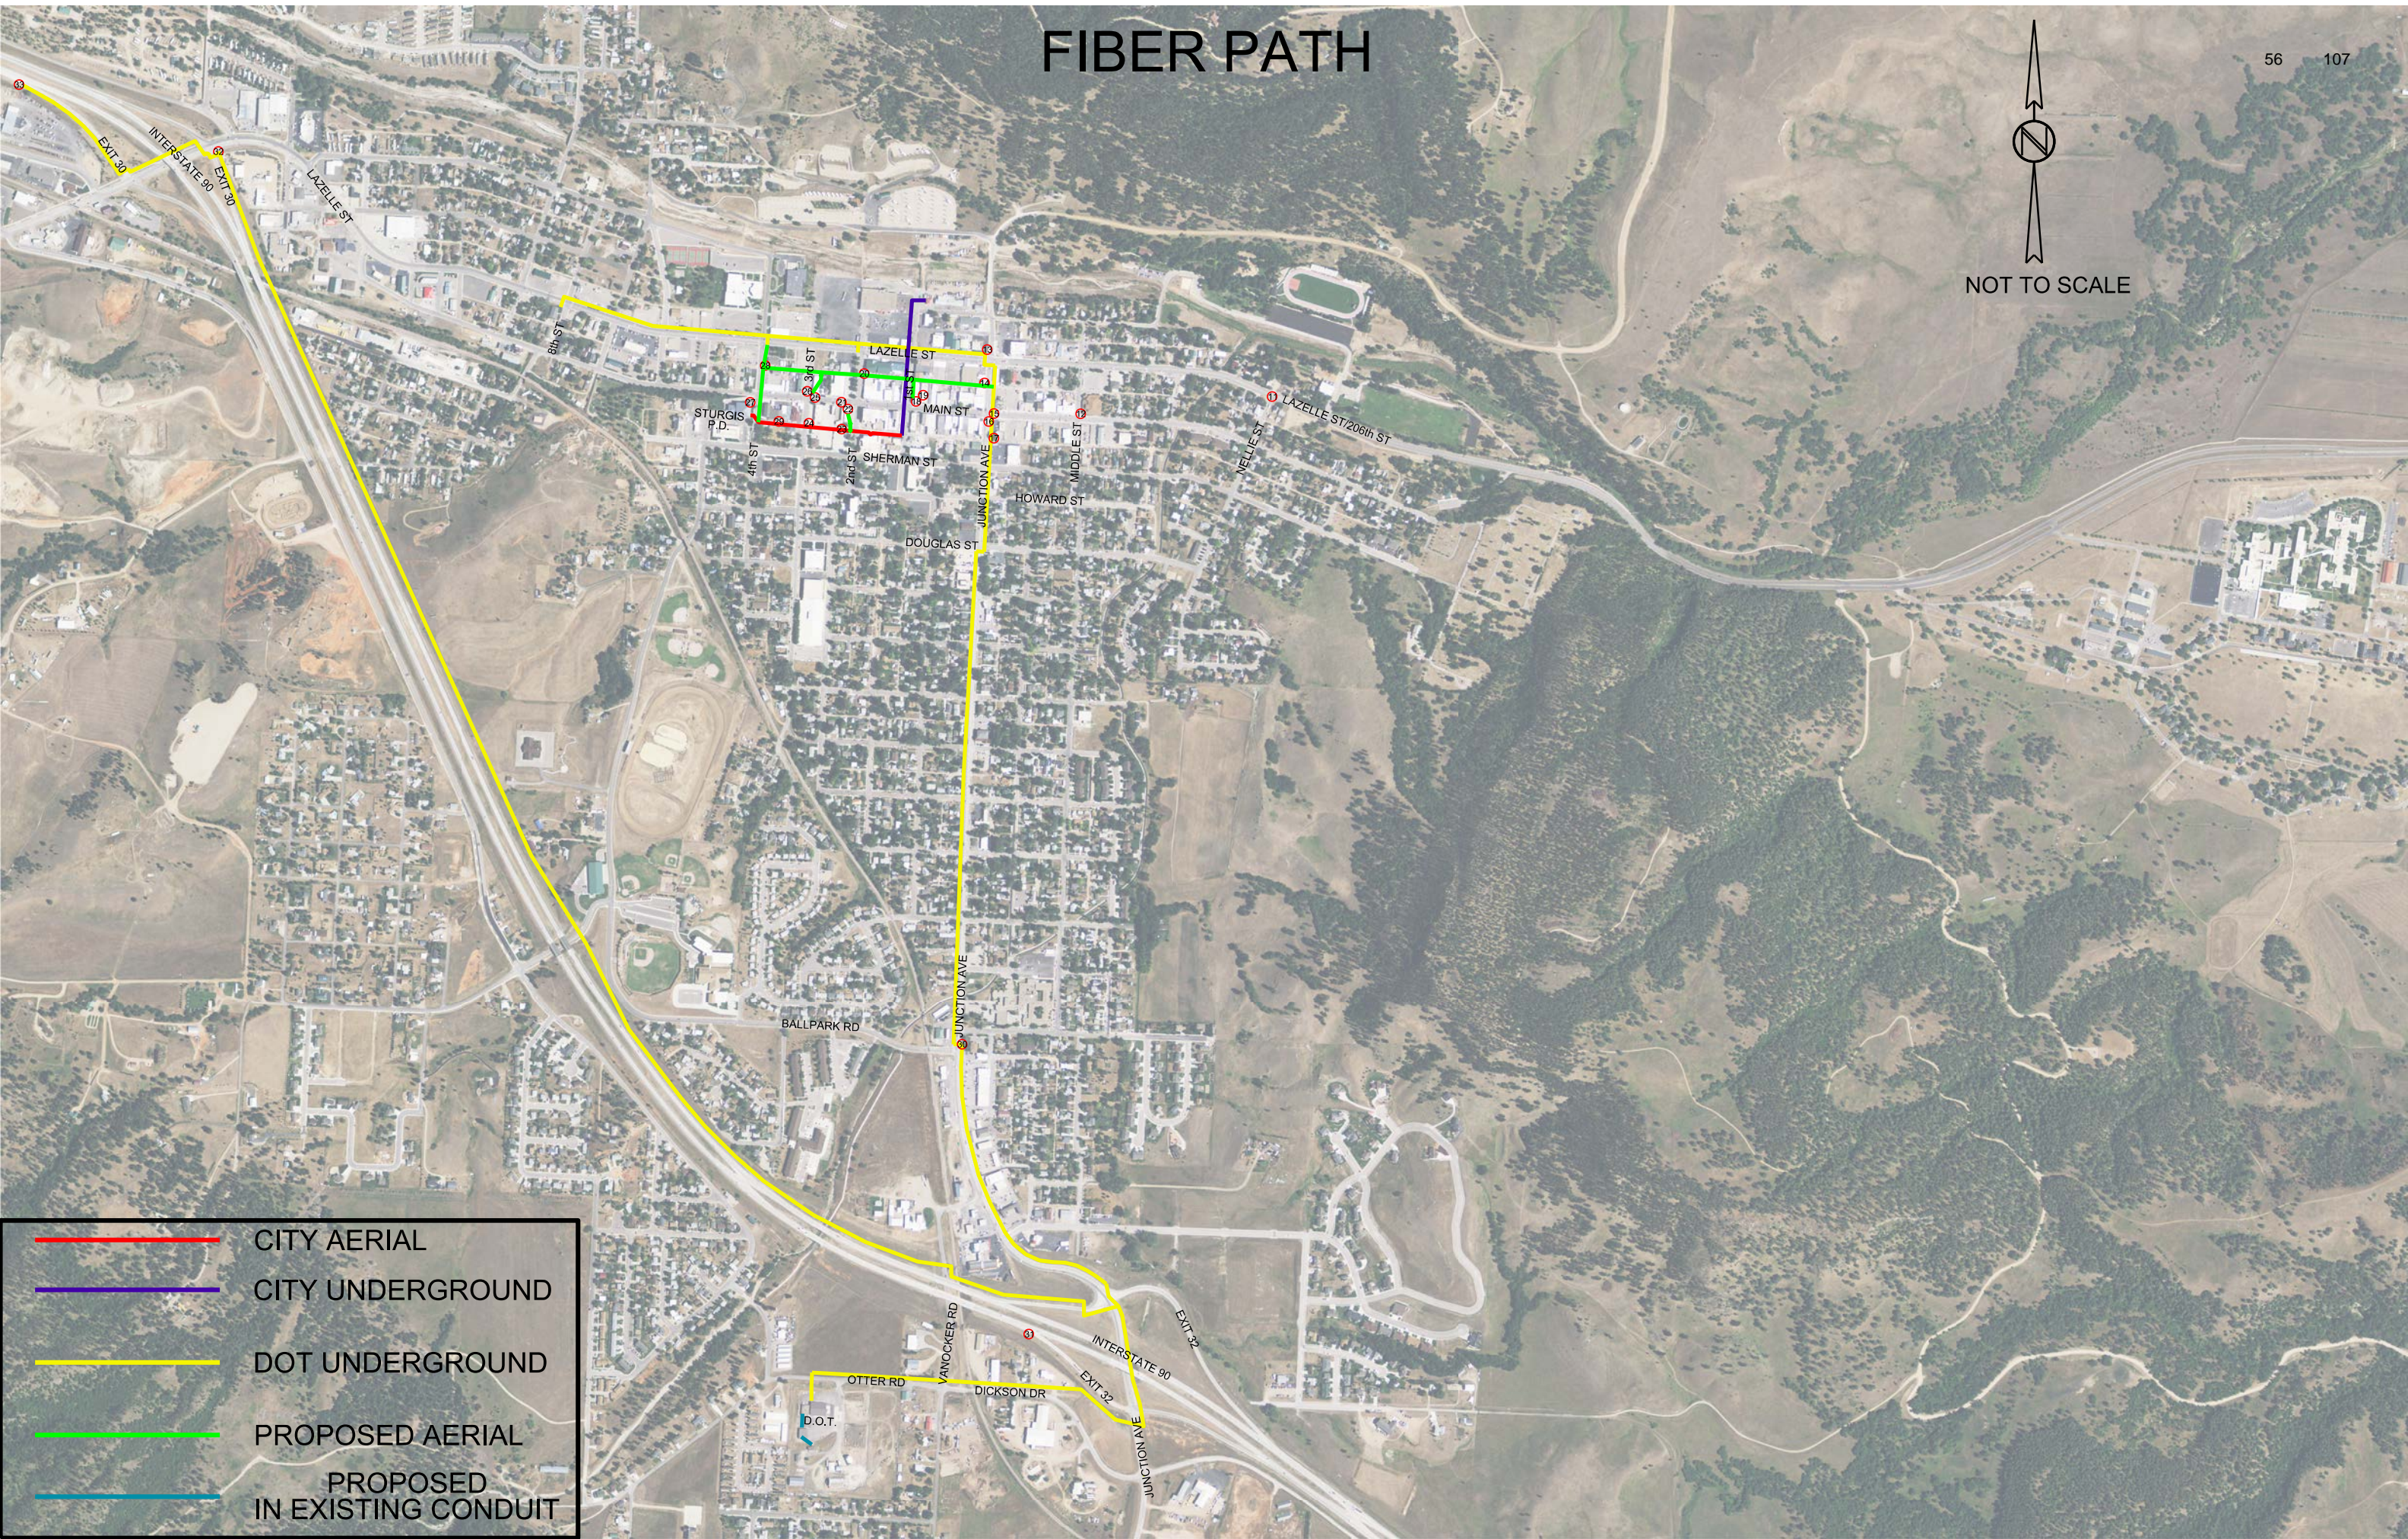

CITY AERIAL

CITY UNDERGROUND

DOT UNDERGROUND

PROPOSED AERIAL

PROPOSED  
IN EXISTING CONDUIT



Plot Scale - 1"=40'


Plotted From - trp14286

# FIBER PATH

STATE OF SOUTH DAKOTA	PROJECT	SHEET	TOTAL SHEETS
	P 034-451	57	107

Plotting Date: 04/02/2014

NOT TO SCALE

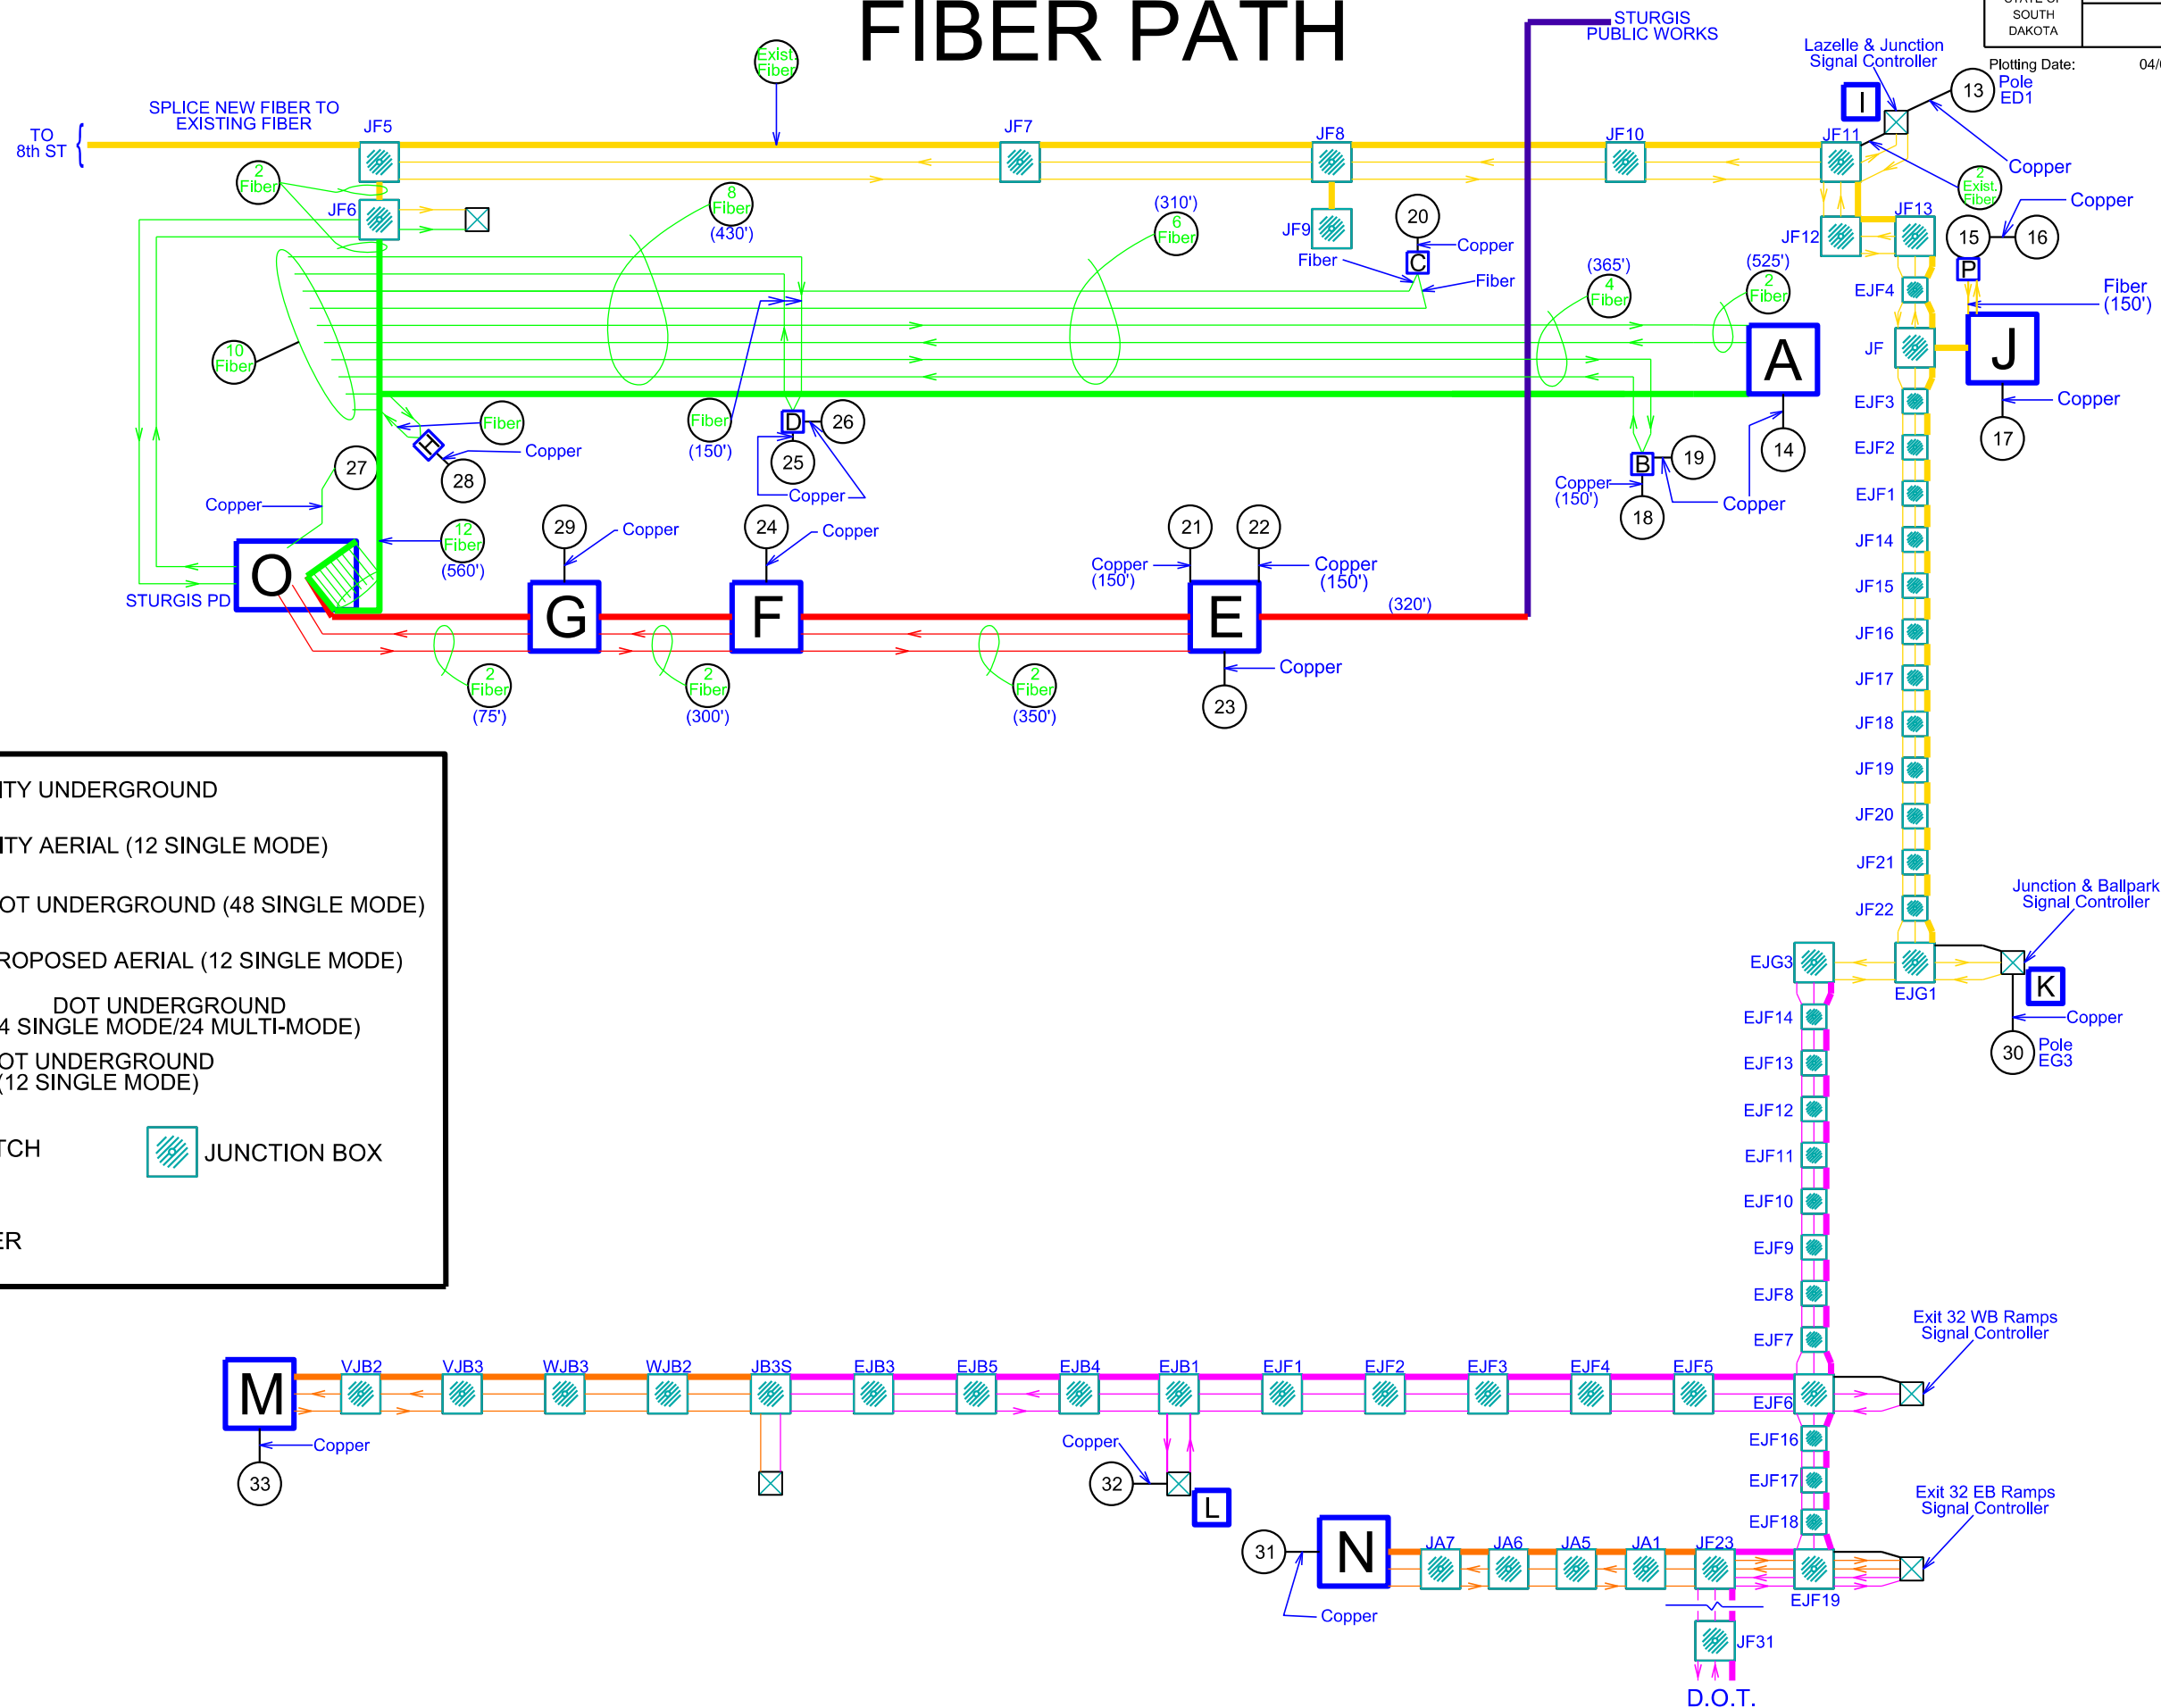

- CITY UNDERGROUND
- CITY AERIAL (12 SINGLE MODE)
- DOT UNDERGROUND (48 SINGLE MODE)
- PROPOSED AERIAL (12 SINGLE MODE)
- DOT UNDERGROUND (24 SINGLE MODE/24 MULTI-MODE)
- DOT UNDERGROUND (12 SINGLE MODE)
- FIBER SWITCH
- JUNCTION BOX
- CONTROLLER





FIBER PATH  
(LOCATIONS 13-29)

58 107



NOT TO SCALE

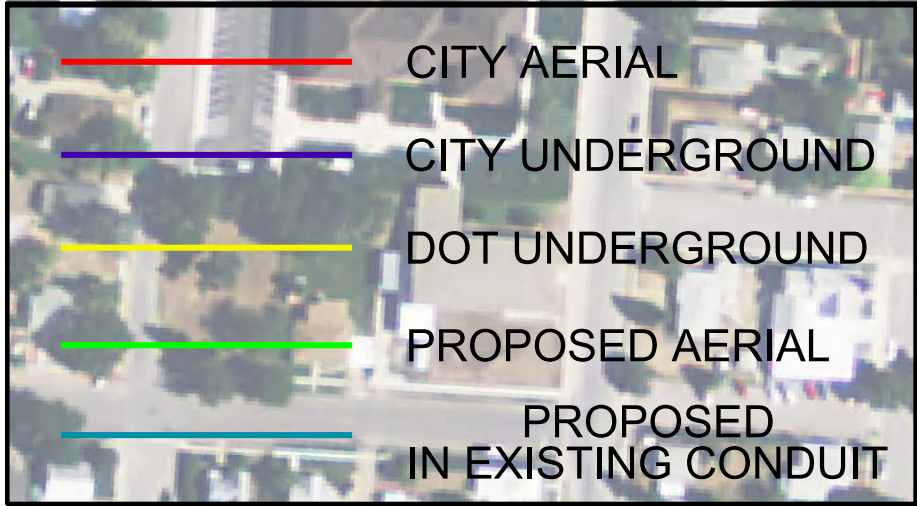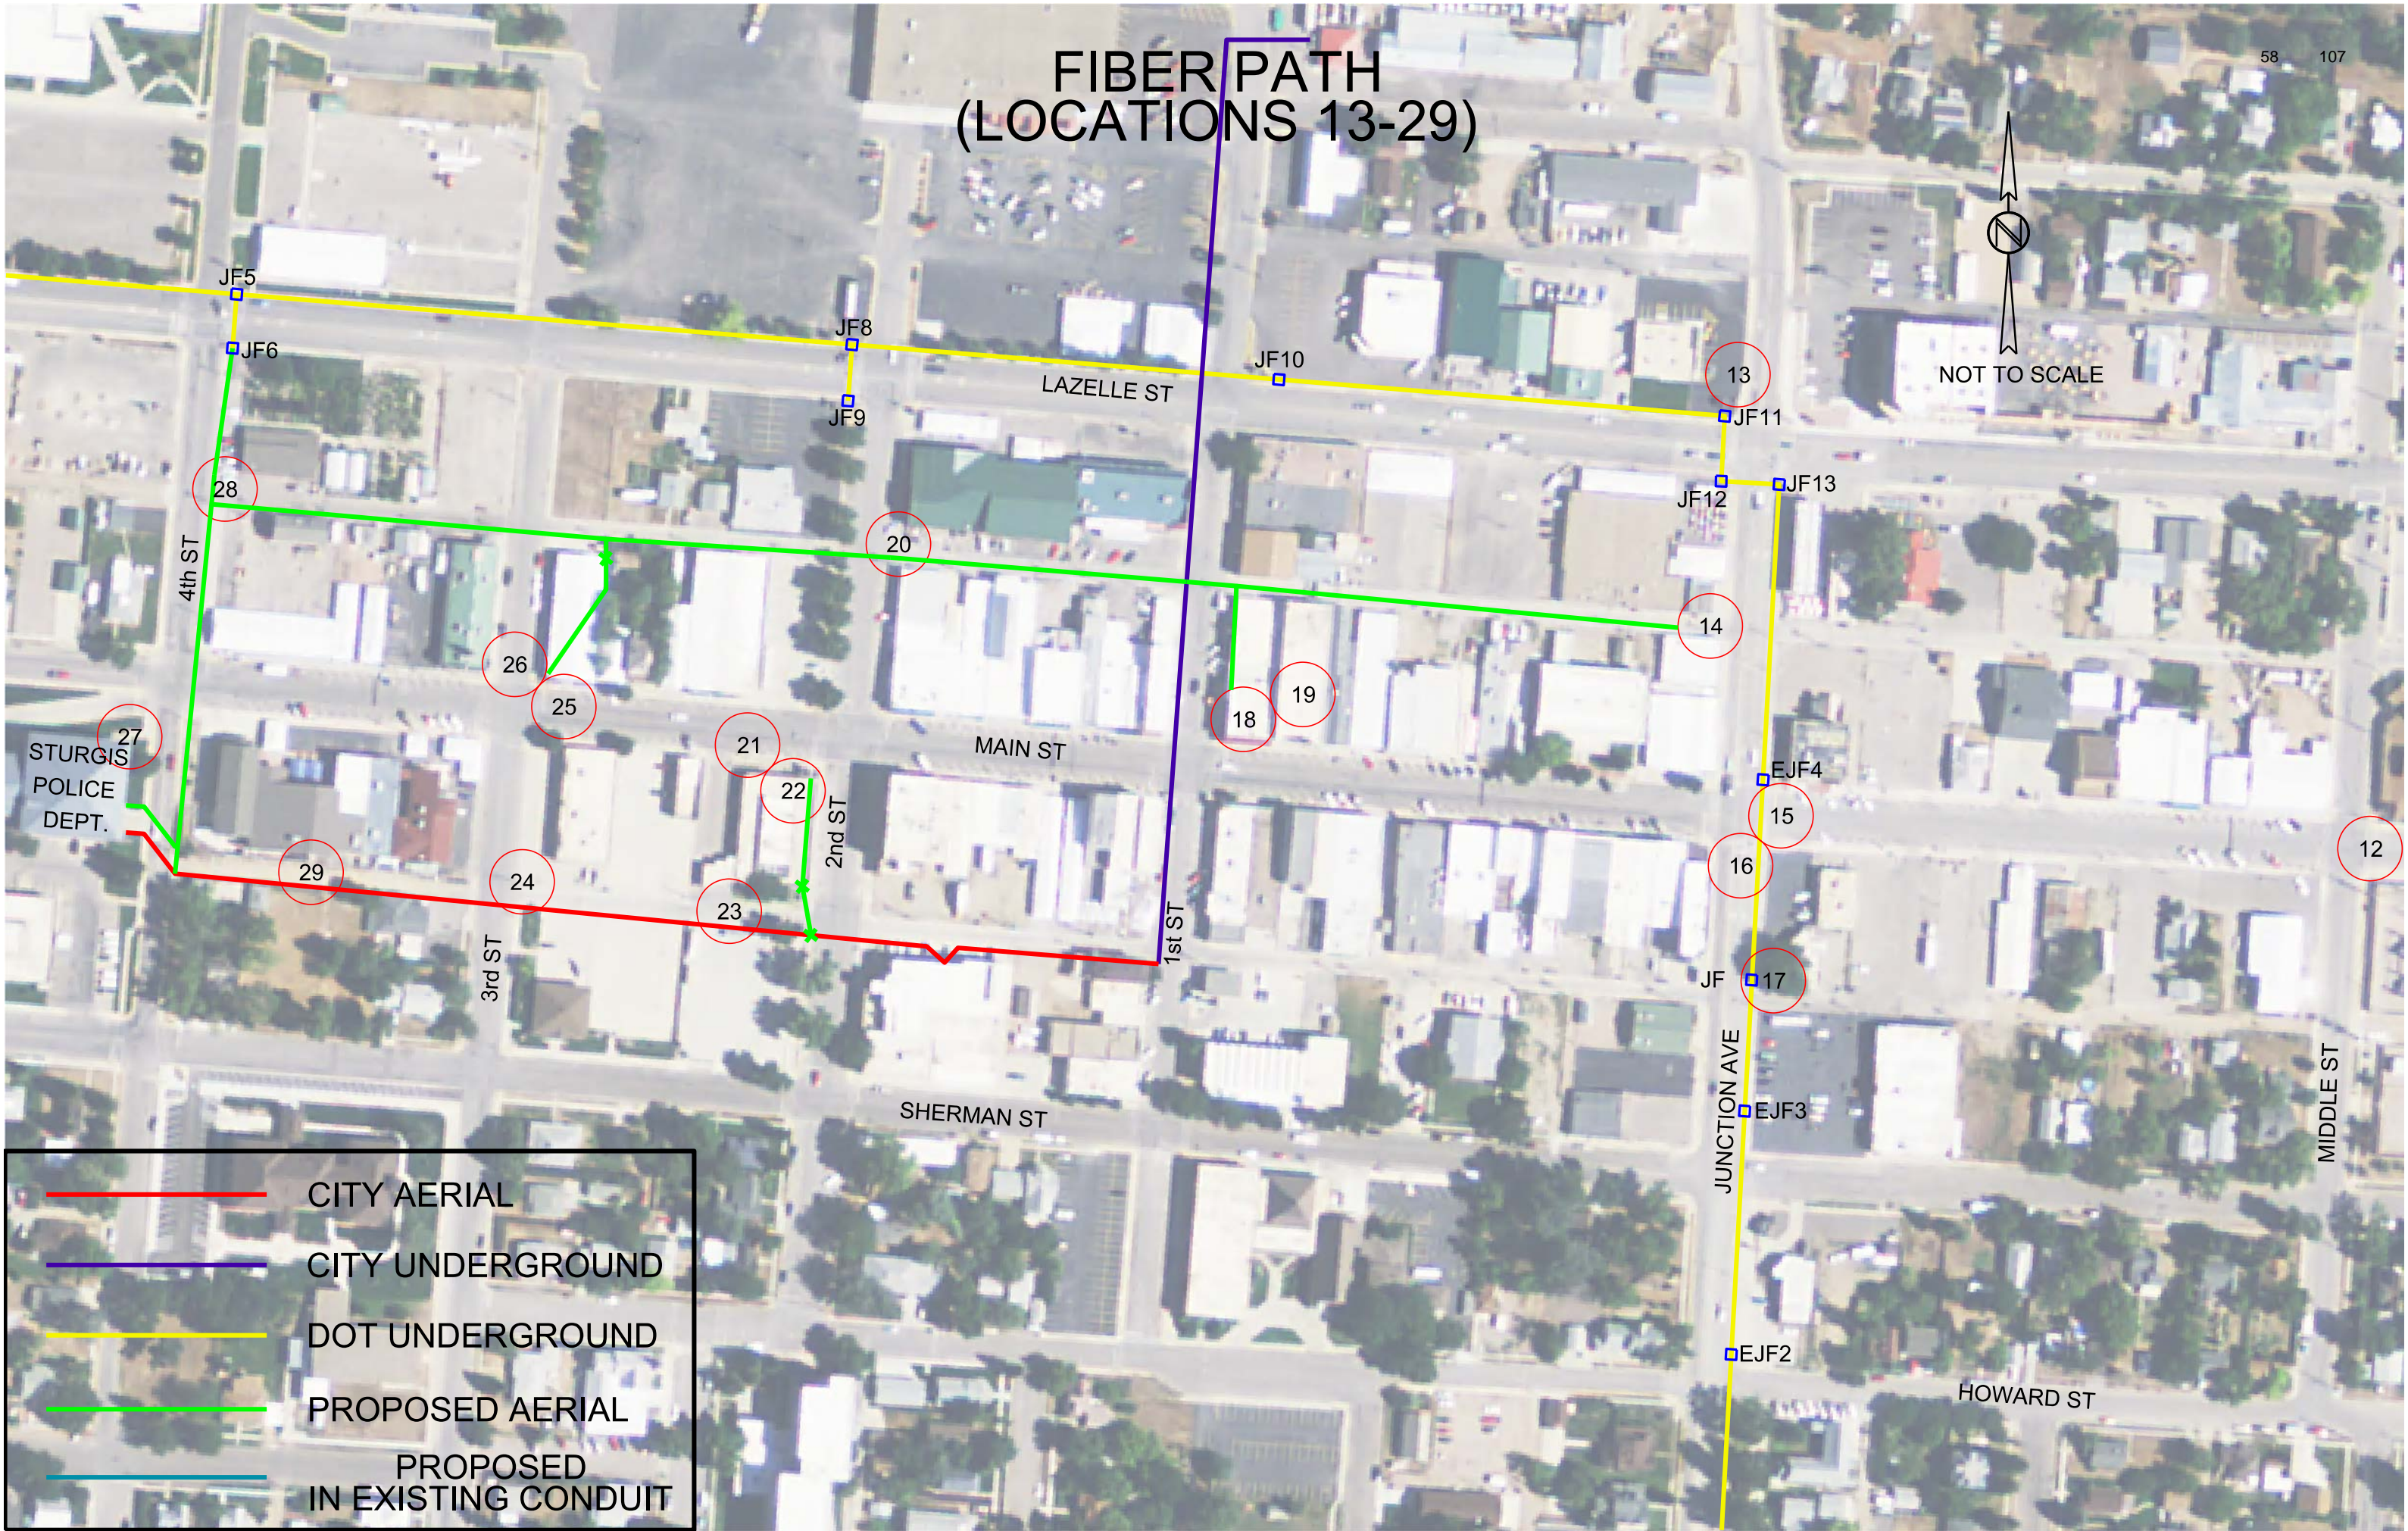



# FIBER PATH (DOUGLAS STREET)



NOT TO SCALE

DOUGLAS STREET

JUNCTION AVE



# FIBER PATH (BALLPARK RD - LOCATION 30)

60 107



NOT TO SCALE

JUNCTION AVE

BALLPARK RD

30





FIBER PATH  
(LOCATION 31)



NOT TO SCALE

31

INTERSTATE 90

EXIT 32

EXIT 32

JUNCTION AVE

DICKSON DR

CITY AERIAL

CITY UNDERGROUND

DOT UNDERGROUND

PROPOSED AERIAL





# FIBER PATH (VANOCKER RD)

BEST WESTERN

JUNCTION AVE

INTERSTATE 90

VANOCKER RD

OTTER RD

D.O.T.

62 107



NOT TO SCALE


31

- CITY AERIAL
- CITY UNDERGROUND
- DOT UNDERGROUND
- PROPOSED AERIAL








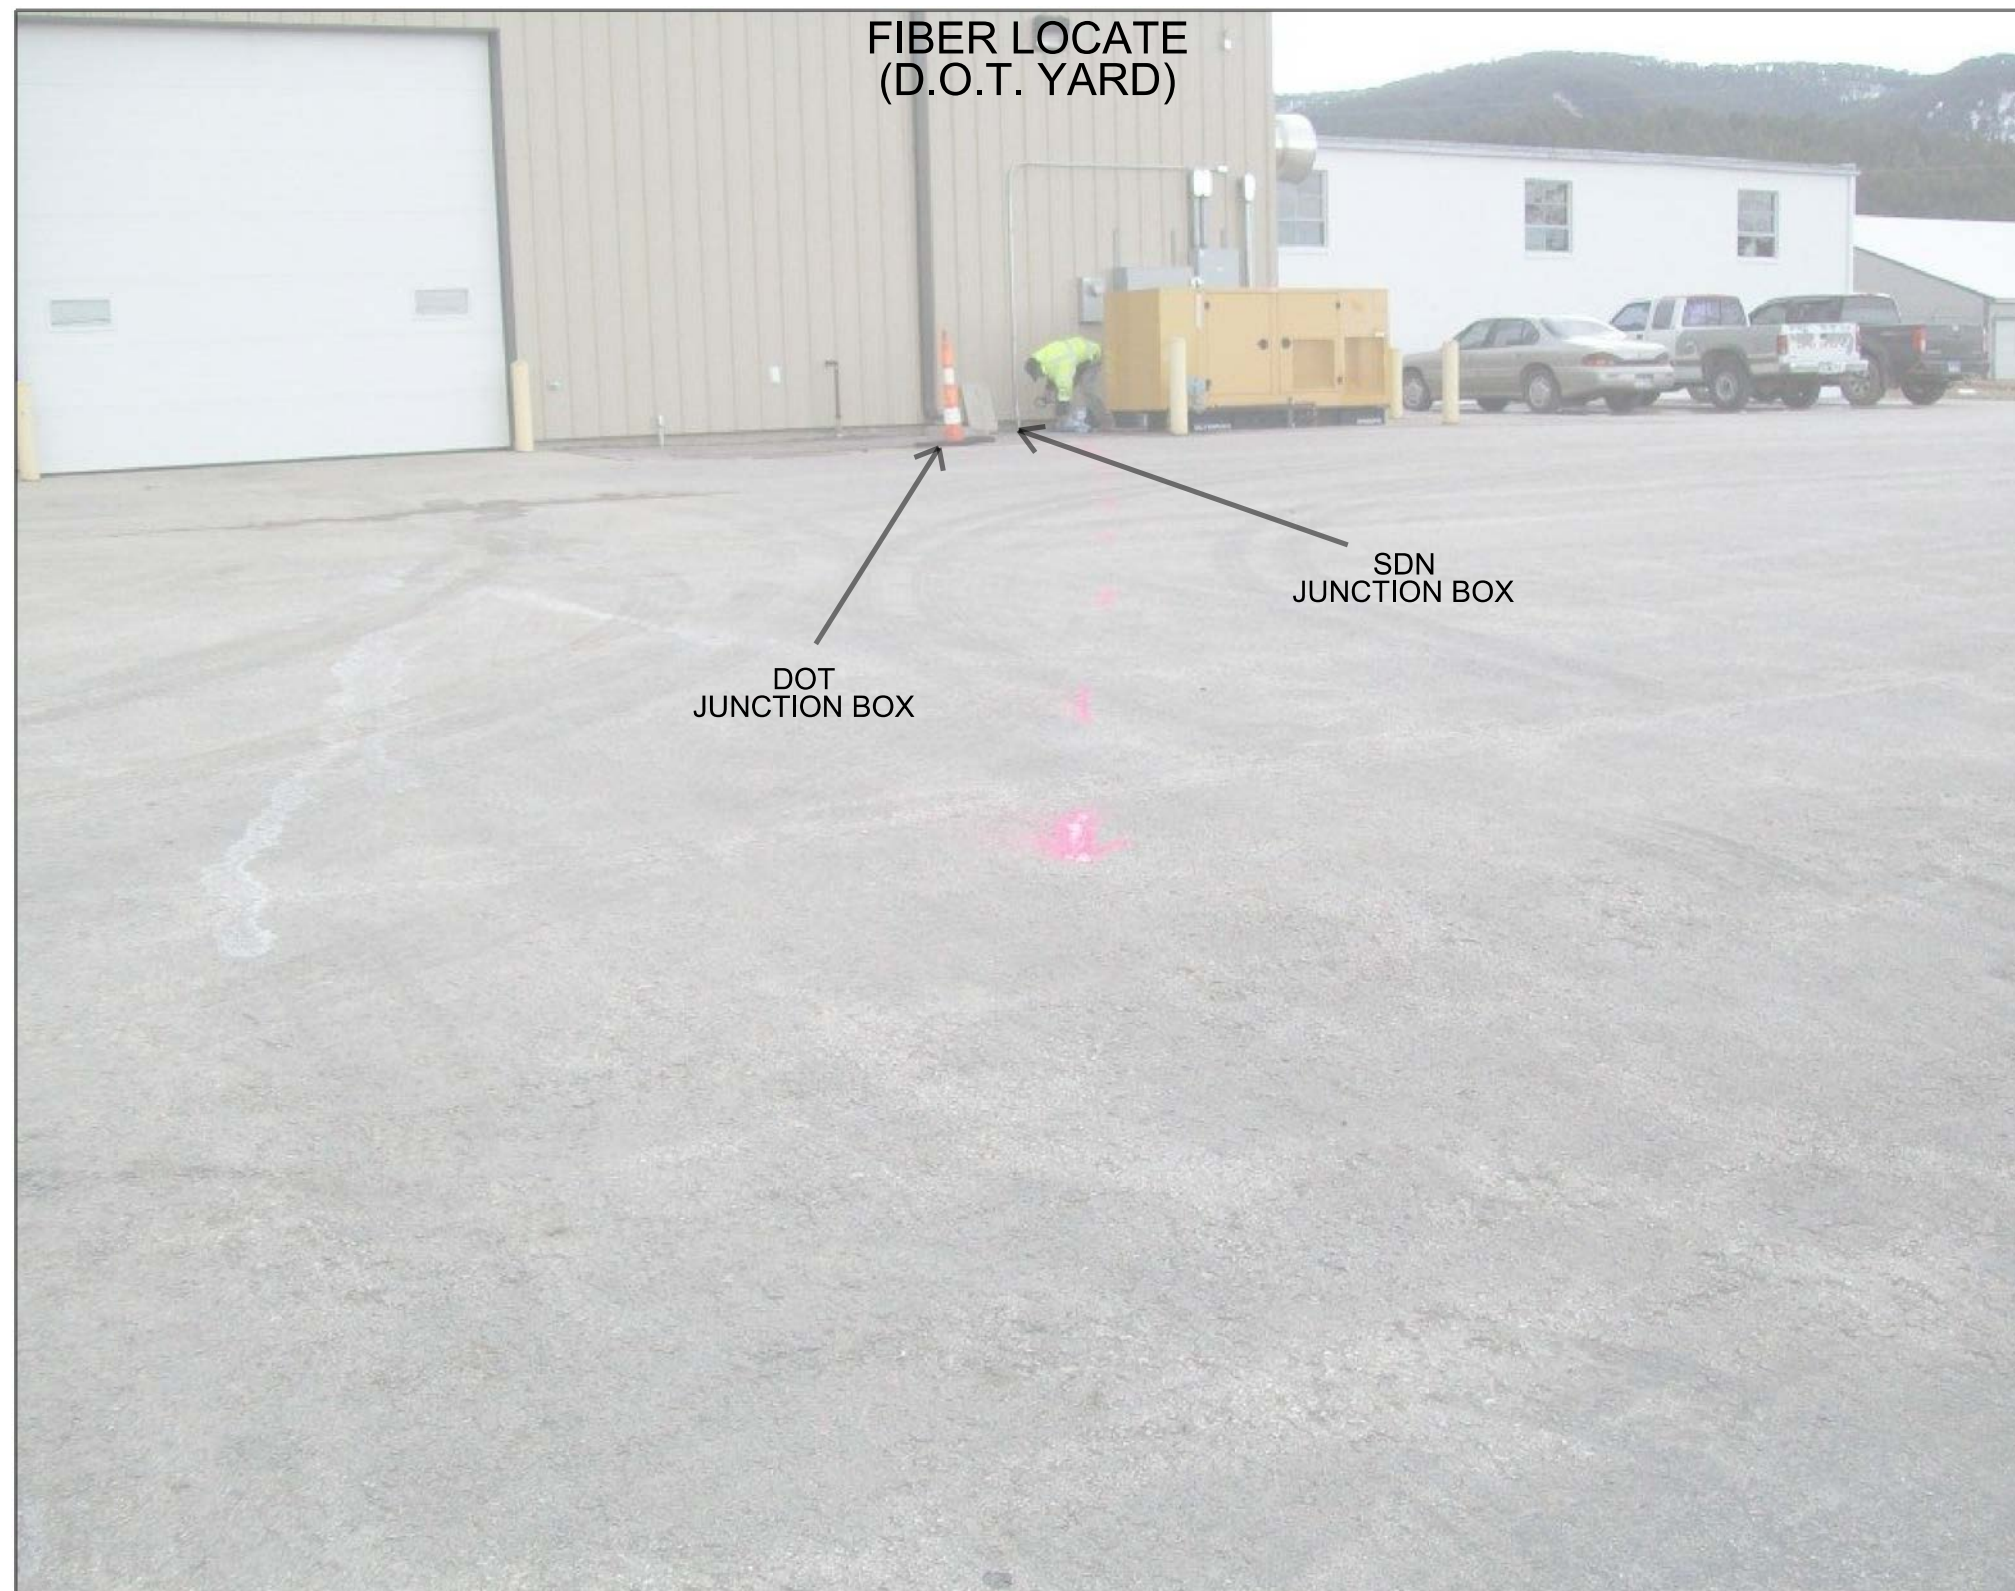



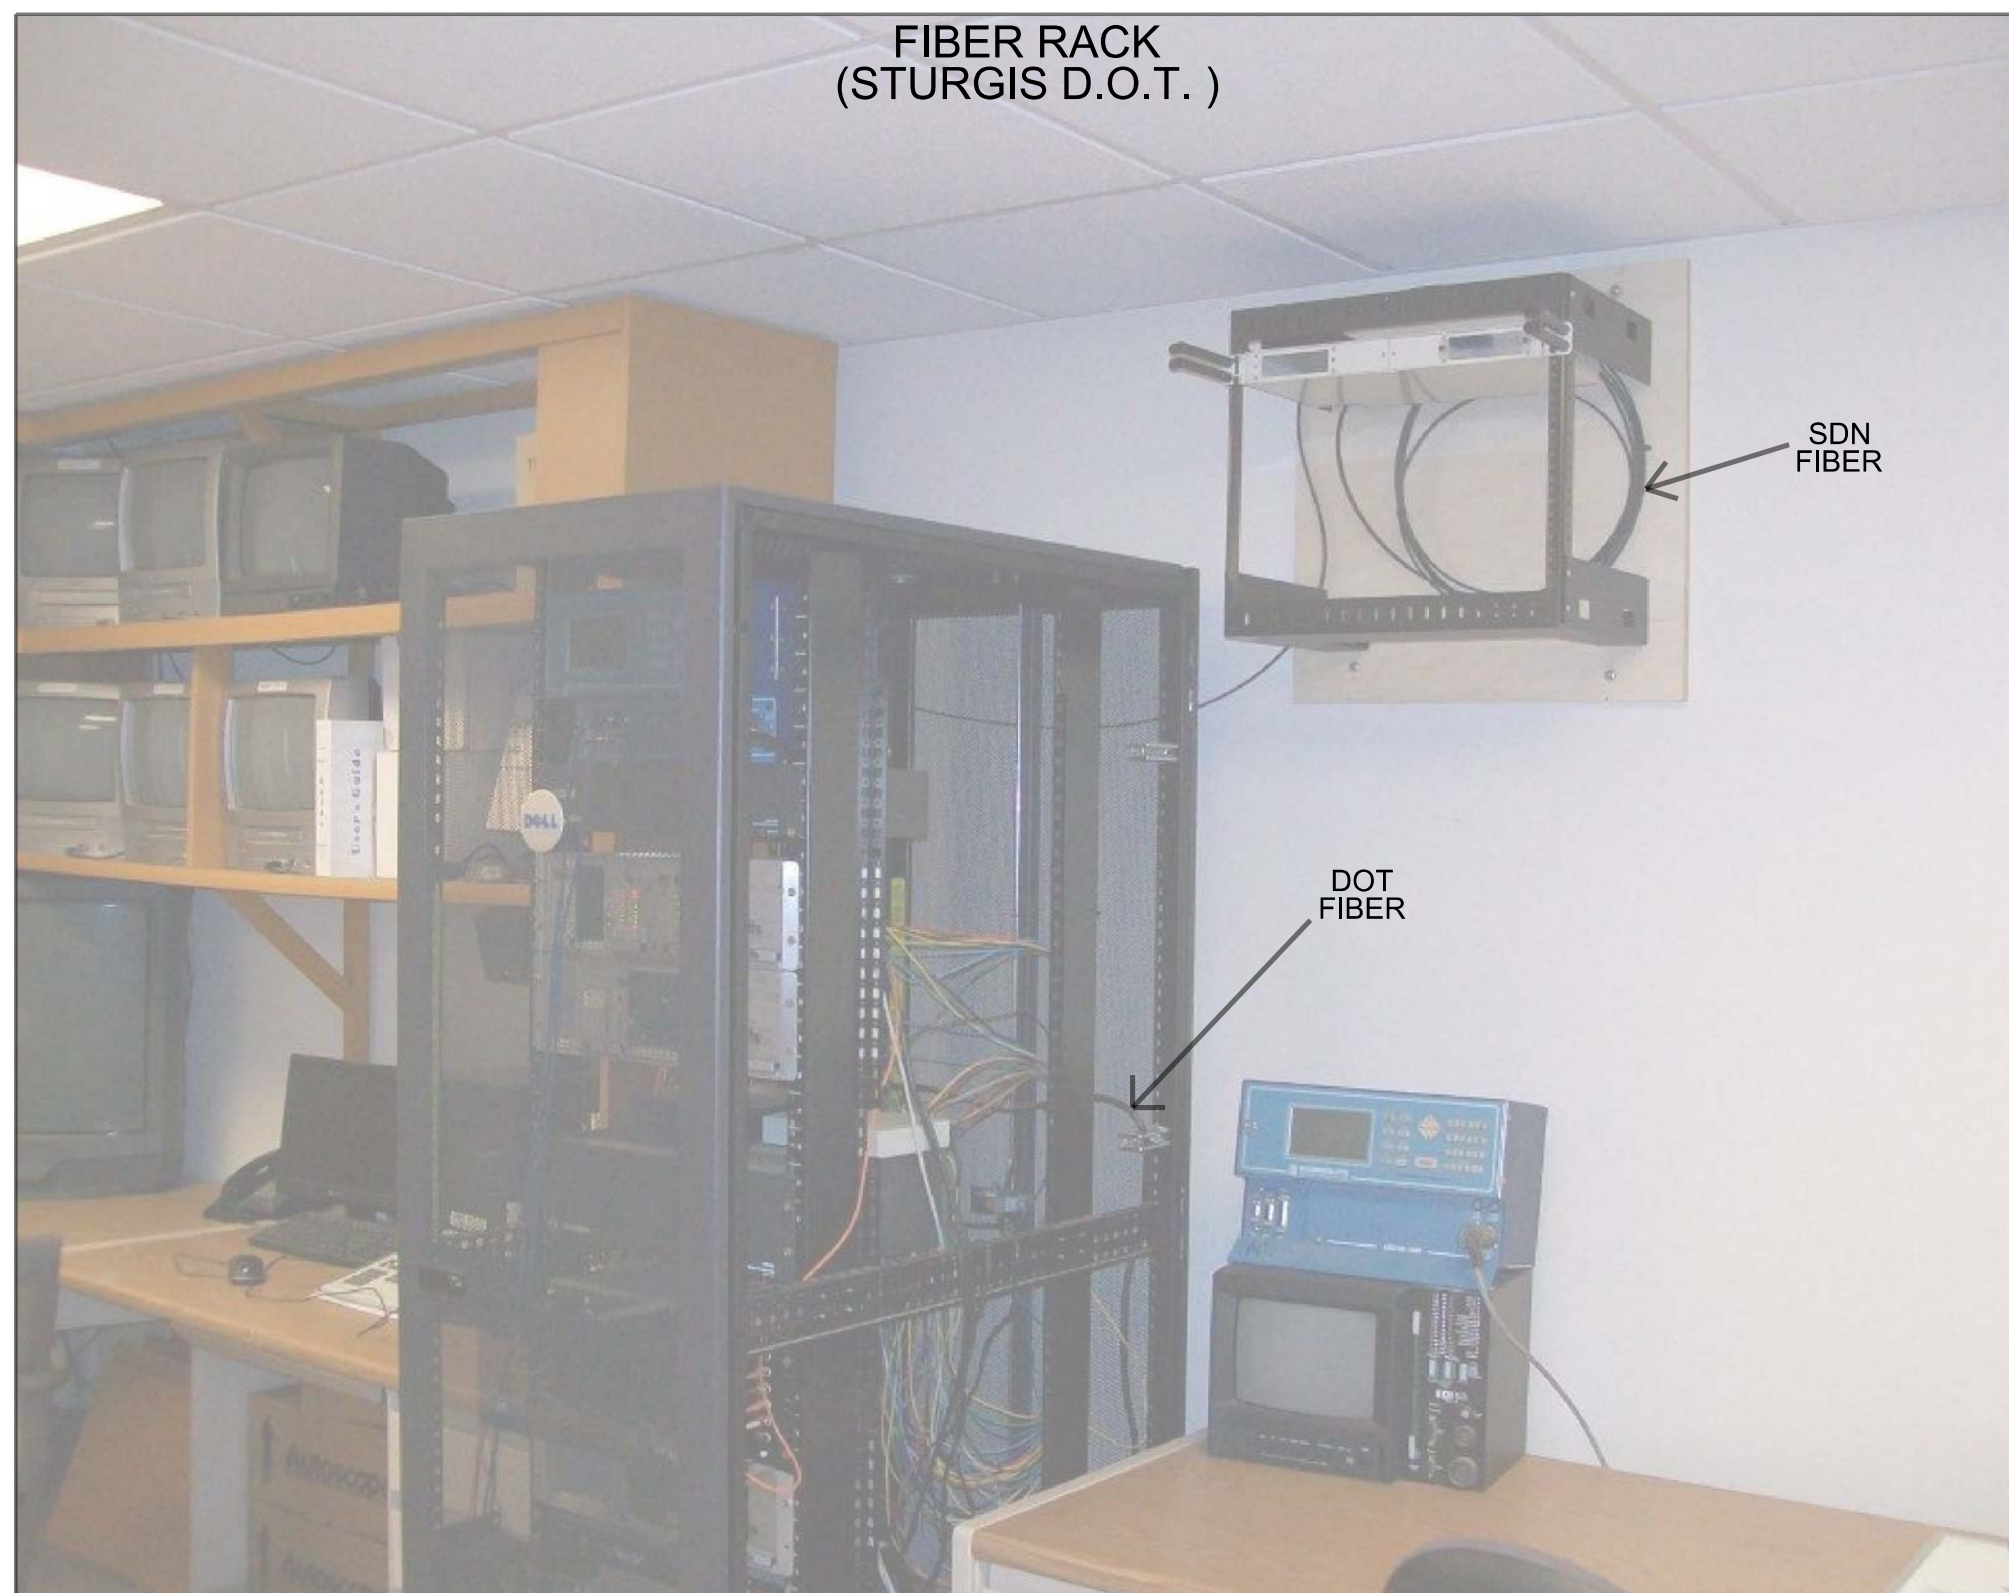



FIBER PATH  
(LOCATIONS 32-33)



NOT TO SCALE



CITY AERIAL

CITY UNDERGROUND

DOT UNDERGROUND

PROPOSED AERIAL

33

32


EXIT 30

INTERSTATE 90

LAZELLE ST

EXIT 30



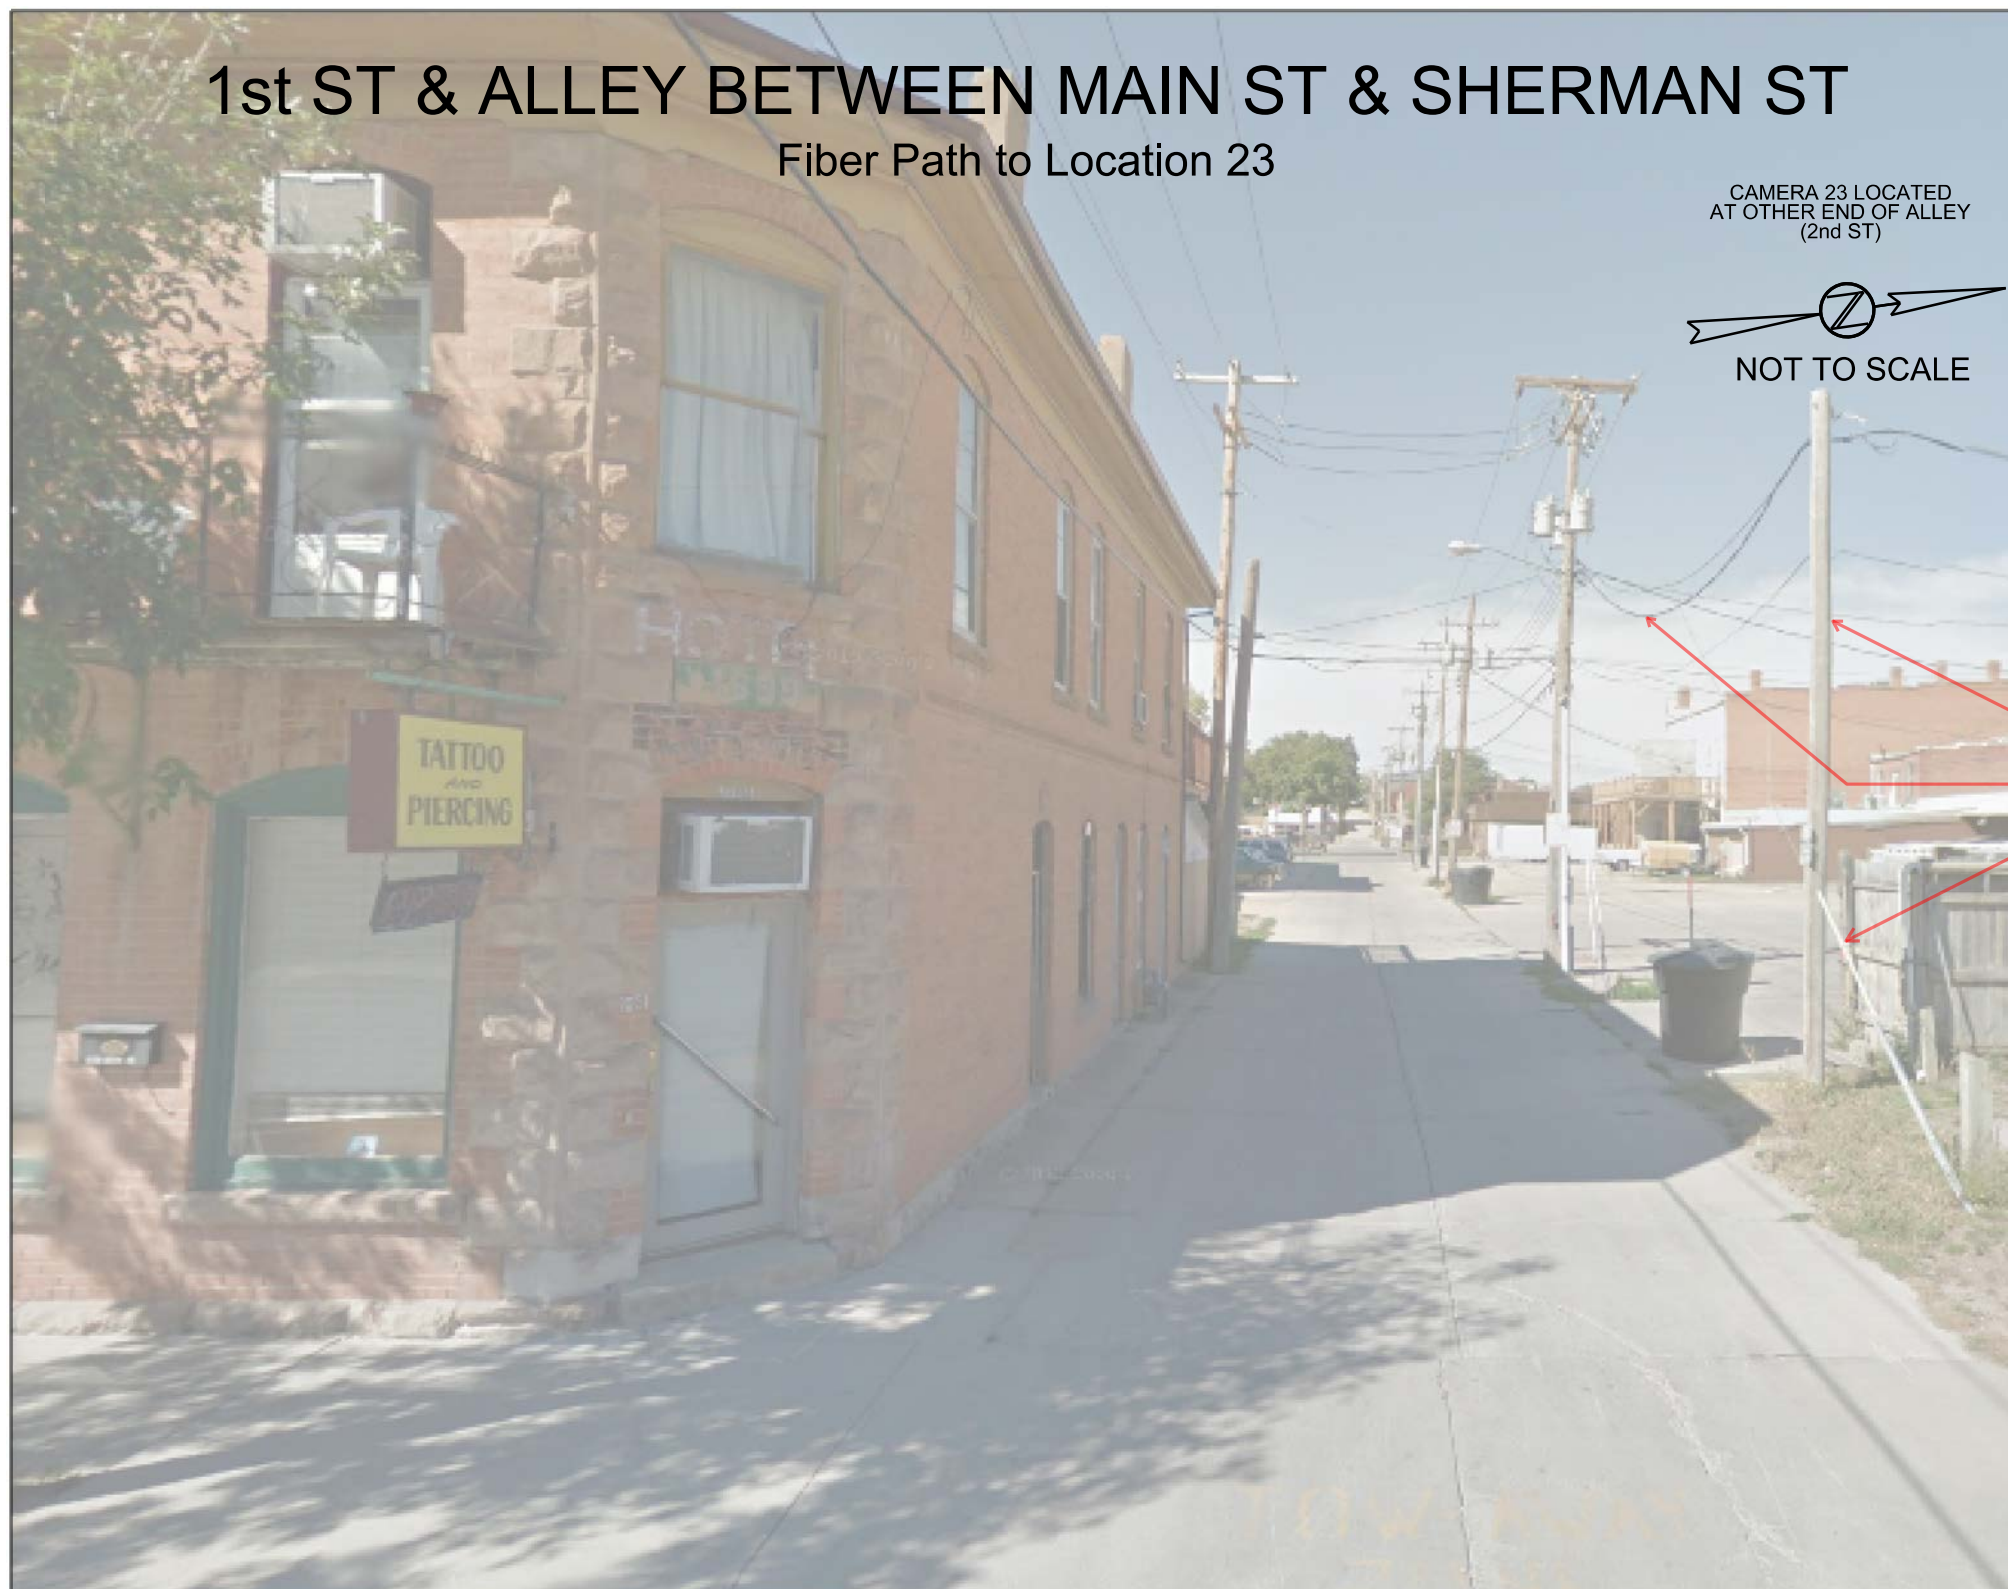

# 1st ST & ALLEY BETWEEN MAIN ST & SHERMAN ST

Fiber Path to Location 23


CAMERA 23 LOCATED  
AT OTHER END OF ALLEY  
(2nd ST)



NOT TO SCALE

CITY AERIAL



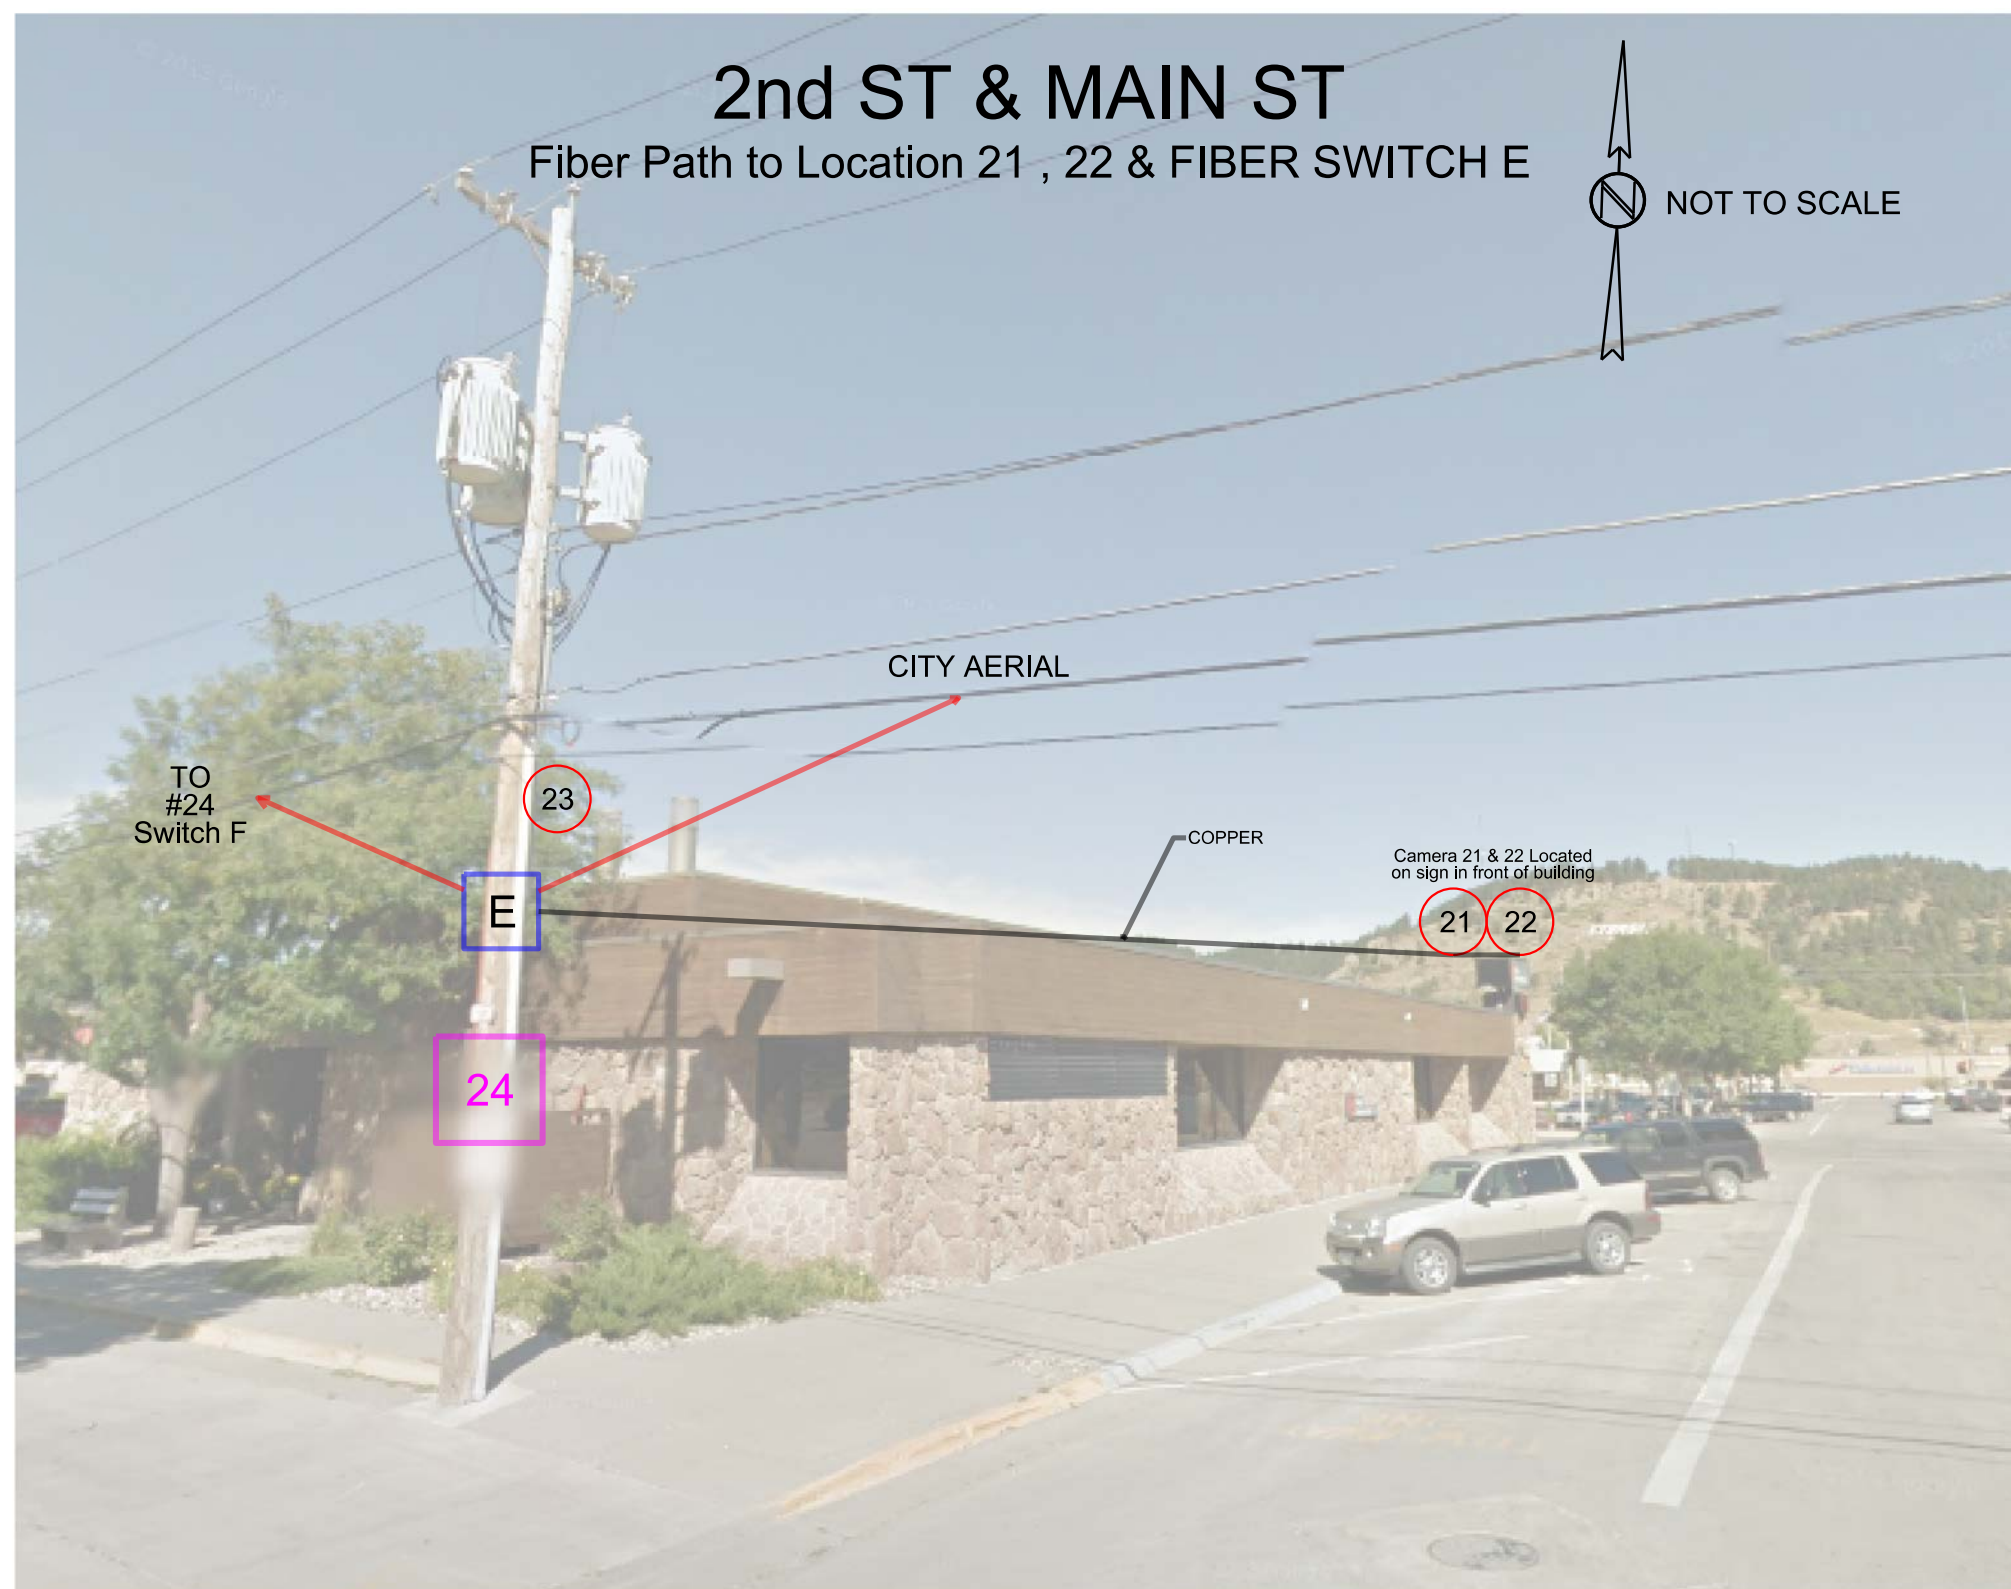




# 3rd ST & ALLEY BETWEEN MAIN ST & SHERMAN ST

Fiber Path to Location 24 & FIBER SWITCH F






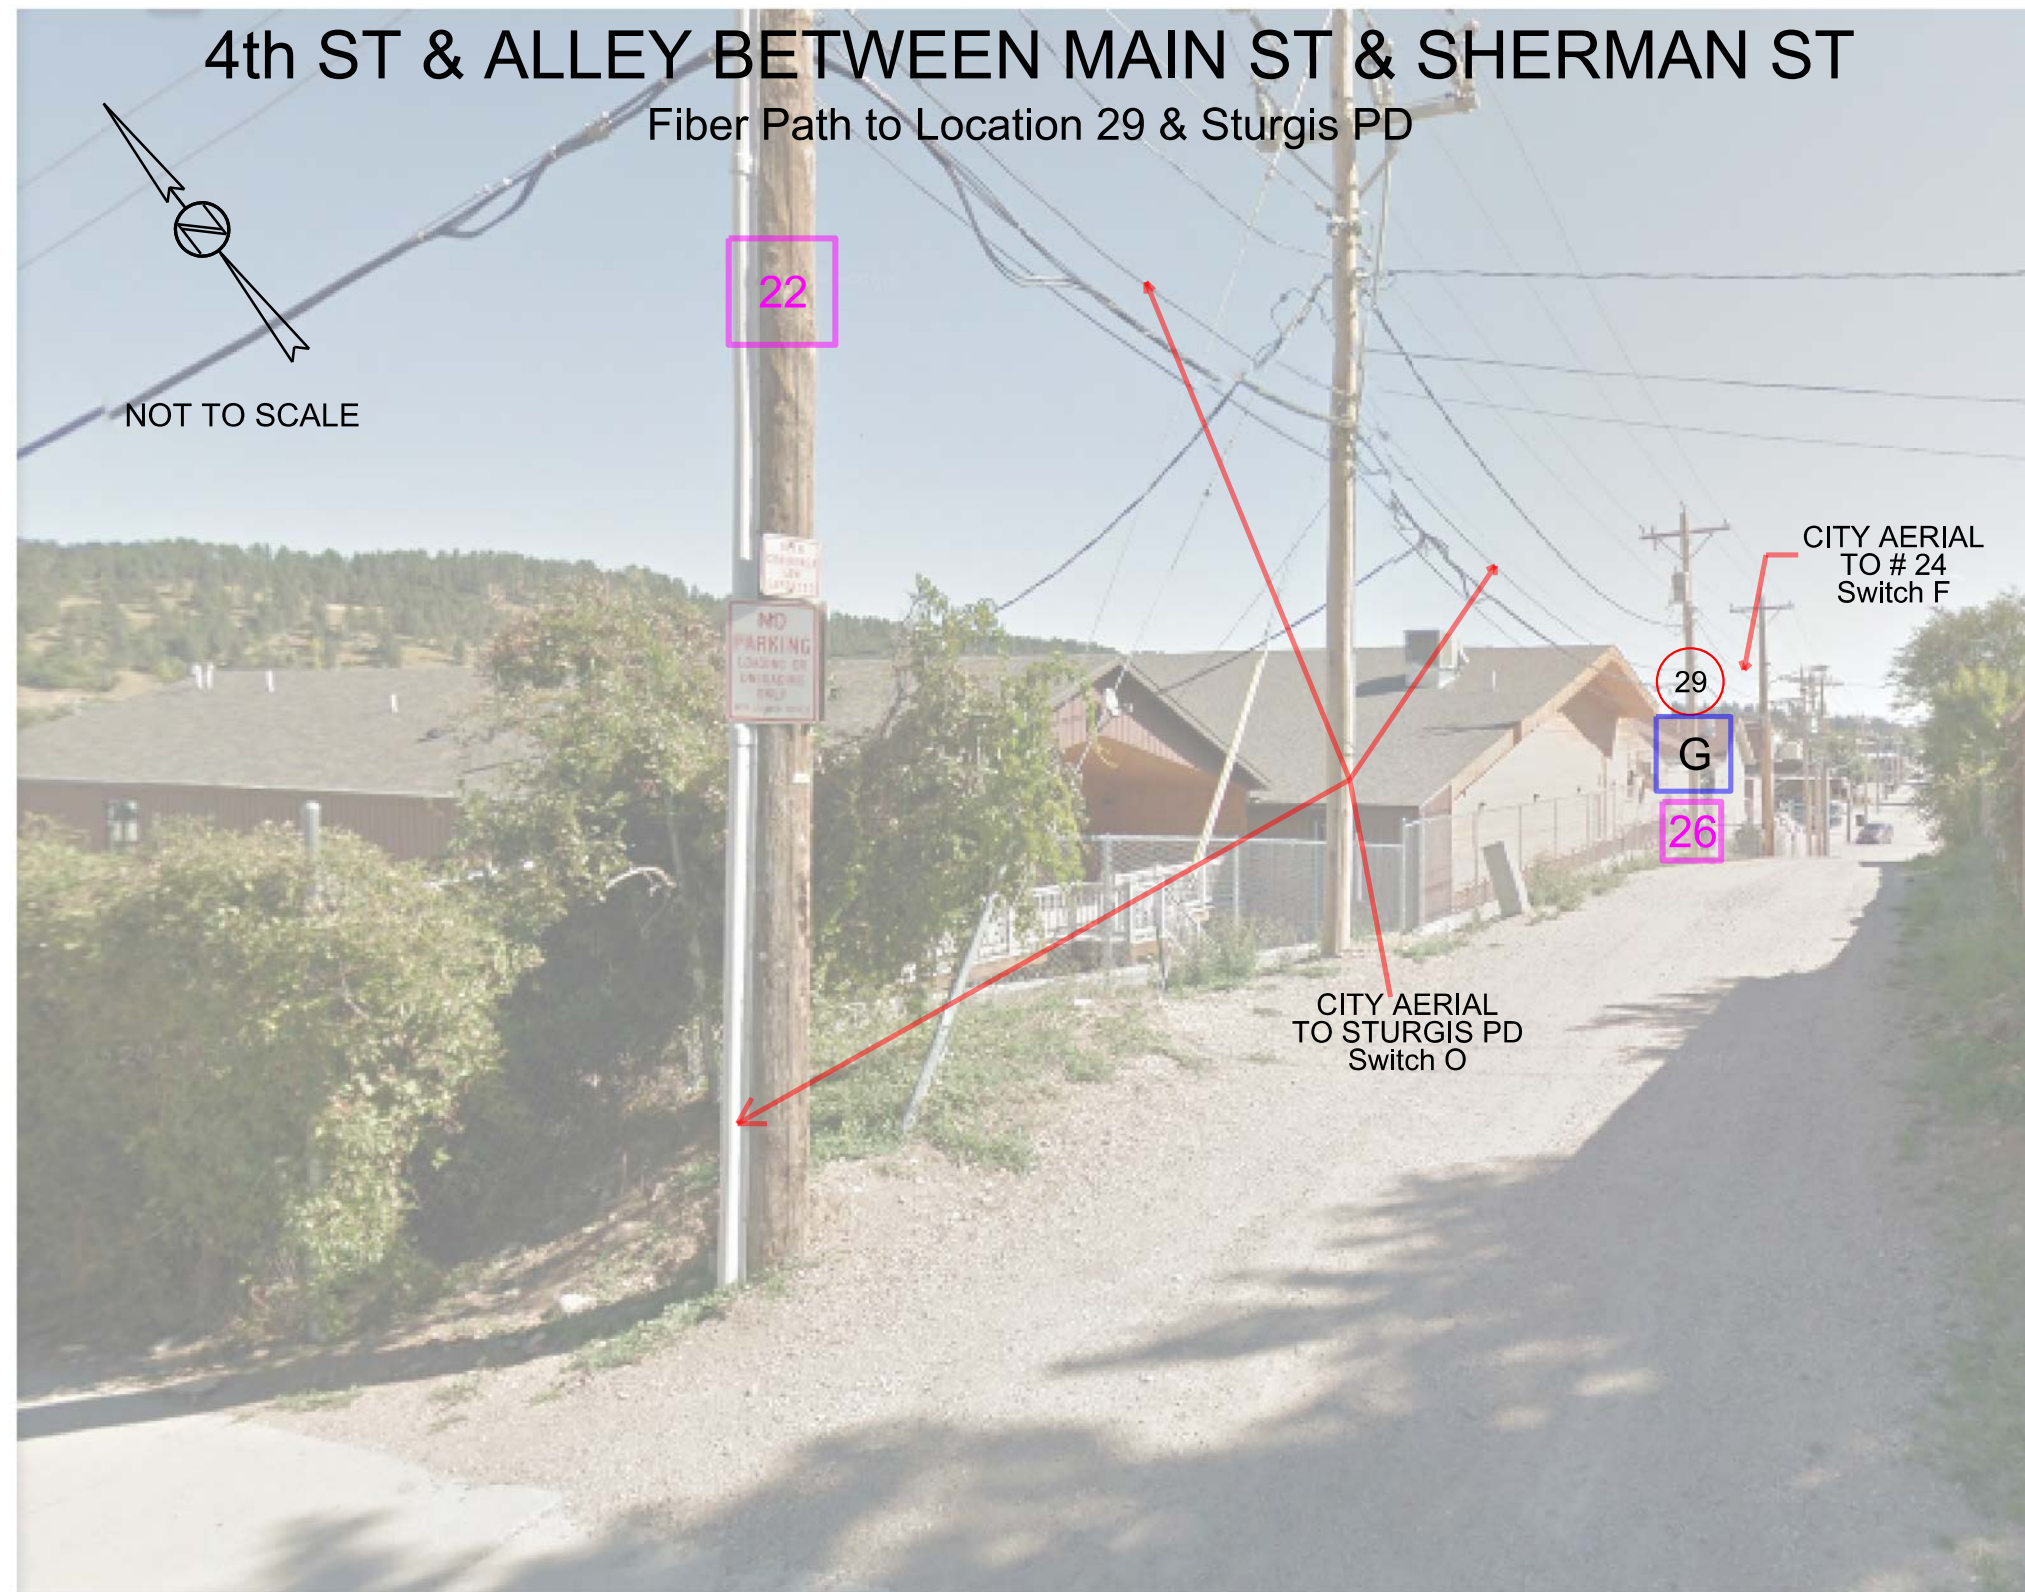








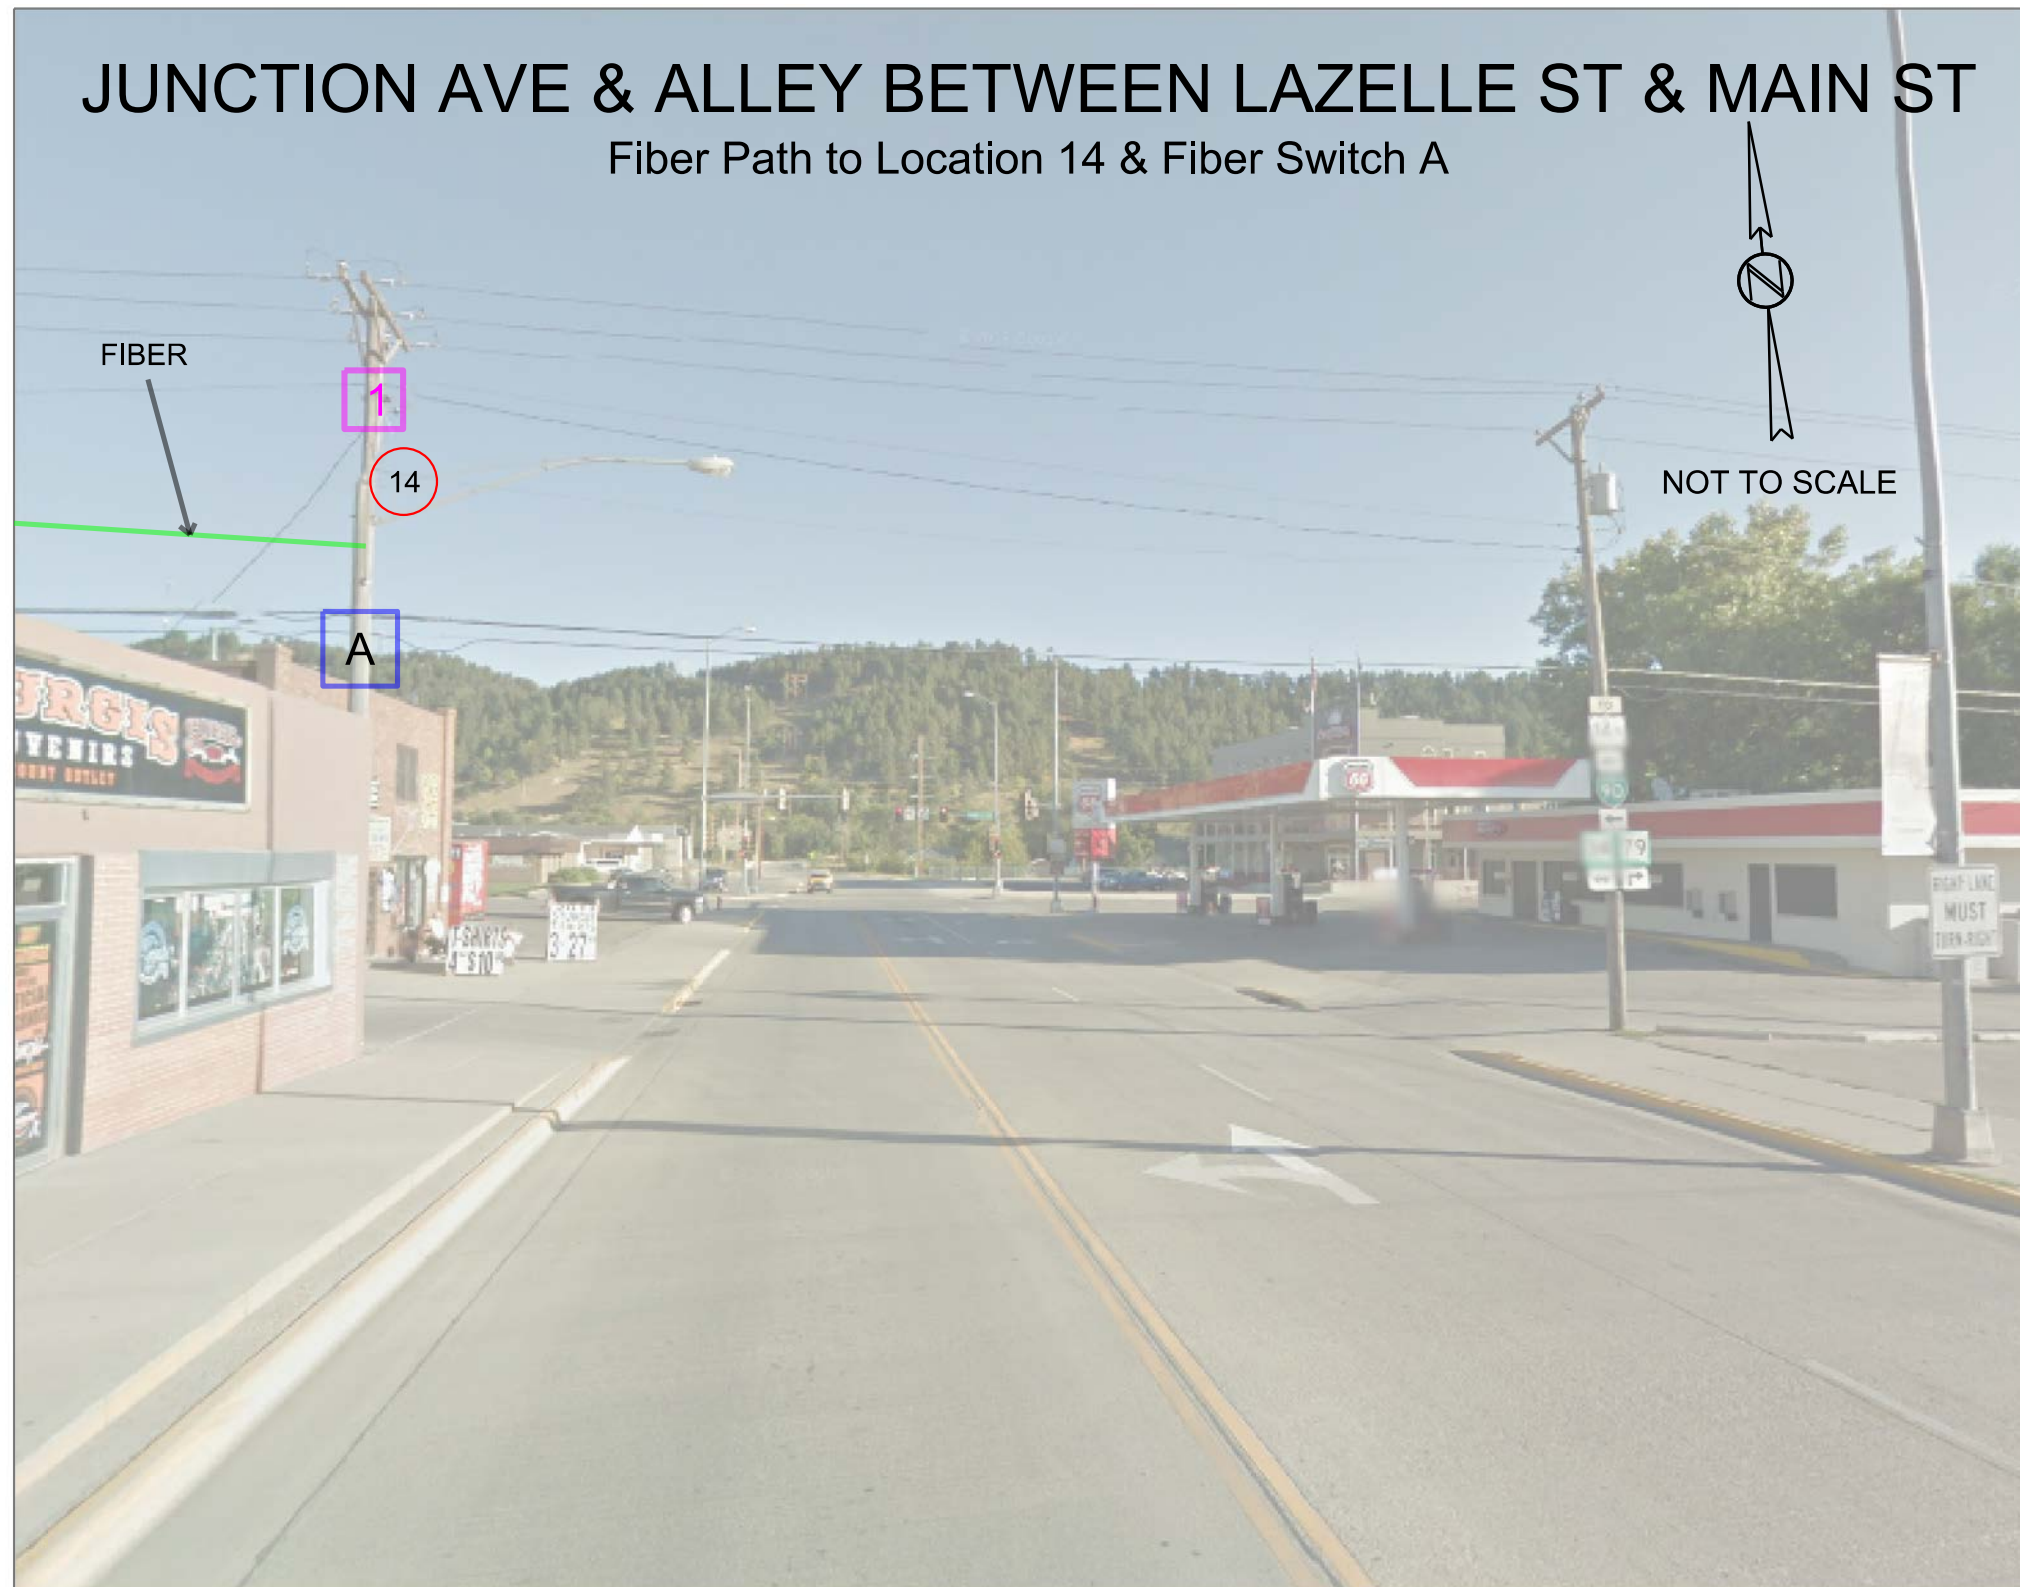




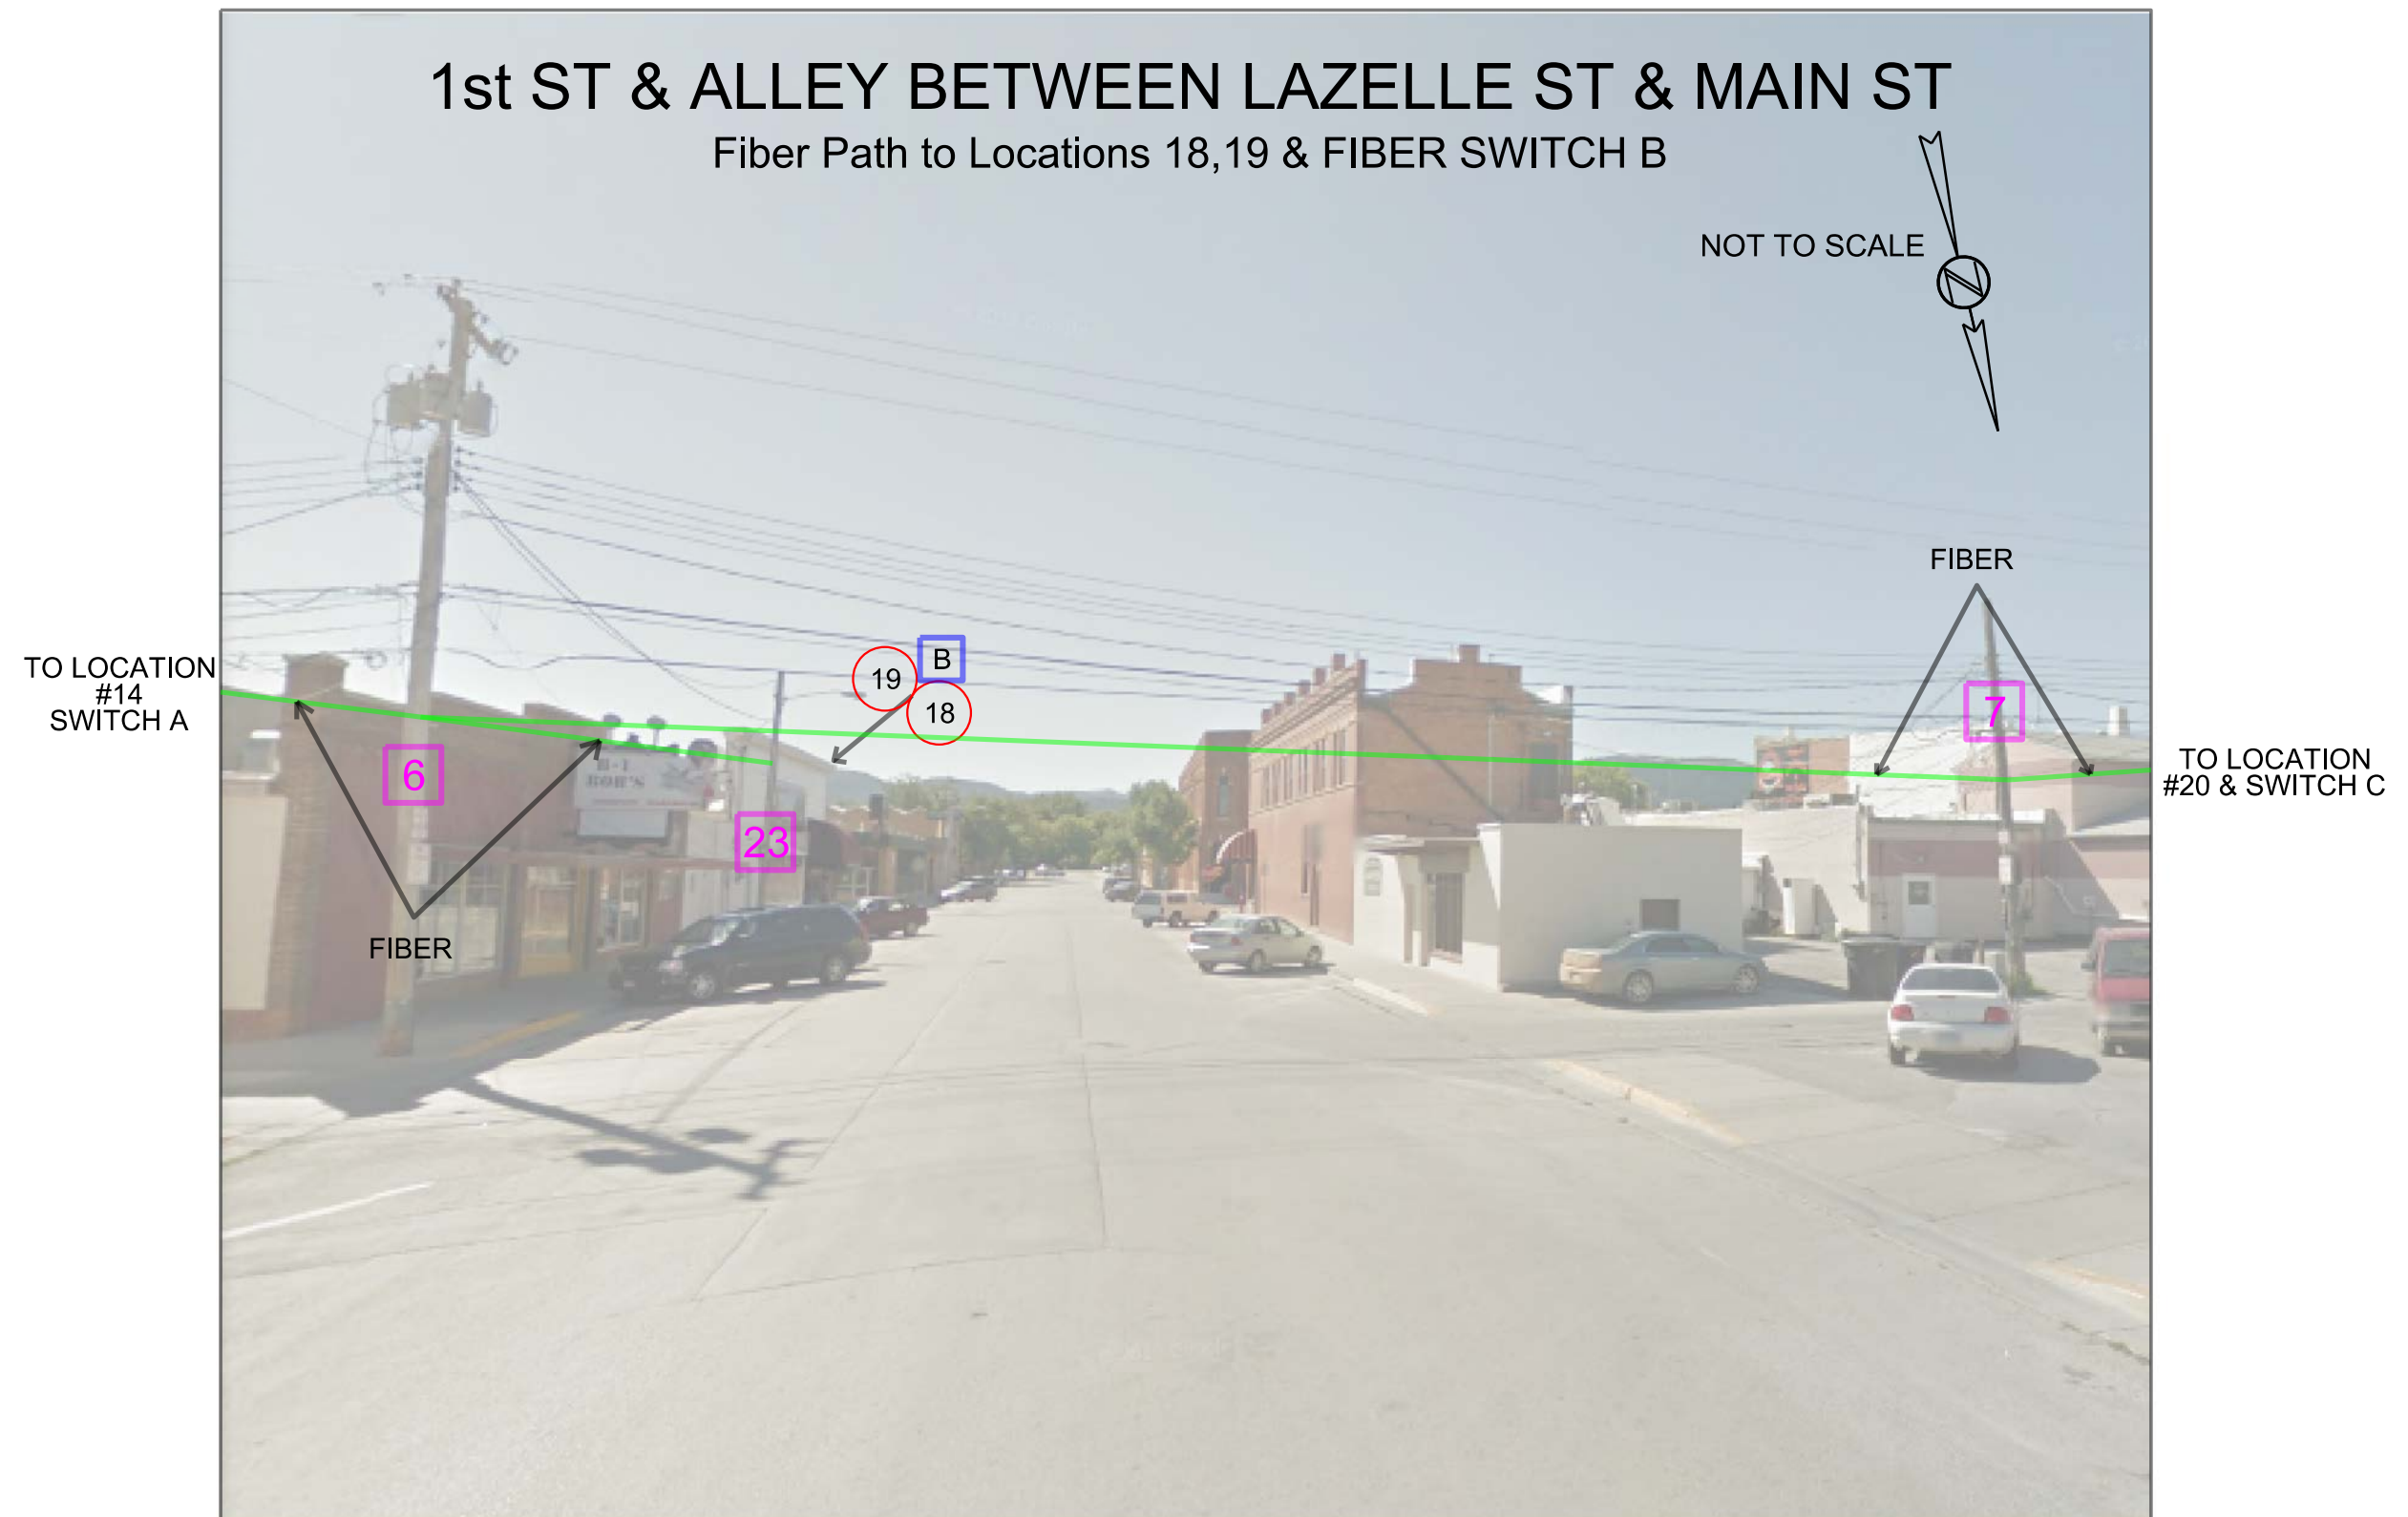









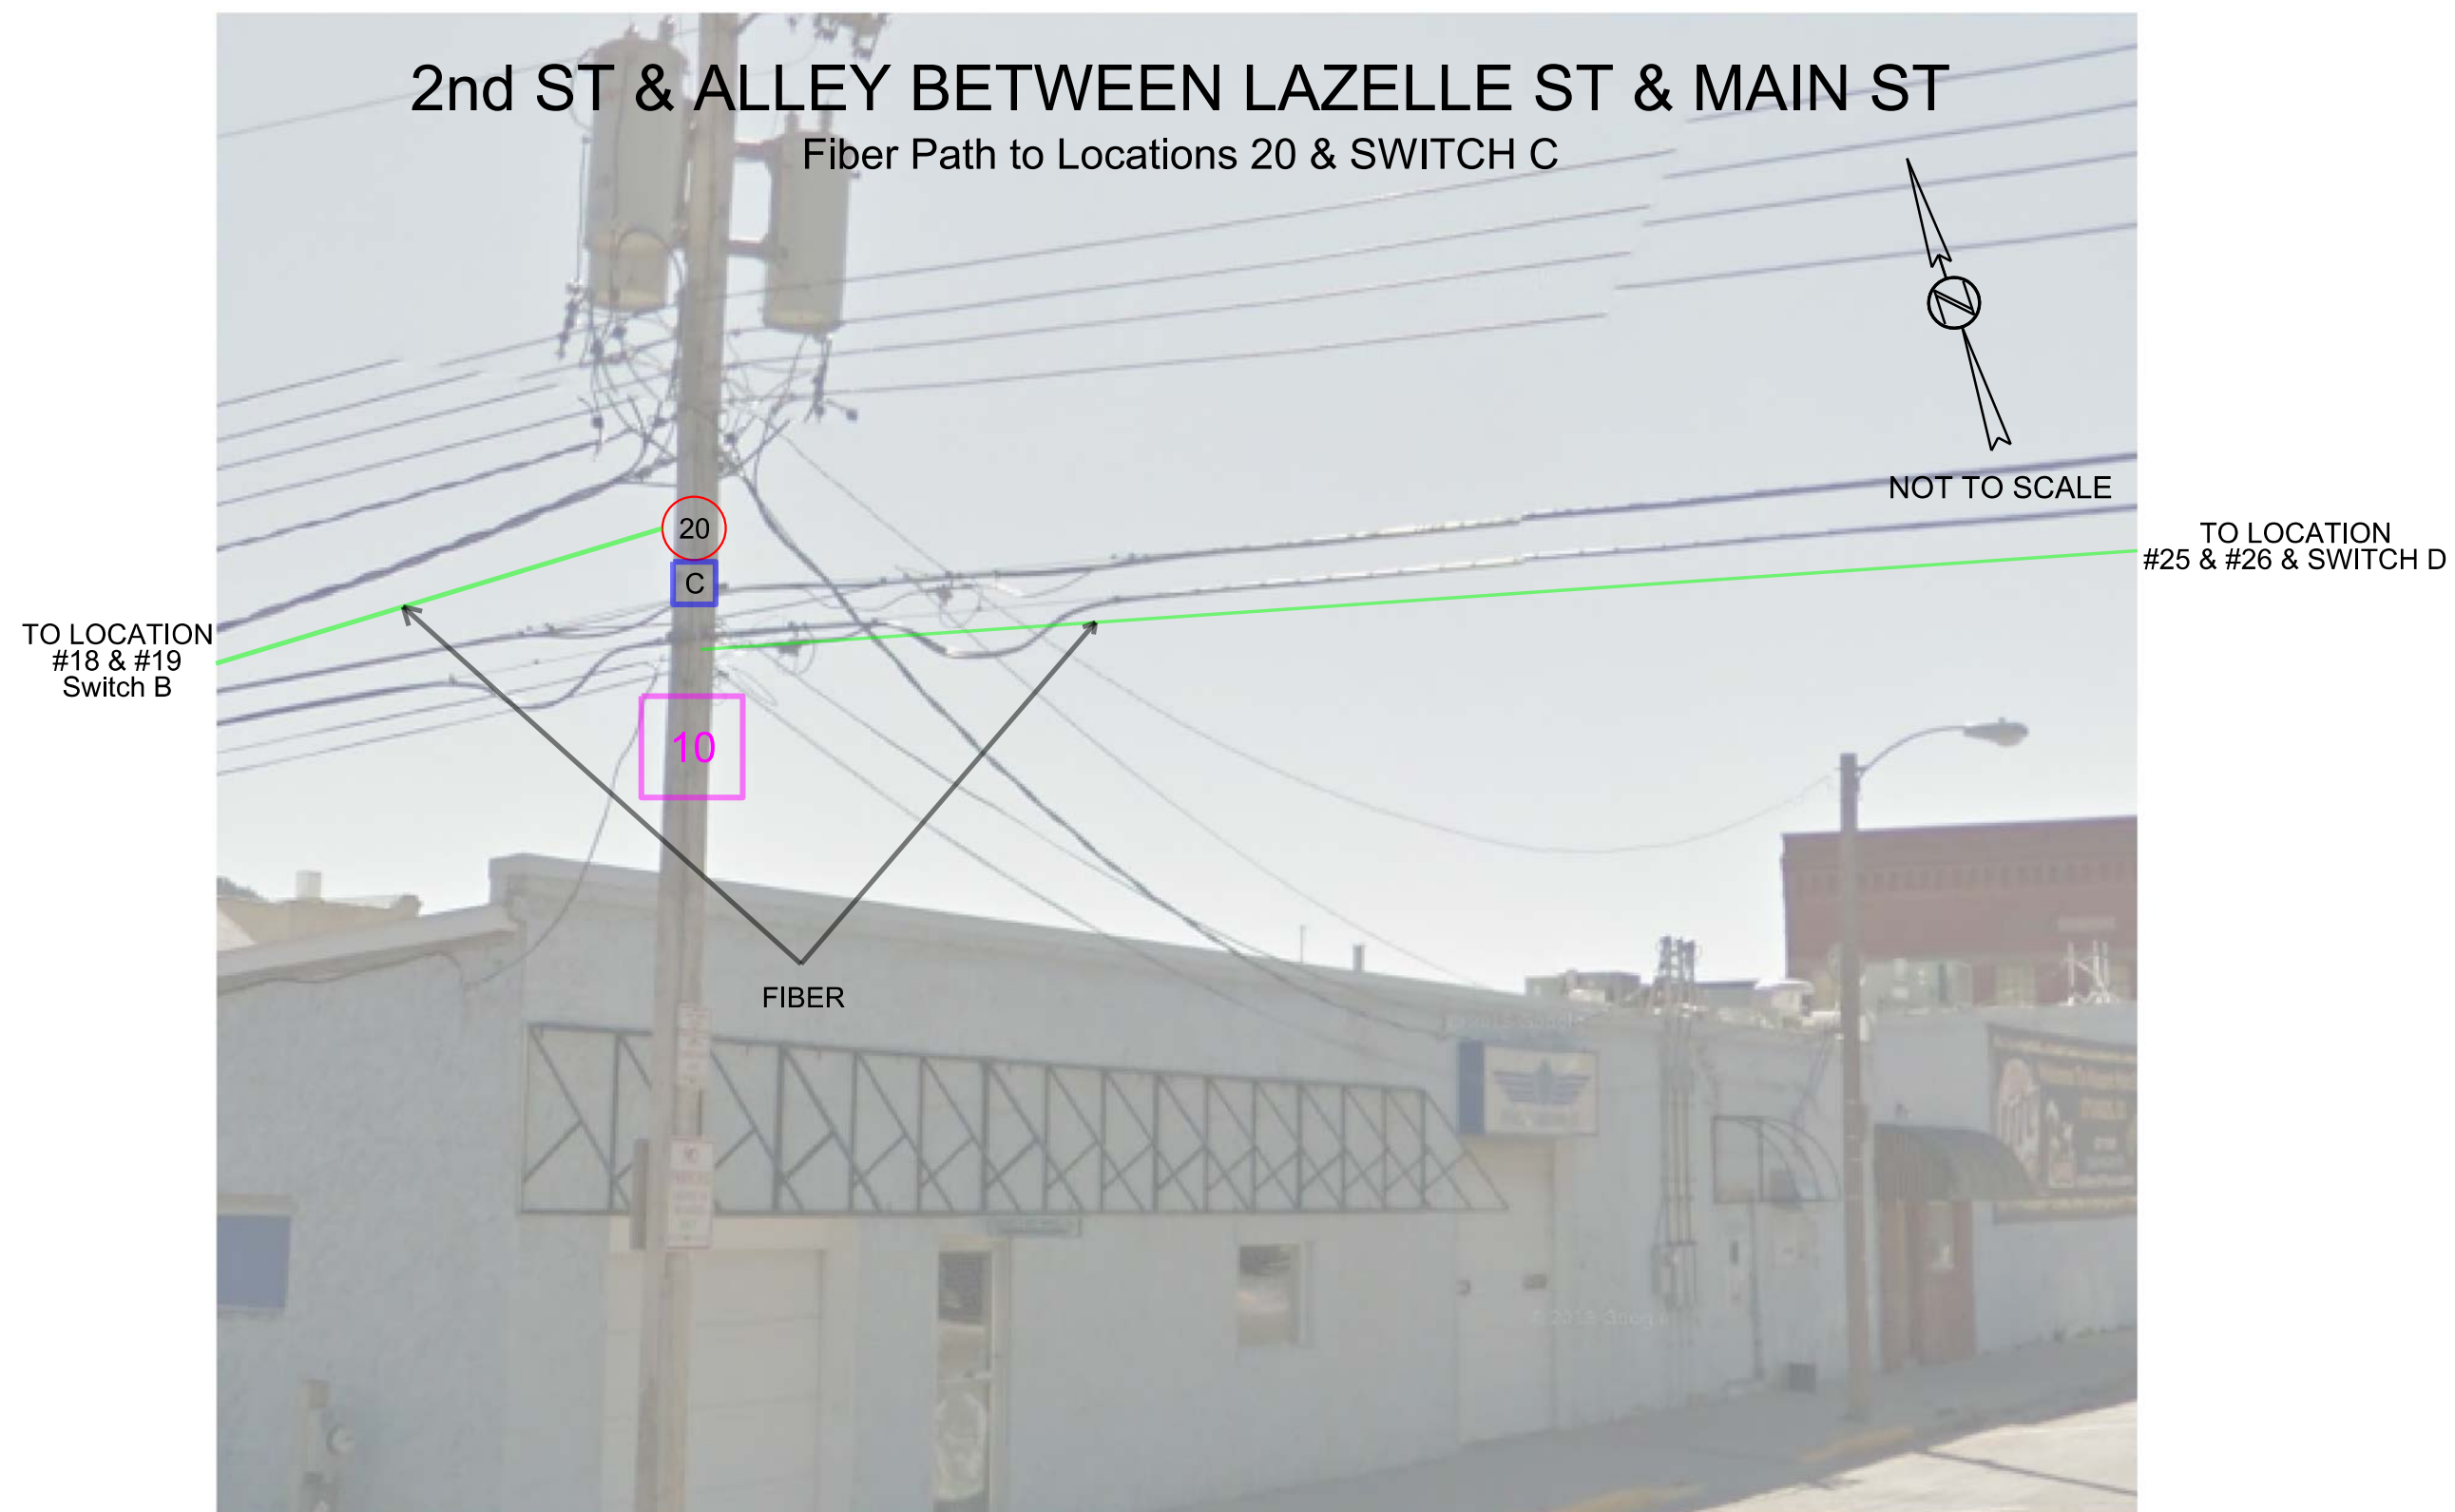




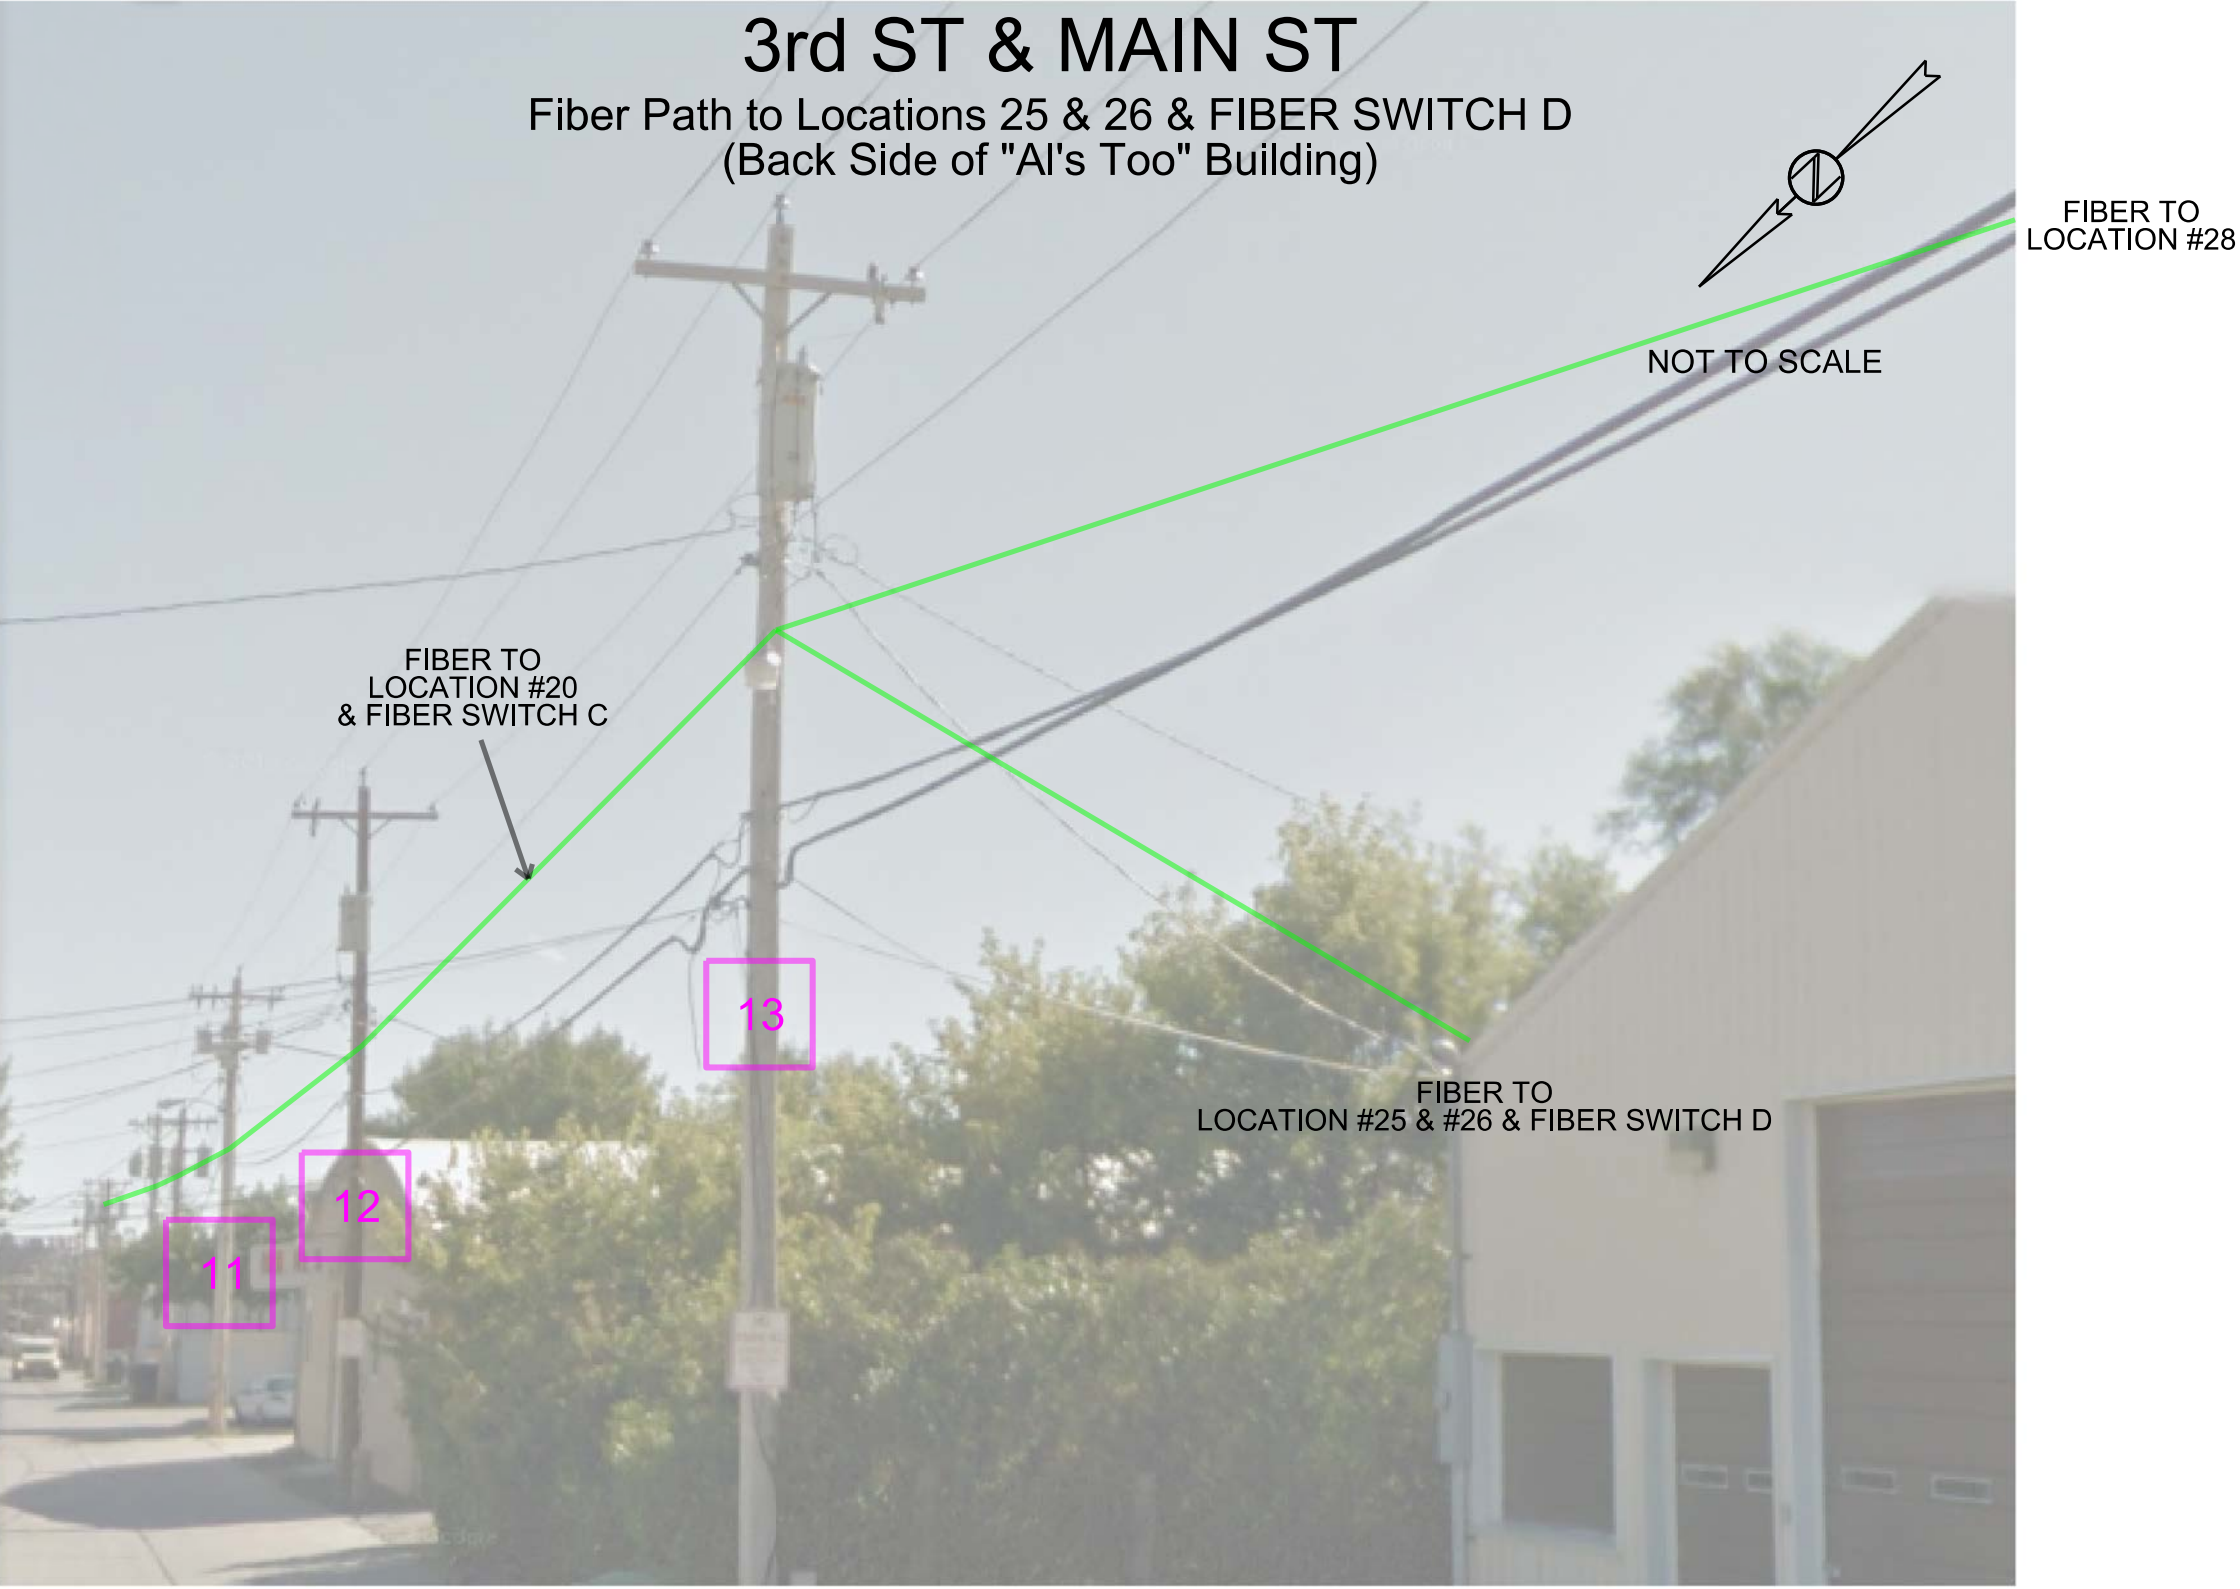




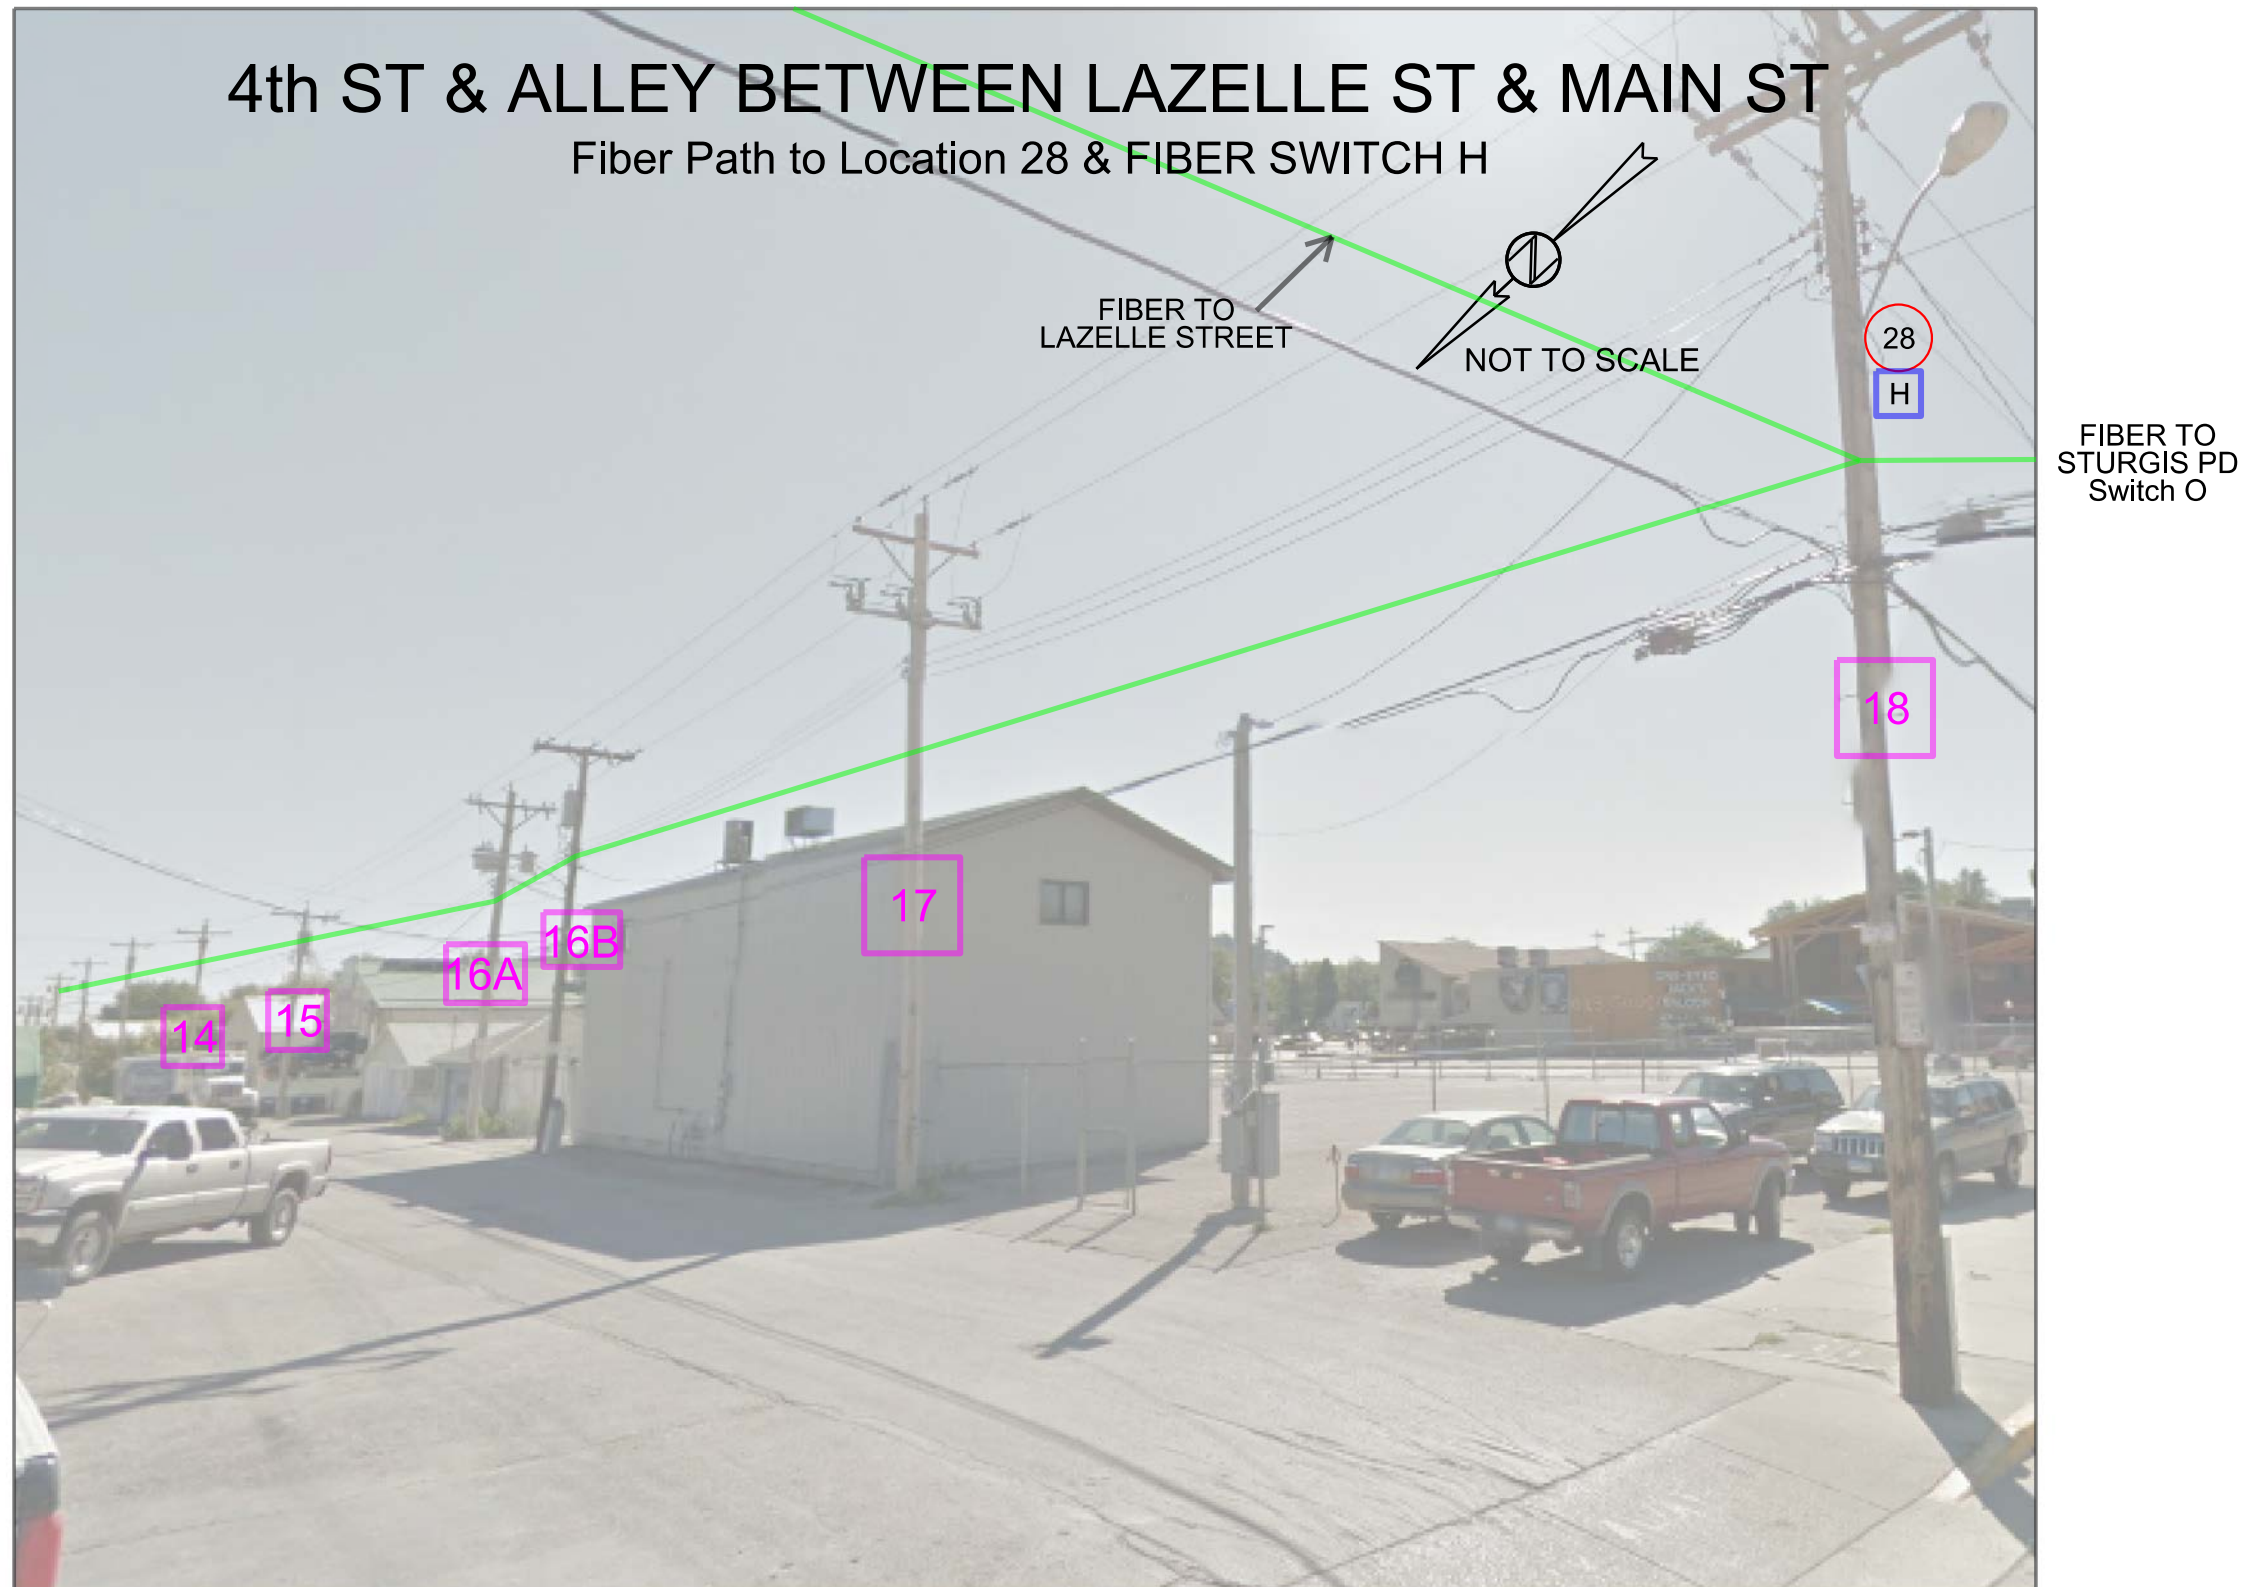




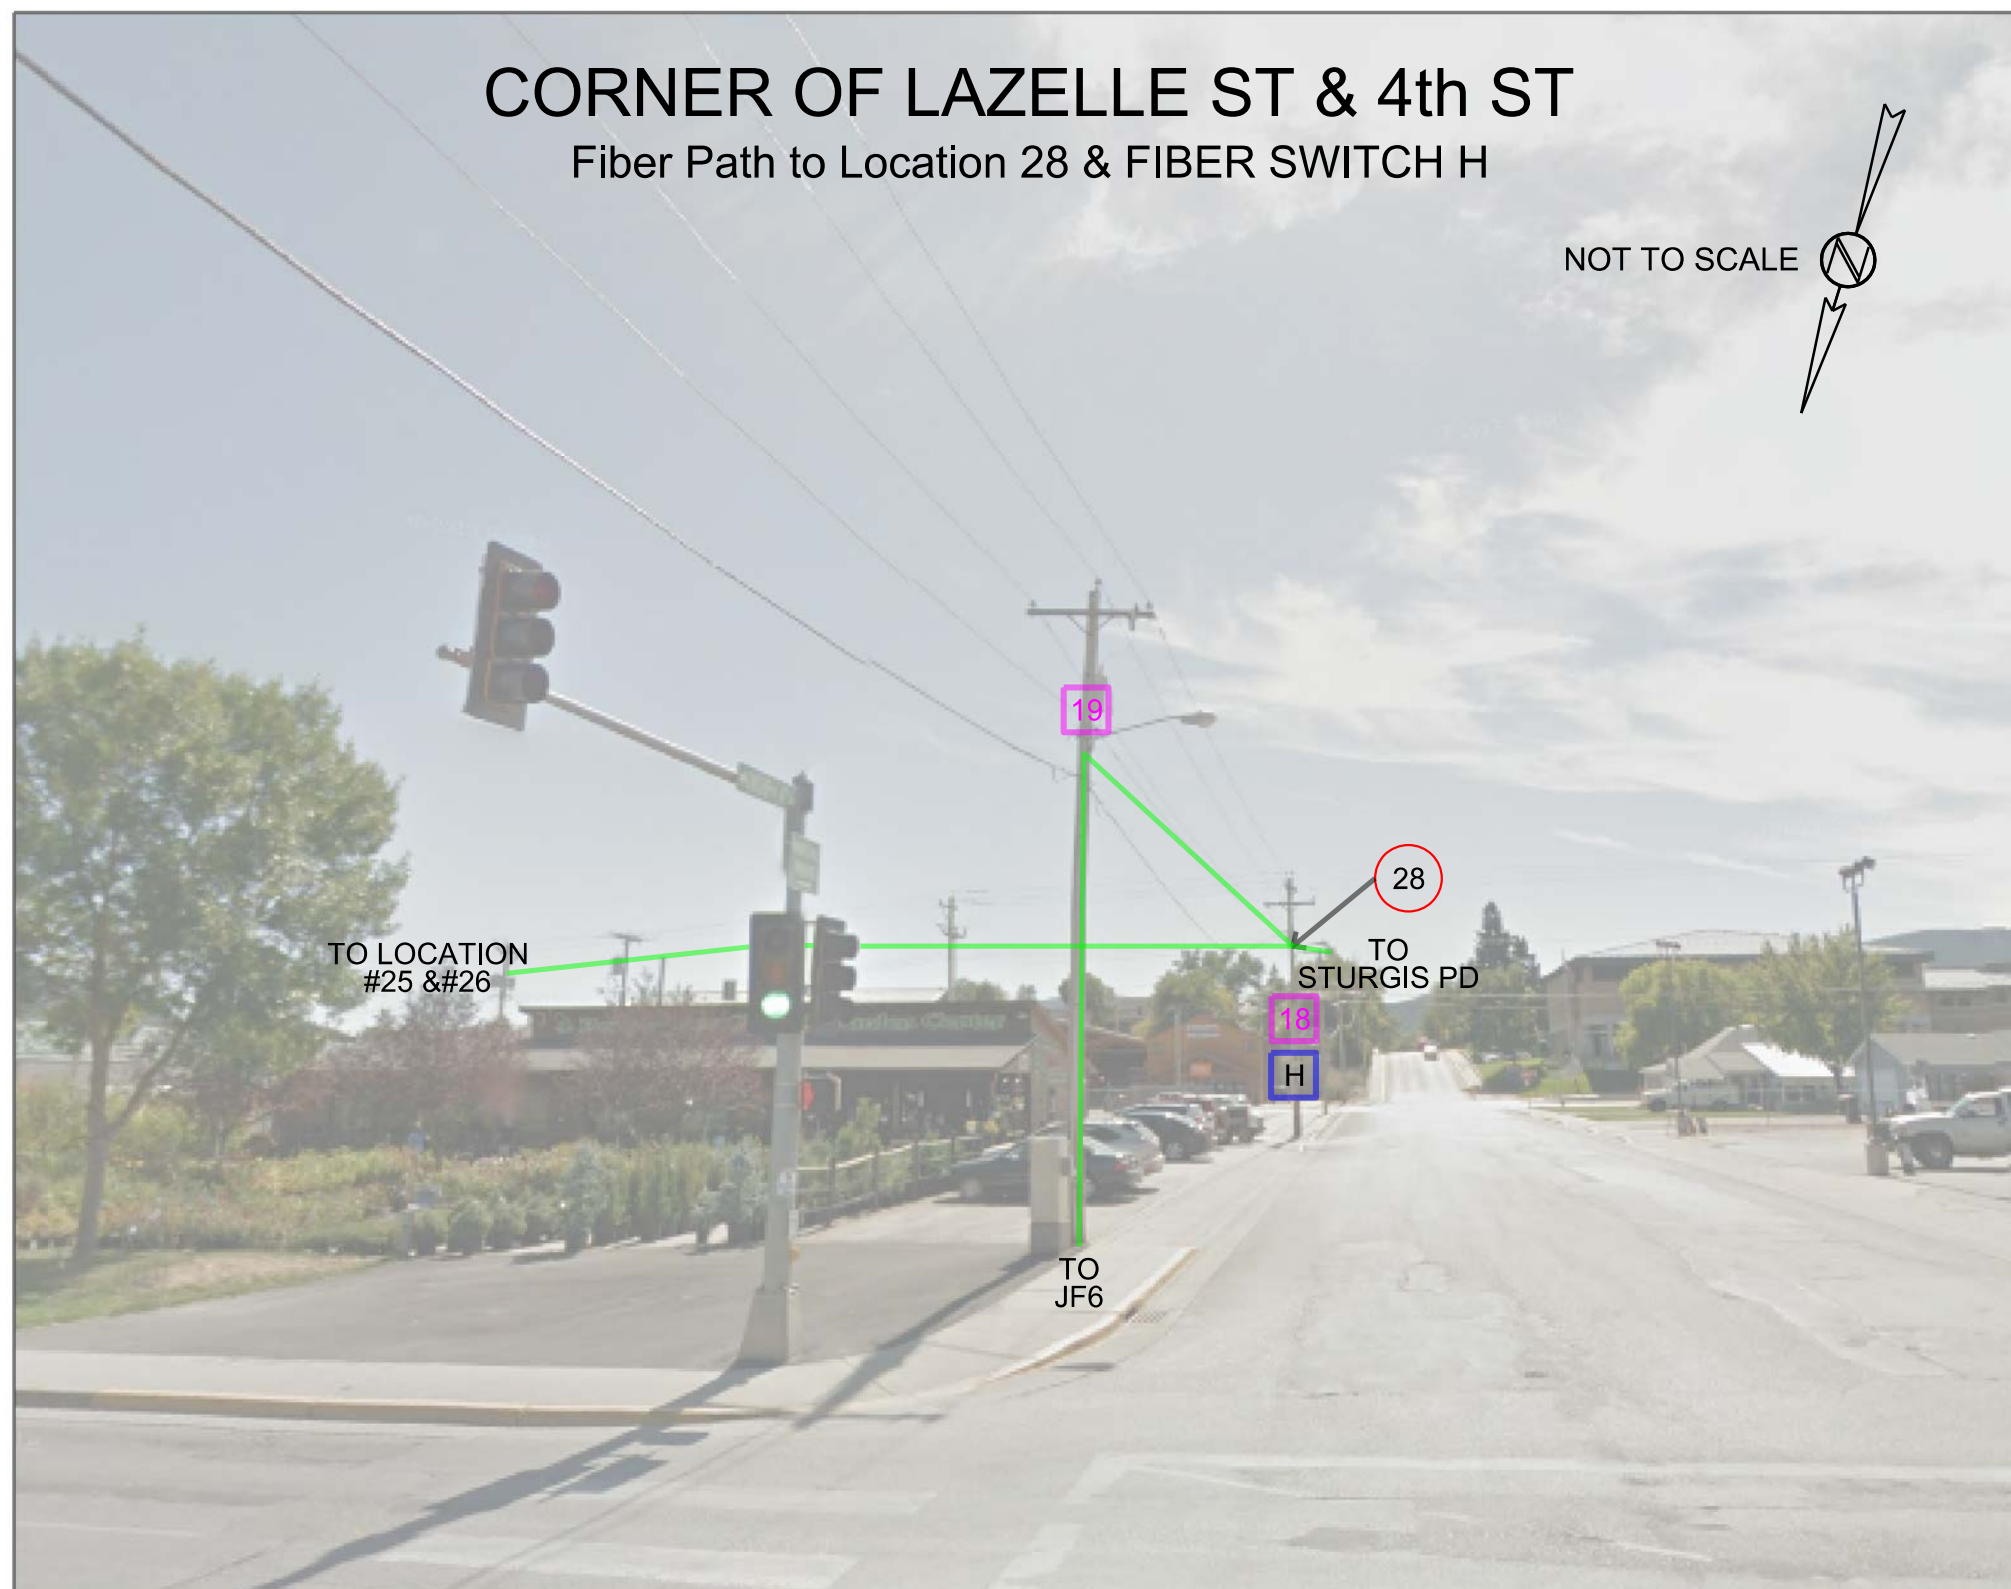



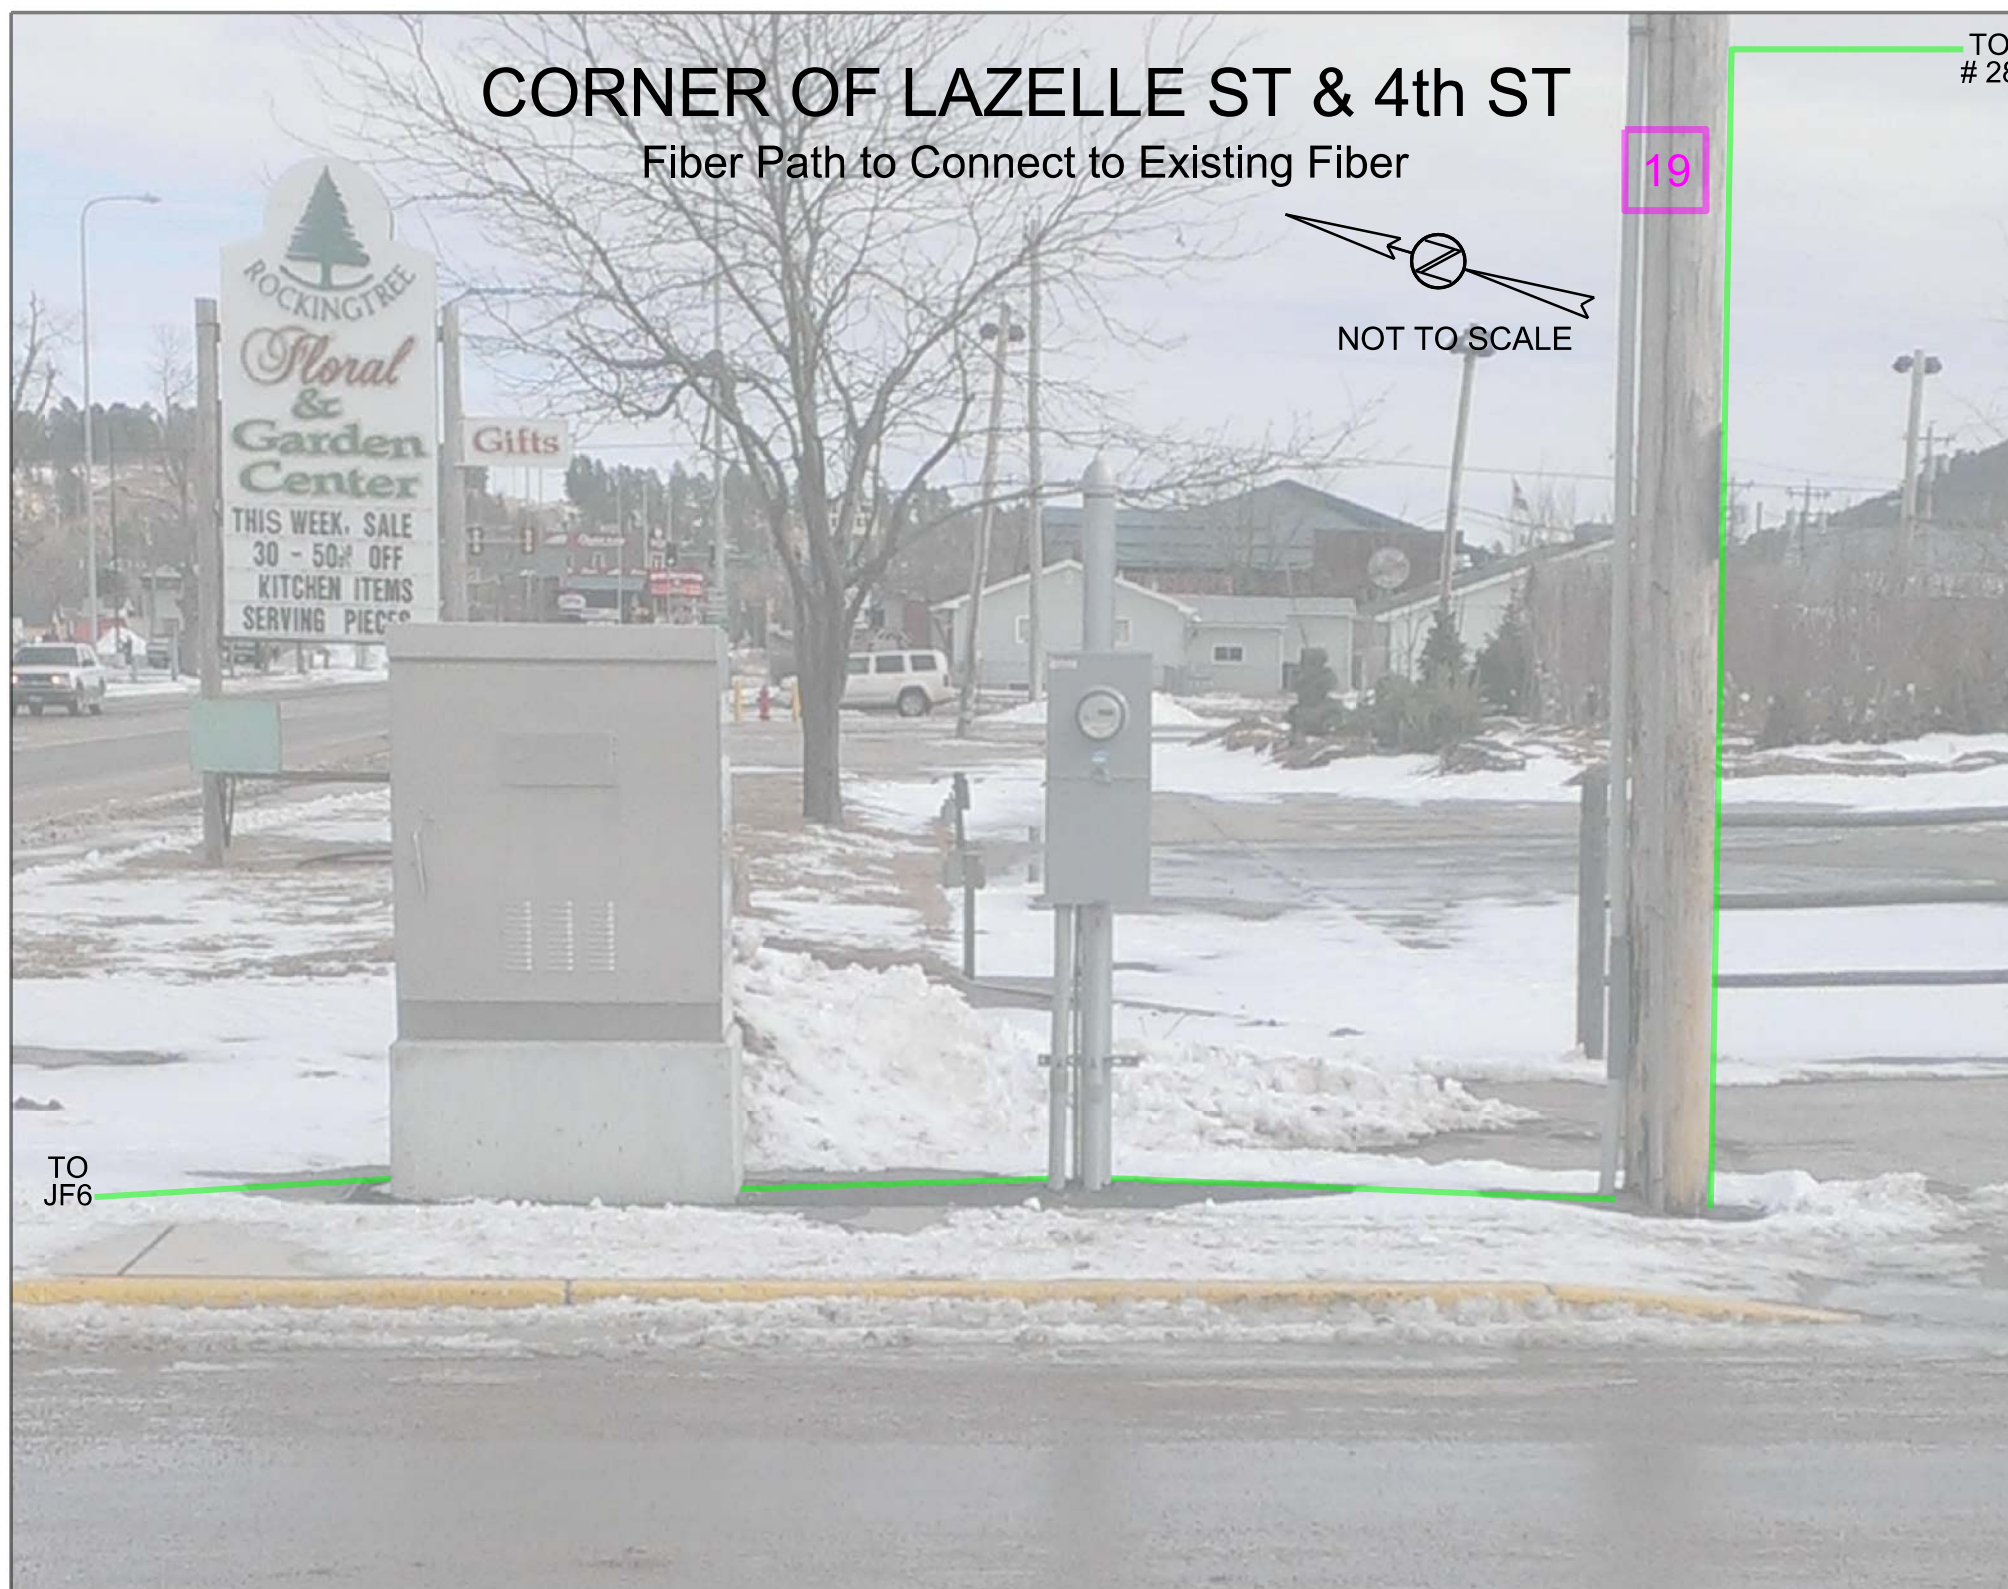



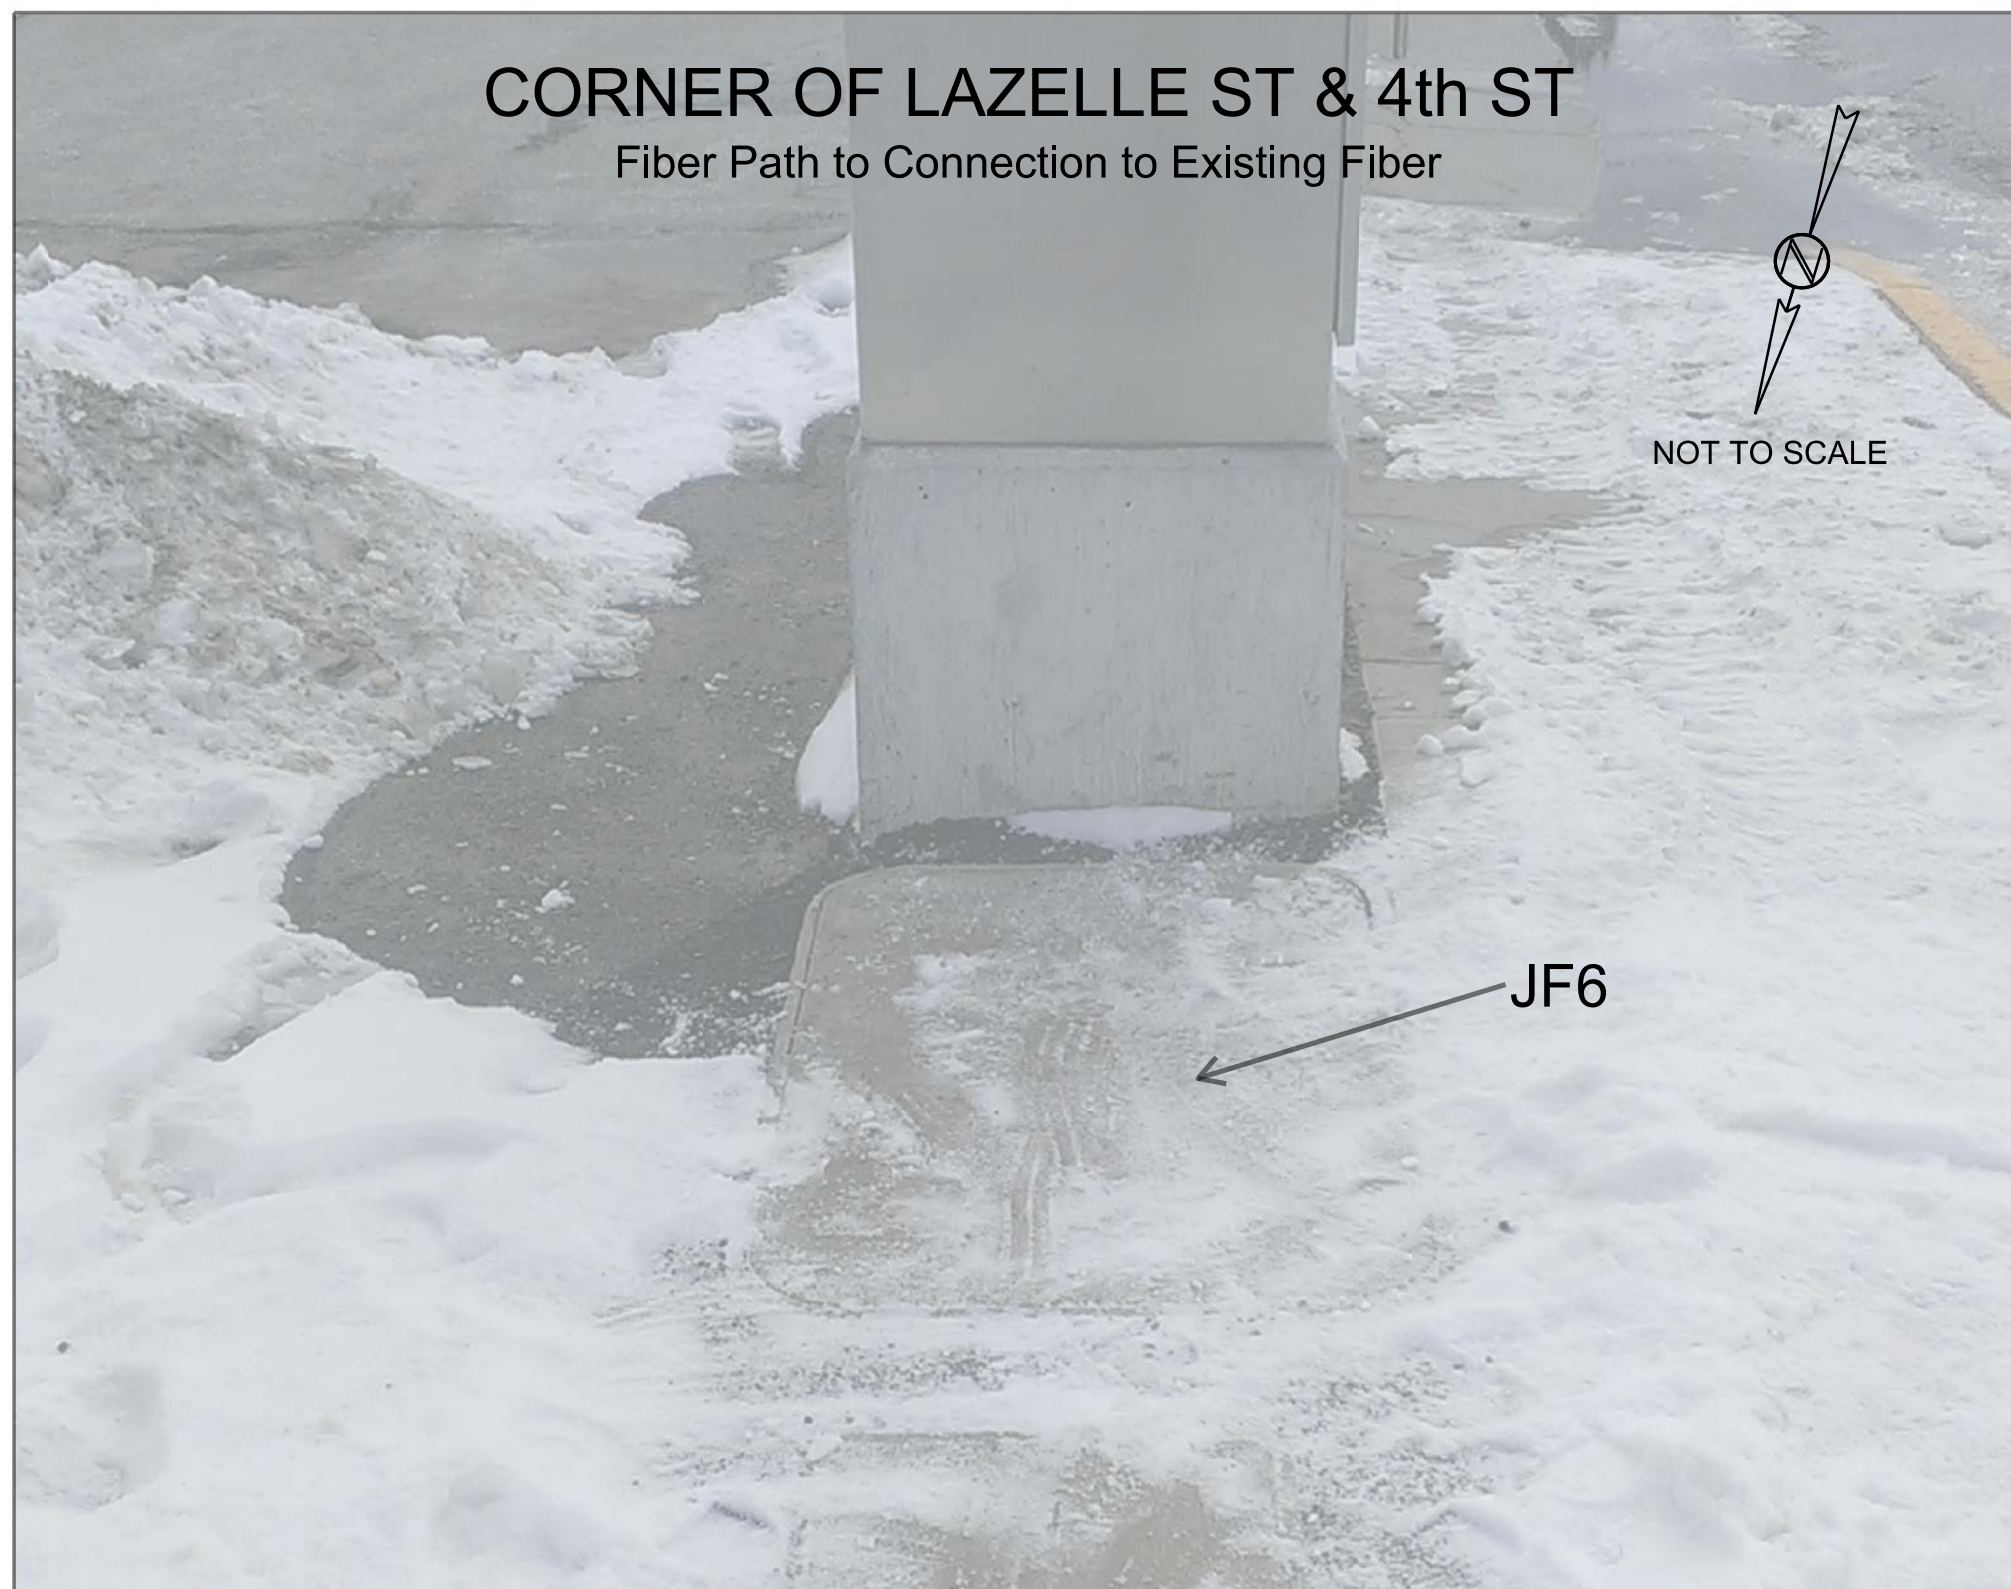



# EXISTING CONDUIT LAYOUT

## SD HWY 34/LAZELLE STREET & 4TH STREET

STATE OF SOUTH DAKOTA	PROJECT	SHEET	TOTAL SHEETS
	P 034-451	81	107


Plotting Date: 04/02/2014

THIS SHEET HAS BEEN REVISED TO  
REFLECT CONSTRUCTION AS-BUILTS

SCALE  
1" = 40'



KEY	ITEM
	3' DIAMETER FOOTING (B2,B3)
	4' DIAMETER FOOTING (B4)
	TYPE 2 ELECTRICAL JUNCTION BOX (JB2-JB4)
	TYPE 3 ELECTRICAL JUNCTION BOX (JB1)
	TRAFFIC SIGNAL CONTROLLER
	GALVANIZED STEEL UTILITY POST
	METER SOCKET
	ELECTRICAL SERVICE CABINET
	VIDEO DETECTION LOOP (23,25)
	VIDEO DETECTION LOOP (24,26)
	2" RIGID CONDUIT, SCHEDULE 40
	4" RIGID CONDUIT, SCHEDULE 40
	3" RIGID CONDUIT, SCHEDULE 80
	1/C #4 AWG COPPER WIRE
	1/C #6 AWG COPPER CABLE
	4/C #14 AWG COPPER TRAY CABLE, K2
	24/C #14 AWG COPPER TRAY CABLE, K2
	VIDEO CABLE

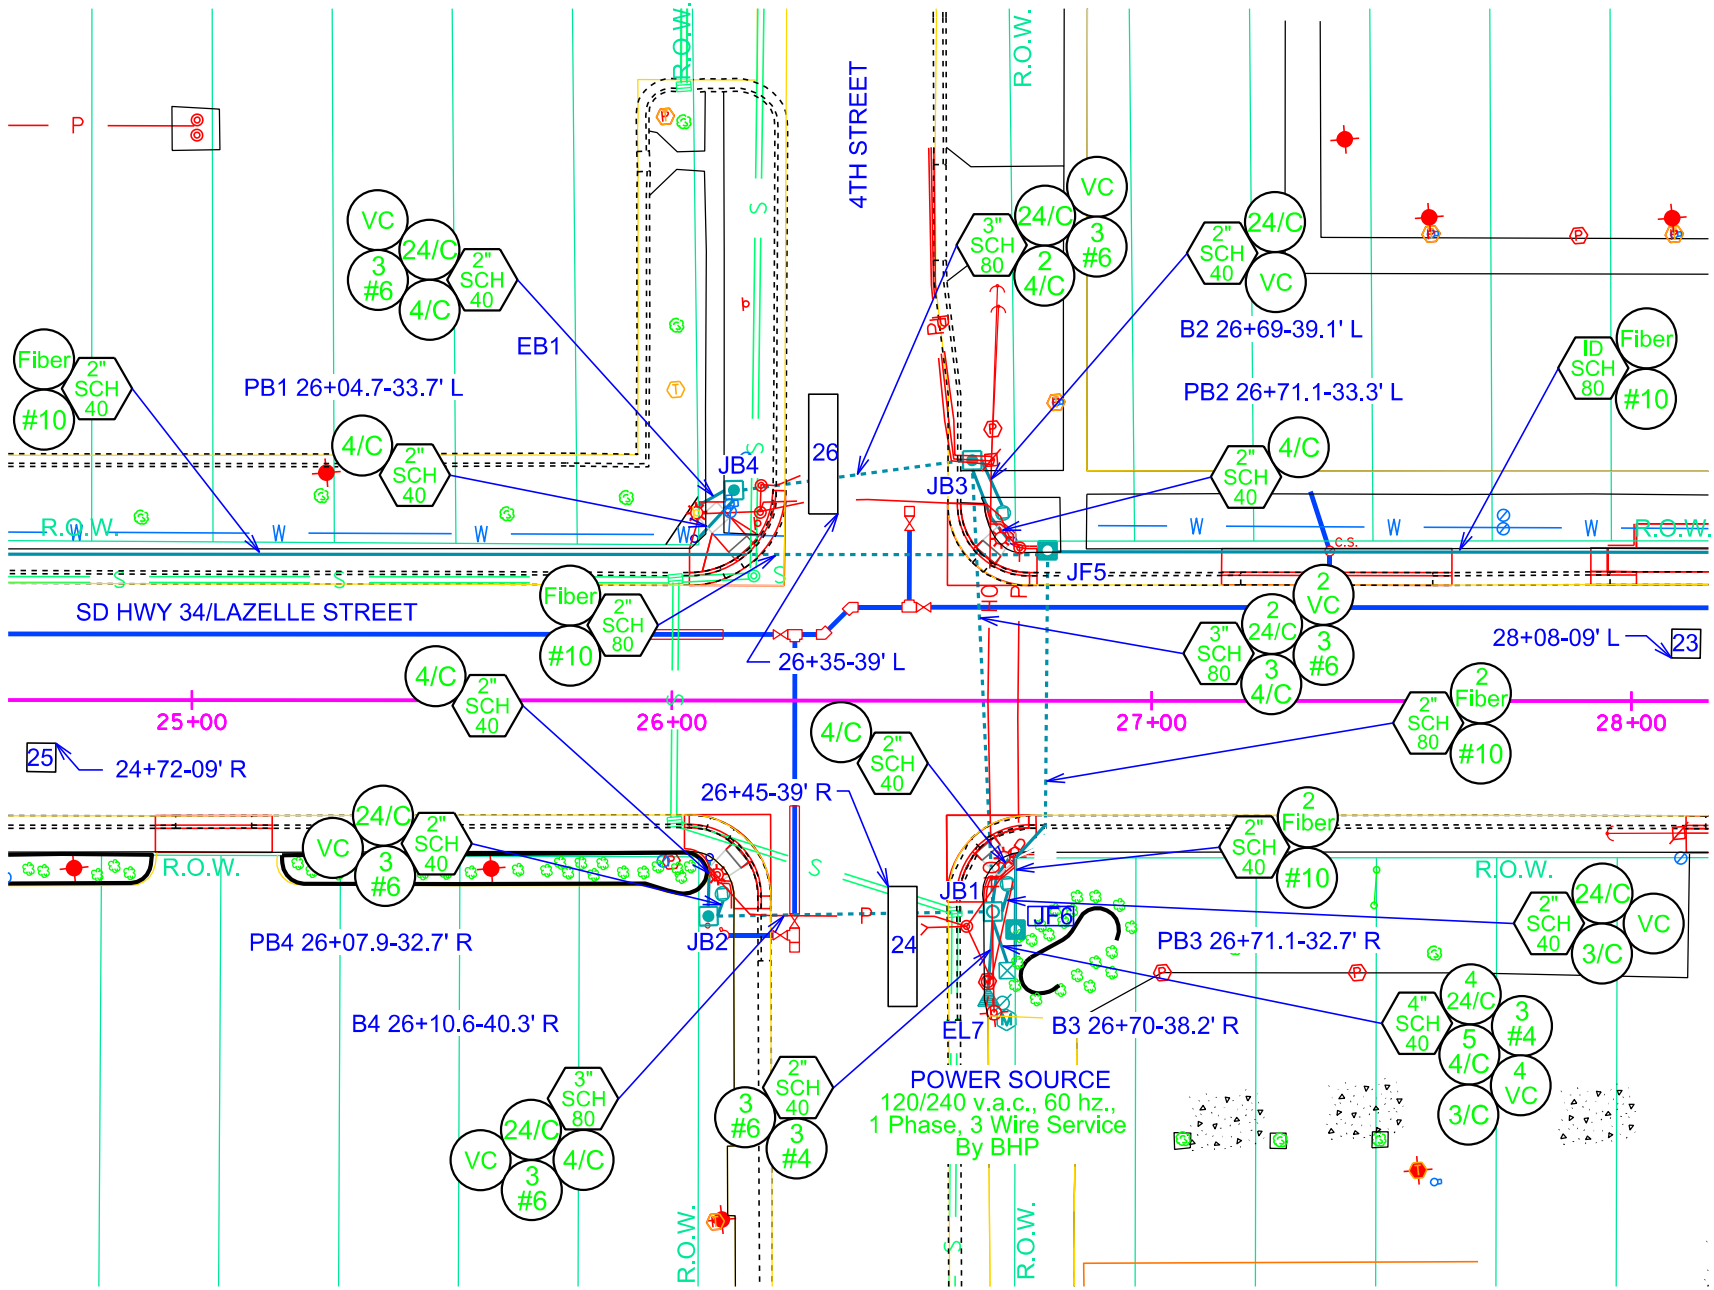



# EXISTING CONDUIT LAYOUT

## SD HWY 34/LAZELLE STREET & 3RD STREET

STATE OF SOUTH DAKOTA	PROJECT	SHEET	TOTAL SHEETS
	P 034-451	82	107


Plotting Date: 04/02/2014

THIS SHEET HAS BEEN REVISED TO  
REFLECT CONSTRUCTION AS-BUILTS

SCALE  
1" = 40'



KEY	ITEM
	GALVANIZED STEEL UTILITY POLE NOT A BID ITEM
	3' DIAMETER FOOTING (P1,L12)
	ELECTRICAL SERVICE CABINET
	2" RIGID CONDUIT, SCHEDULE 40
	1/C #4 AWG COPPER WIRE

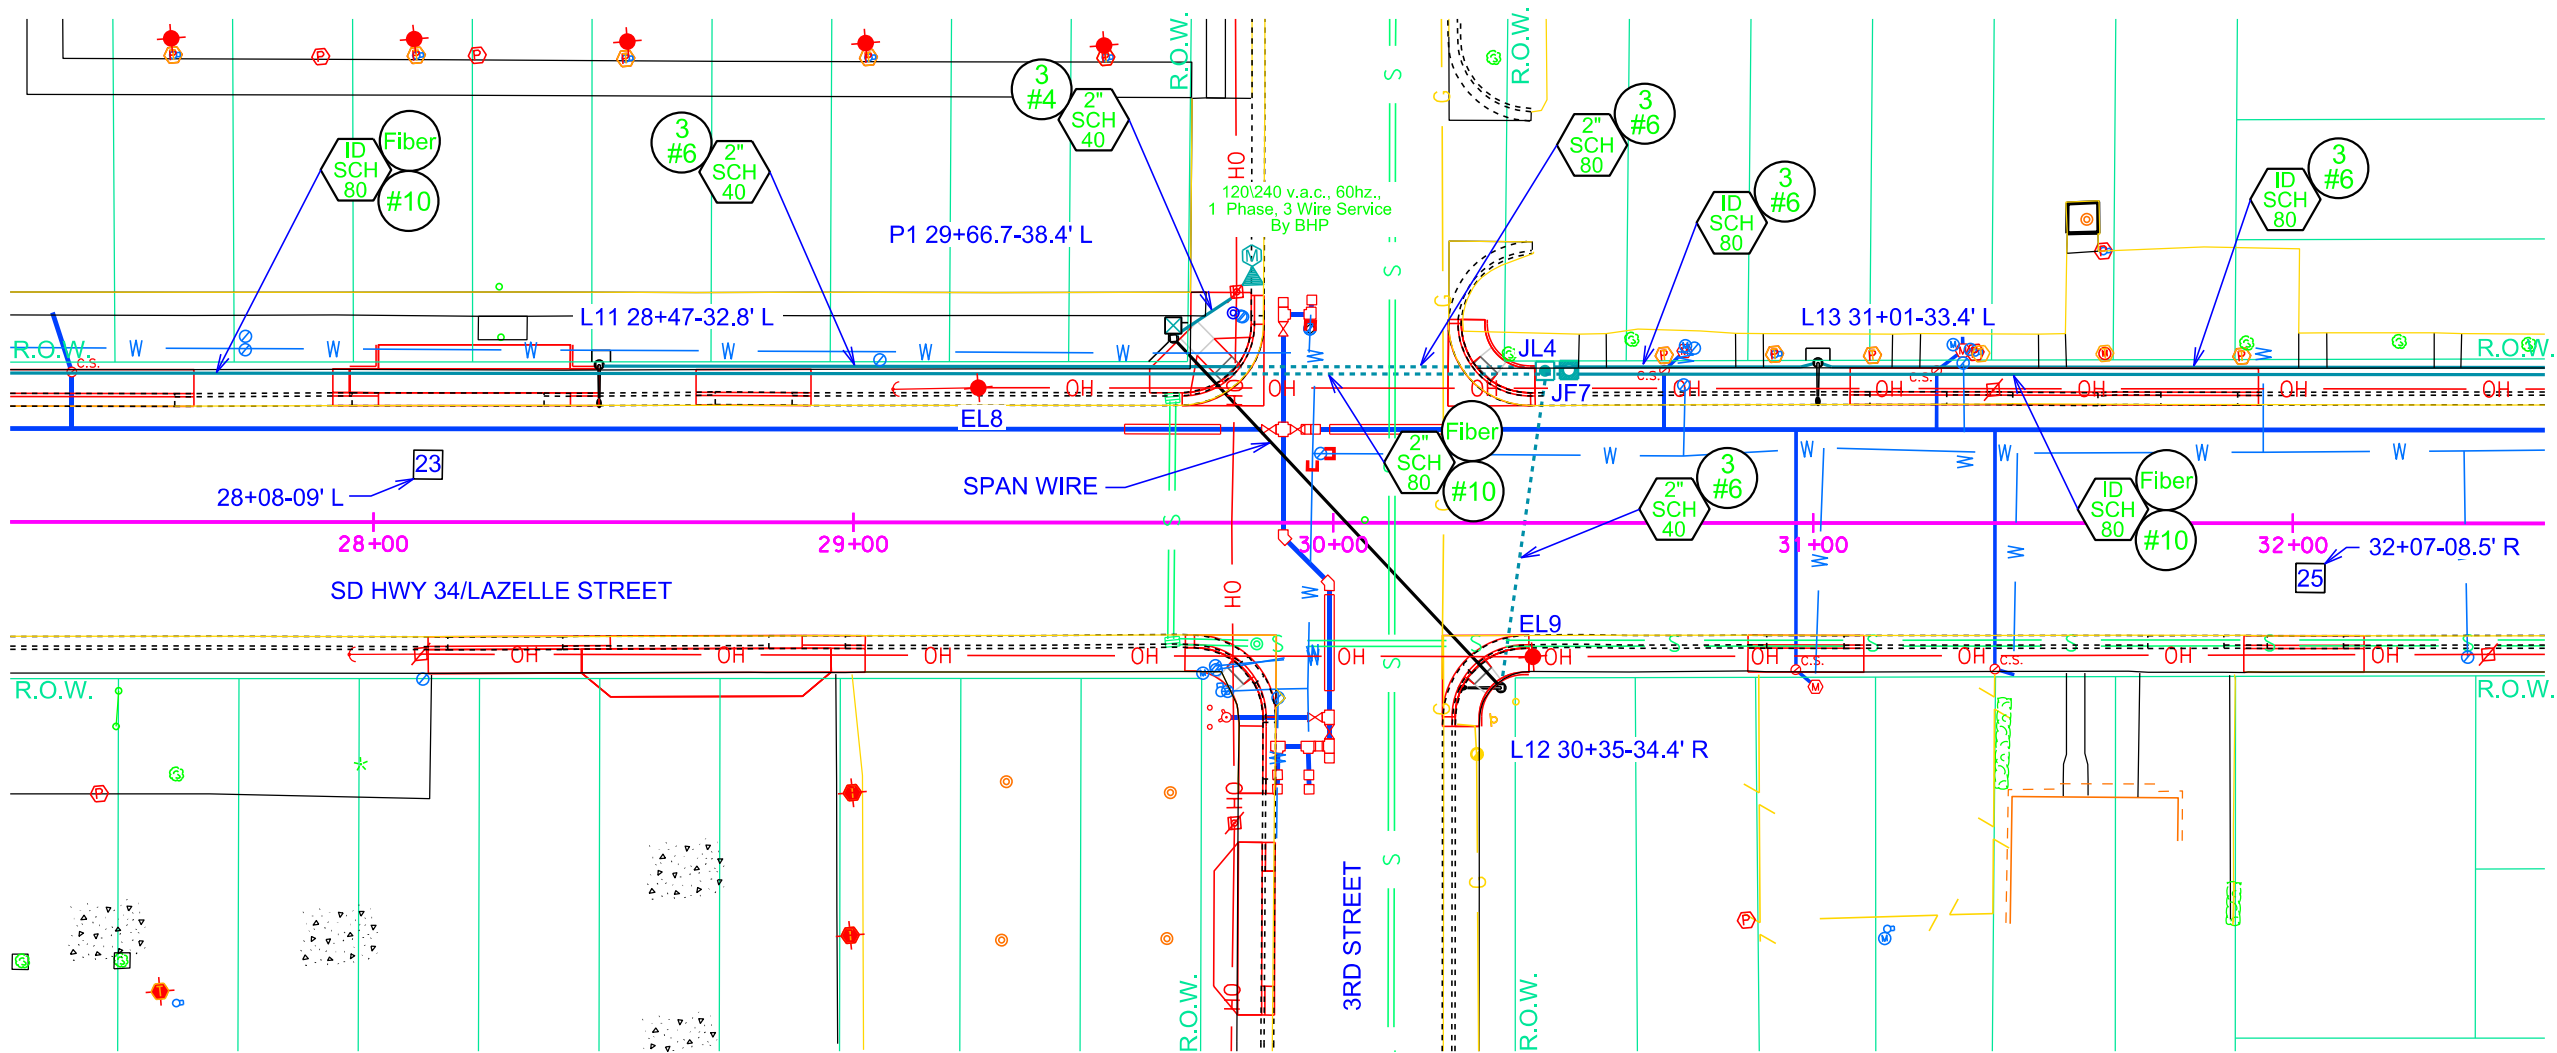

Plot Scale - 1:40

Plotted From -

R.O.W.



# EXISTING CONDUIT LAYOUT

## SD HWY 34/LAZELLE STREET & 2ND STREET

STATE OF SOUTH DAKOTA	PROJECT	SHEET	TOTAL SHEETS
	P 034-451	83	107


Plotting Date: 04/02/2014

THIS SHEET HAS BEEN REVISED TO  
REFLECT CONSTRUCTION AS-BUILTS

SCALE  
1" = 40'



KEY	ITEM
	4' DIAMETER FOOTING (C1-C4)
	GALVANIZED STEEL UTILITY POST
	METER SOCKET
	ELECTRICAL SERVICE CABINET
	TYPE 2 ELECTRICAL JUNCTION BOX (JC2-JC4)
	TYPE 3 ELECTRICAL JUNCTION BOX (JC1)
	TRAFFIC SIGNAL CONTROLLER
	VIDEO DETECTION LOOP (23,25)
	VIDEO DETECTION LOOP (24,26)
	2" RIGID CONDUIT, SCHEDULE 40
	2" RIGID CONDUIT, SCHEDULE 80
	4" RIGID CONDUIT, SCHEDULE 40
	3" RIGID CONDUIT, SCHEDULE 80
	1/C #4 AWG COPPER WIRE
	1/C #6 AWG COPPER CABLE
	4/C #14 AWG COPPER TRAY CABLE, K2
	24/C #14 AWG COPPER TRAY CABLE, K2
	VIDEO CABLE

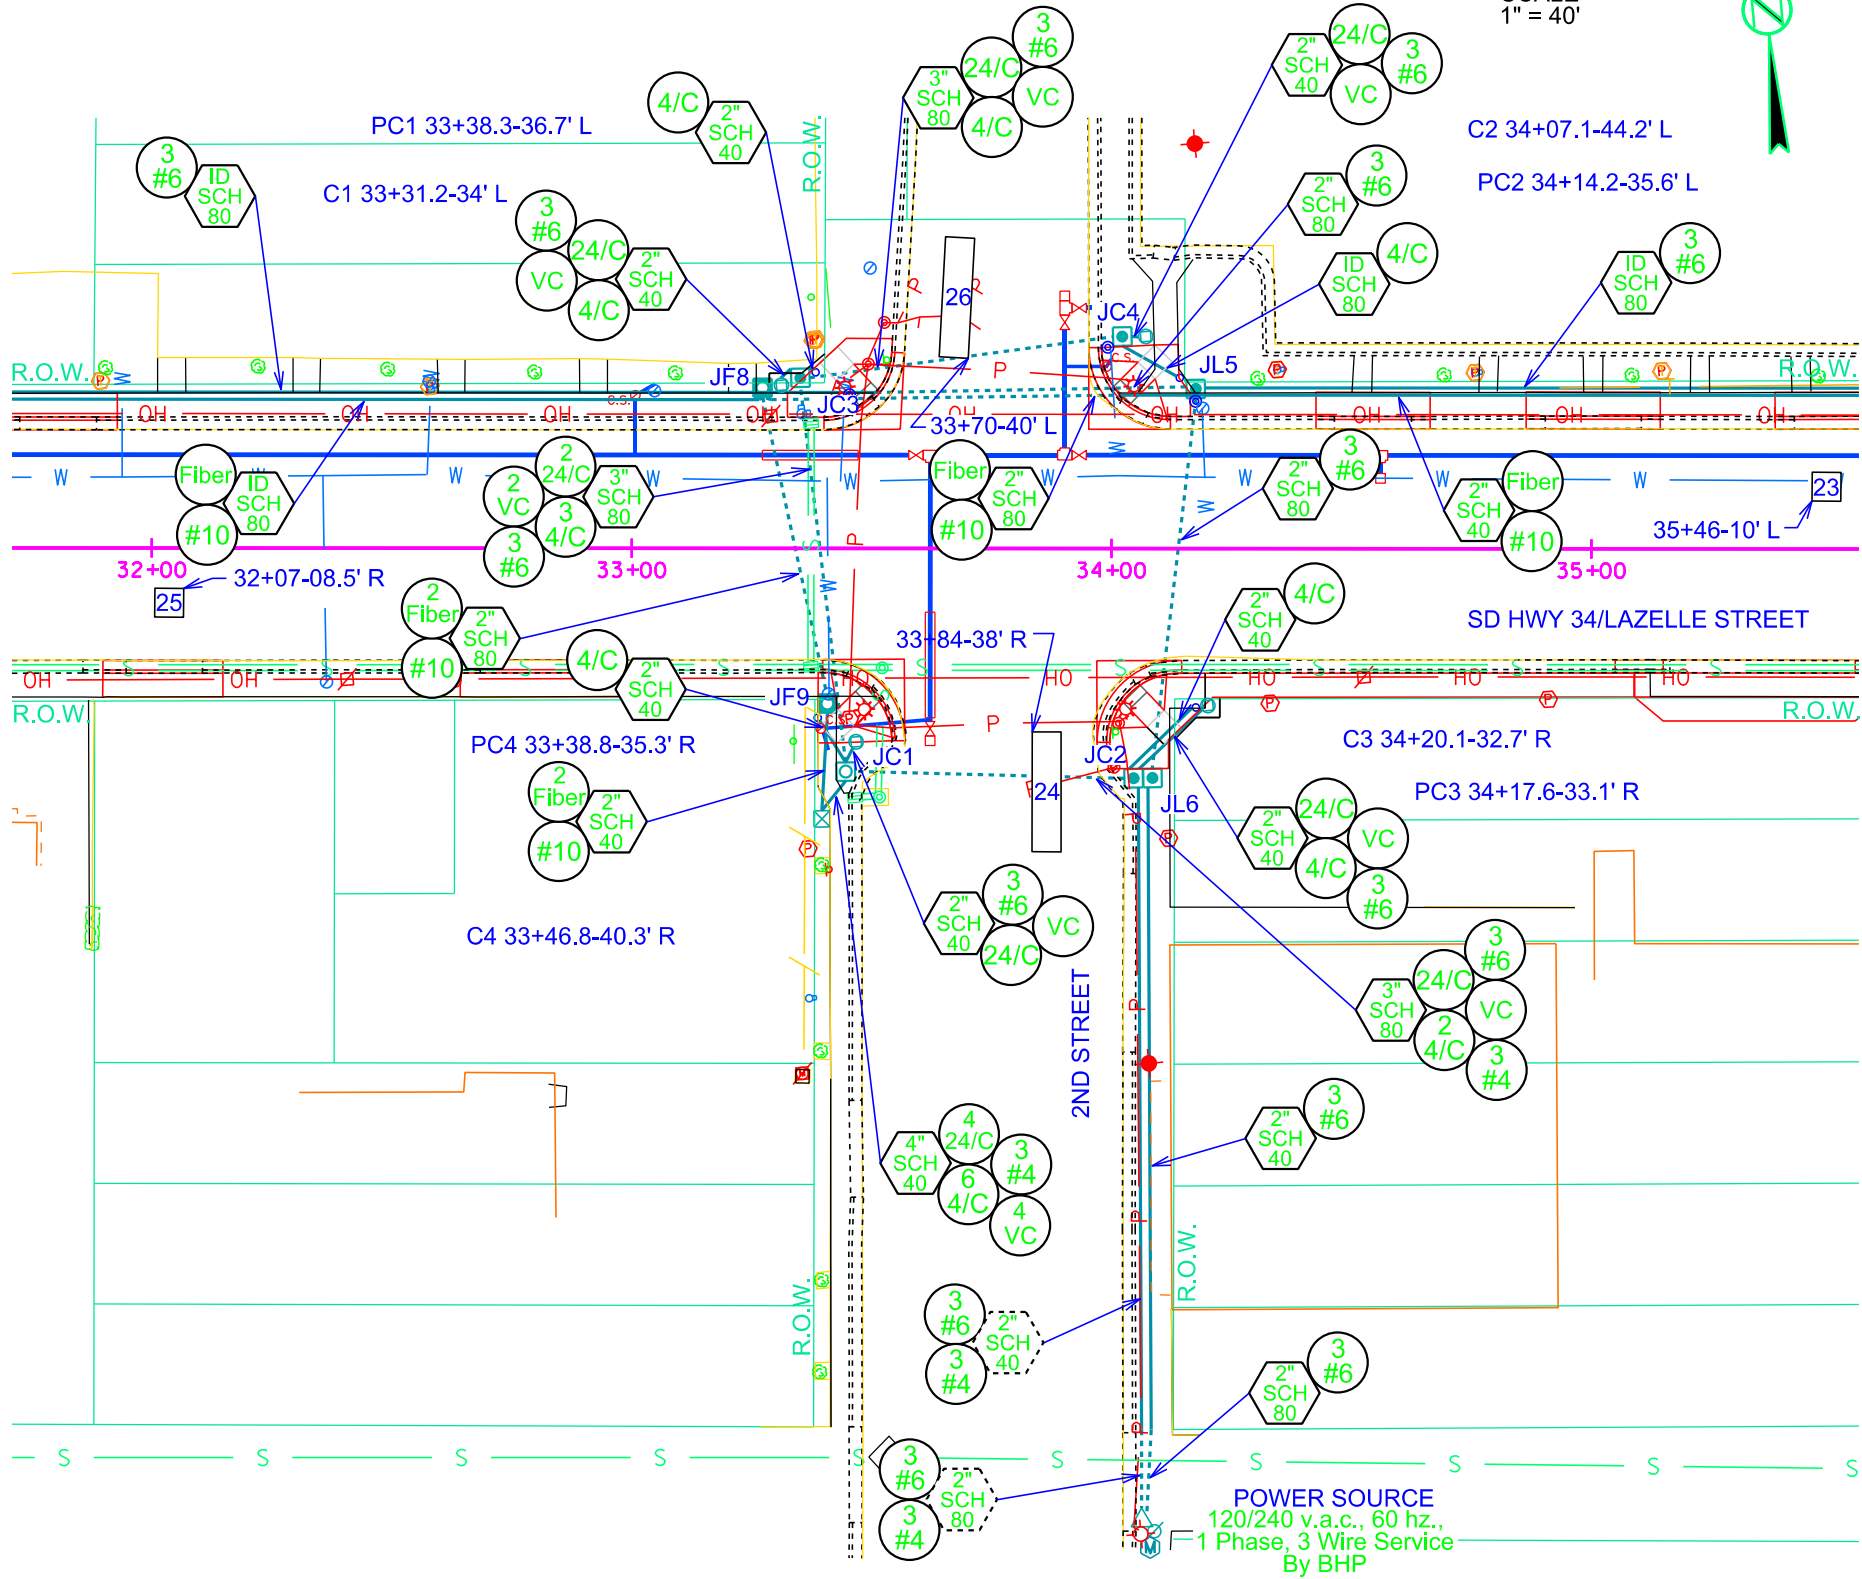

Plot Scale - 1:40

Plotted From - tpr14286



# EXISTING CONDUIT LAYOUT

## SD HWY 34/LAZELLE STREET & 1ST STREET

### EXISTING FIBER PATH


STATE OF SOUTH DAKOTA	PROJECT	SHEET	TOTAL SHEETS
	P 034-451	84	107

Plotting Date: 04/02/2014      Revised Date: 07/16/2013      SB

THIS SHEET HAS BEEN REVISED TO  
REFLECT CONSTRUCTION AS-BUILTS

KEY	ITEM
	GALVANIZED STEEL UTILITY POLE NOT A BID ITEM
	3' DIAMETER FOOTING (L15,L16)
	ELECTRICAL SERVICE CABINET
	METER SOCKET NOT A BID ITEM
	2" RIGID CONDUIT, SCHEDULE 40
	1/C #4 AWG COPPER WIRE

SCALE  
1" = 40'

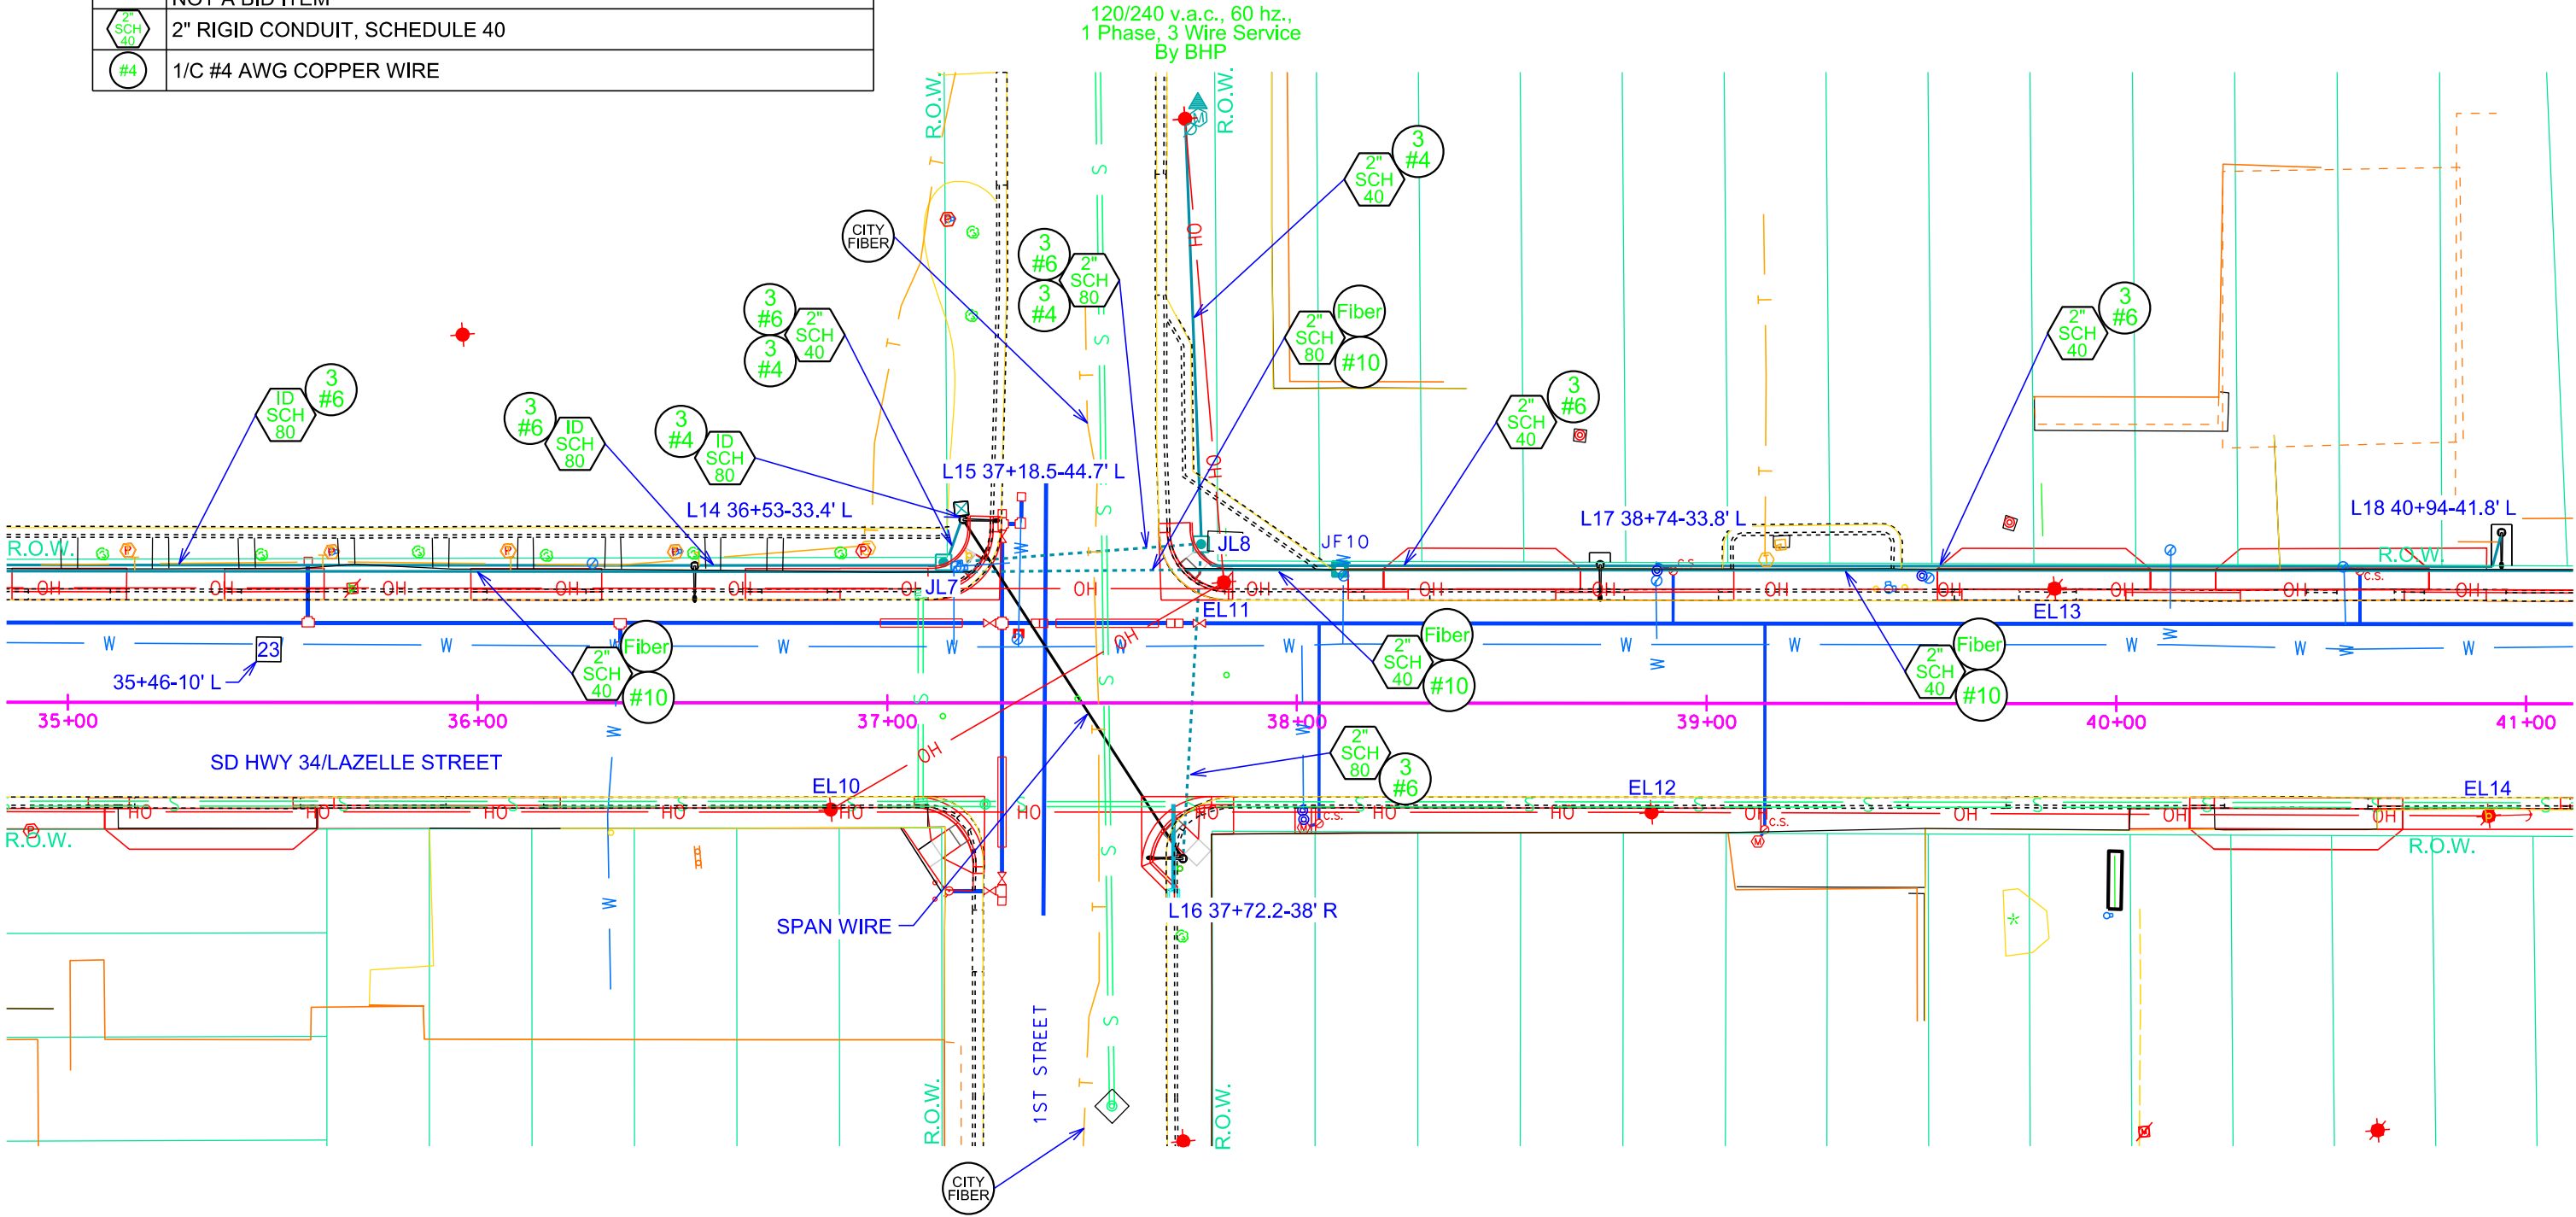

Plot Scale - 1:40

Plotted From - tpr14286



Plot Scale - 1"=40'

Plotted From - Imp14286

# EXISTING CONDUIT LAYOUT

## SD HWY 34/LAZELLE STREET & JUNCTION AVENUE

### CAMERA 13 & SWITCH I EXISTING FIBER PATH

STATE OF SOUTH DAKOTA	PROJECT	SHEET	TOTAL SHEETS
	P 034-451	85	107


Plotting Date: 04/02/2014 Revised Date: 01/31/2014 SB

THIS SHEET HAS BEEN REVISED TO  
REFLECT CONSTRUCTION AS-BUILTS



SCALE  
1" = 40'

EXISTING SIGNAL EQUIPMENT	
KEY	ITEM
	POWER POLE
	WOOD UTILITY POLE
	JUNCTION BOX (EJD3)
	ELECTRICAL SERVICE CABINET
	METER SOCKET
	2" RIGID CONDUIT, SCHEDULE 40
	4" RIGID CONDUIT, SCHEDULE 40
	VIDEO DETECTION LOOP (34,38)
	VIDEO DETECTION LOOP (33,35,36,37,39)
	TRAFFIC SIGNAL CONTROLLER
	TYPE 1 ELECTRICAL JUNCTION BOX (JD2, JD3, JD4)
	TYPE 3 ELECTRICAL JUNCTION BOX (JD1)
	2" RIGID CONDUIT, SCHEDULE 40
	4" INNERDUCT, SCHEDULE 80
	1/C #4 AWG COPPER WIRE
	1/C #6 AWG COPPER WIRE
	4/C #14 AWG COPPER TRAY CABLE, K2
	7/C #14 AWG COPPER TRAY CABLE, K2
	12/C #14 AWG COPPER TRAY CABLE, K2
	24/C #14 AWG COPPER TRAY CABLE, K2
	VIDEO CABLE NOT A BID ITEM
	OUTDOOR RATED CATEGORY 5 CABLE
	MISCELLANEOUS, ELECTRICAL (OUTLETS ON ED1 & ED4)

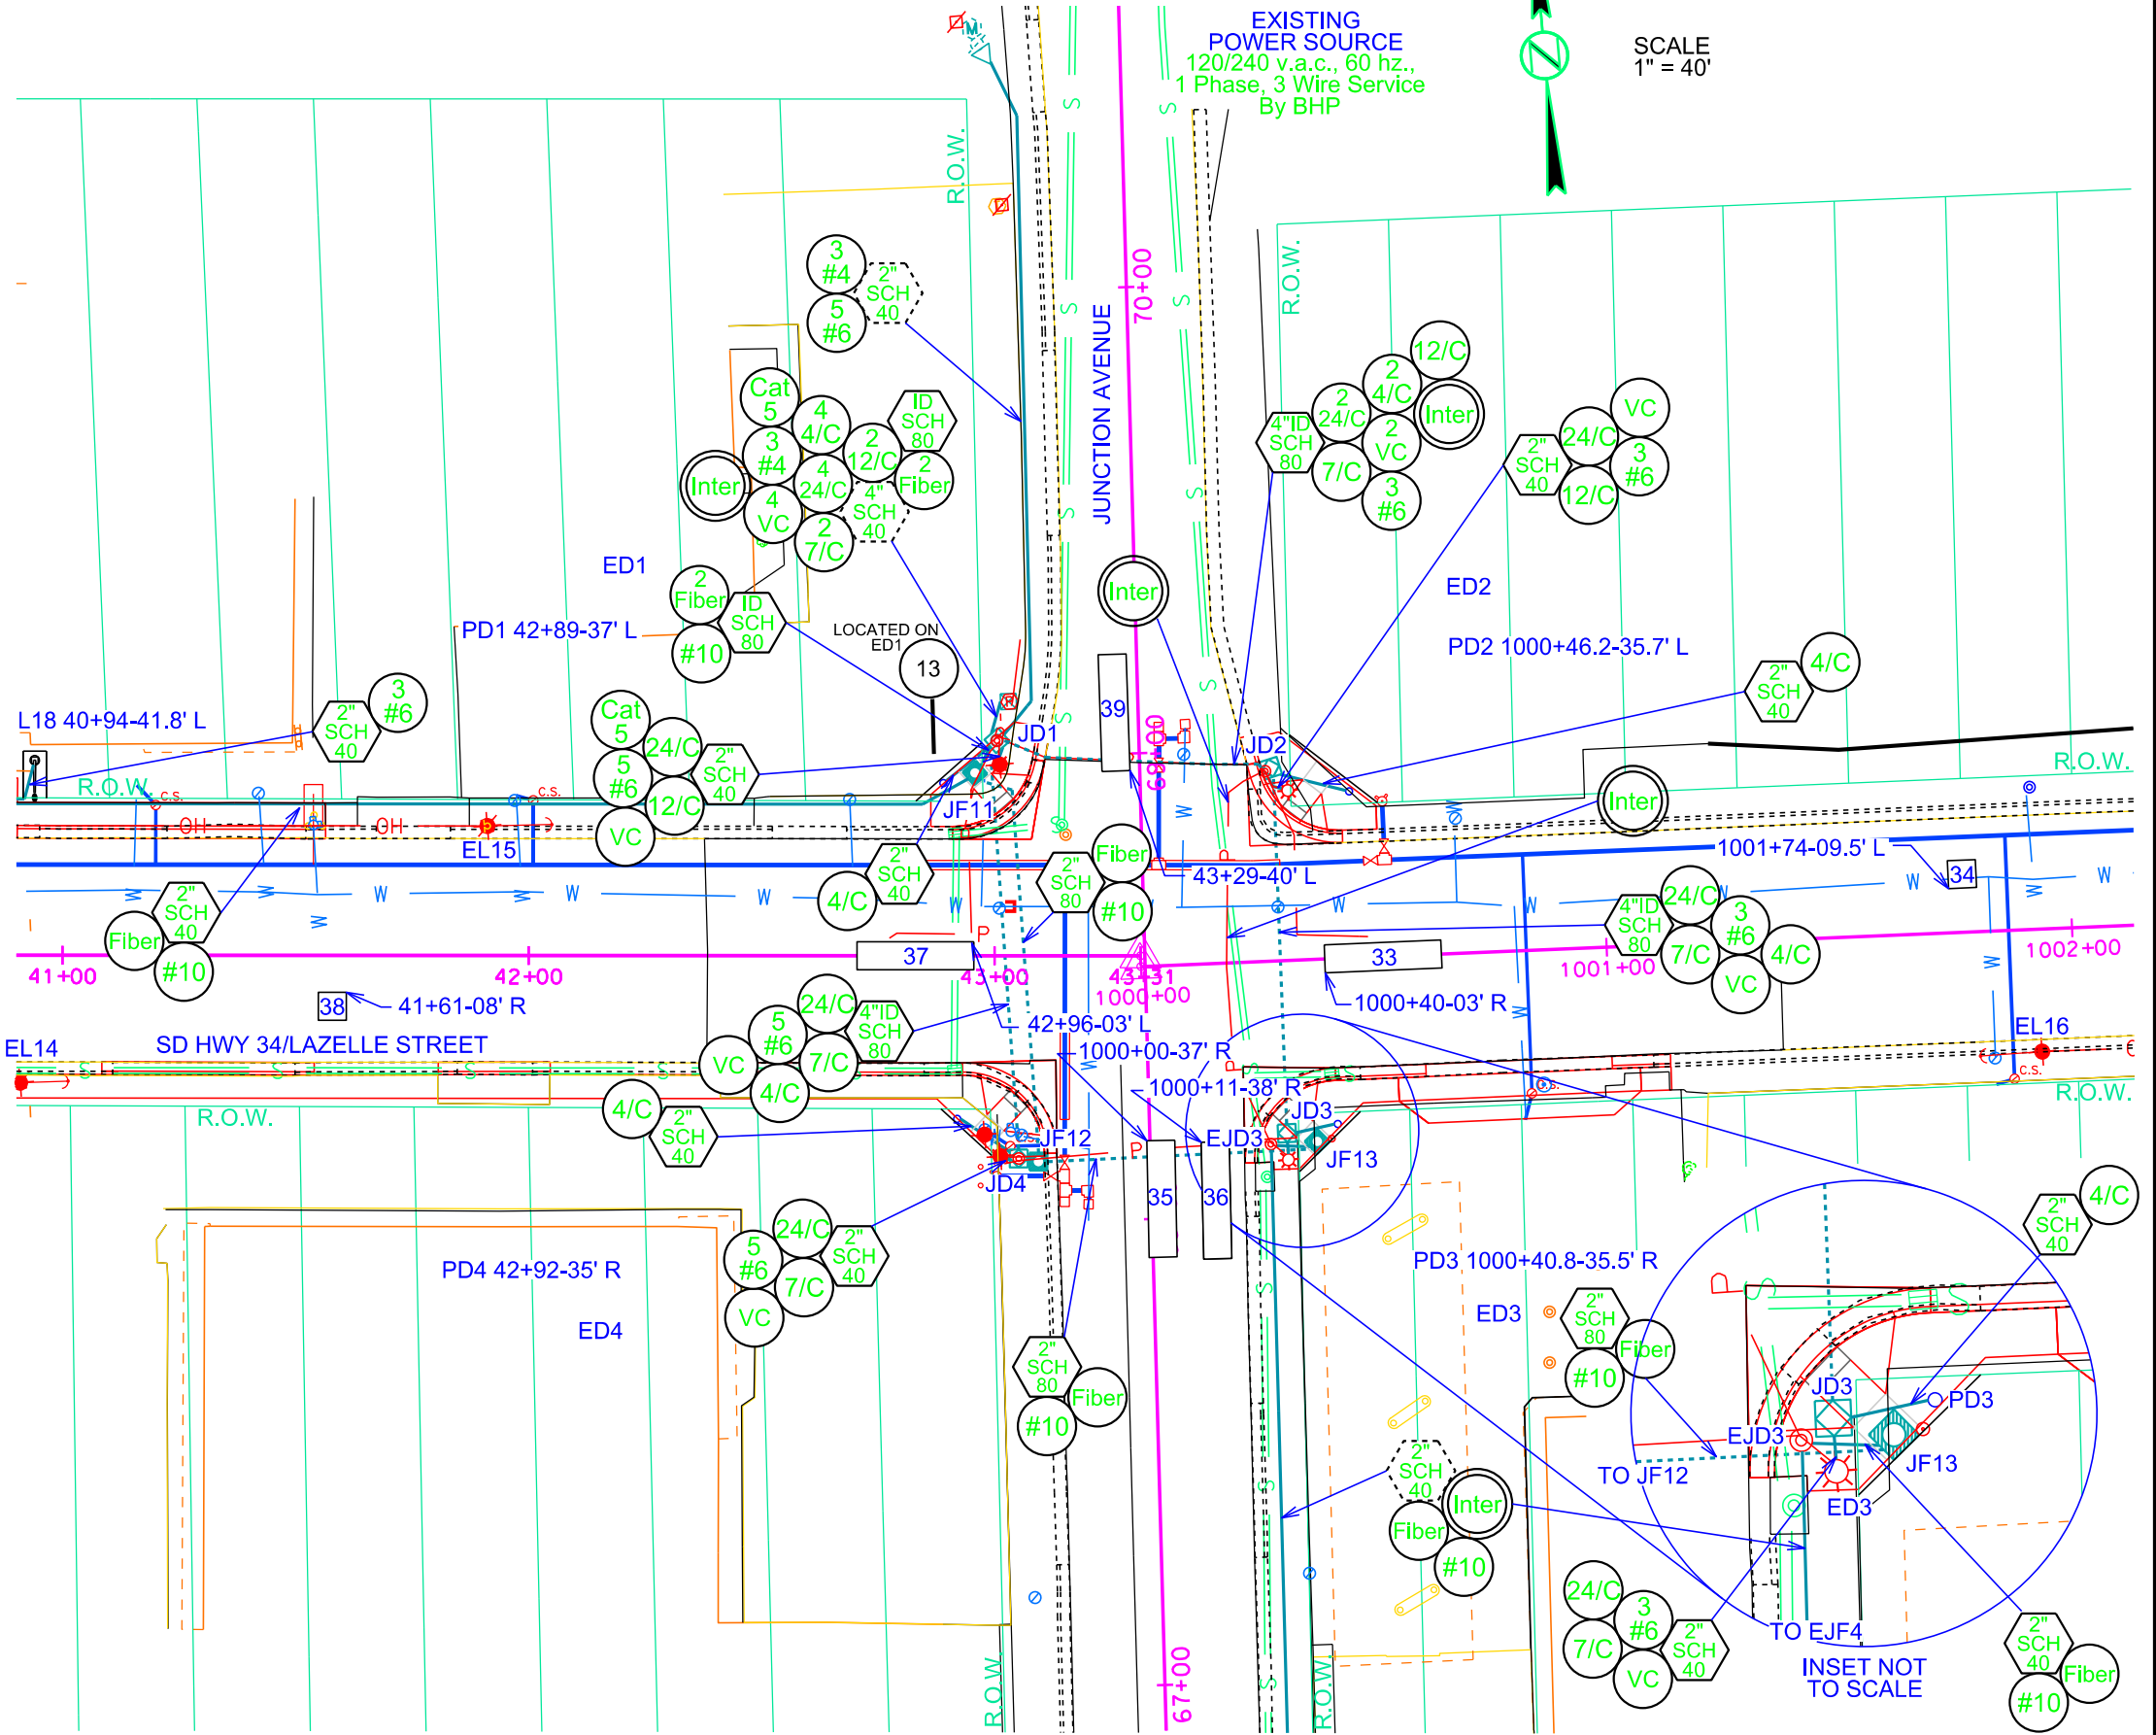



# EXISTING CONDUIT LAYOUT

## SD HWY 79/JUNCTION AVENUE


### CAMERAS 14 - 17 & SWITCHES A,J&P EXISTING FIBER PATH

STATE OF SOUTH DAKOTA	PROJECT P 034-451	SHEET 86	TOTAL SHEETS 107
Plotting Date: 04/02/2014			



SCALE  
1" = 40'

Plot Scale - 1:40

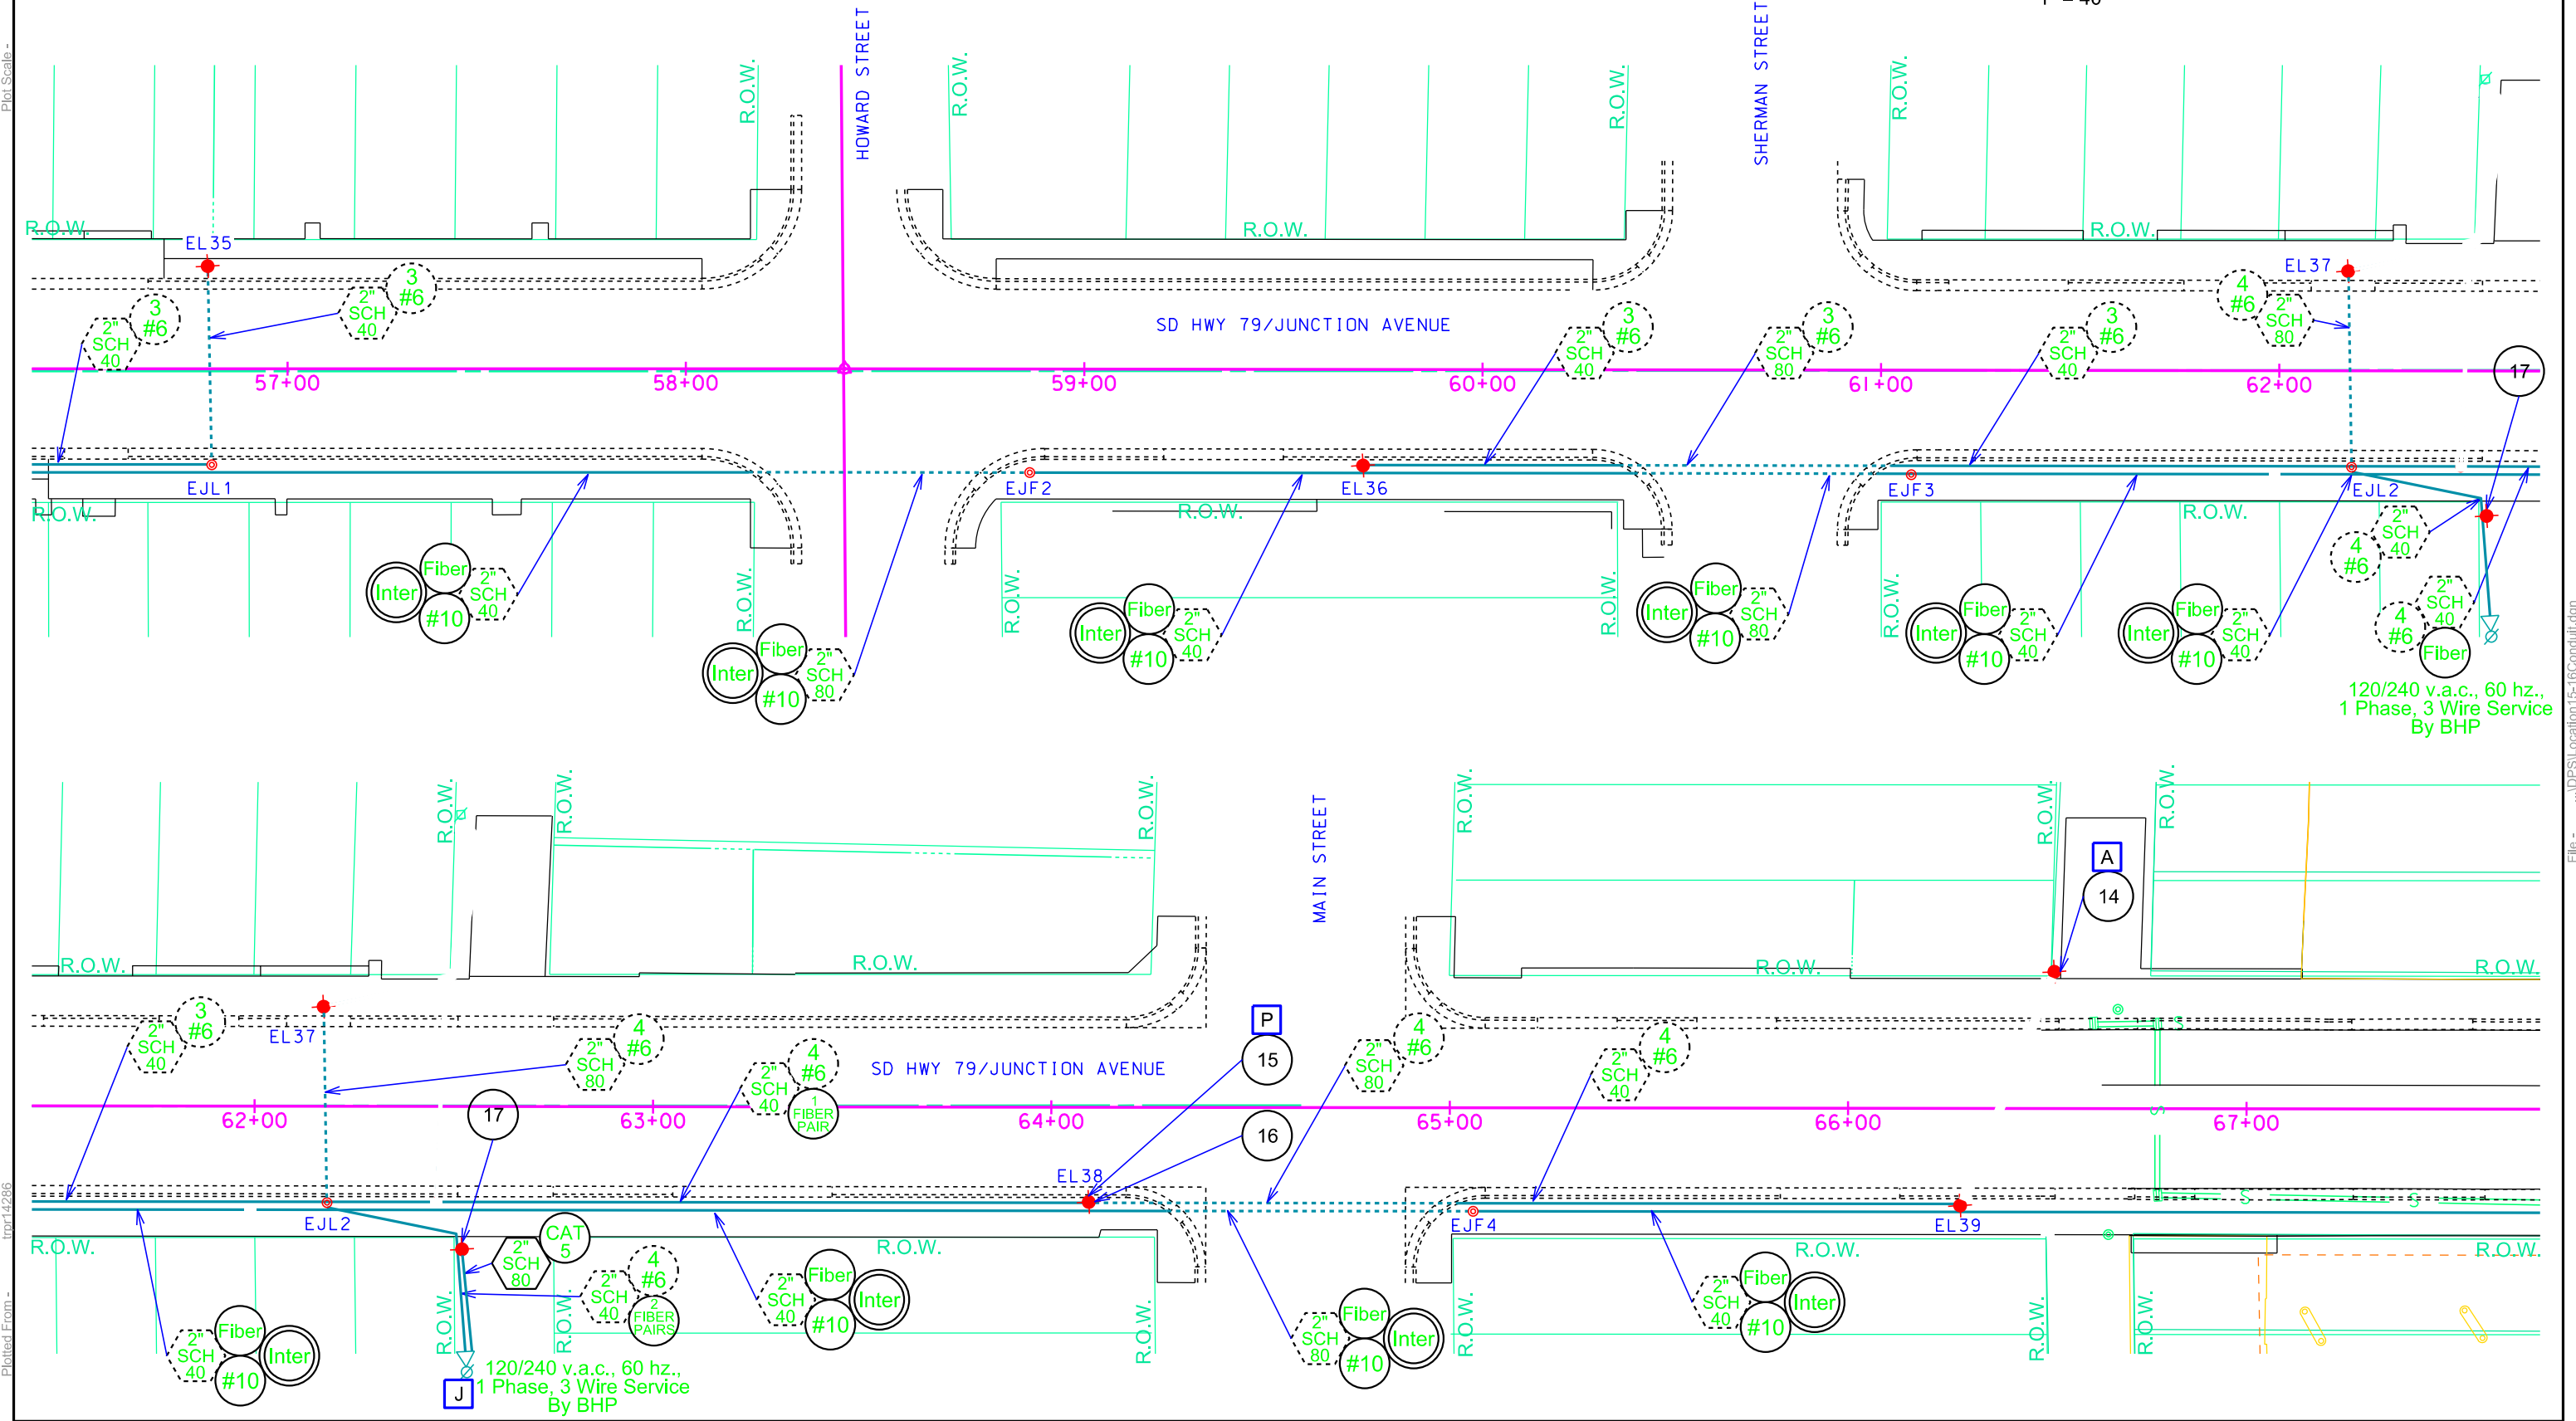

Plotted From - Imp14286

File - ...DPS\Location\15-16Conduit.dgn



Plot Scale - 1"=40'

Plotted From - tpr14286

# EXISTING CONDUIT LAYOUT

## SD HWY 79/JUNCTION AVENUE

### EXISTING FIBER PATH

STATE OF SOUTH DAKOTA	PROJECT	SHEET	TOTAL SHEETS
	P 034-451	87	107

Plotting Date: 04/02/2014 Revised Date: 07/16/2013 SB


THIS SHEET HAS BEEN REVISED TO  
REFLECT CONSTRUCTION AS-BUILTS



SCALE  
1" = 40'

AS-BUILT NOTE: NO SLACK IN FIBER FROM  
DOUGLAS STREET TO LAZELLE STREET

EXISTING ITEMS	
KEY	ITEM
	POWER POLE
	WOOD UTILITY POLE
	JUNCTION BOX (EJH1-EJH4)
	ELECTRICAL SERVICE CABINET
	METER SOCKET
	2" RIGID CONDUIT, SCHEDULE 40
	4" RIGID CONDUIT, SCHEDULE 40
	2" RIGID CONDUIT, SCHEDULE 80
	1/C # 4 AWG COPPER WIRE
	1/C #6 AWG COPPER WIRE
	7/C #14 AWG COPPER TRAY CABLE, K2
	19/C #14 AWG COPPER TRAY CABLE, K2
	#16 AWG COPPER TWISTED SHIELDED PAIR
	TRAFFIC SIGNAL CONTROLLER

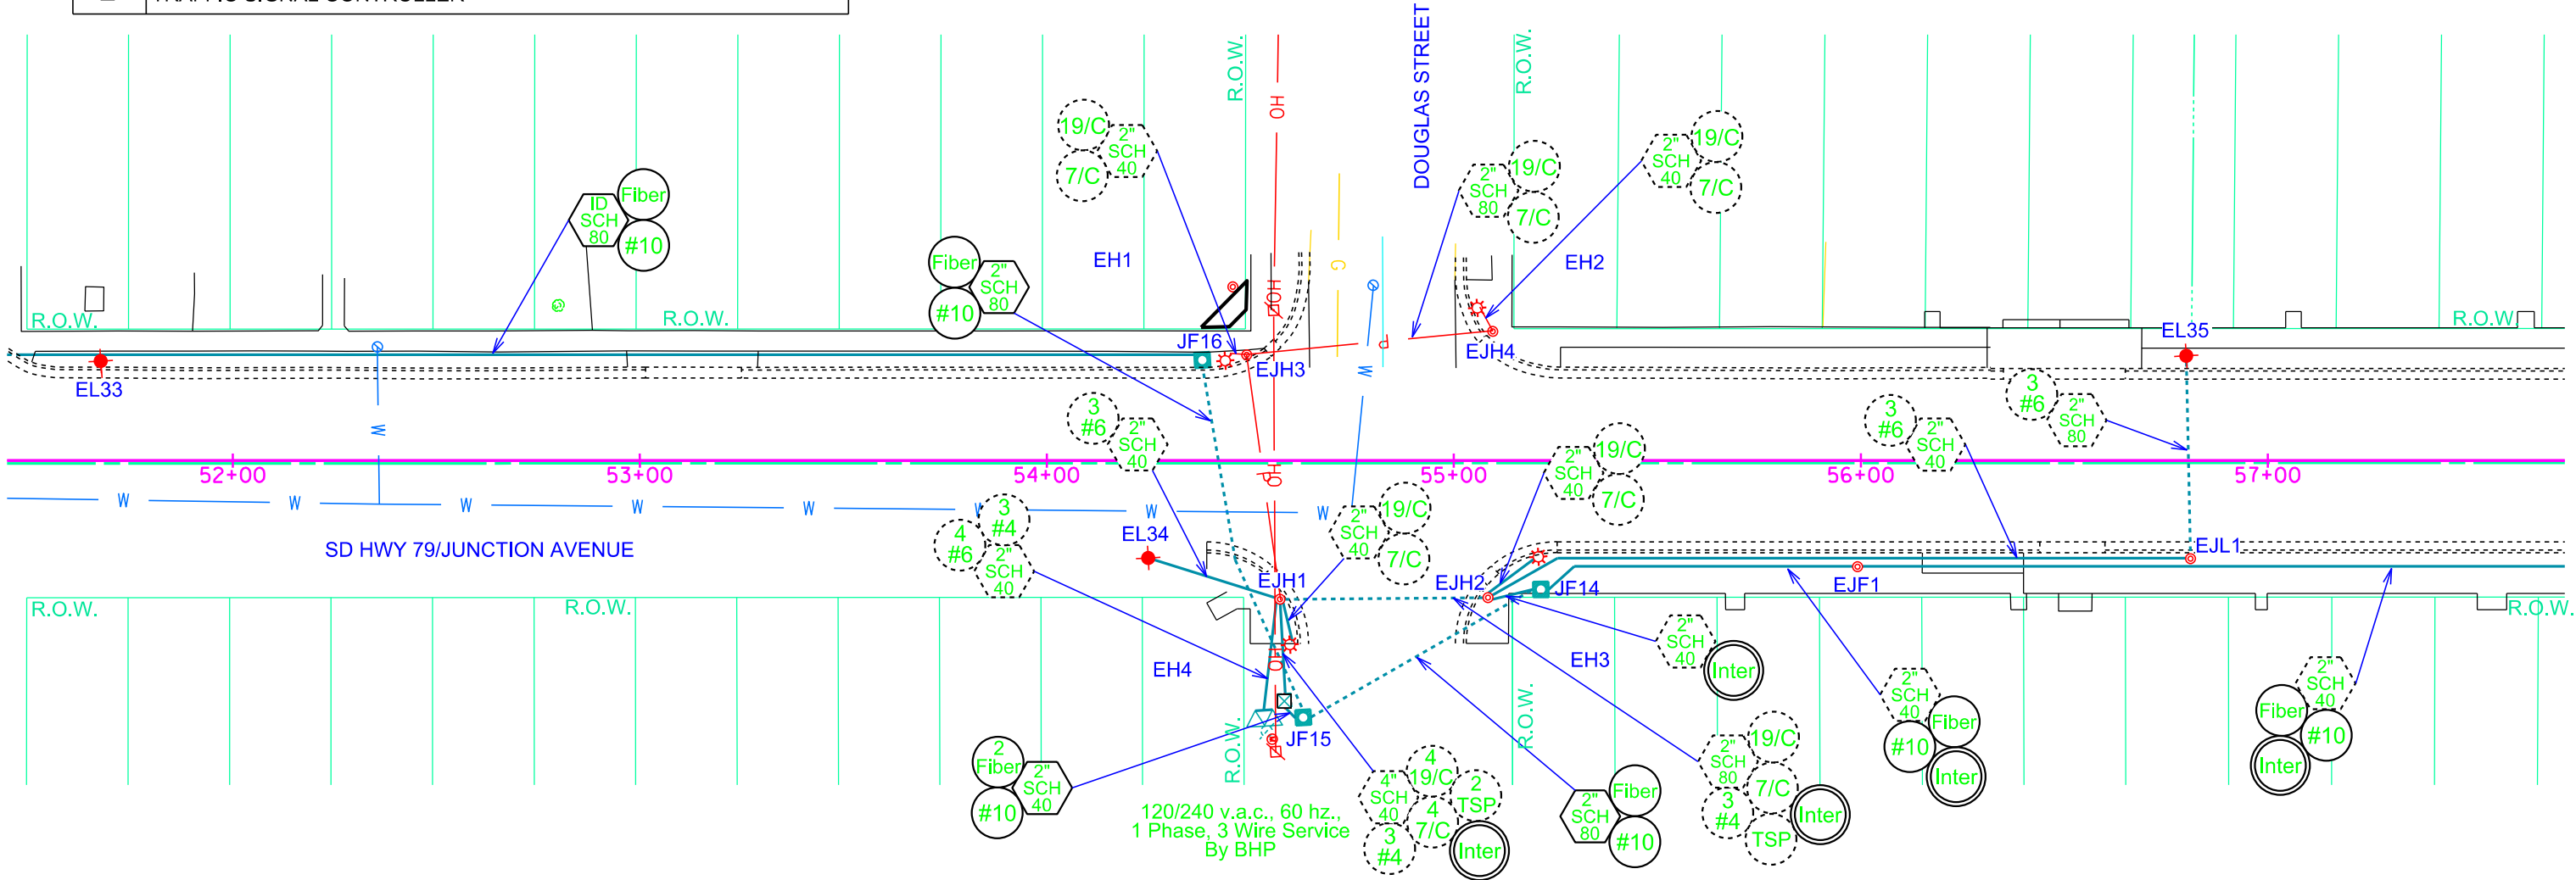




# EXISTING CONDUIT LAYOUT

## SD HWY 79/JUNCTION AVENUE EXISTING FIBER PATH


STATE OF SOUTH DAKOTA	PROJECT	SHEET	TOTAL SHEETS
	P 034-451	88	107

Plotting Date: 04/02/2014 Revised Date: 07/16/2013 SB

THIS SHEET HAS BEEN REVISED TO  
REFLECT CONSTRUCTION AS-BUILTS

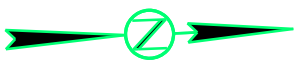

SCALE  
1" = 40'

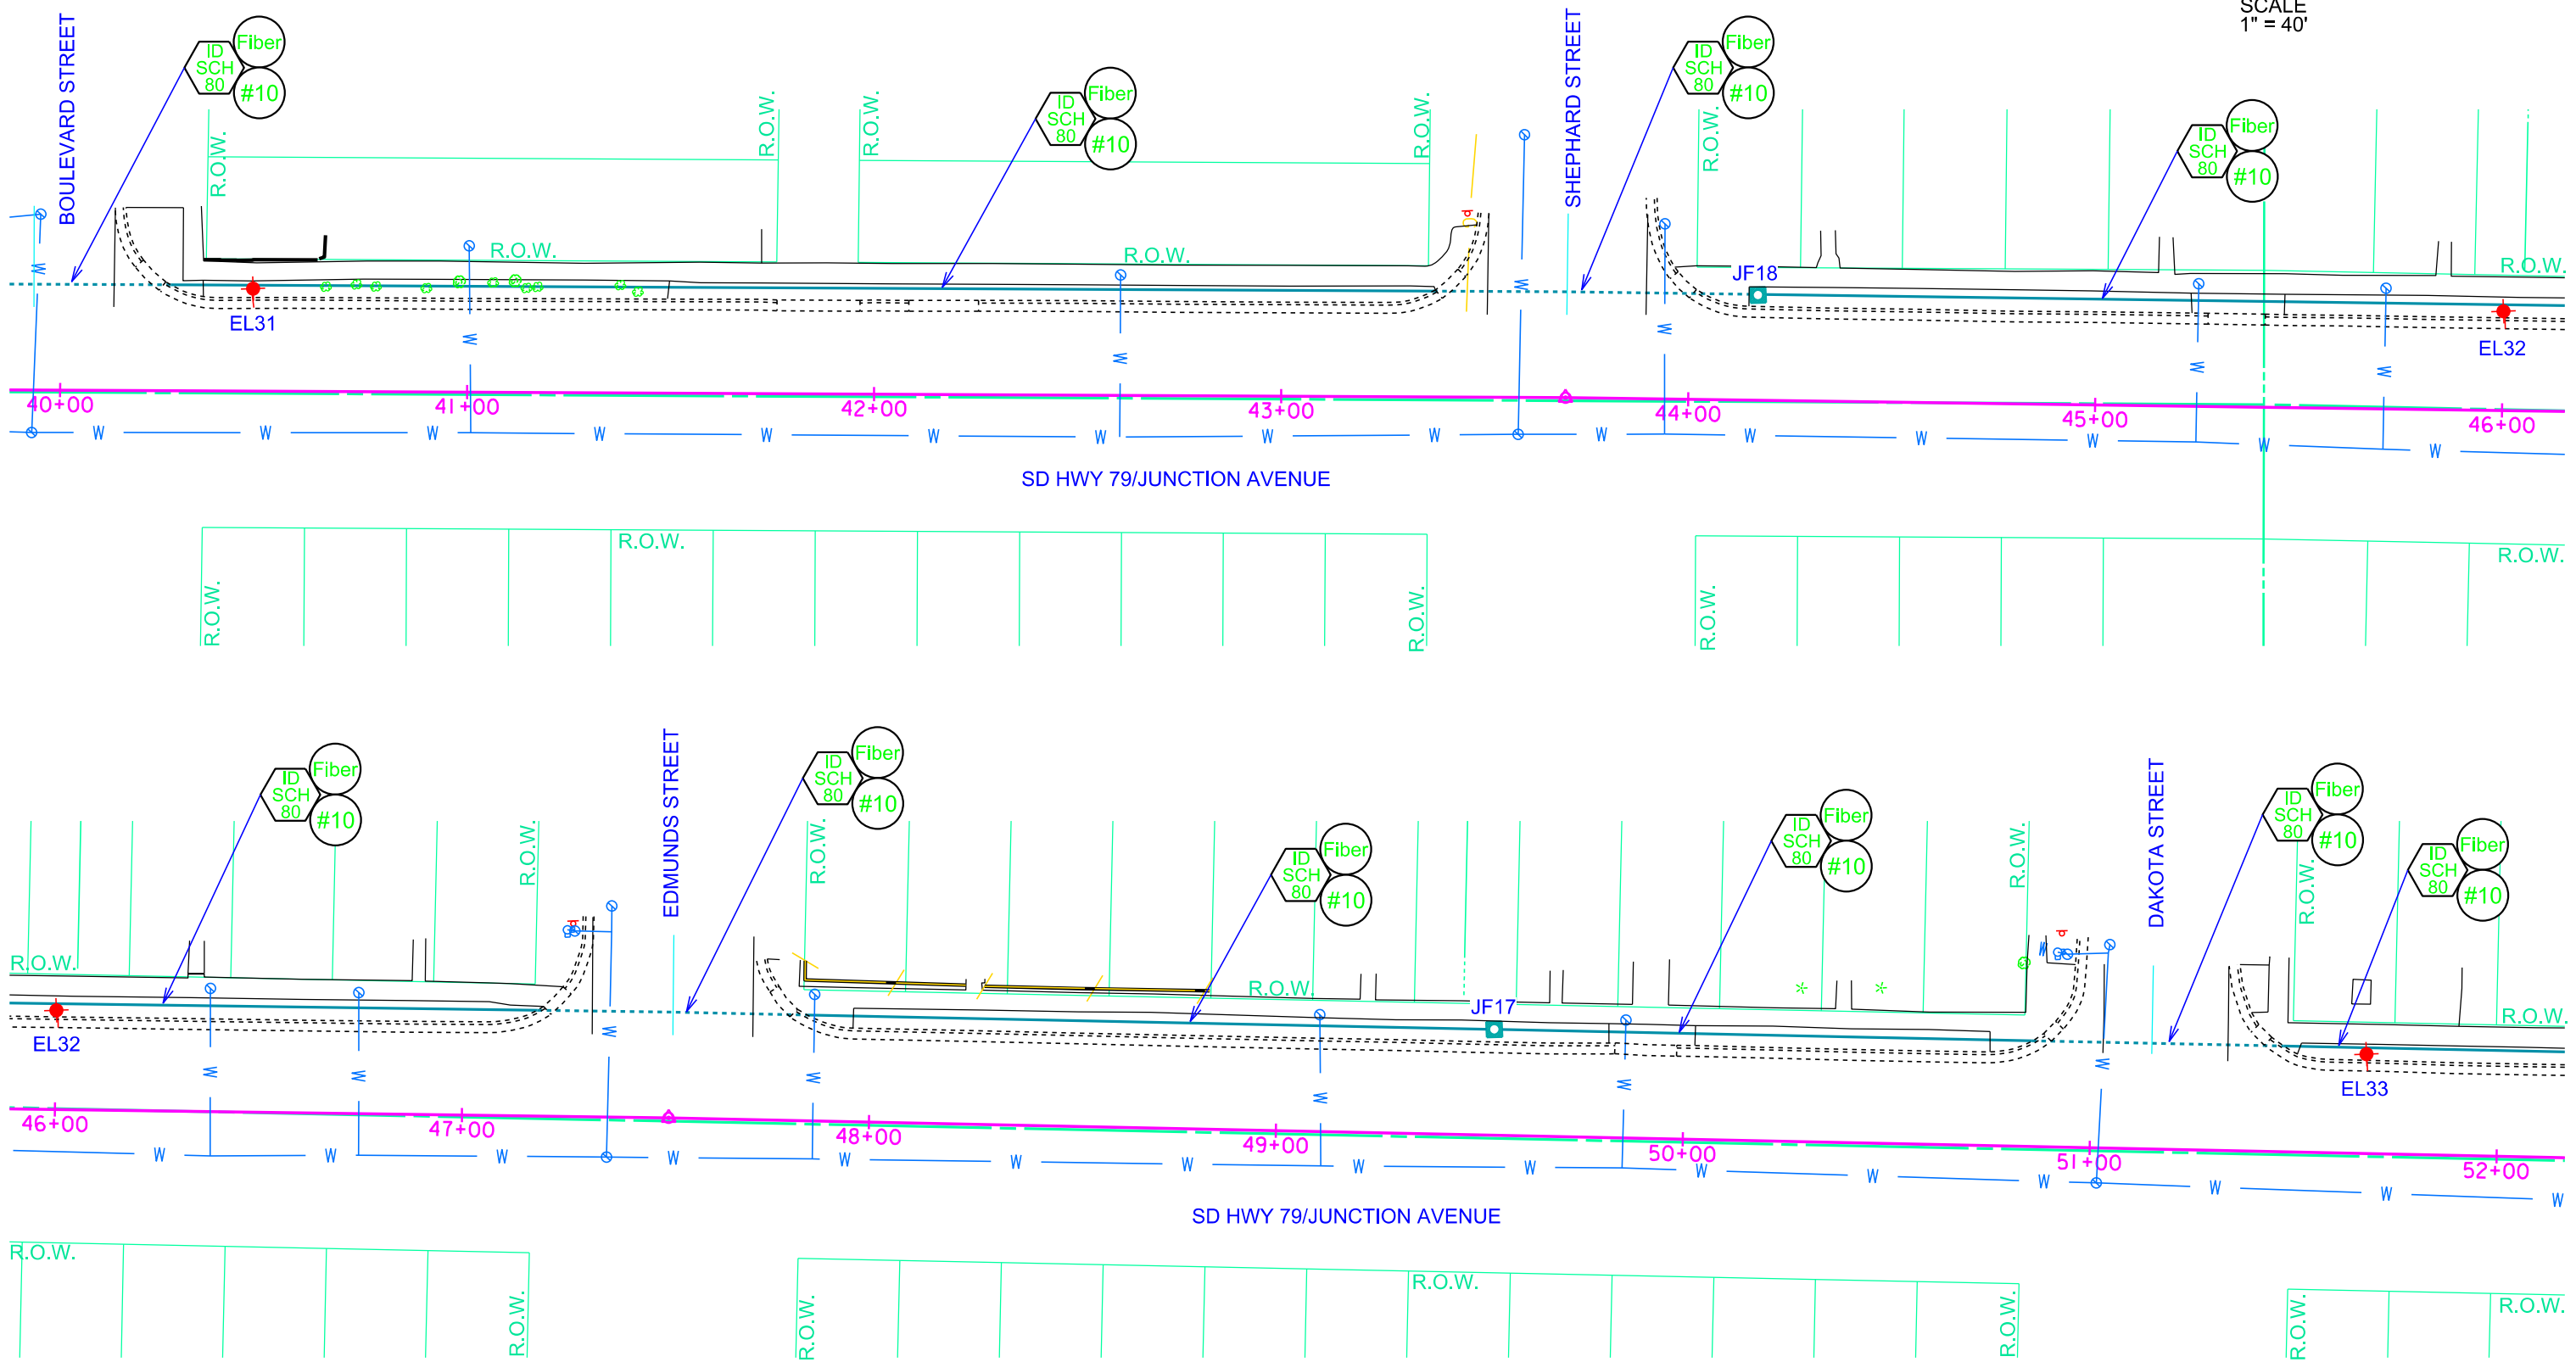

Plot Scale - 1:40

Plotted From - tpr14286



# EXISTING CONDUIT LAYOUT

## SD HWY 79/JUNCTION AVENUE EXISTING FIBER PATH


STATE OF SOUTH DAKOTA	PROJECT	SHEET	TOTAL SHEETS
	P 034-451	89	107

Plotting Date: 04/02/2014      Revised Date: 07/16/2013      SB

THIS SHEET HAS BEEN REVISED TO  
REFLECT CONSTRUCTION AS-BUILTS



SCALE  
1" = 40'

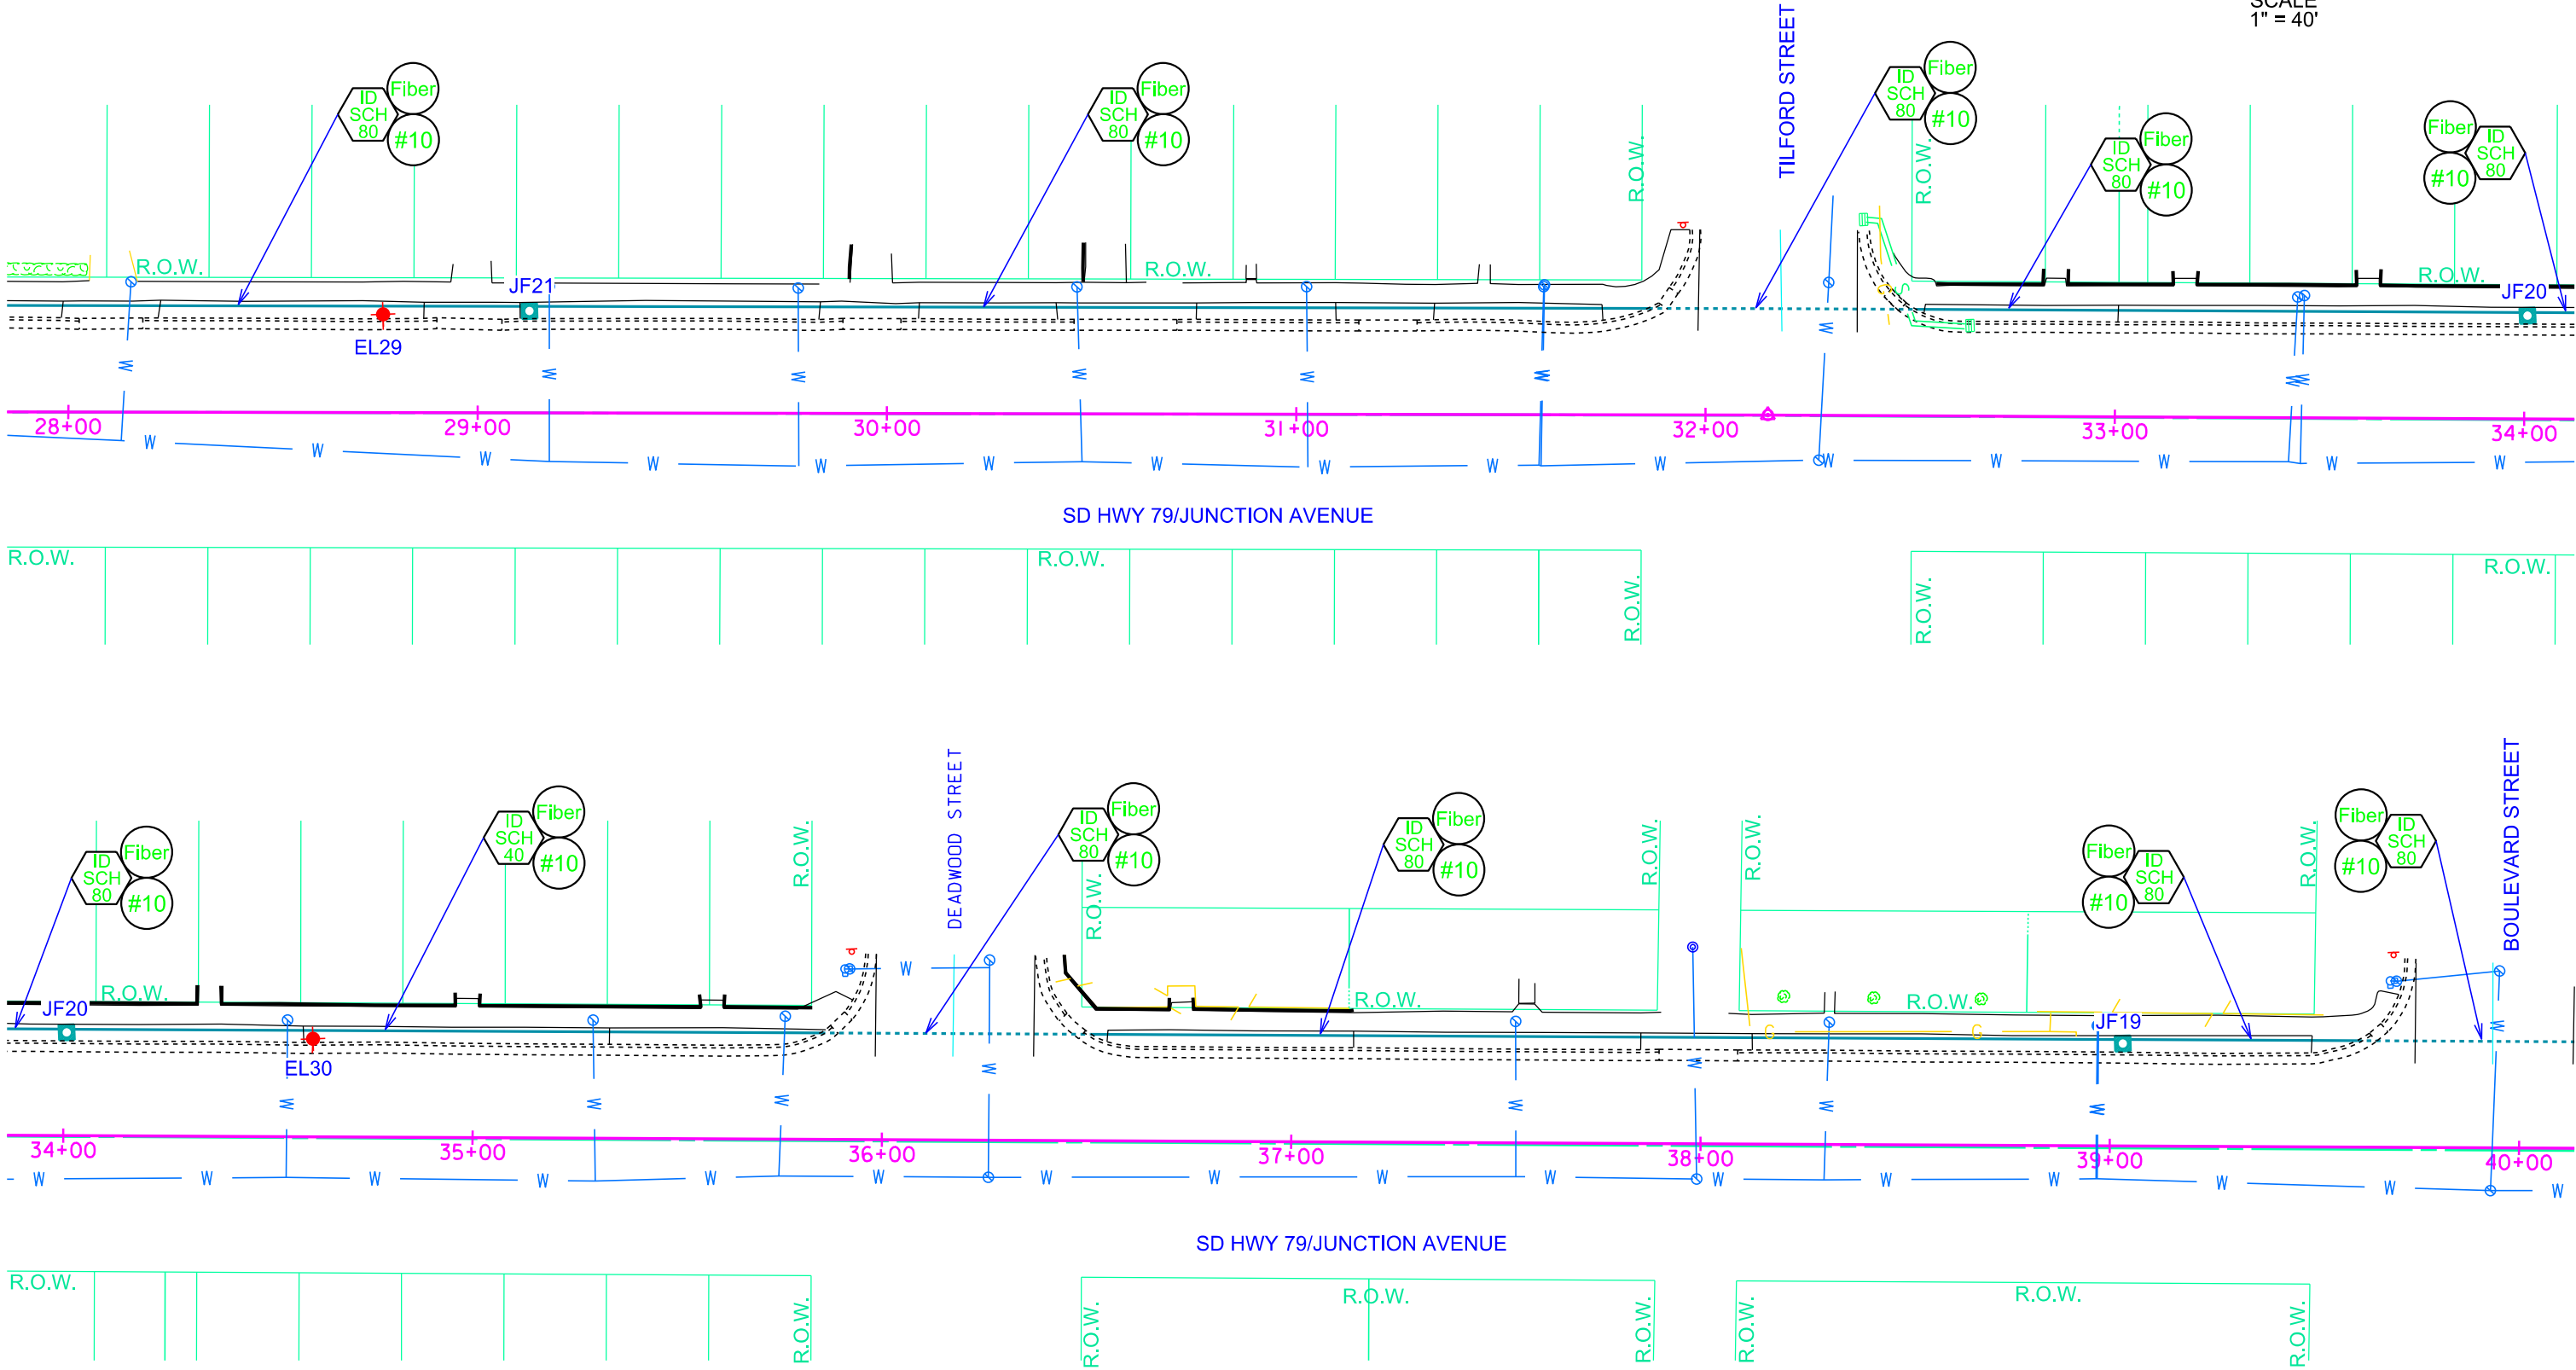

Plot Scale - 1:40

Plotted From - tpr14286



# EXISTING CONDUIT LAYOUT

## SD HWY 79/JUNCTION AVENUE EXISTING FIBER PATH

NOTE: ADDITIONAL CABLES EXIST IN THE CONDUIT  
AT THE BALLPARK STREET INTERSECTION  
THAT ARE NOT INDICATED ON PLAN SHEET.


STATE OF SOUTH DAKOTA	PROJECT	SHEET	TOTAL SHEETS
	P 034-451	90	107

Plotting Date: 04/02/2014      Revised Date: 07/16/2013      SB

THIS SHEET HAS BEEN REVISED TO  
REFLECT CONSTRUCTION AS-BUILTS



SCALE  
1" = 40'

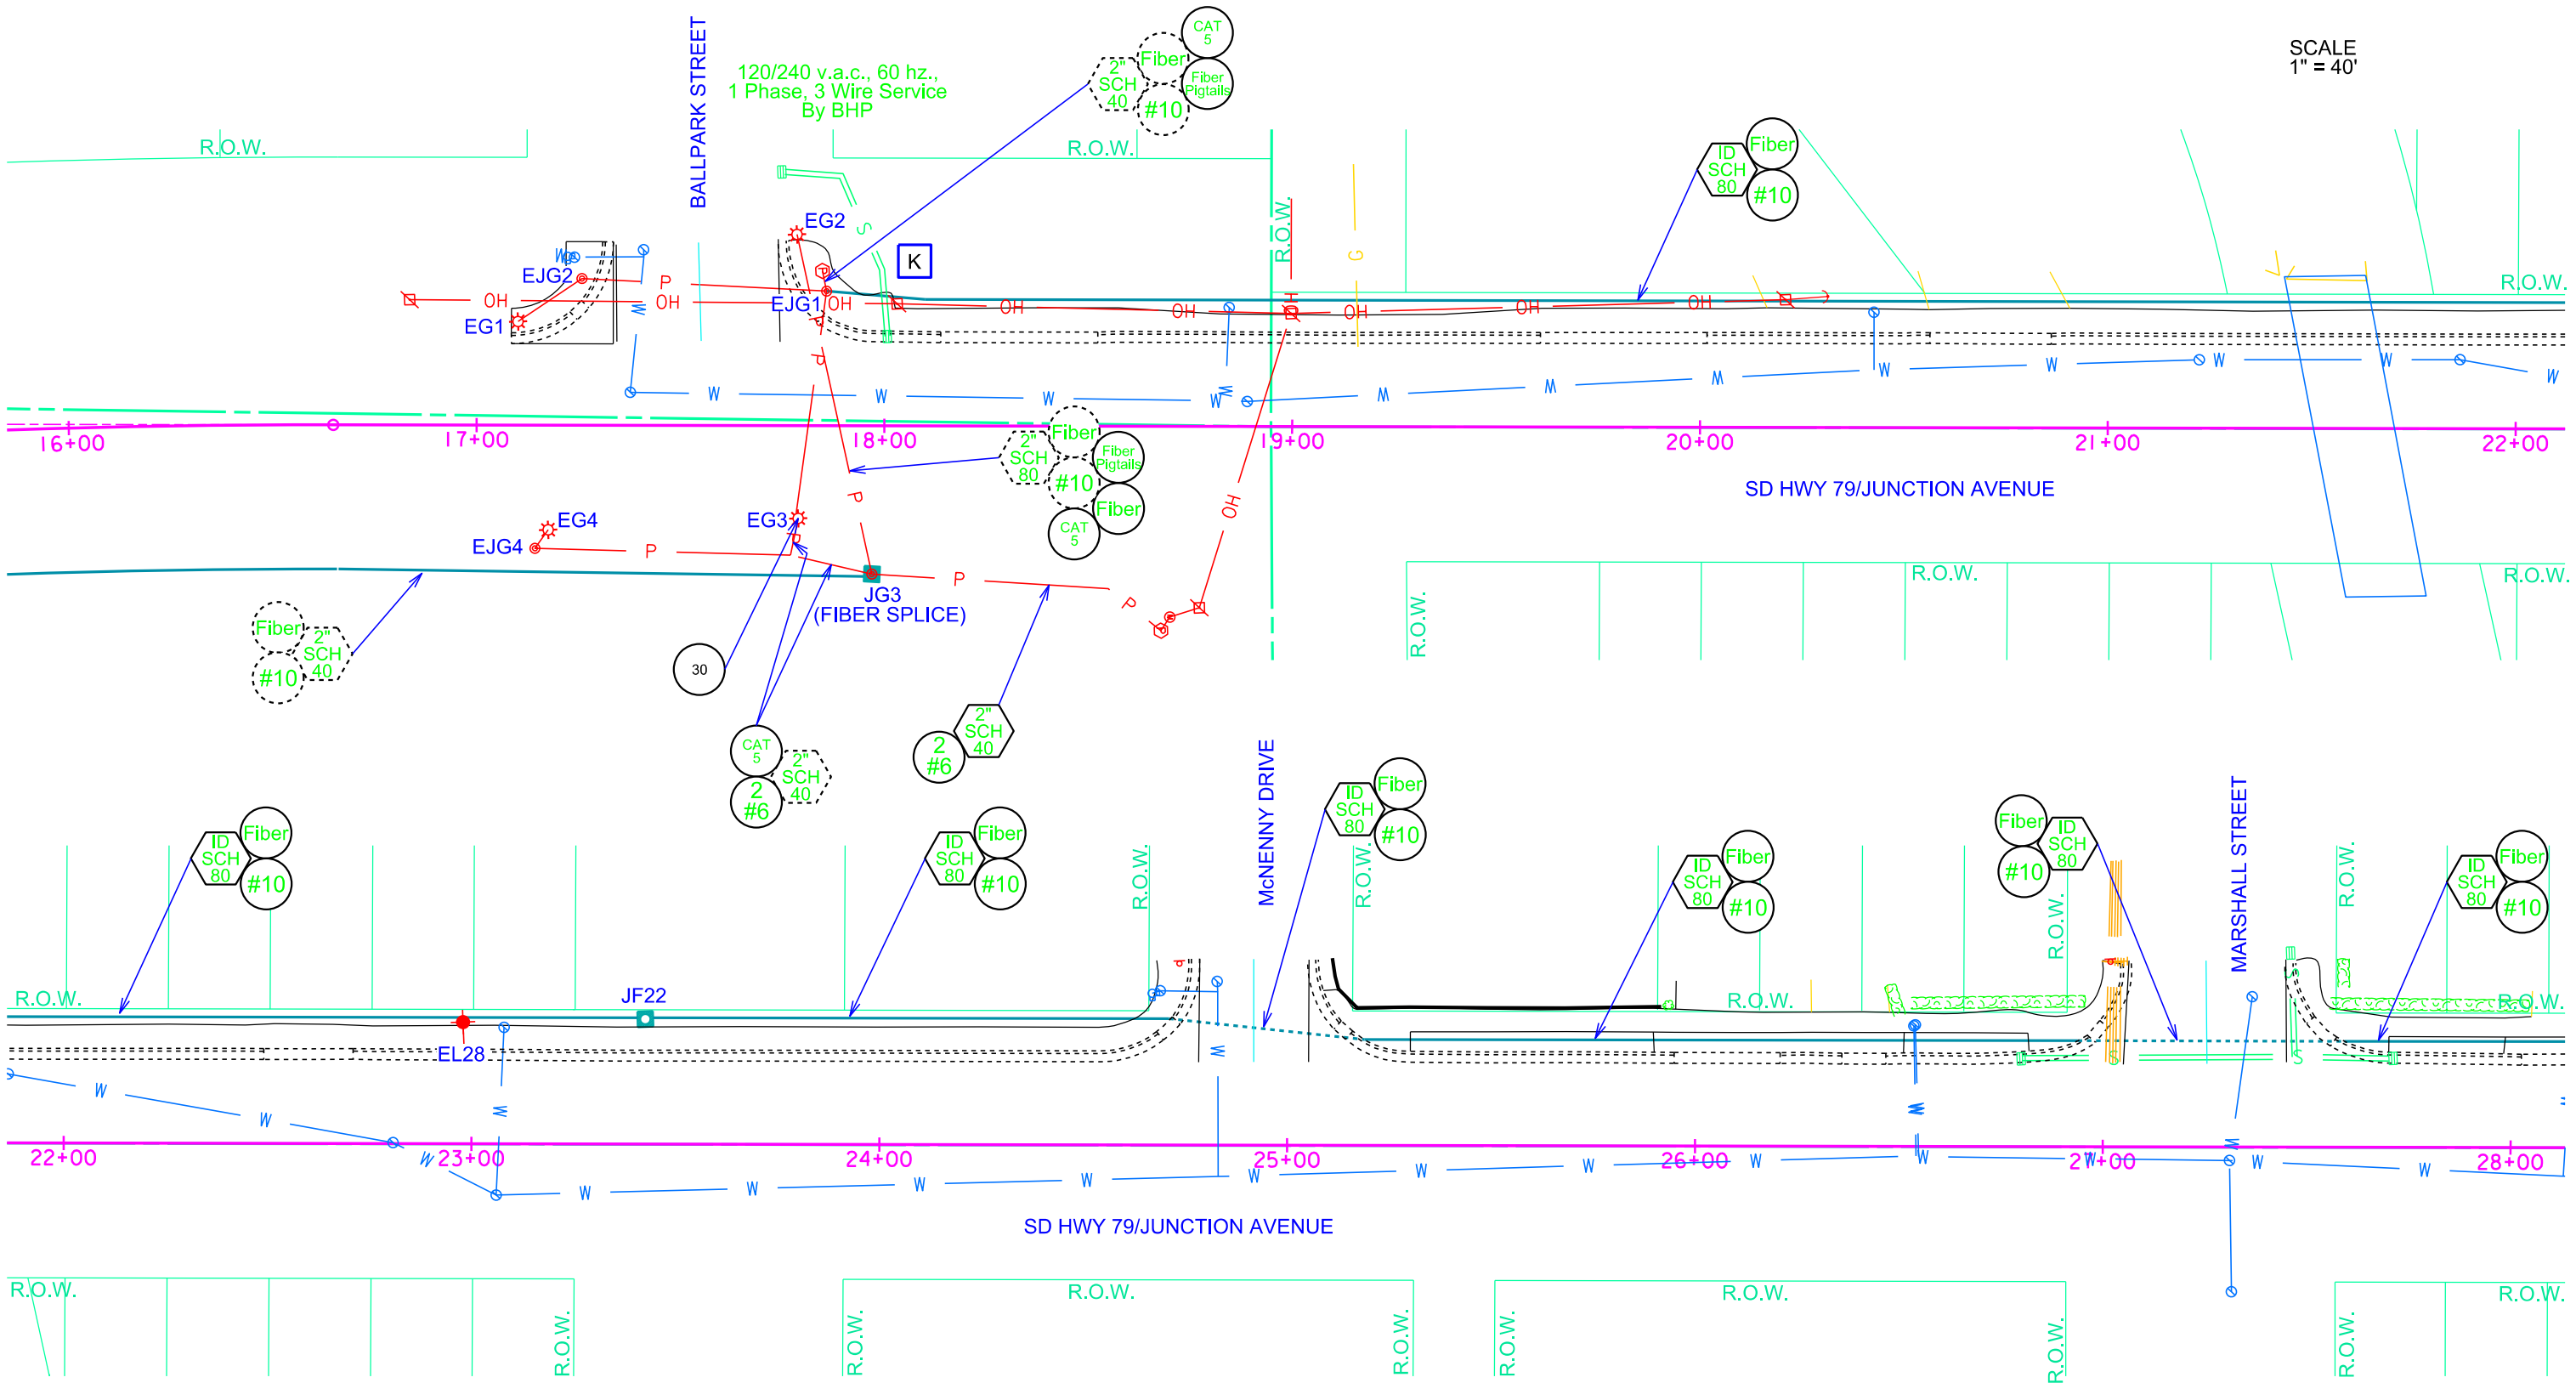


Plot Scale - 1:40

Plotted From - tpr14286




## JUNCTION AVENUE EXISTING FIBER PATH

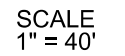Plotting Date: 04/02/2014



Plot Scale - 1"=40'

Plotted From - tpr14286

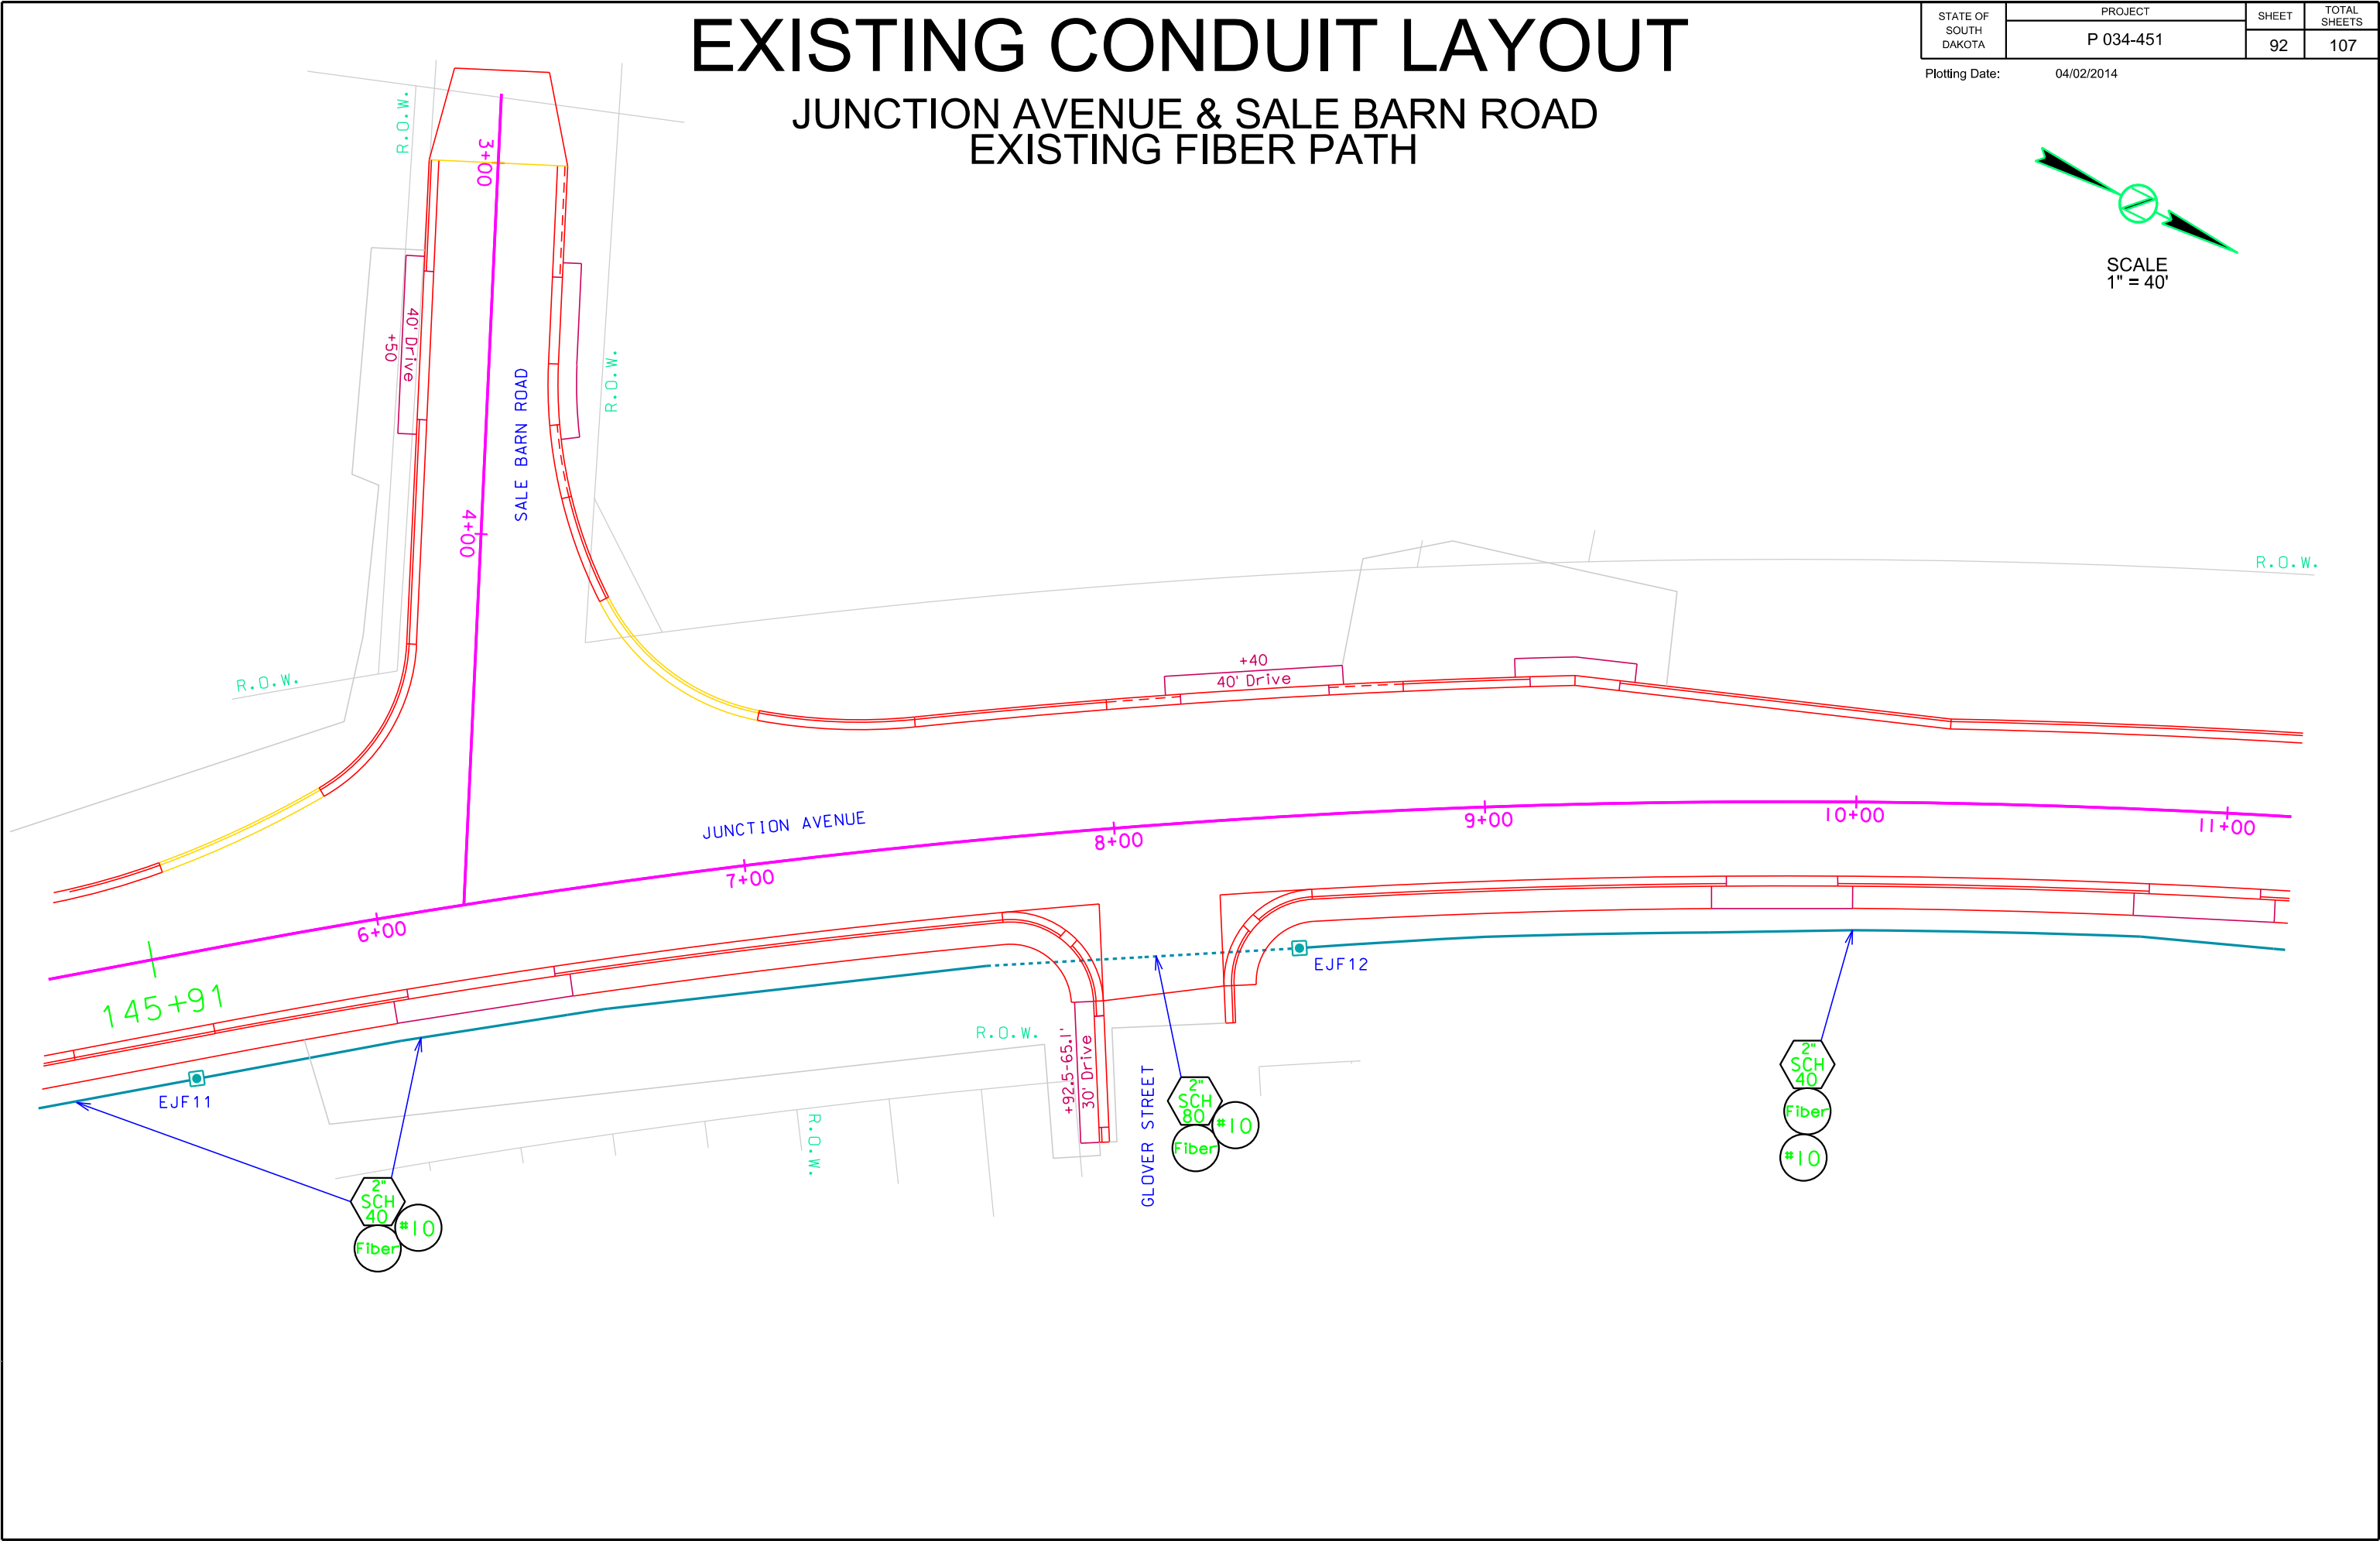





# EXISTING CONDUIT LAYOUT

## JUNCTION AVENUE & ANNA STREET

### EXISTING FIBER PATH

STATE OF SOUTH DAKOTA	PROJECT	SHEET	TOTAL SHEETS
	P 034-451	93	107

Plotting Date: 04/02/2014

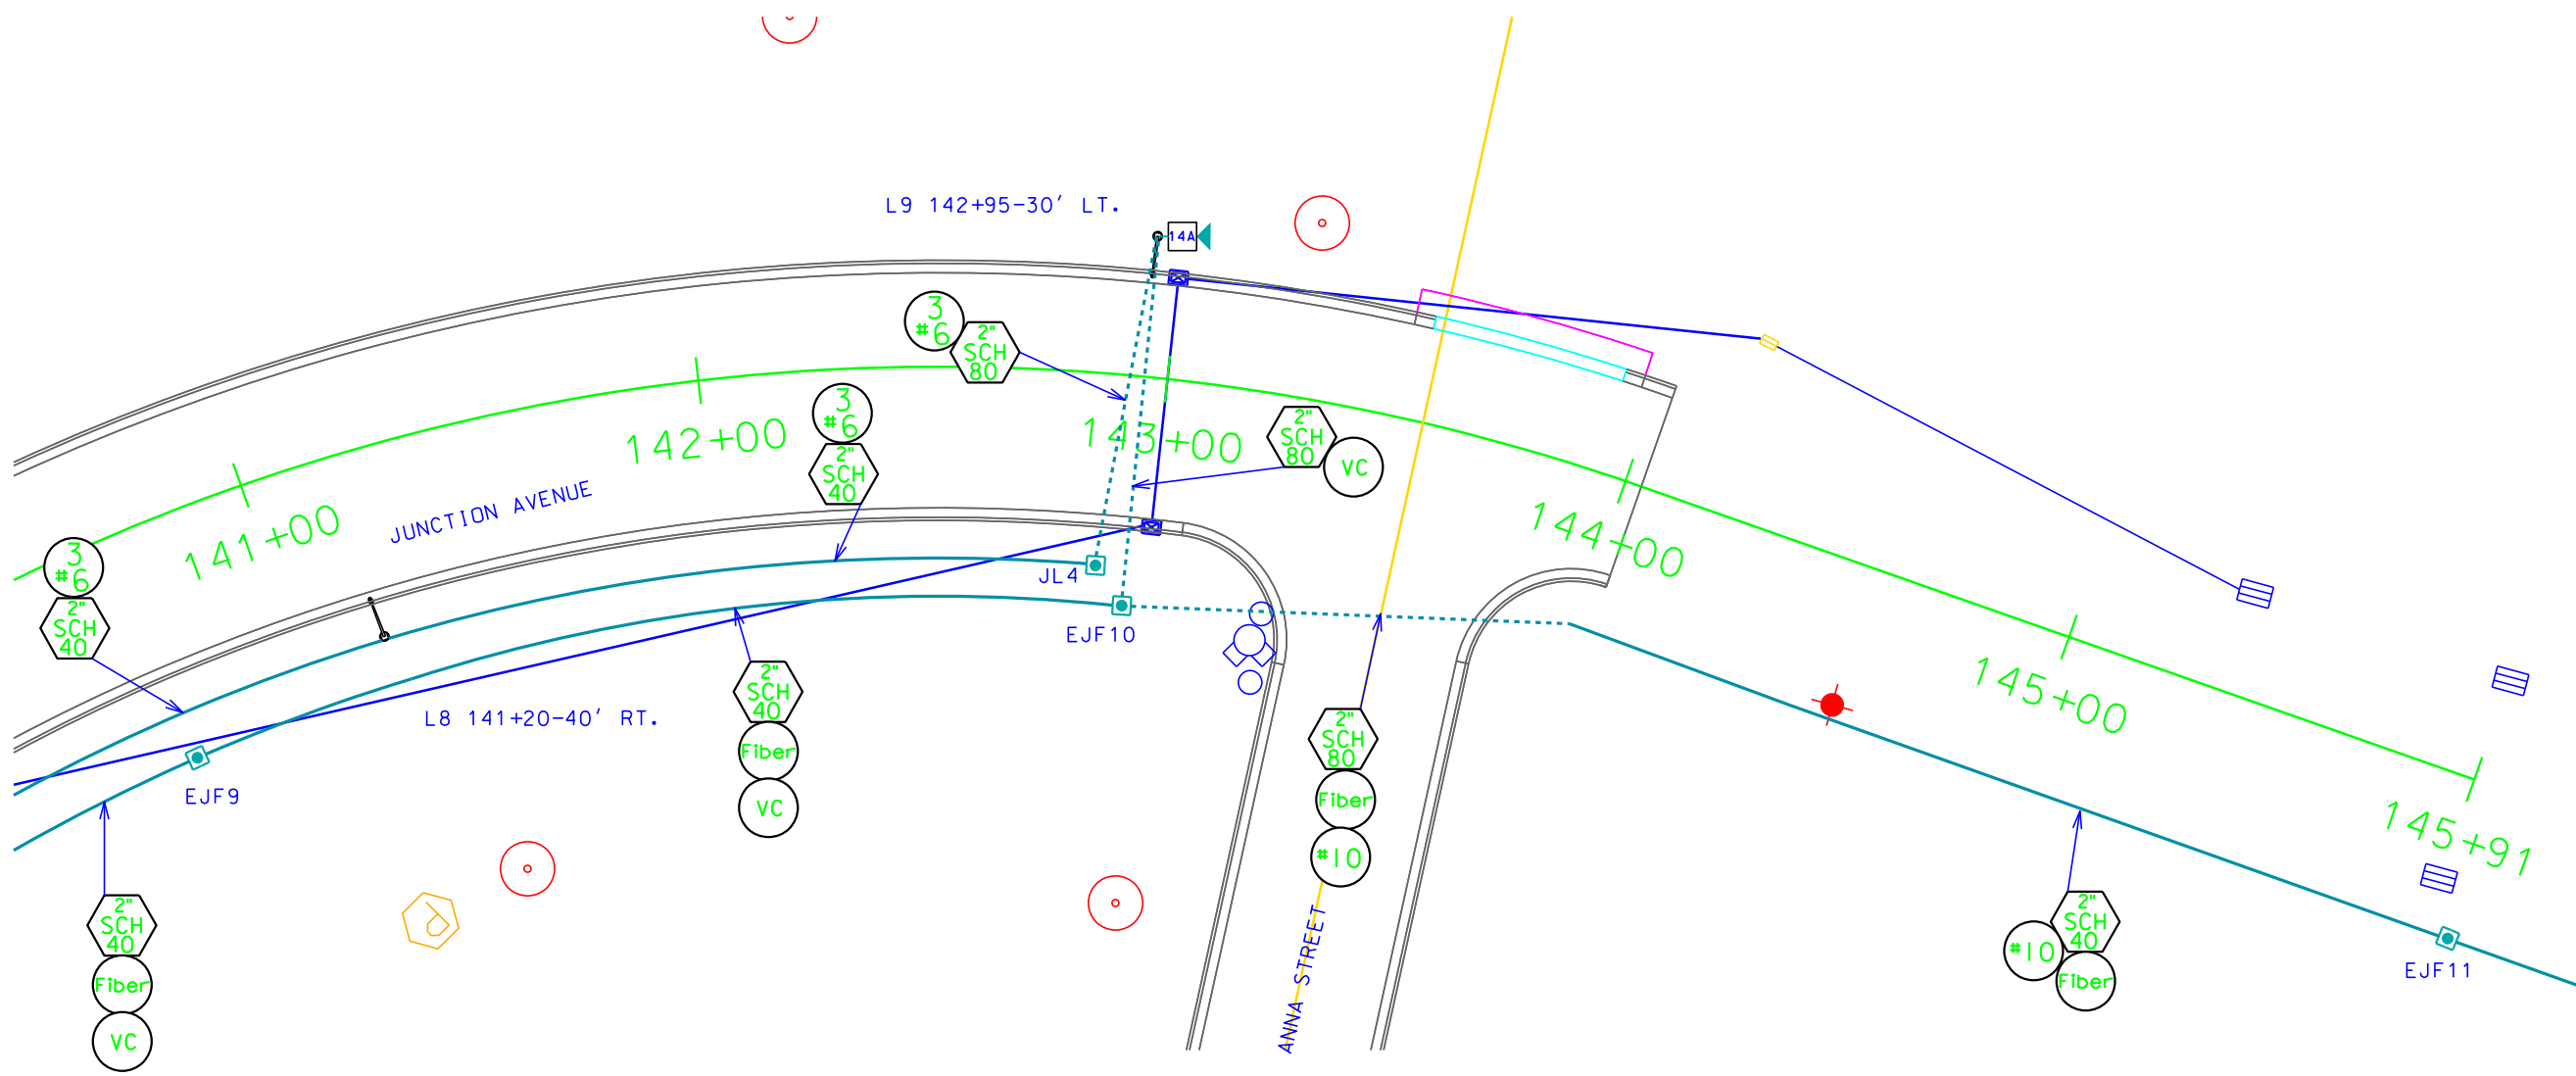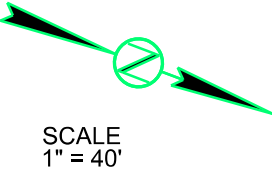

Plot Scale - 1:40

Plotted From - tpr14286





# EXISTING CONDUIT LAYOUT

## JUNCTION AVENUE EXISTING FIBER PATH

STATE OF SOUTH DAKOTA	PROJECT	SHEET	TOTAL SHEETS
	P 034-451	94	107

Plotting Date: 04/02/2014

SCALE  
1" = 40'

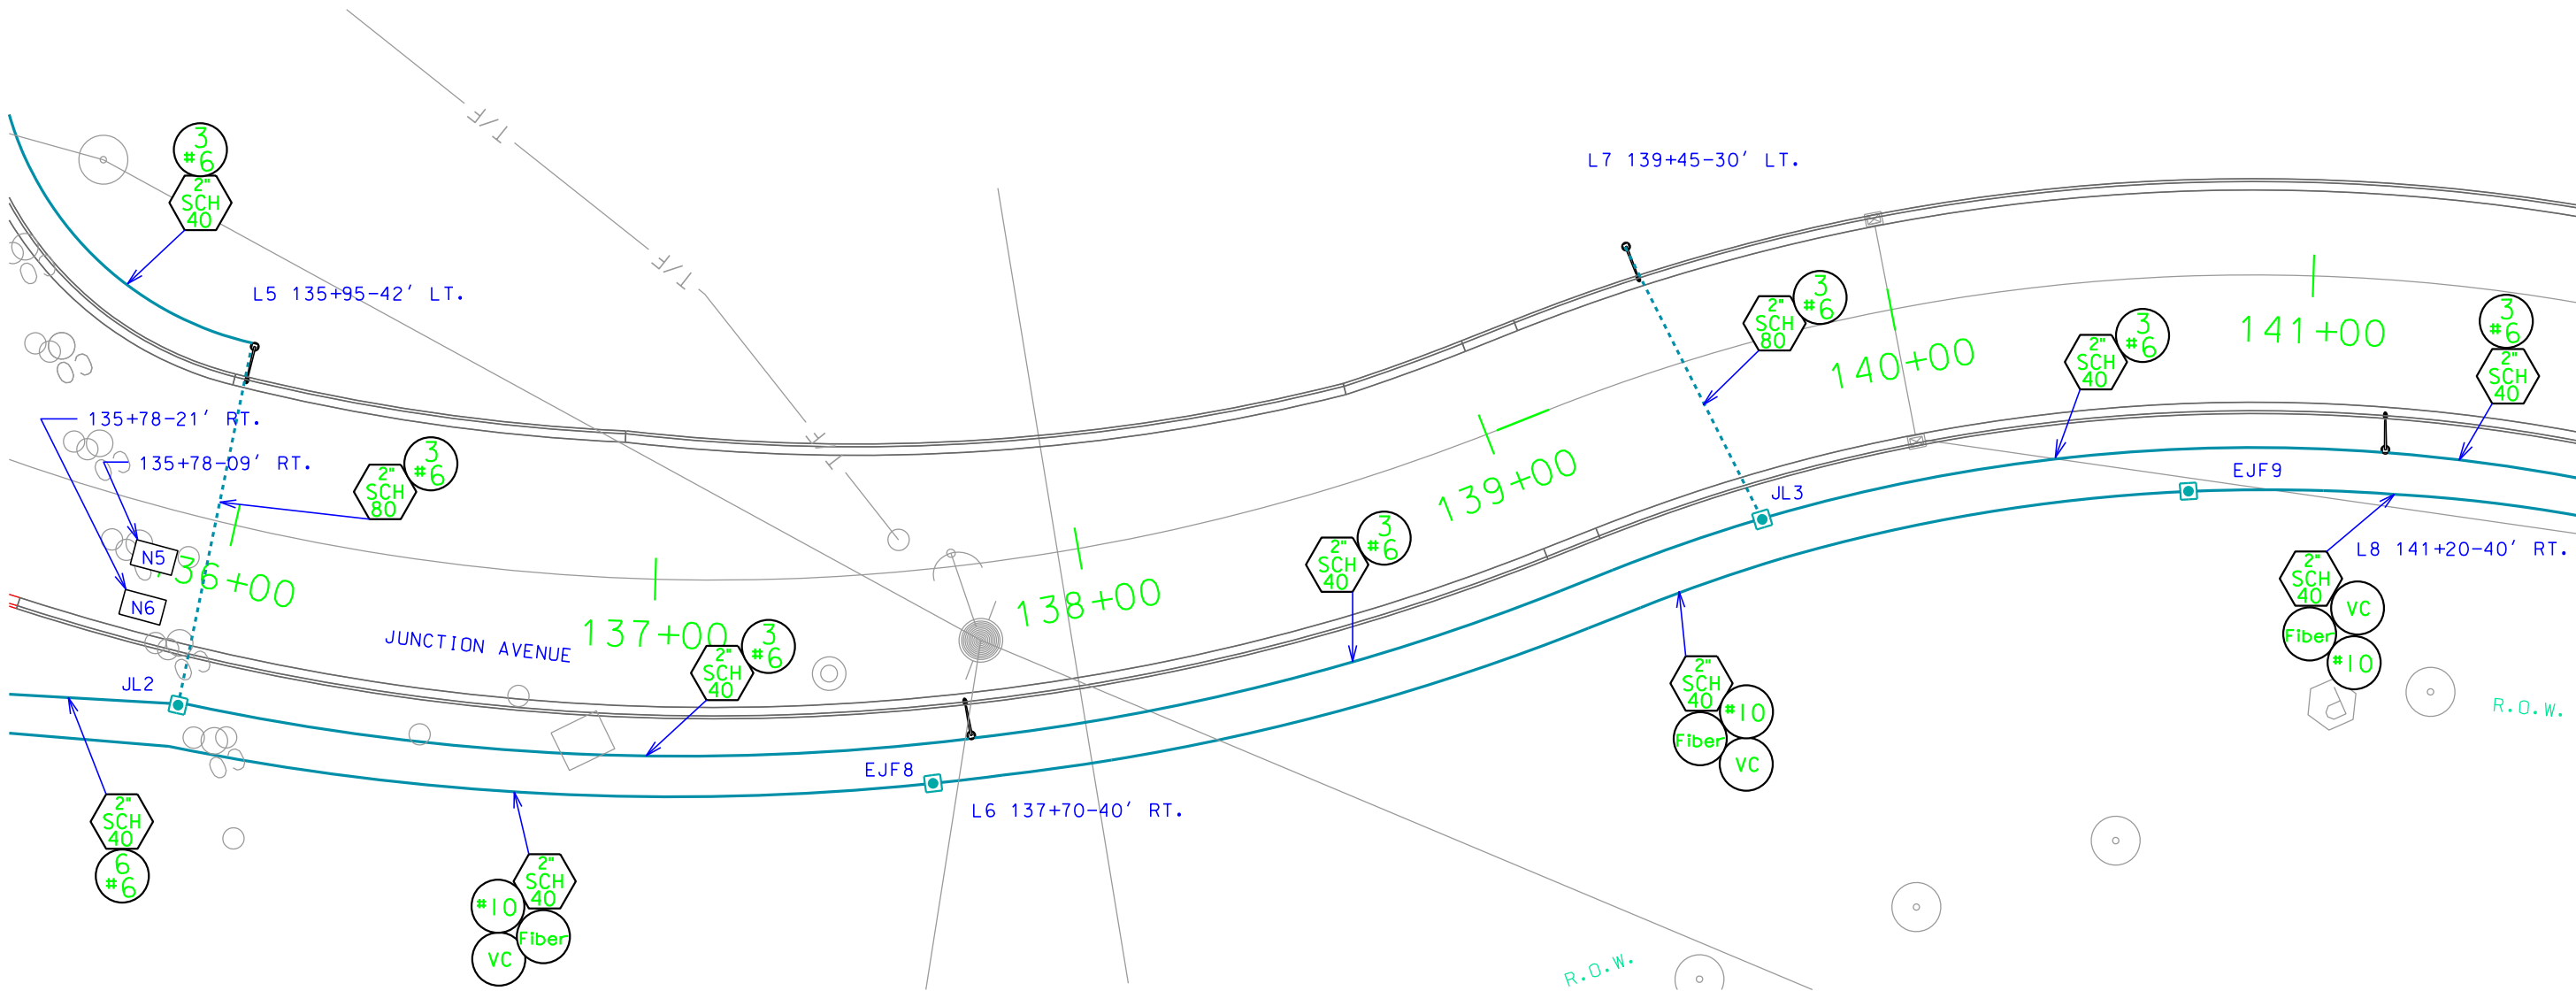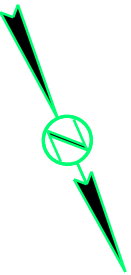

Plot Scale - 1:40

Plotted From - tpr14286




# EXISTING CONDUIT LAYOUT

## EXIT 32 WESTBOUND I-90 RAMPS & JUNCTION AVENUE


### EXISTING FIBER PATH

SCALE  
1" = 40'

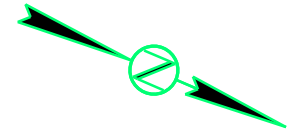

KEY	EXISTING ITEMS
	2' DIAMETER FOOTING (B4)
	3' DIAMETER FOOTING (B1-B3)
	18" DIAMETER JUNCTION BOX (JB1-JB3,JB5)
	24" DIAMETER JUNCTION BOX (JB4)
	ELECTRICAL SERVICE CABINET
	WOOD UTILITY POLE
	METER SOCKET
	TRAFFIC SIGNAL CONTROLLER
	POWER POLE
	2" RIGID CONDUIT, SCHEDULE 40
	3" RIGID CONDUIT, SCHEDULE 40
	5" RIGID CONDUIT, SCHEDULE 40
	2" RIGID CONDUIT, SCHEDULE 80

KEY	EXISTING ITEMS
	3" RIGID CONDUIT, SCHEDULE 80
	4" RIGID CONDUIT, SCHEDULE 80
	1/C #4 AWG COPPER WIRE
	1/C #6 AWG COPPER WIRE
	12/C #14 AWG COPPER TRAY CABLE, K2
	24/C #14 AWG COPPER TRAY CABLE, K2
	VIDEO CABLE
	PRE-EMPTION CABLE

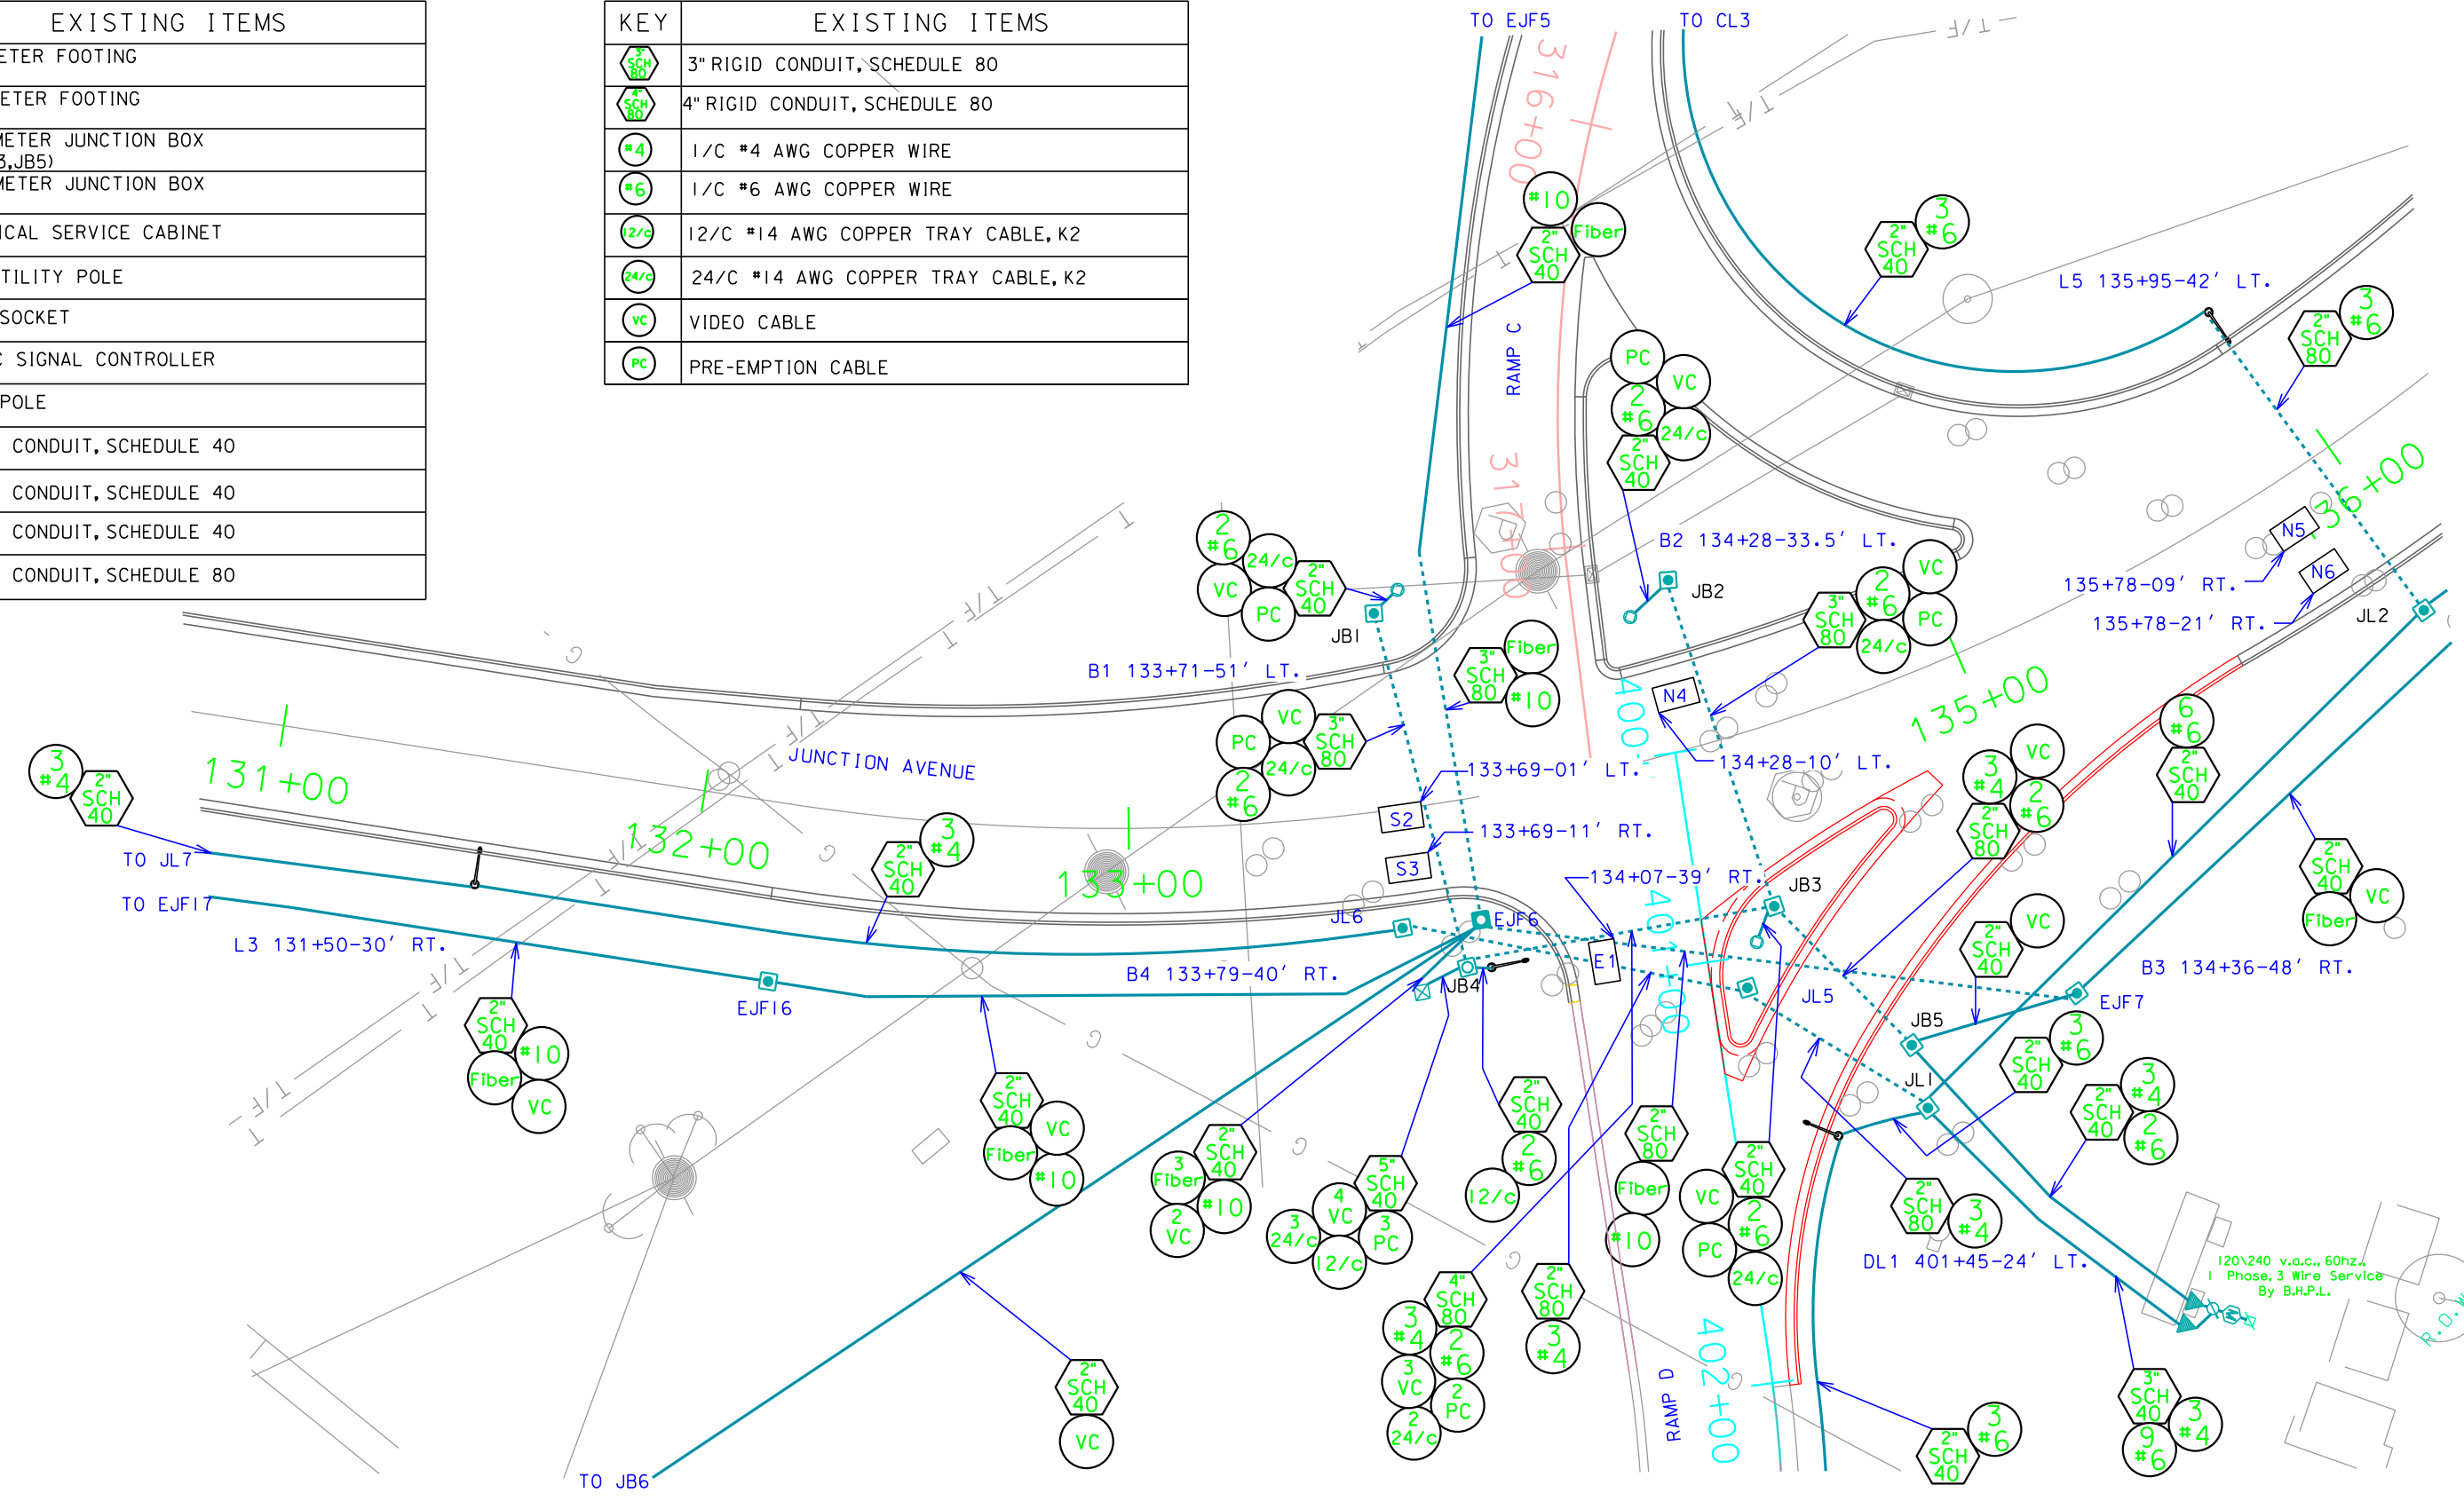

Plot Scale - 1:40










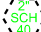
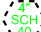
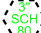
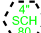






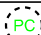

Plotted From - Inp14286

File - U:\rtd\misc\traffic\DPST\34c.dgn



Plot Scale - 1"=40'

Plotted From - tpr14286

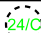KEY	EXISTING ITEMS
	2' DIAMETER FOOTING (A2)
	3' DIAMETER FOOTING (A1, A3-A4)
	
	
	ELECTRICAL SERVICE CABINET
	WOOD UTILITY POLE
	METER SOCKET
	TRAFFIC SIGNAL CONTROLLER
	POWER POLE
	2\" RIGID CONDUIT, SCHEDULE 40
	5\" RIGID CONDUIT, SCHEDULE 40
	3\" RIGID CONDUIT, SCHEDULE 80
	4\" RIGID CONDUIT, SCHEDULE 80
	1/C #4 AWG COPPER WIRE
	1/C #6 AWG COPPER WIRE
	12/C #14 AWG COPPER TRAY CABLE, K2
	19/C #14 AWG COPPER TRAY CABLE, K2
	24/C #14 AWG COPPER TRAY CABLE, K2
	VIDEO CABLE
	PRE-EMPTION CABLE
	12 STRAND SINGLE MODE FIBER


# EXISTING CONDUIT LAYOUT

## EXIT 32 EASTBOUND I-90 RAMP & JUNCTION AVENUE CAMERA 31 & SWITCH N EXISTING FIBER PATH

STATE OF SOUTH DAKOTA	PROJECT P 034-451	SHEET 96	TOTAL SHEETS 107
-----------------------	----------------------	-------------	---------------------

Plotting Date: 04/02/2014

2 STRANDS OF 12 SINGLE MODE FIBER ARE CONNECTED TO  
2 STRANDS OF SINGLE MODE FIBER  
IN THE 48 HYBRID FIBER  
@ TRAFFIC SIGNAL CONTROLLER

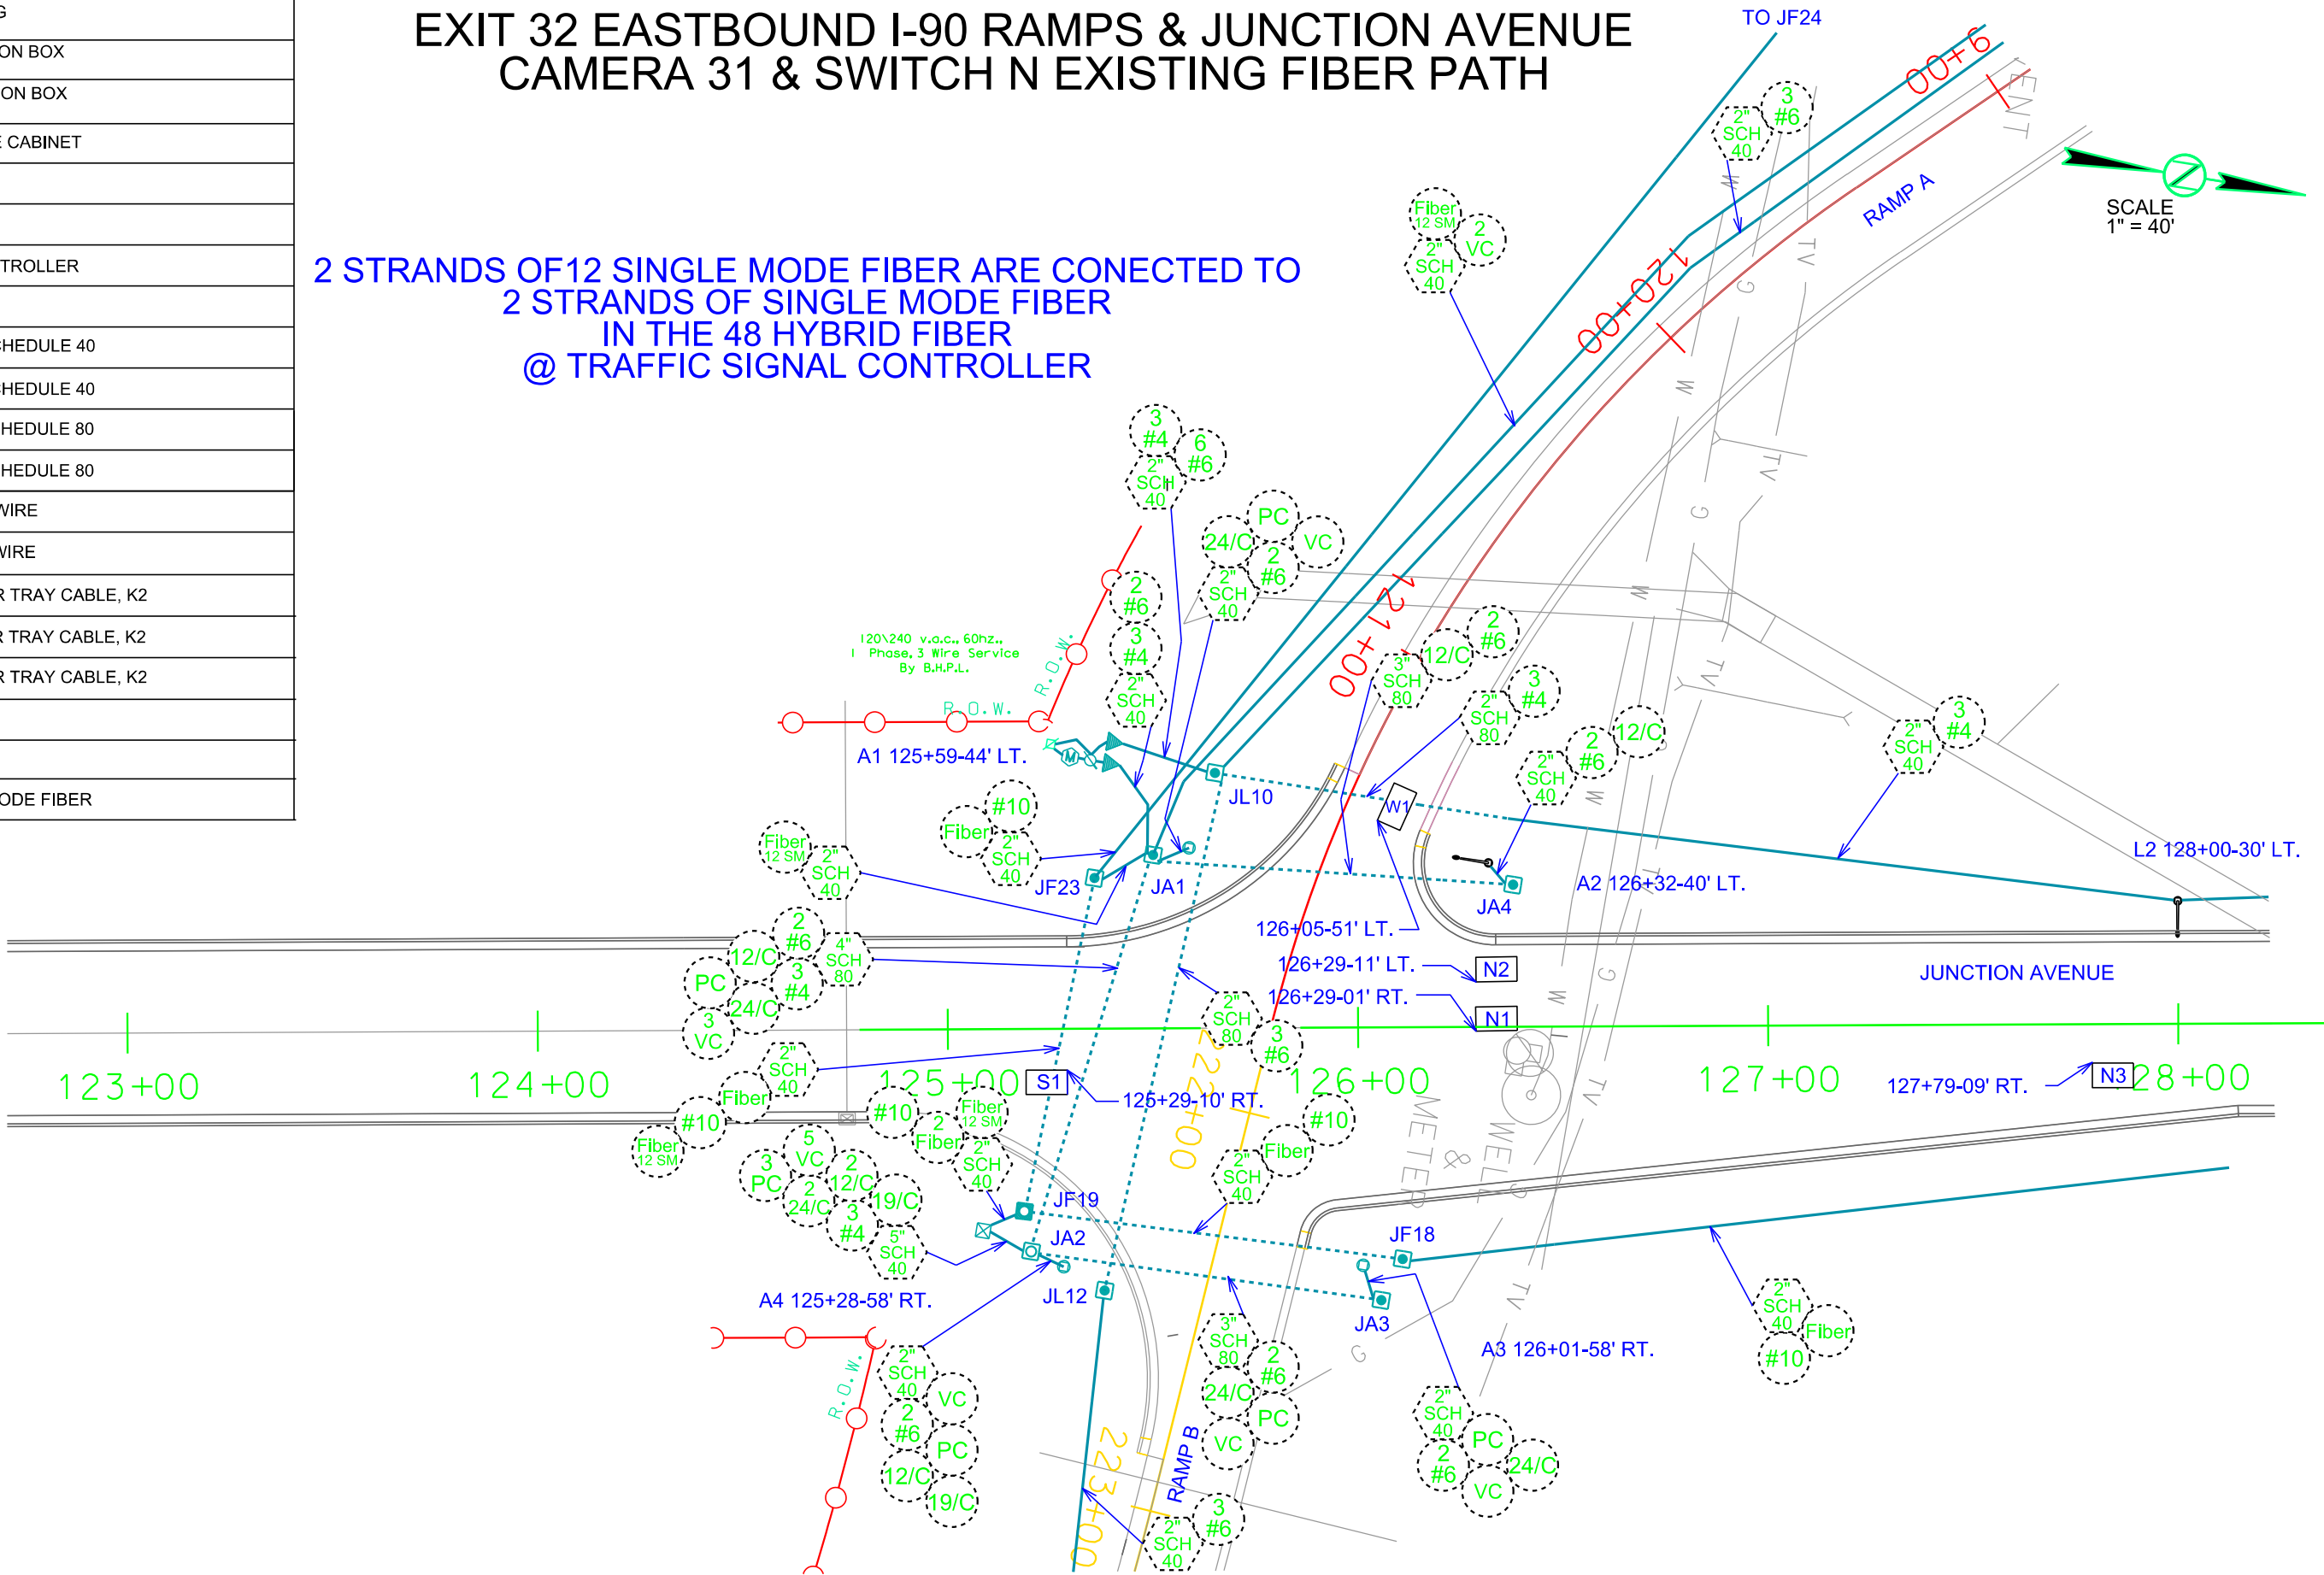

File - ...MiscTrafficDPS126c (2).dgn



# EXISTING CONDUIT LAYOUT


## INTERSTATE 90 EXIT 32 EASTBOUND OFF RAMP

### CAMERA 31

STATE OF SOUTH DAKOTA	PROJECT	SHEET	TOTAL SHEETS
	P 0034(133)34	97	107

Plotting Date: 04/02/2014

SCALE  
1" = 40'

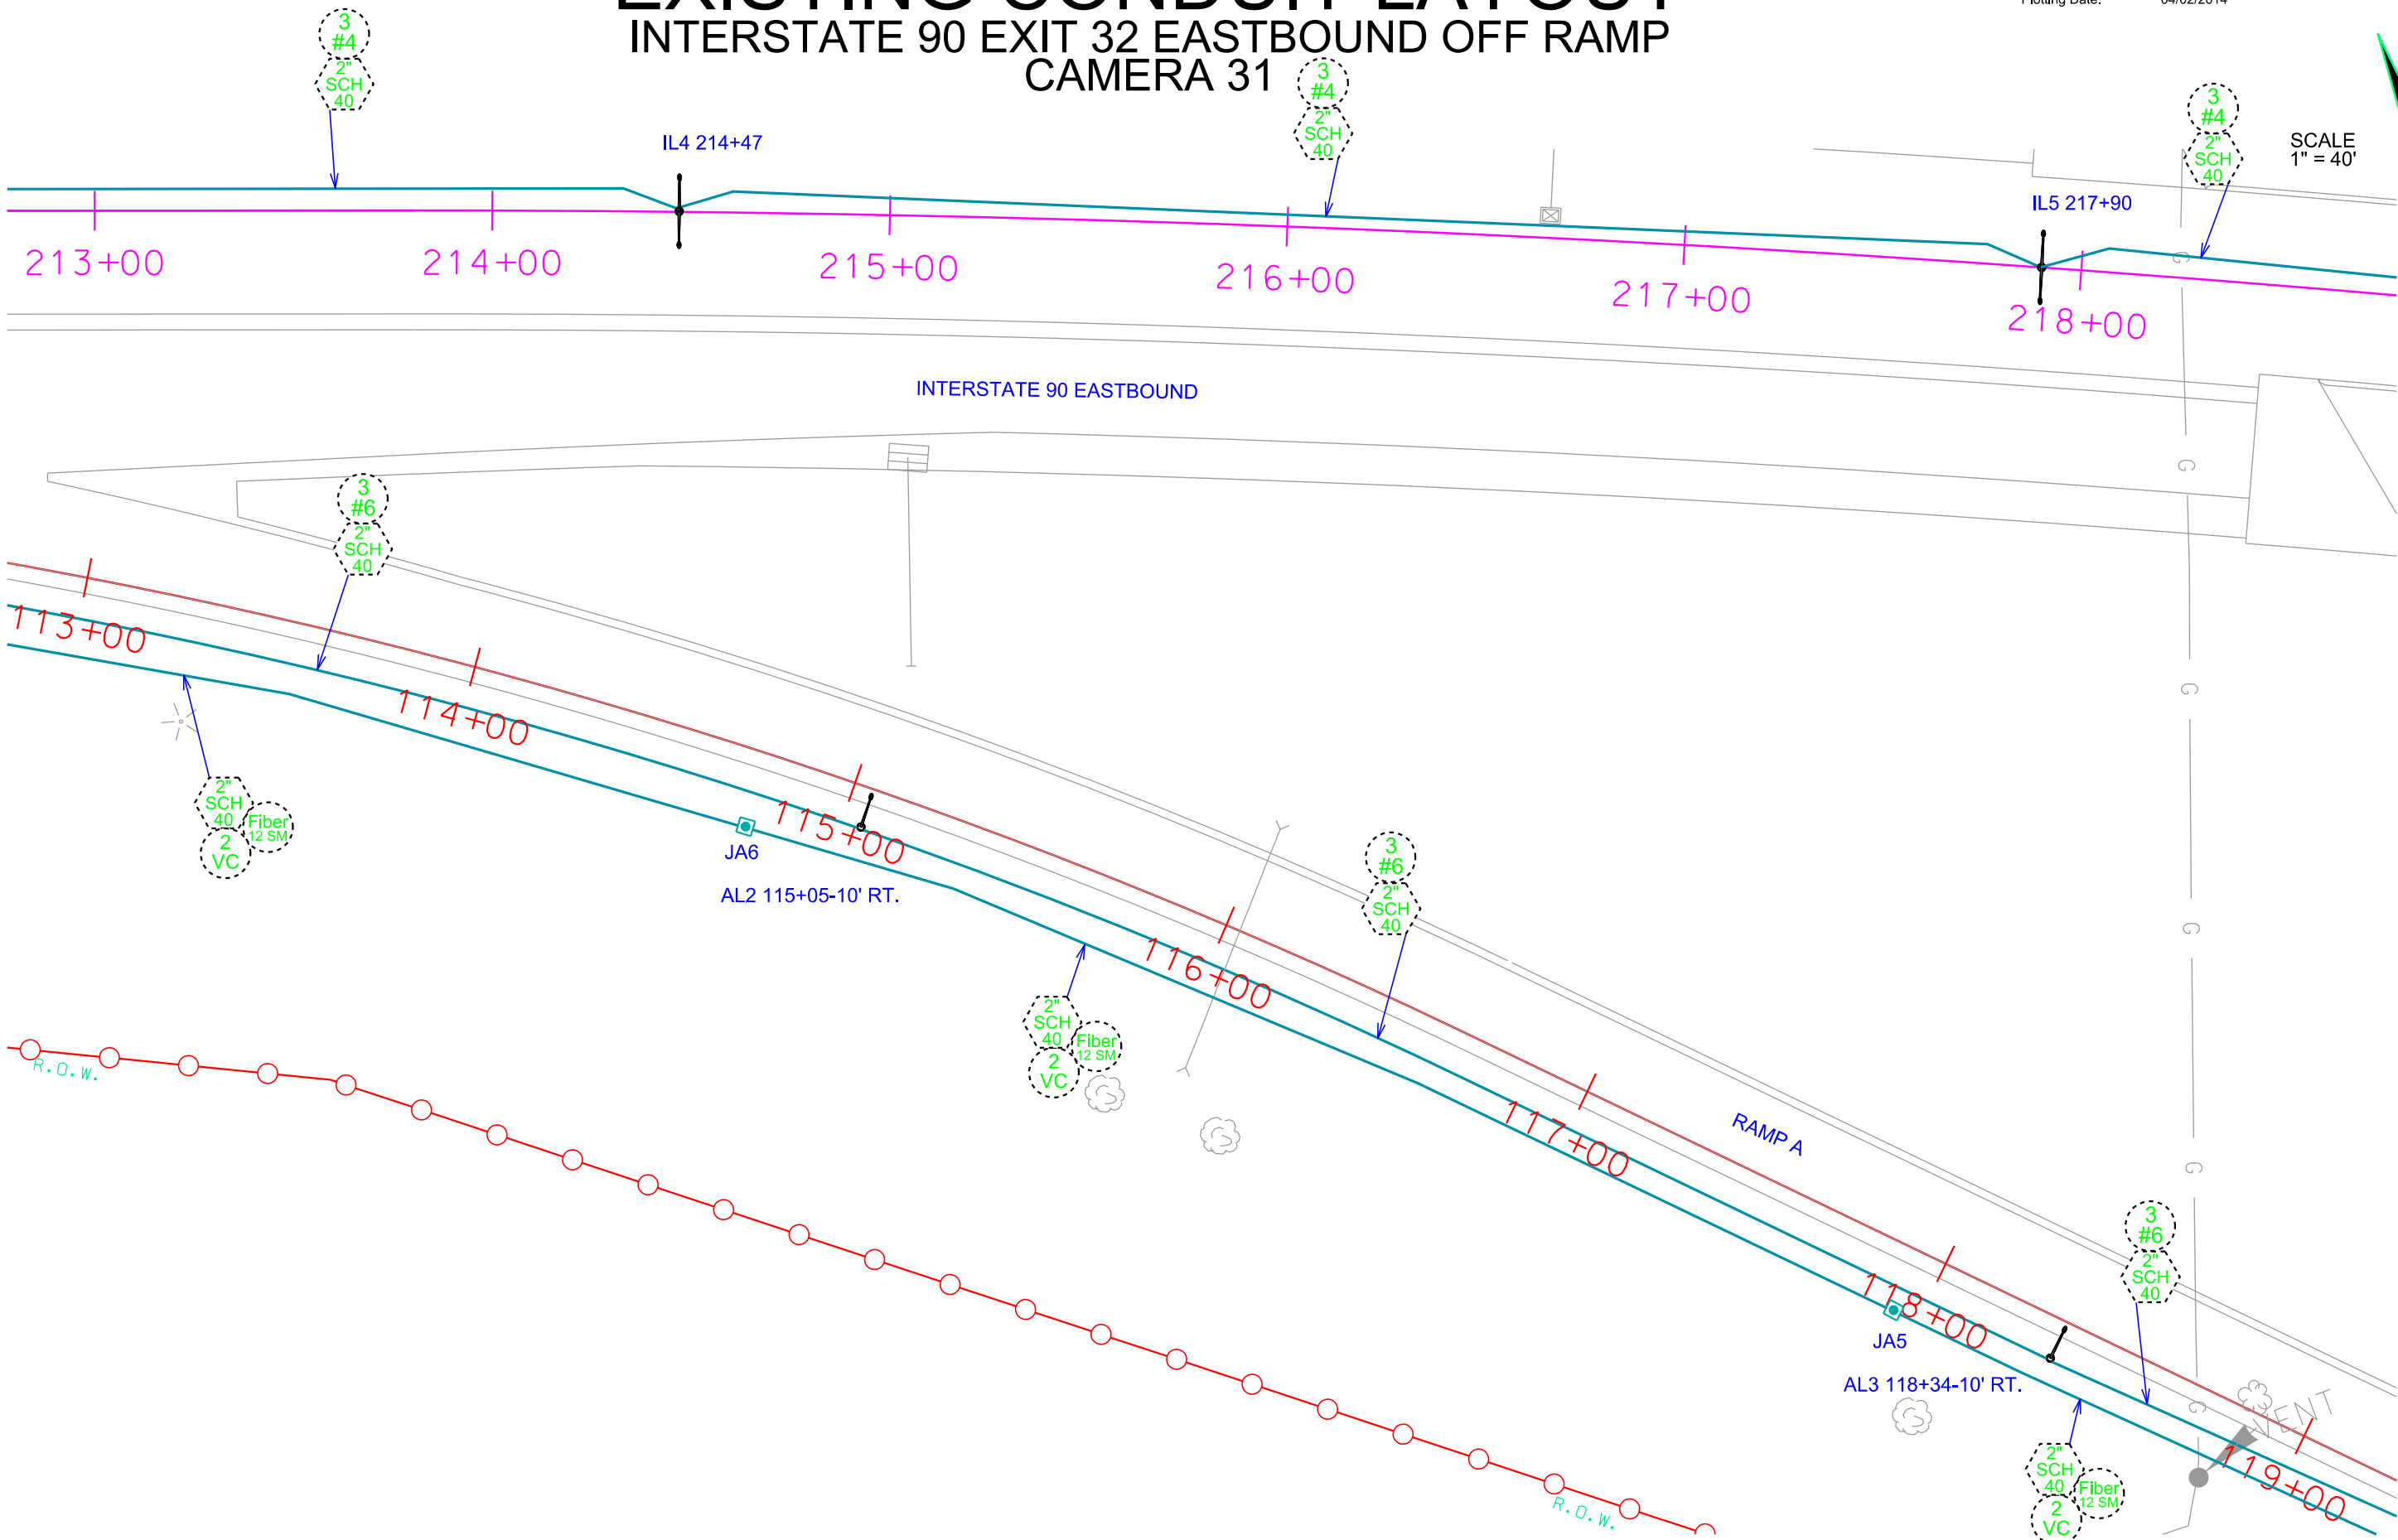

Plot Scale - 1:40

Plotted From - tpr14286



# EXISTING CONDUIT LAYOUT


INTERSTATE 90 EXIT 32 EASTBOUND OFF RAMP  
CAMERA 31 & SWITCH N EXISTING FIBER PATH

STATE OF SOUTH DAKOTA	PROJECT	SHEET	TOTAL SHEETS
	P 0034(133)34	98	107

Plotting Date: 04/02/2014

Plot Scale - 1"=40'

Plotted From - Imp14286

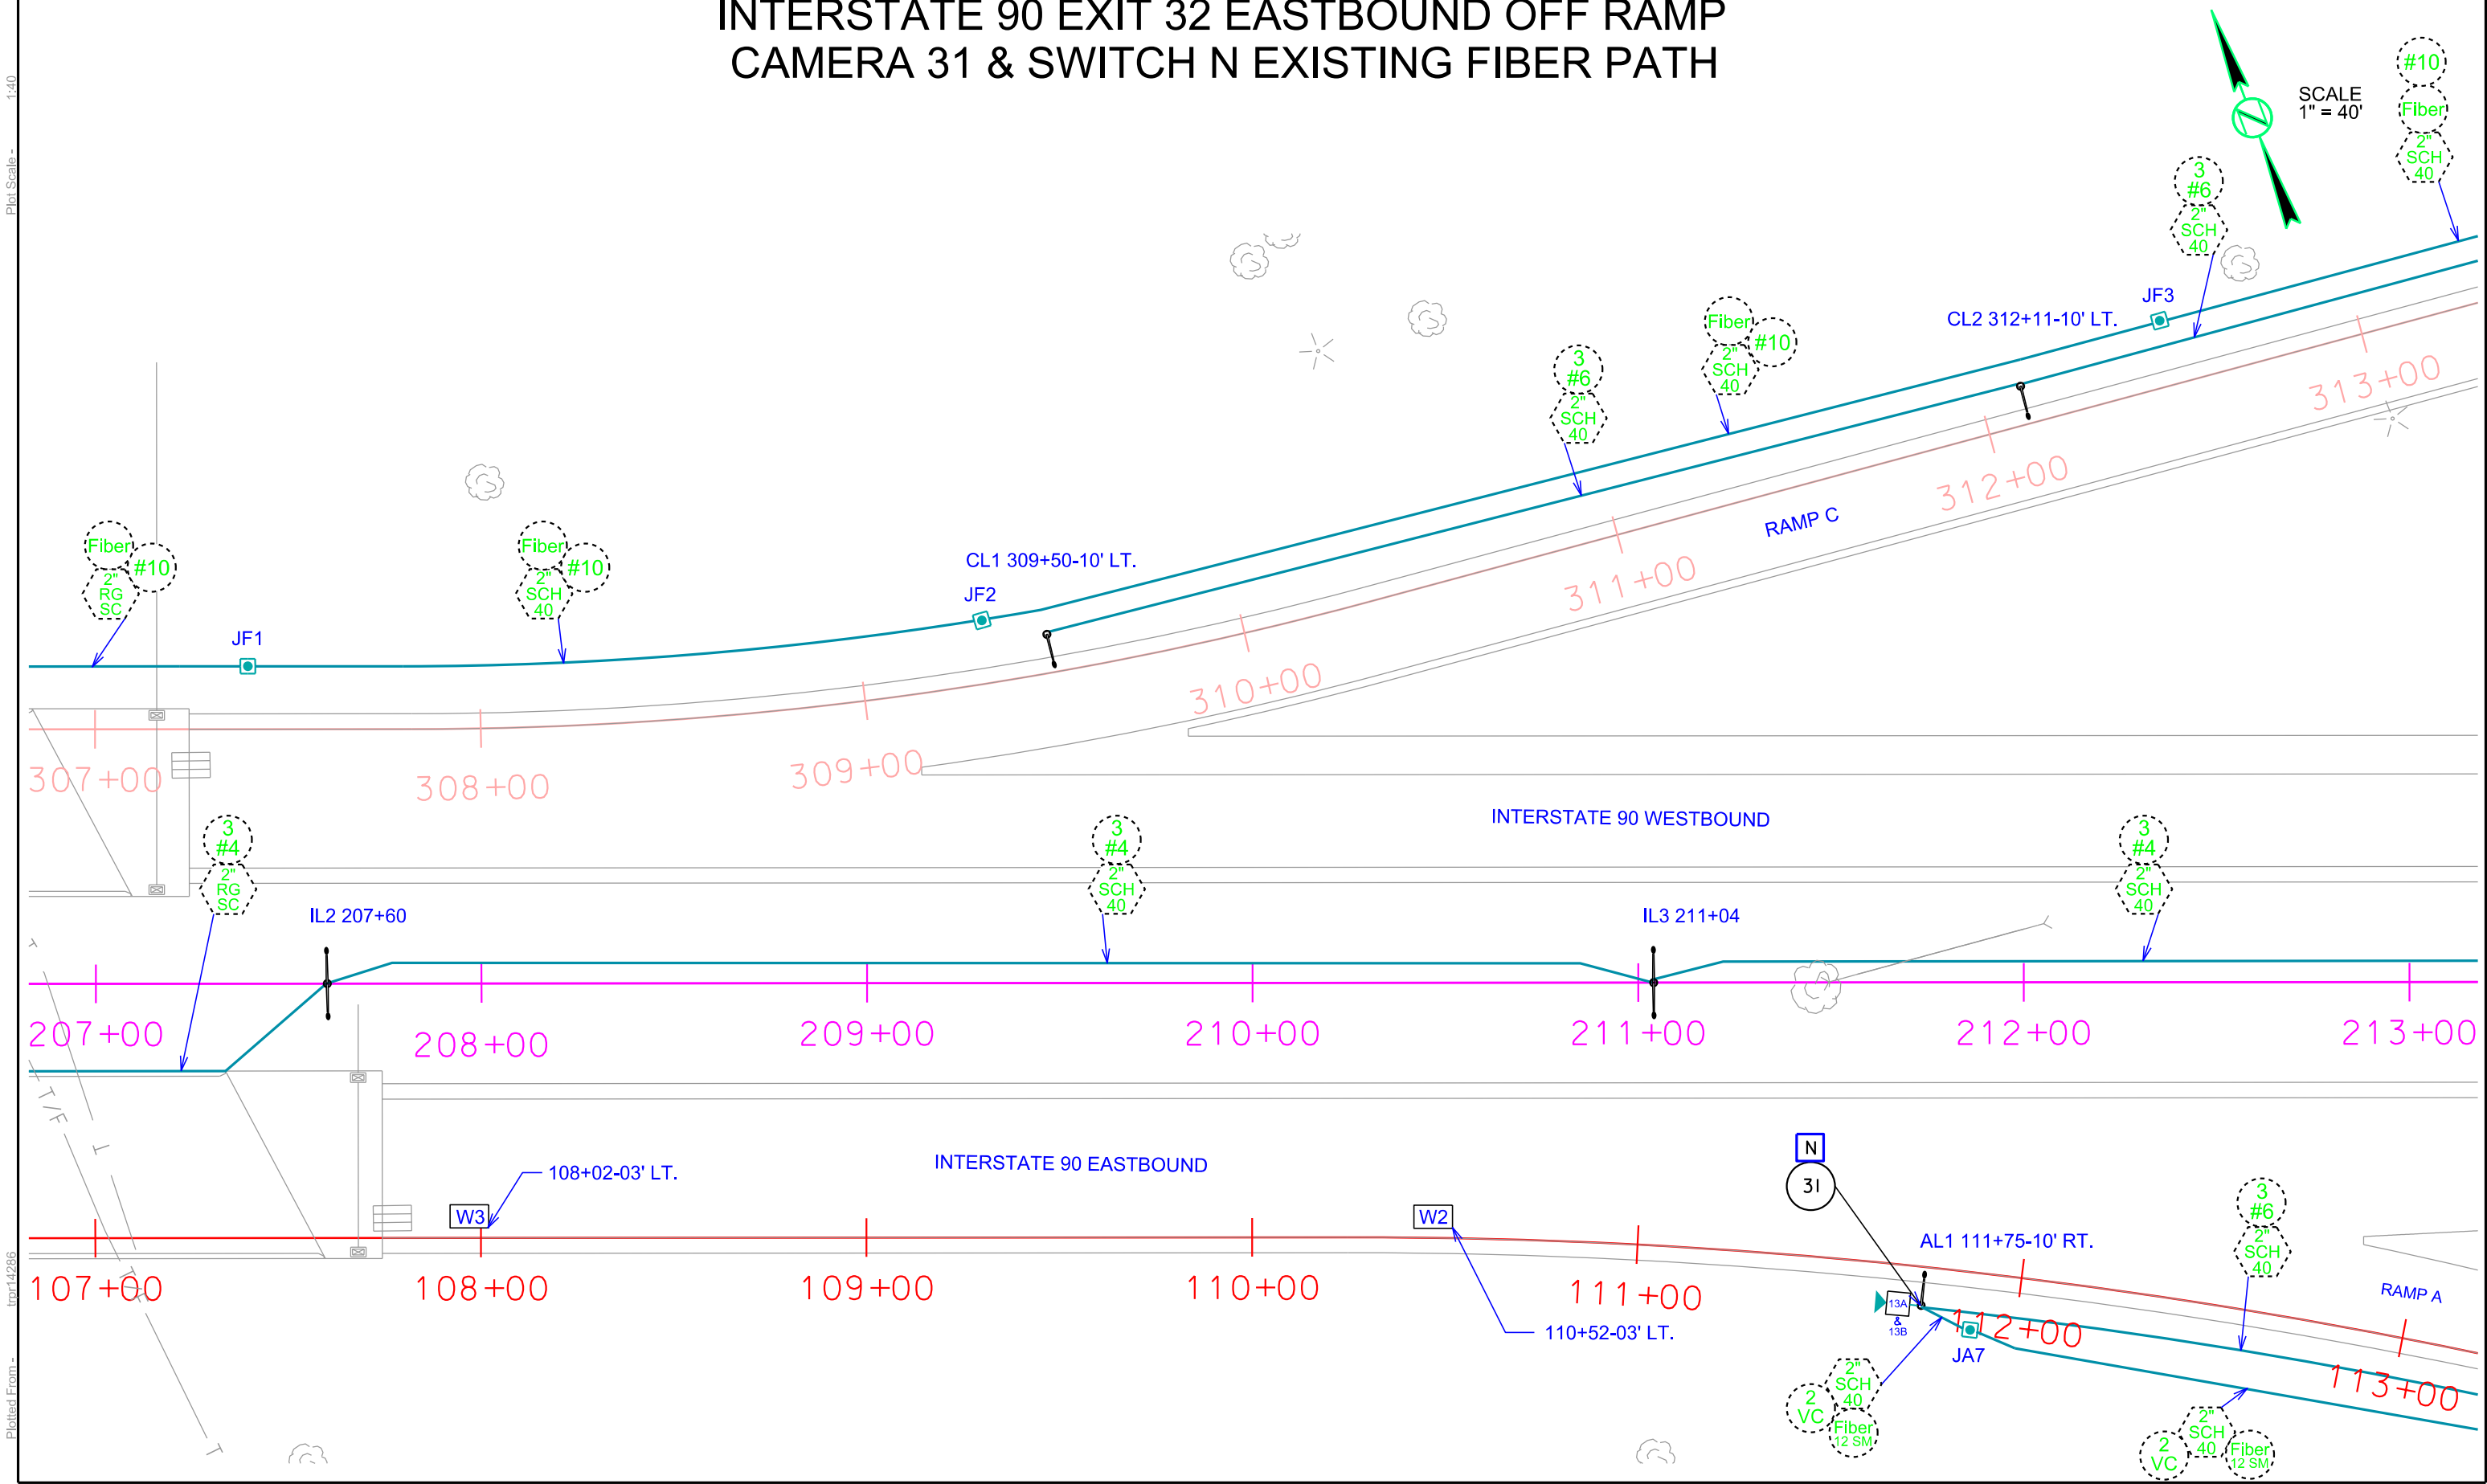

File - ...IDPS\mead\00DS\207c (2).dgn




# EXISTING CONDUIT LAYOUT

## OTTER ROAD EXISTING FIBER PATH

STATE OF SOUTH DAKOTA	PROJECT	SHEET	TOTAL SHEETS
	P 034-451	99	107

Plotting Date: 04/02/2014

SCALE  
1" = 40'

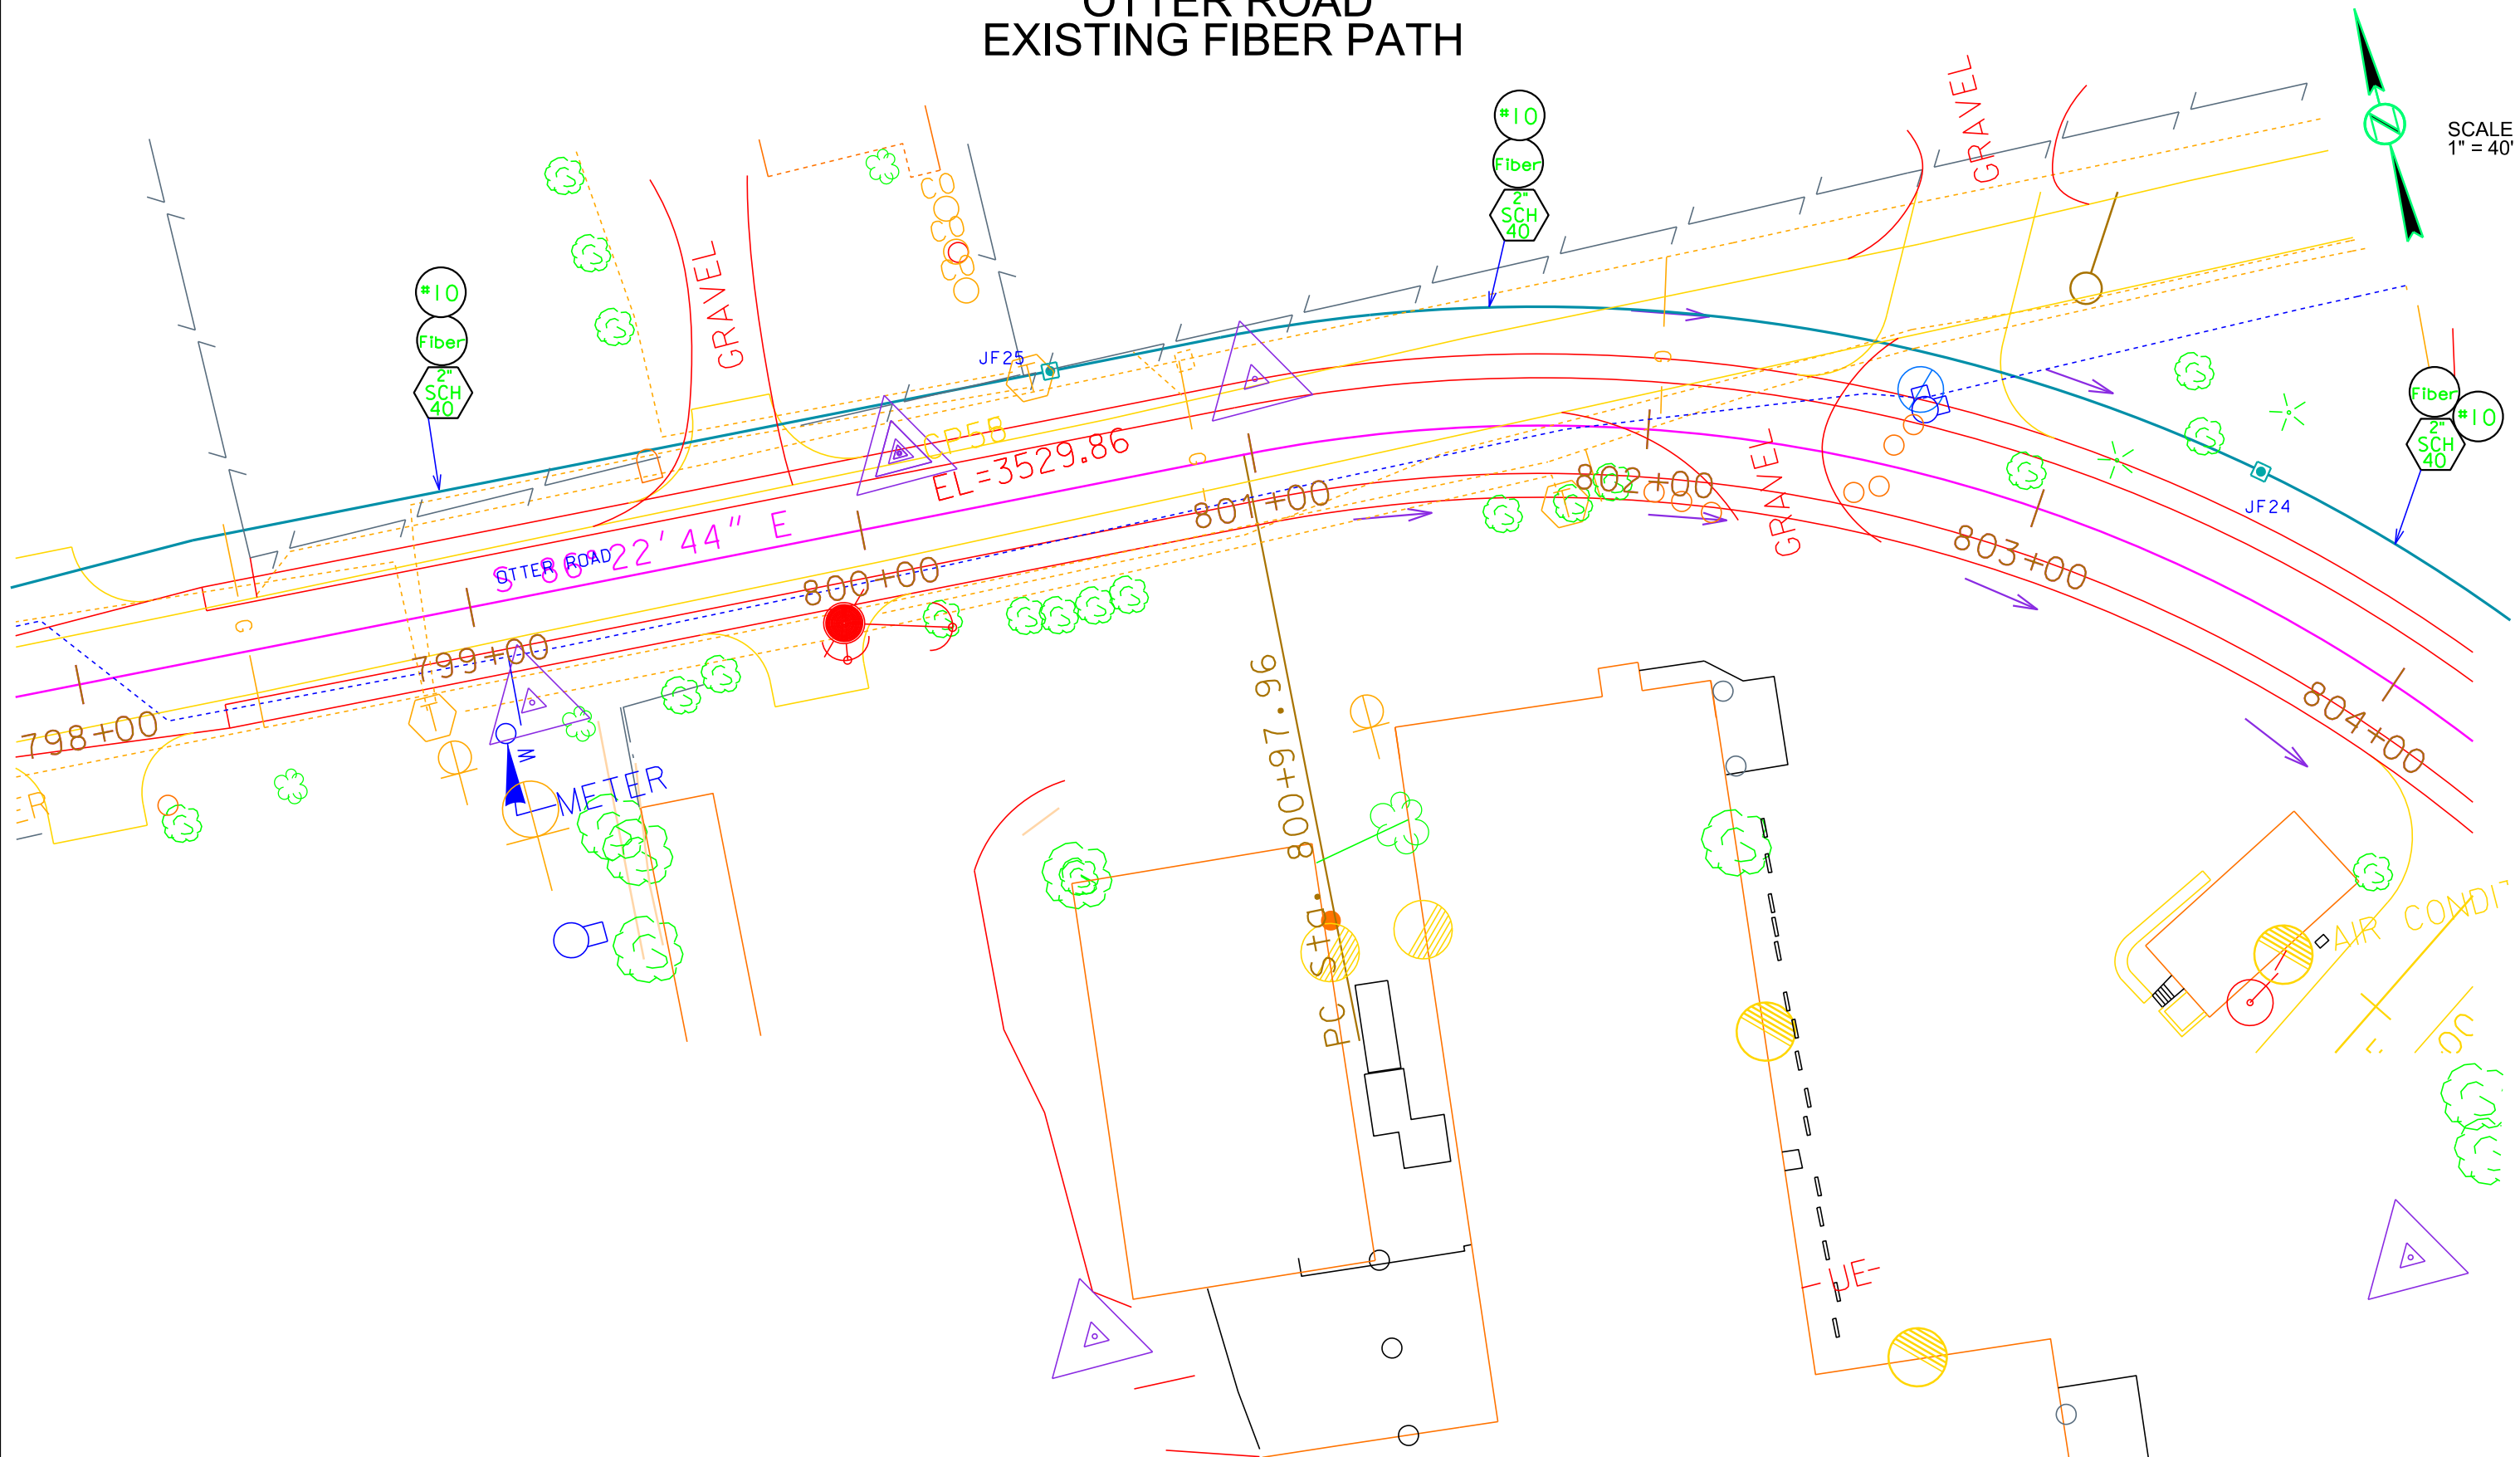




# EXISTING CONDUIT LAYOUT

## OTTER ROAD EXISTING FIBER PATH

STATE OF SOUTH DAKOTA	PROJECT	SHEET	TOTAL SHEETS
	P 034-451	100	107

Plotting Date: 04/02/2014

SCALE  
1" = 40'

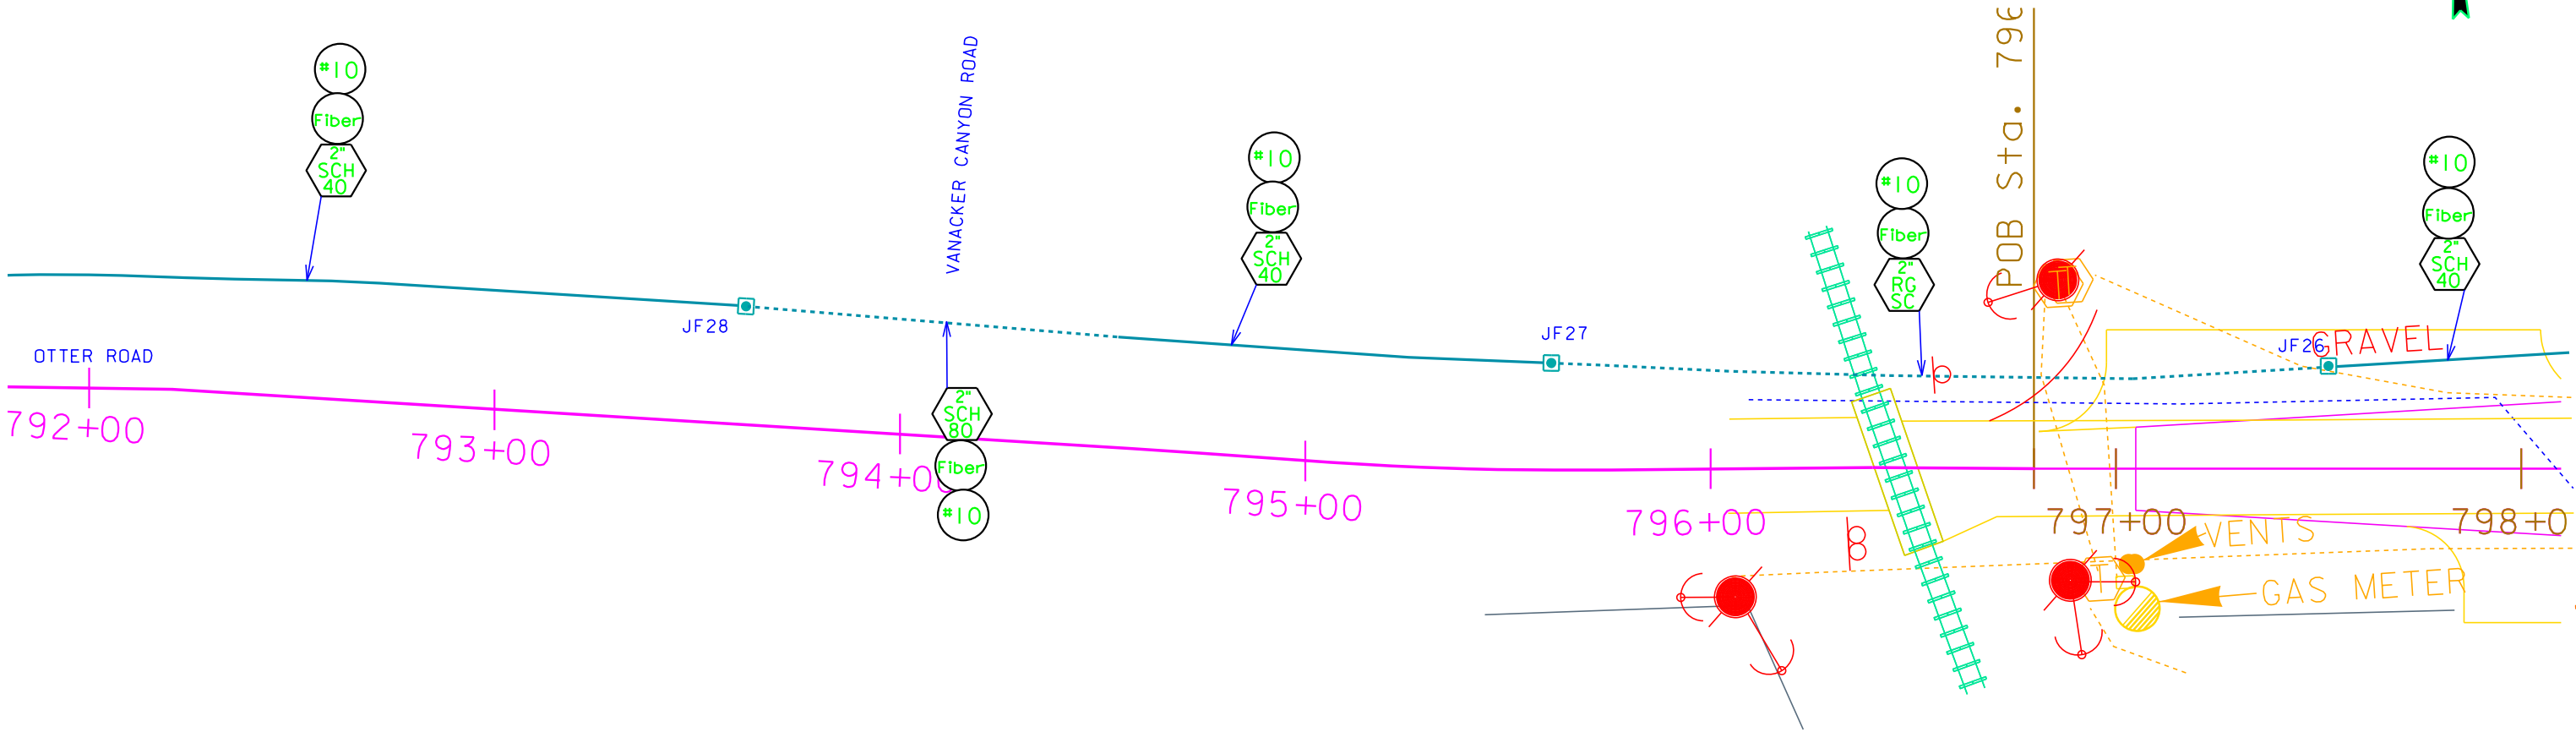

Plot Scale - 1:40


Plotted From - tpr14286

File - U:\034-451\Traffic\DPST\9797C.dgn



Plot Scale - 1"=40'

Plotted From - tpr14286

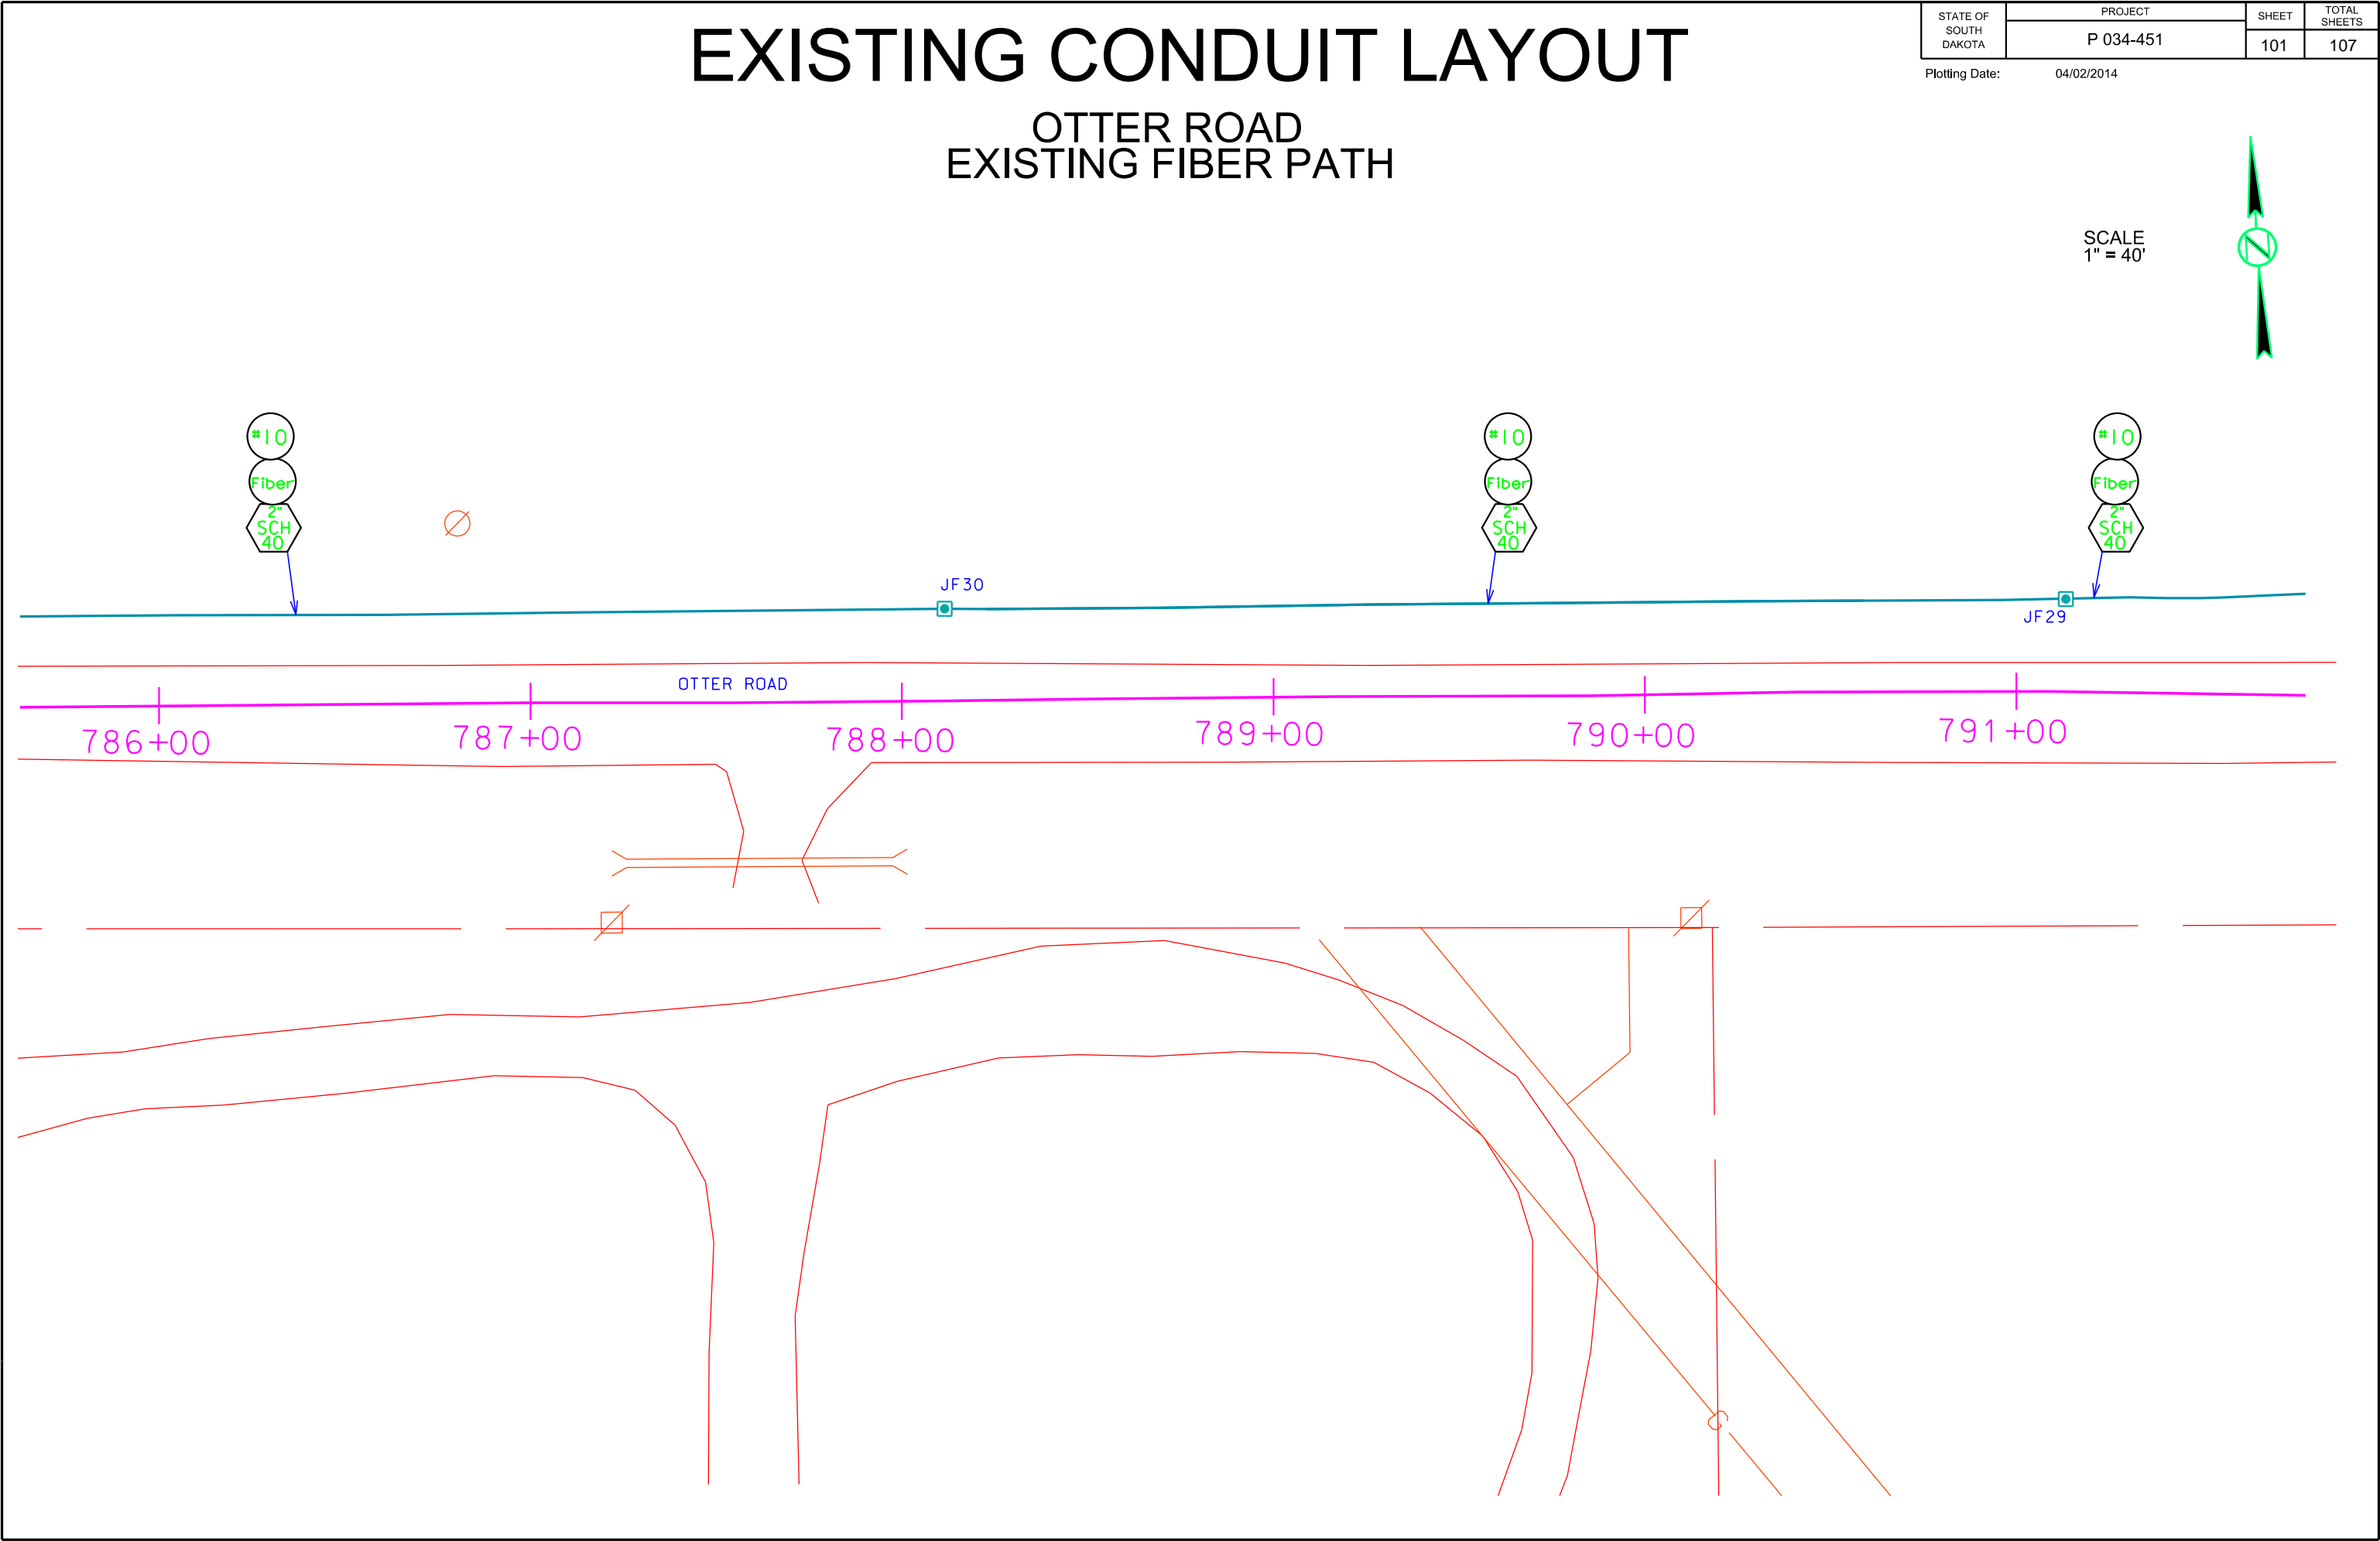




# EXISTING CONDUIT LAYOUT

## OTTER ROAD EXISTING FIBER PATH

STATE OF SOUTH DAKOTA	PROJECT	SHEET	TOTAL SHEETS

Plotting Date: 04/02/2014

SCALE  
1" = 40'

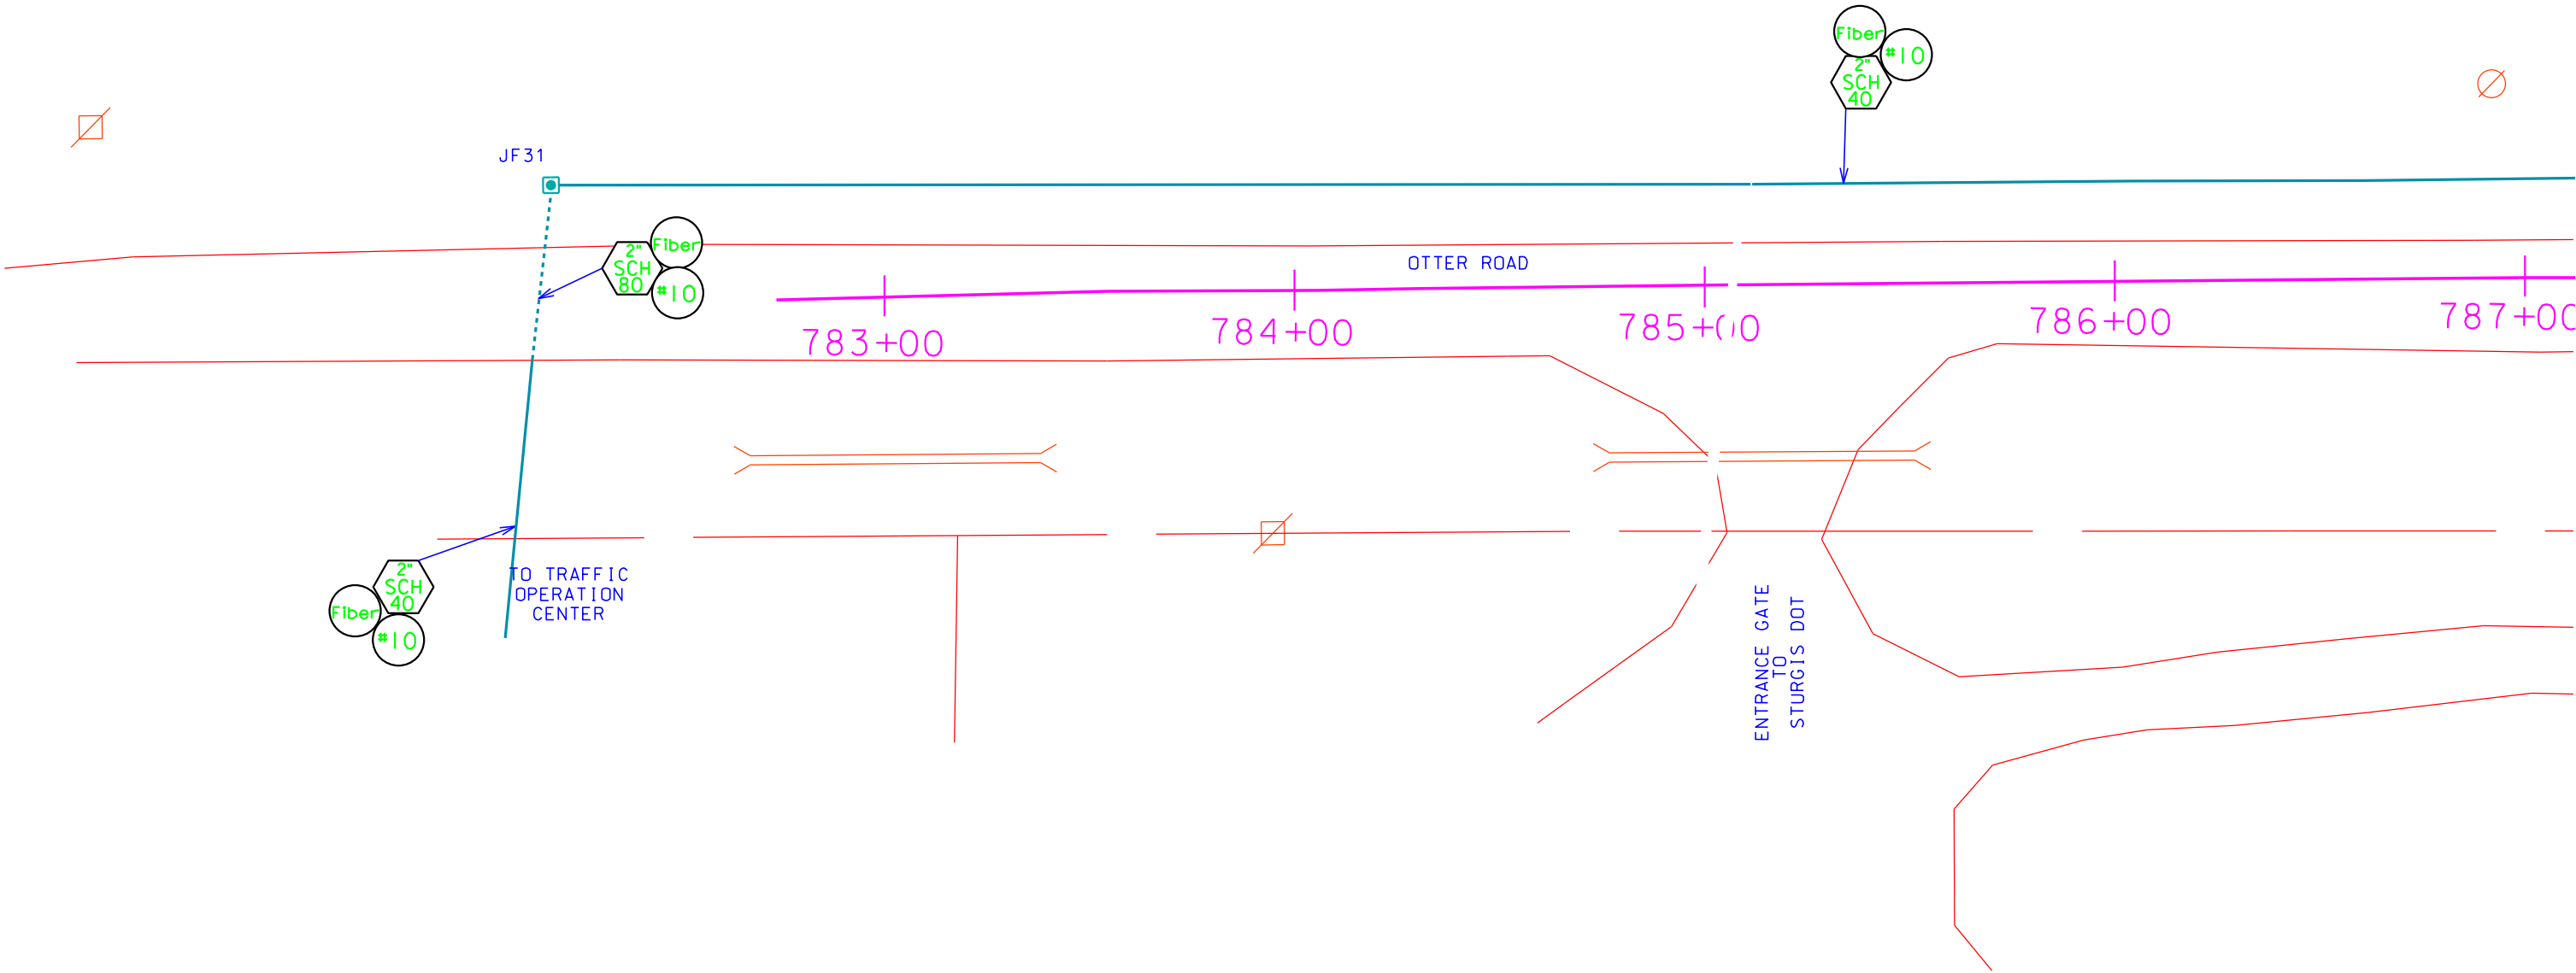

Plot Scale - 1:40

Plotted From - tpr14286

File - U:\034-451\Traffic\DOT\PS1785C.dgn




# EXISTING CONDUIT LAYOUT


## INTERSTATE 90 EXIT 30 / WESTBOUND OFF RAMP EXISTING FIBER PATH

STATE OF SOUTH DAKOTA	PROJECT	SHEET	TOTAL SHEETS
	P 034-451	103	107

Plotting Date: 04/02/2014

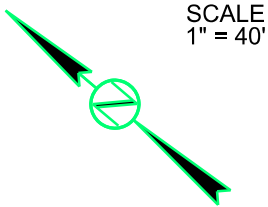

Plot Scale - 1"=40'

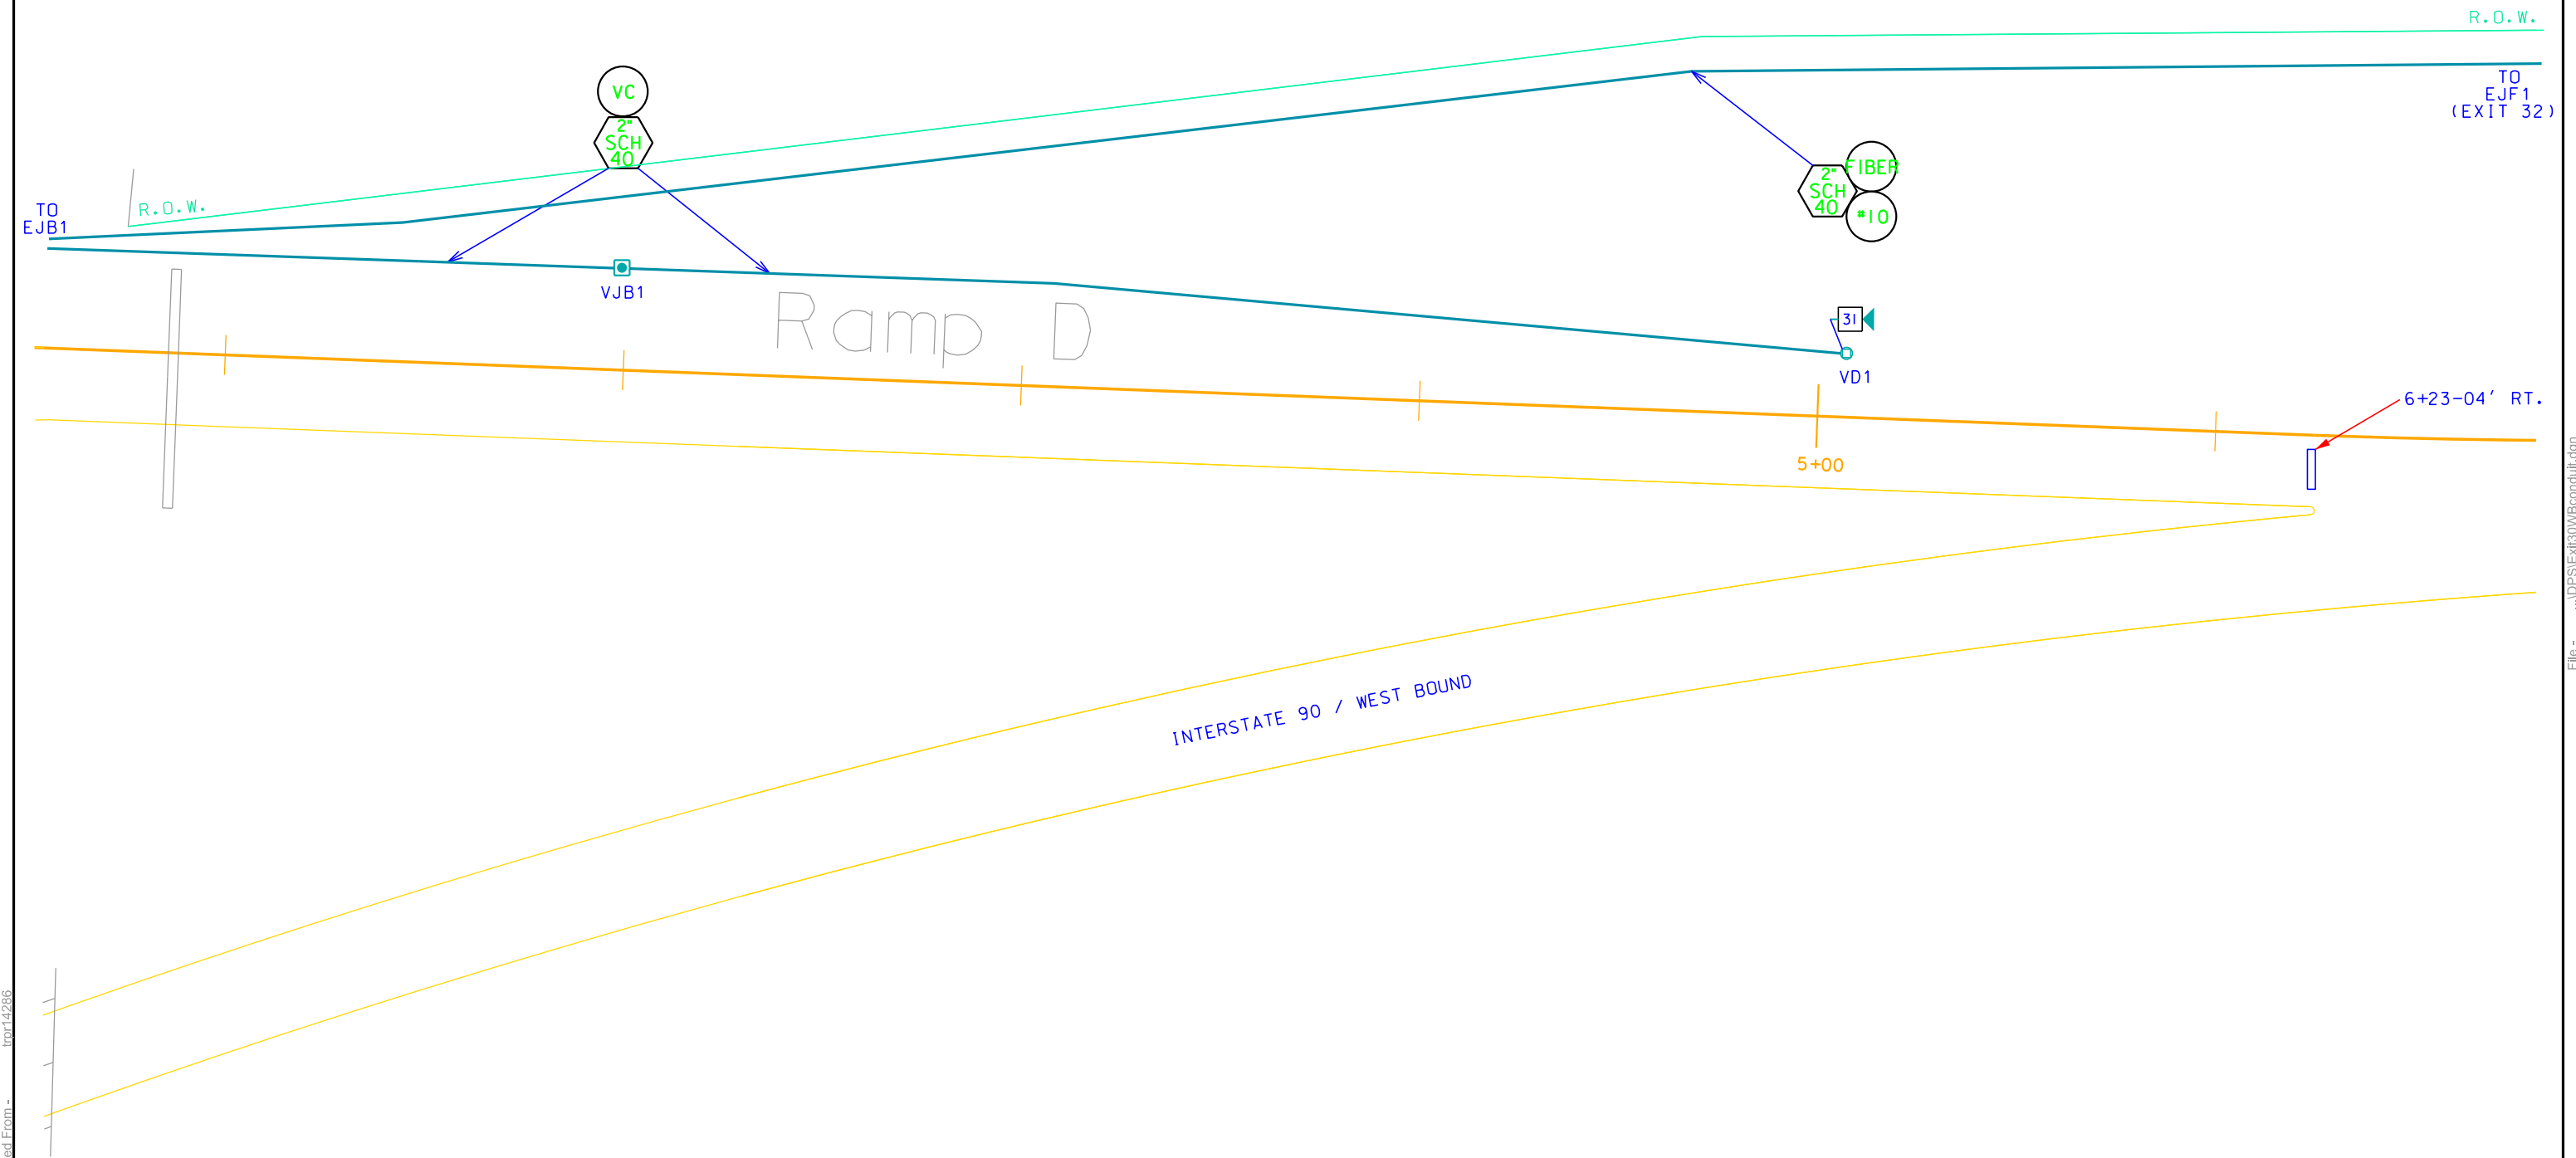

Plotted From - tpr14286

File - ...IDPS\Exit30WB\conduit.dgn



Plot Scale - 1:40  
Plotted From - tpr14286


# EXISTING CONDUIT LAYOUT

## INTERSTATE 90 EXIT 30 WESTBOUND RAMPS & LAZELLE STREET


### CAMERA 32 & SWITCH L EXISTING FIBER PATH

STATE OF SOUTH DAKOTA	PROJECT	SHEET	TOTAL SHEETS
	P 034-451	104	107

Plotting Date: 04/02/2014

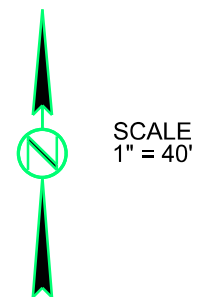

EXISTING ITEMS	
KEY	ITEM
	18 INCH DIAMETER JUNCTION BOX (EJB2)
	24 INCH DIAMETER JUNCTION BOX (EJB1, EJB3-EJB5)
	2" RIGID CONDUIT SCHEDULE 40
	1/C #2 AWG COPPER WIRE
	1/C #3 AWG COPPER WIRE
	1/C #4 AWG COPPER WIRE
	12/C #14 AWG COPPER TRAY CABLE, K2
	19/C #14 AWG COPPER TRAY CABLE, K2
	7/C #14 AWG COPPER TRAY CABLE, K2
	SERVICE CABINET
	WOOD UTILITY POLE
	METER SOCKET
	2' DIAMETER FOOTING (VD1, ED8)
	3' DIAMETER FOOTING (ED5-ED7)
	18 INCH DIAMETER JUNCTION BOX (SJB1-SJB4) (VJB1)
	TRAFFIC SIGNAL CONTROLLER
	3" RIGID CONDUIT SCHEDULE 40
	5" RIGID CONDUIT SCHEDULE 40
	3" RIGID CONDUIT SCHEDULE 80
	PRE-EMPTION CABLE
	VIDEO CABLE
	FIBER OPTIC CABLE
	OUTDOOR RATED CATEGORY 5 CABLE

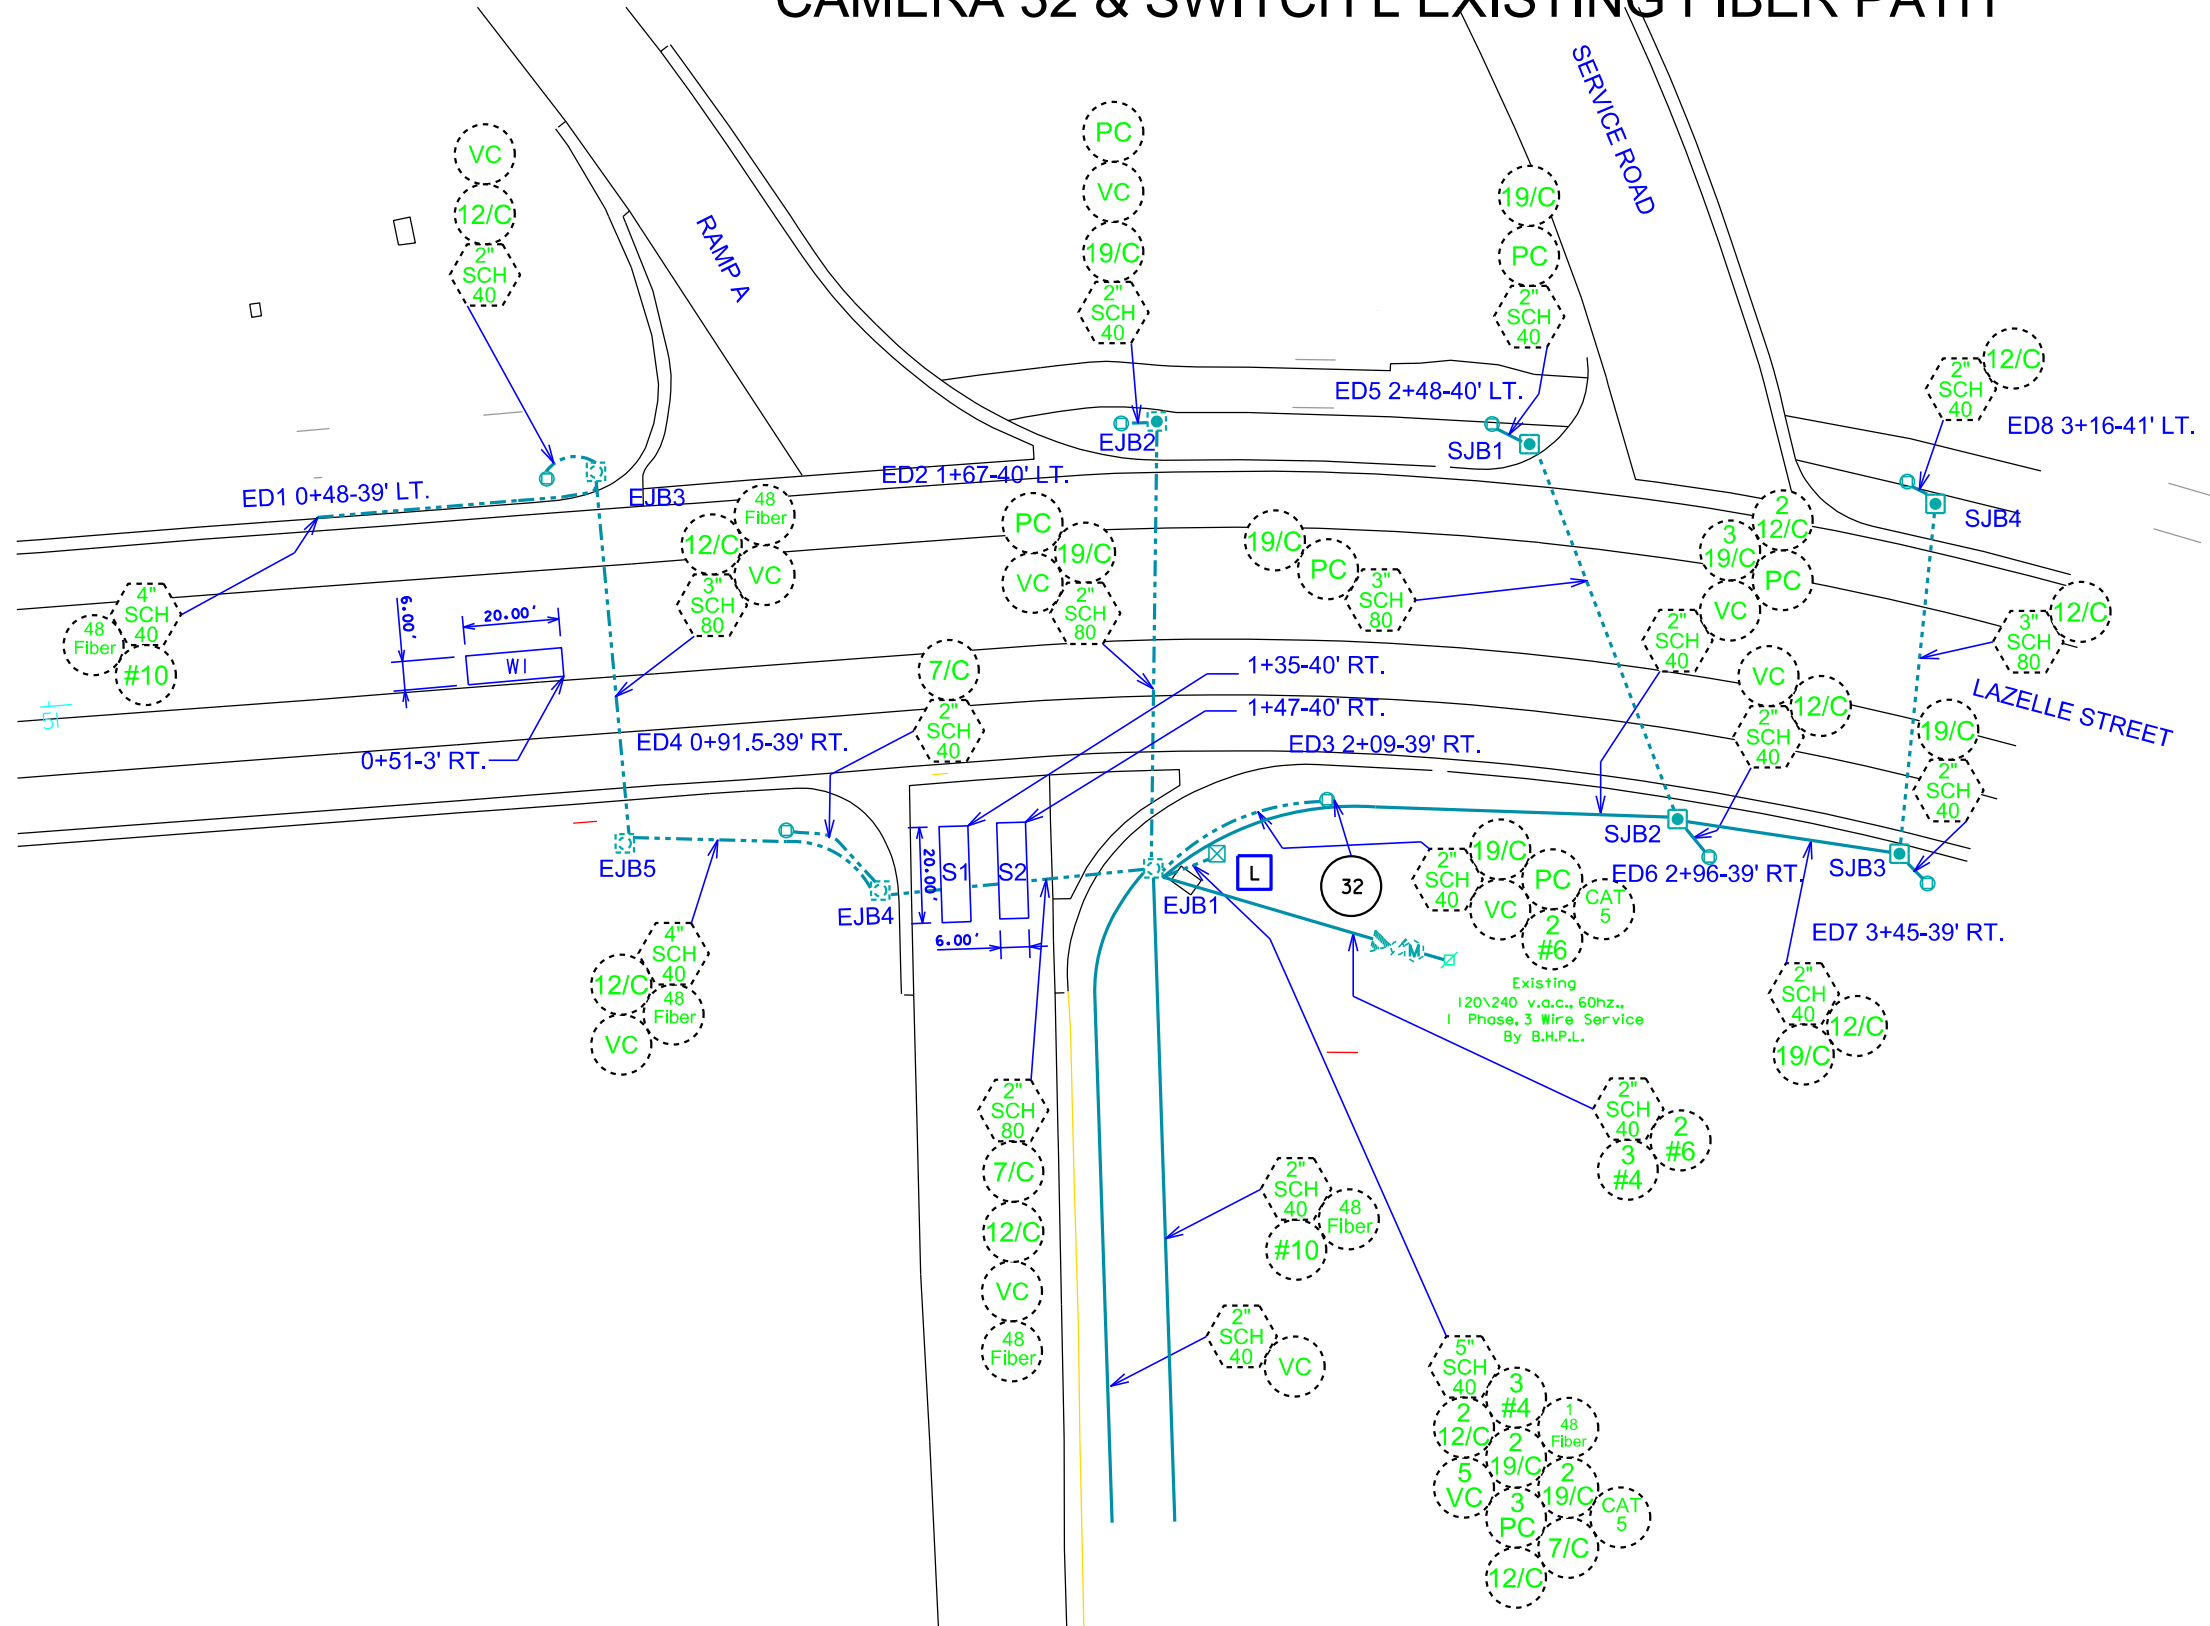







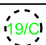
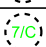
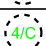









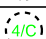

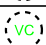


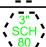


## Plot Scale - 1:40

Plotted From - trnr14286

SCALE  
1" = 40'



EXISTING ITEMS	
KEY	ITEM
	18" DIAMETER JUNCTION BOX (WJB1-WJB4,VJB2,VJB3)
	2" RIGID CONDUIT SCHEDULE 40
	4" RIGID CONDUIT SCHEDULE 40
	2" RIGID CONDUIT SCHEDULE 80
	3" RIGID CONDUIT SCHEDULE 80
	12/C #14 AWG COPPER TRAY CABLE, K2
	19/C #14 AWG COPPER TRAY CABLE, K2
	7/C #14 AWG COPPER TRAY CABLE, K2
	4/C #14 AWG COPPER TRAY CABLE, K2
	2' DIAMETER FOOTING (VD2)
	TRAFFIC SIGNAL CONTROLLER
	METER SOCKET
	SERVICE CABINET
	WOOD UTILITY POLE
	VIDEO DETECTION SYSTEM (32)
	2" RIGID CONDUIT SCHEDULE 40
	5" RIGID CONDUIT SCHEDULE 40
	1/C #4 AWG COPPER WIRE
	4/C #14 AWG TRAY CABLE, K2
	PRE-EMPTION CABLE (NOT A BID ITEM)
	VIDEO CABLE (NOT A BID ITEM)
	FIBER OPTIC CABLE
	1/C #10 AWG COPPER TRAY CABLE, K2
	12 STRAND SINGLE MODE FIBER




# EXISTING CONDUIT LAYOUT

INTERSTATE 90 EXIT 30 EASTBOUND OFF RAMP  
CAMERA 33 & EXISTING FIBER PATH

STATE OF SOUTH DAKOTA	PROJECT	SHEET	TOTAL SHEETS
	P 034-451	106	107

Plotting Date: 04/02/2014

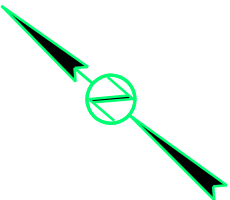

SCALE  
1" = 40'

INTERSTATE 90 / EAST BOUND

Ramp B

VJB3

2"  
SCH  
40

VC

Fiber  
12 SM

15+00

R.O.W.

Plot Scale - 1:40

Plotted From - tpr14286





# EXISTING CONDUIT LAYOUT

INTERSTATE 90 EXIT 30 EASTBOUND OFF RAMP  
CAMERA 33 & SWITCH M EXISTING FIBER PATH

STATE OF SOUTH DAKOTA	PROJECT	SHEET	TOTAL SHEETS
	P 034-451	107	107

Plotting Date: 04/02/2014

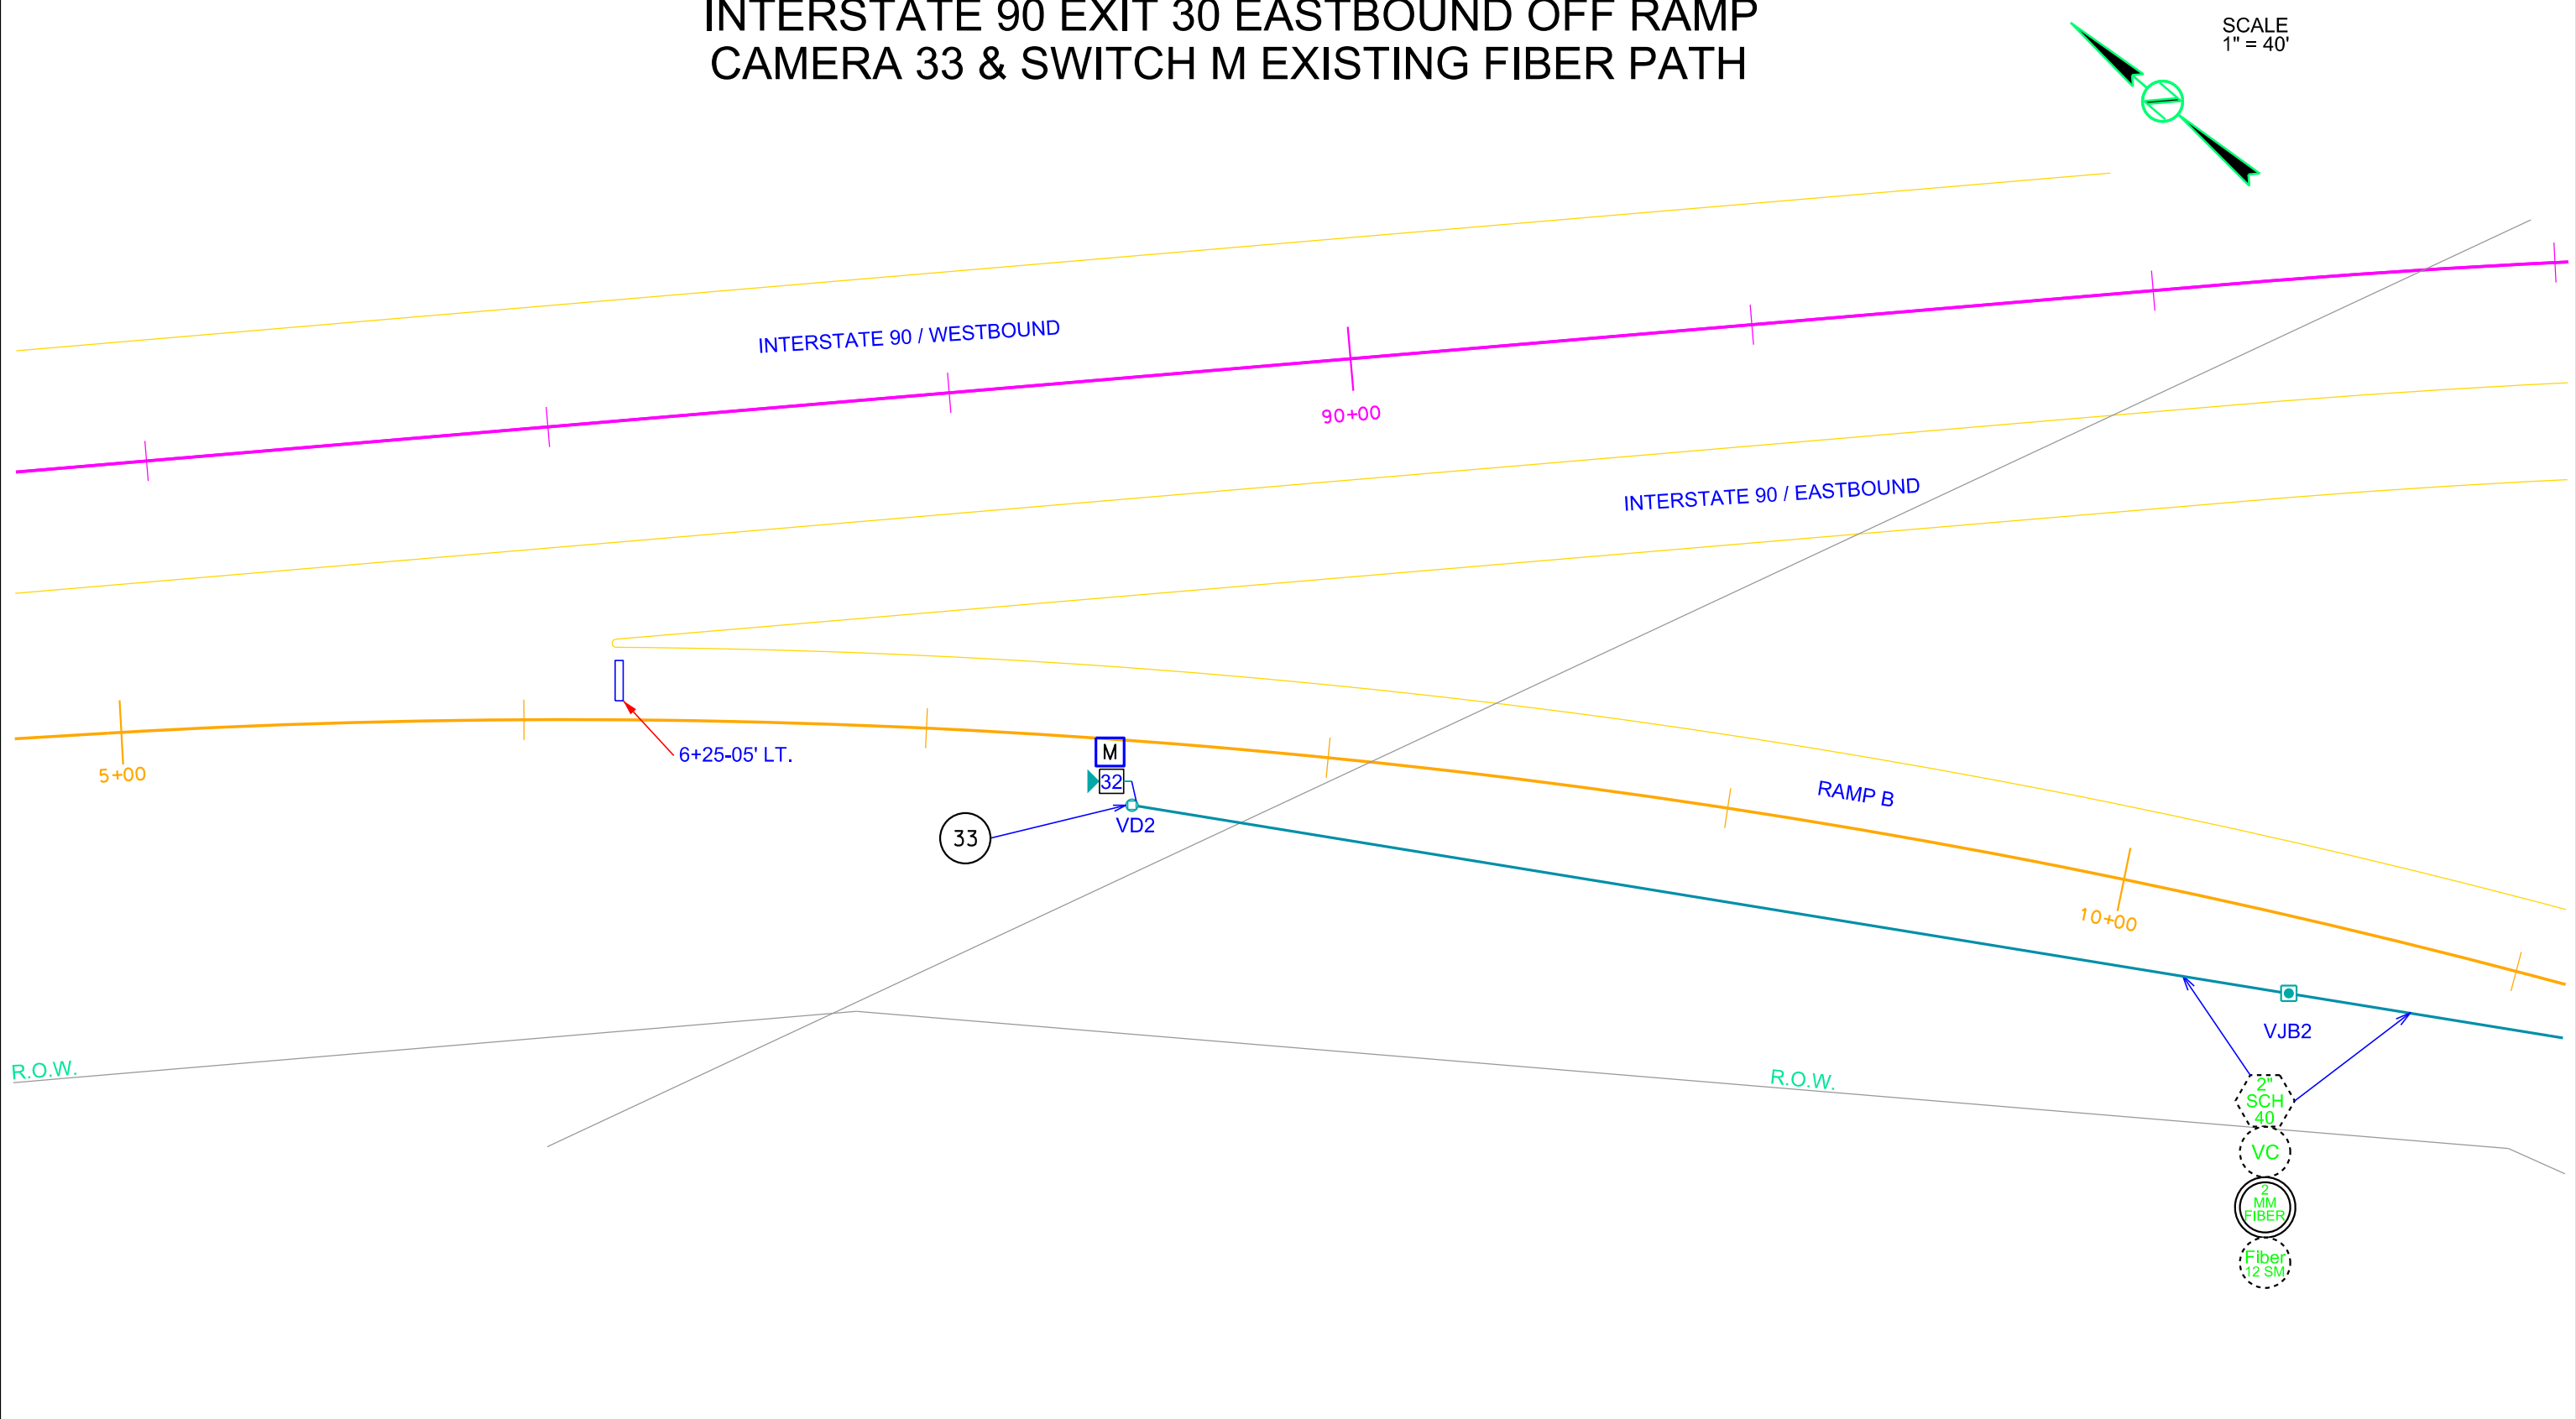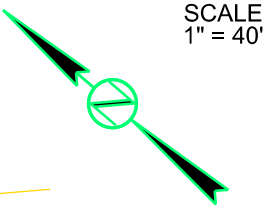

Plot Scale - 1:40

Plotted From - tpr14286

File - ...IDPS\Exit30EBConduit (2).dgn